


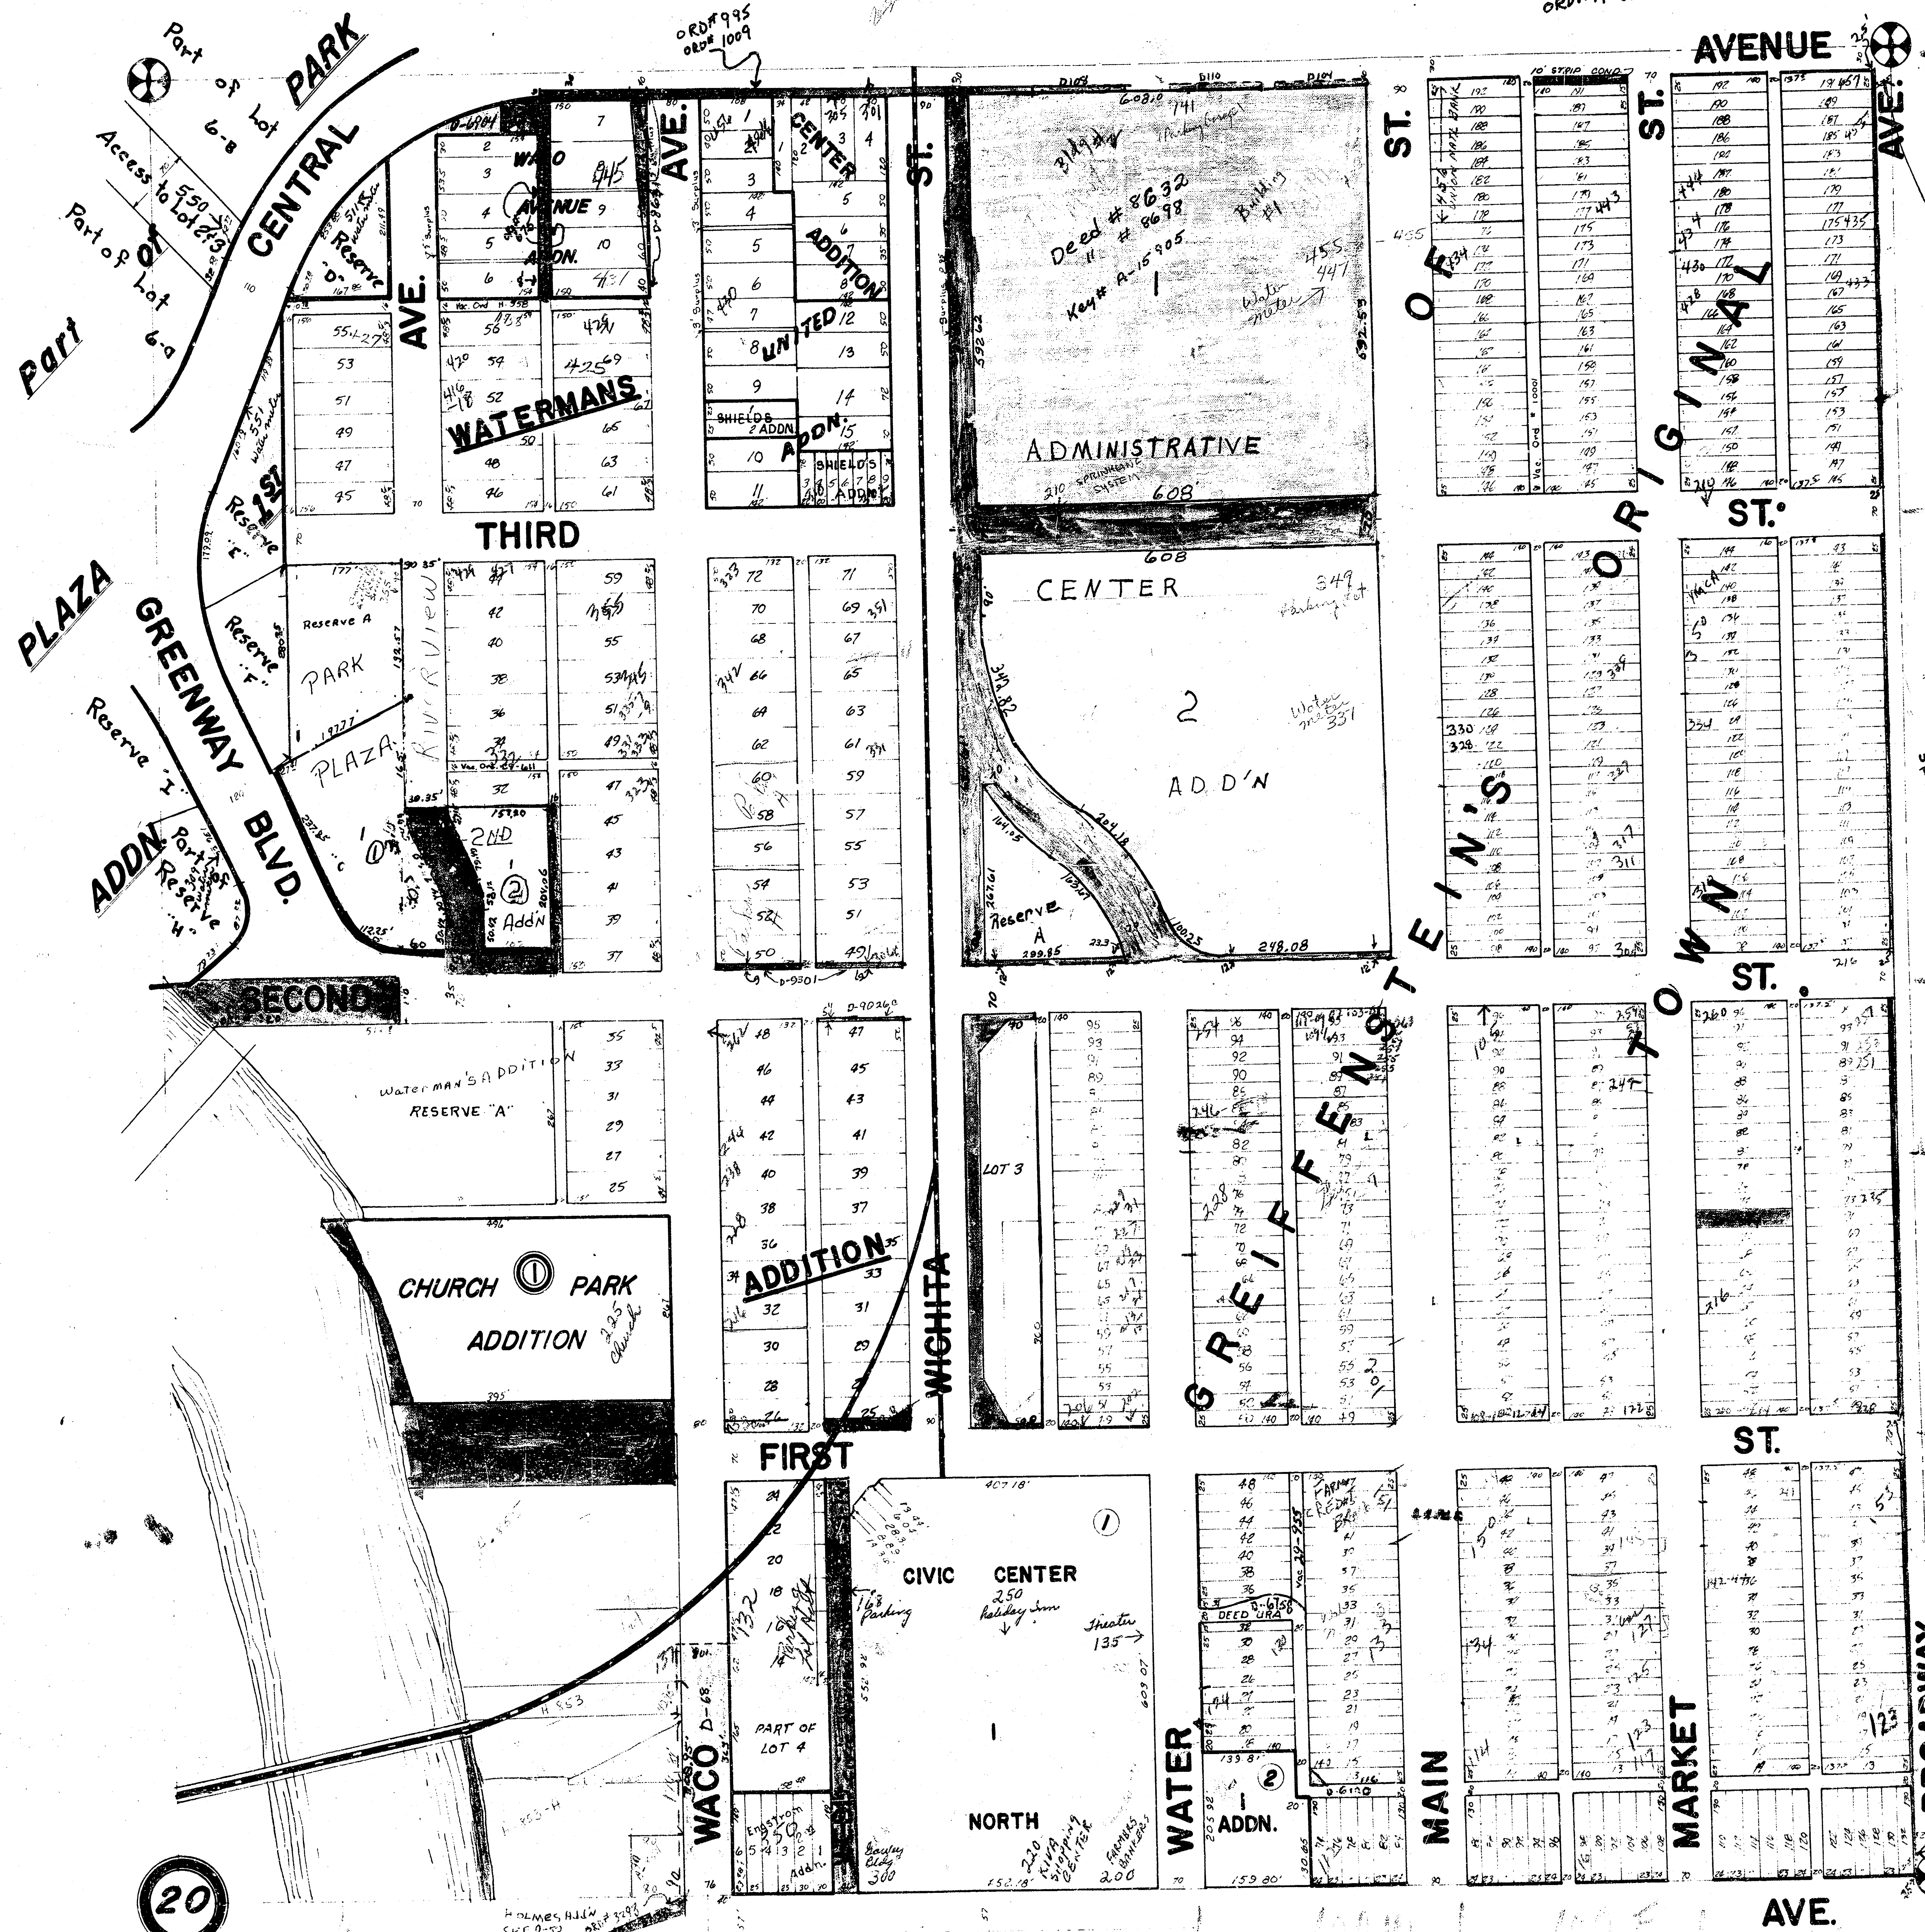

Deed BK M 185 P 506
C# A-14905
ORD # 14-052

Whening of Broadway
The W. 1/2 of the Sec 20
of NE 1/4 Sec 20
ORD # 231, Feb 12, 1890