


9-53
900

21

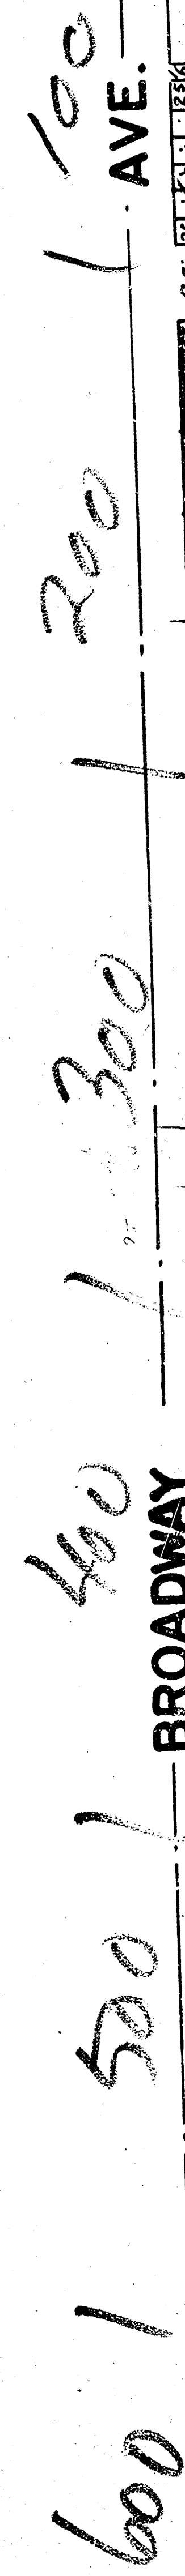

ORD# 16-685
CE# A33119
-ORD# 16-702
BK # 16-685 Pg 32

WASHINGTON