


NE 1/4 SEC 28 TWP 27 S R 1E.

9-57

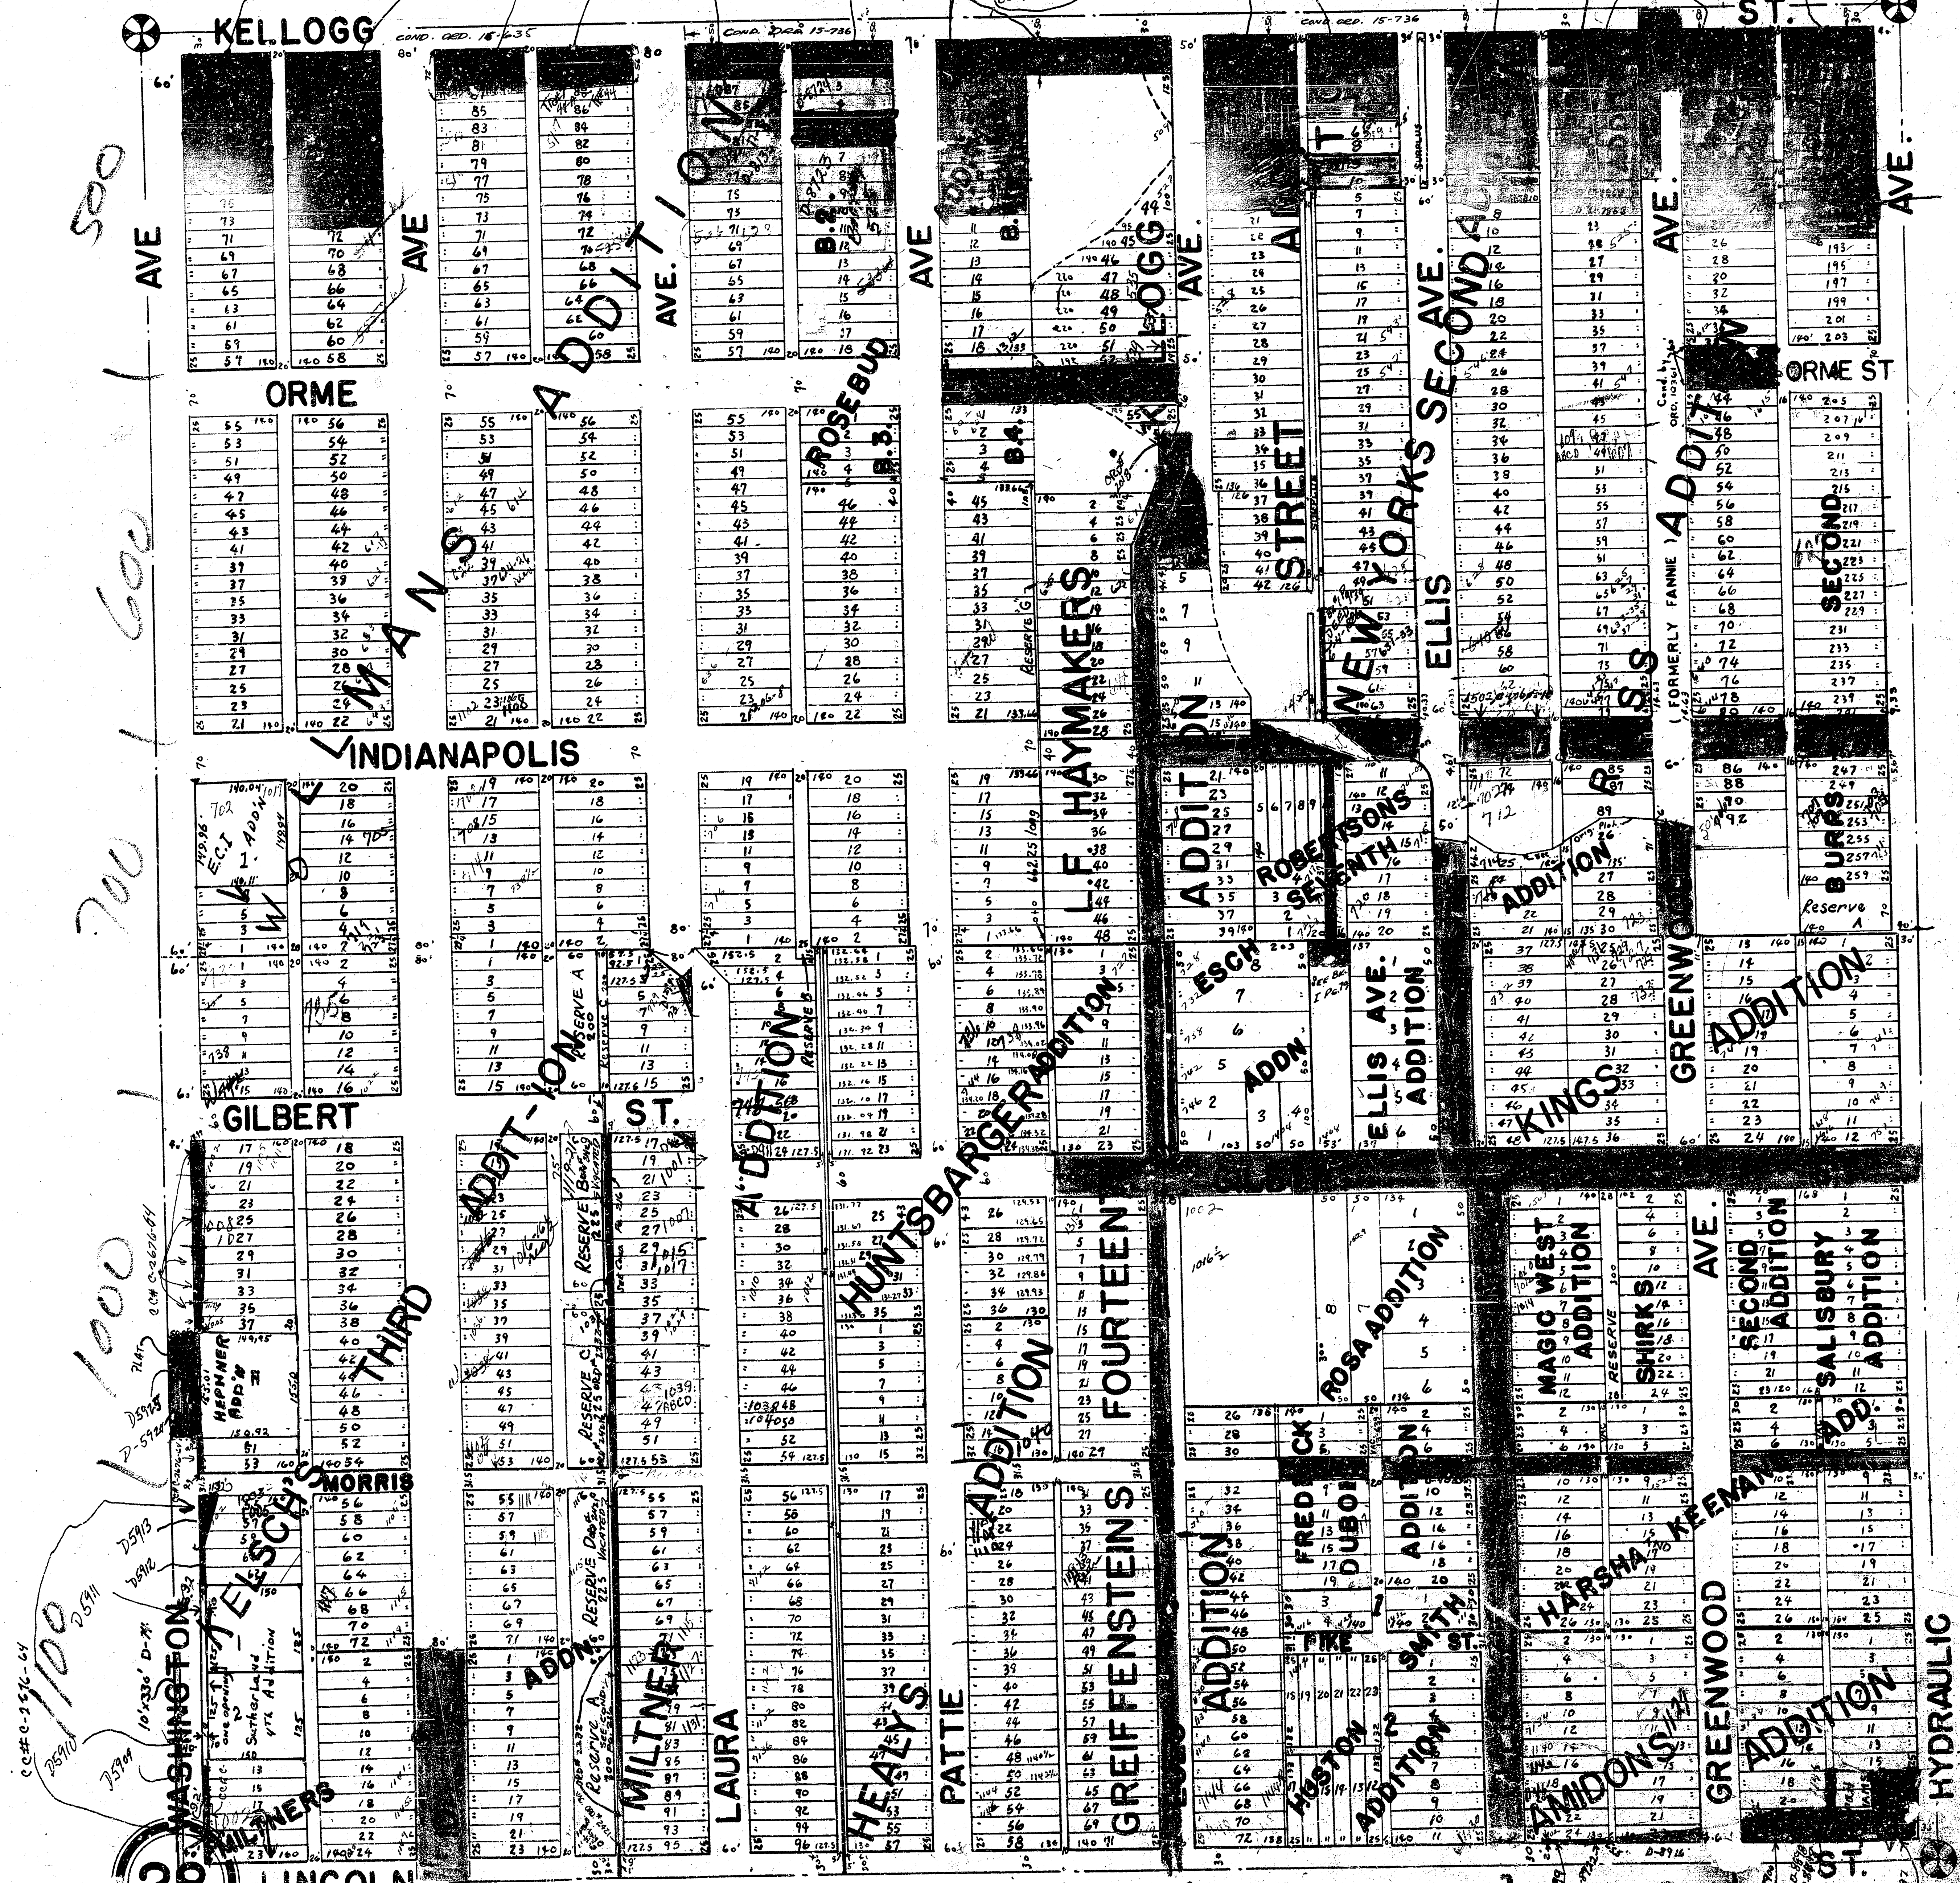

500
600
700
1000
1100
1200
1300
1400
1500
1600

28

LINCOLN

1000 | 1100 | 1200 | 1300 | 1400 | 1500 | 1600