


NE 1/4 SEC. 32 TWP 27 R1E. 9-61

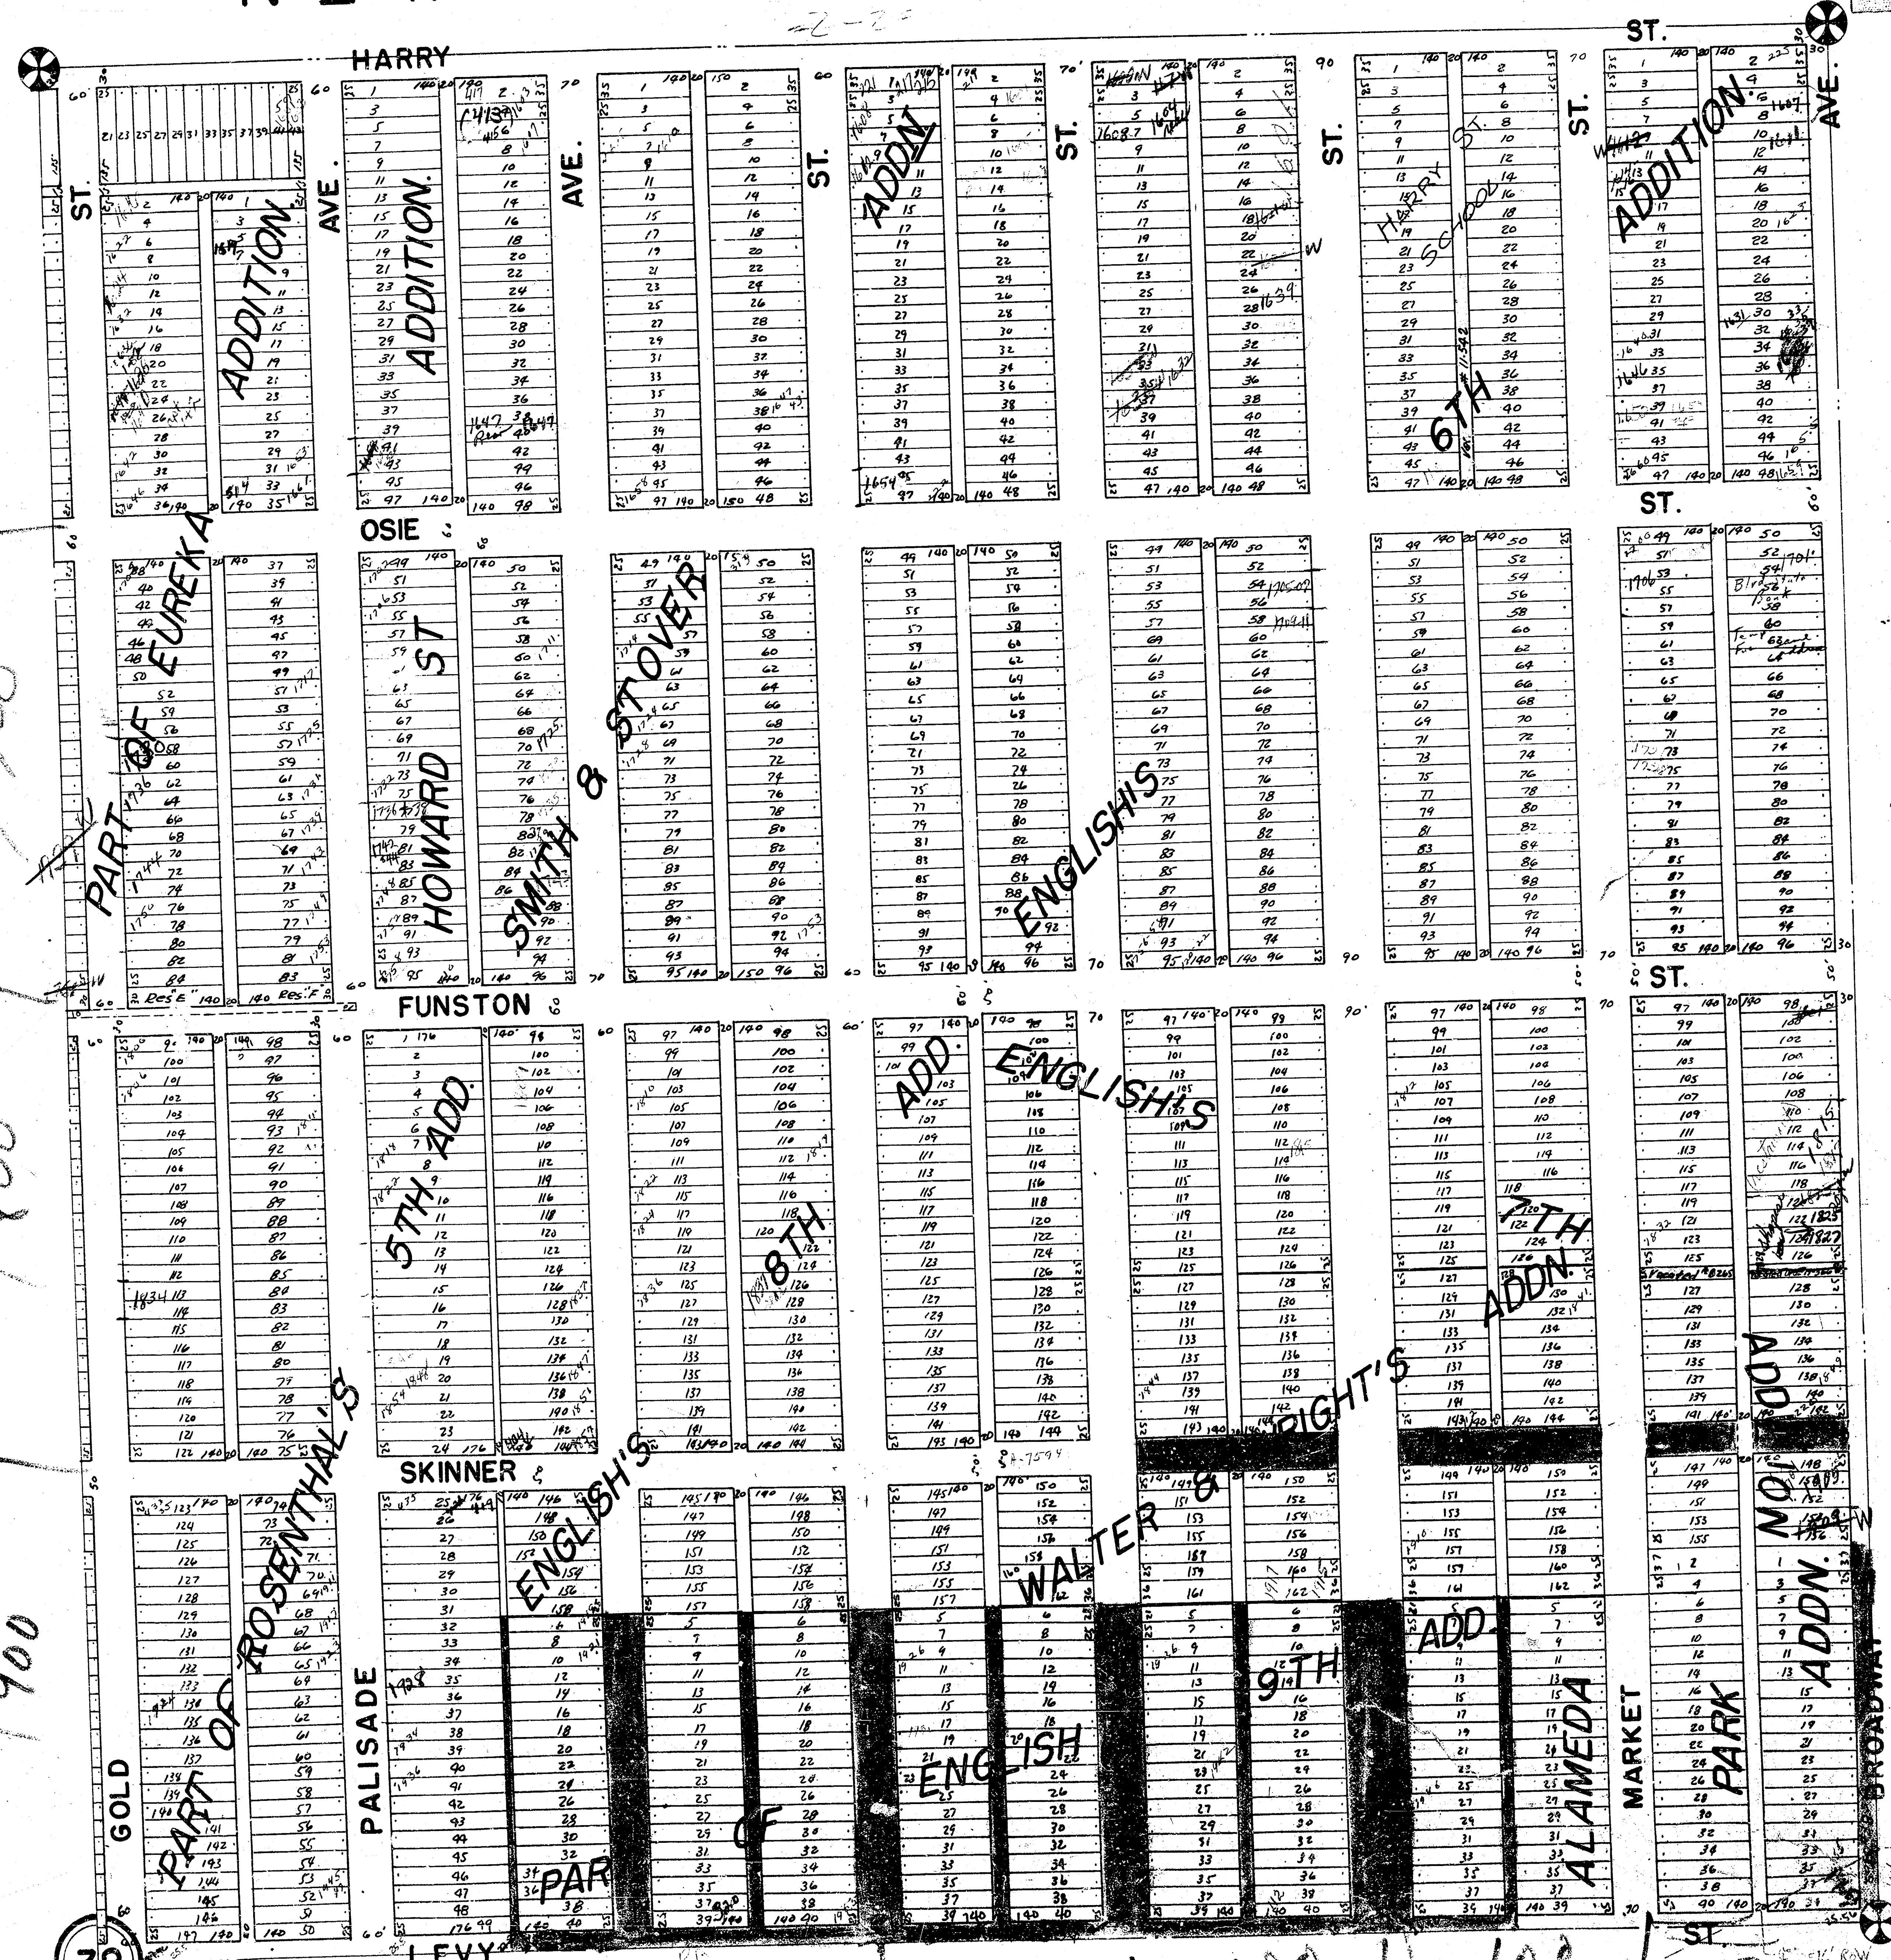

32

500 400 300 200 100 100 200