


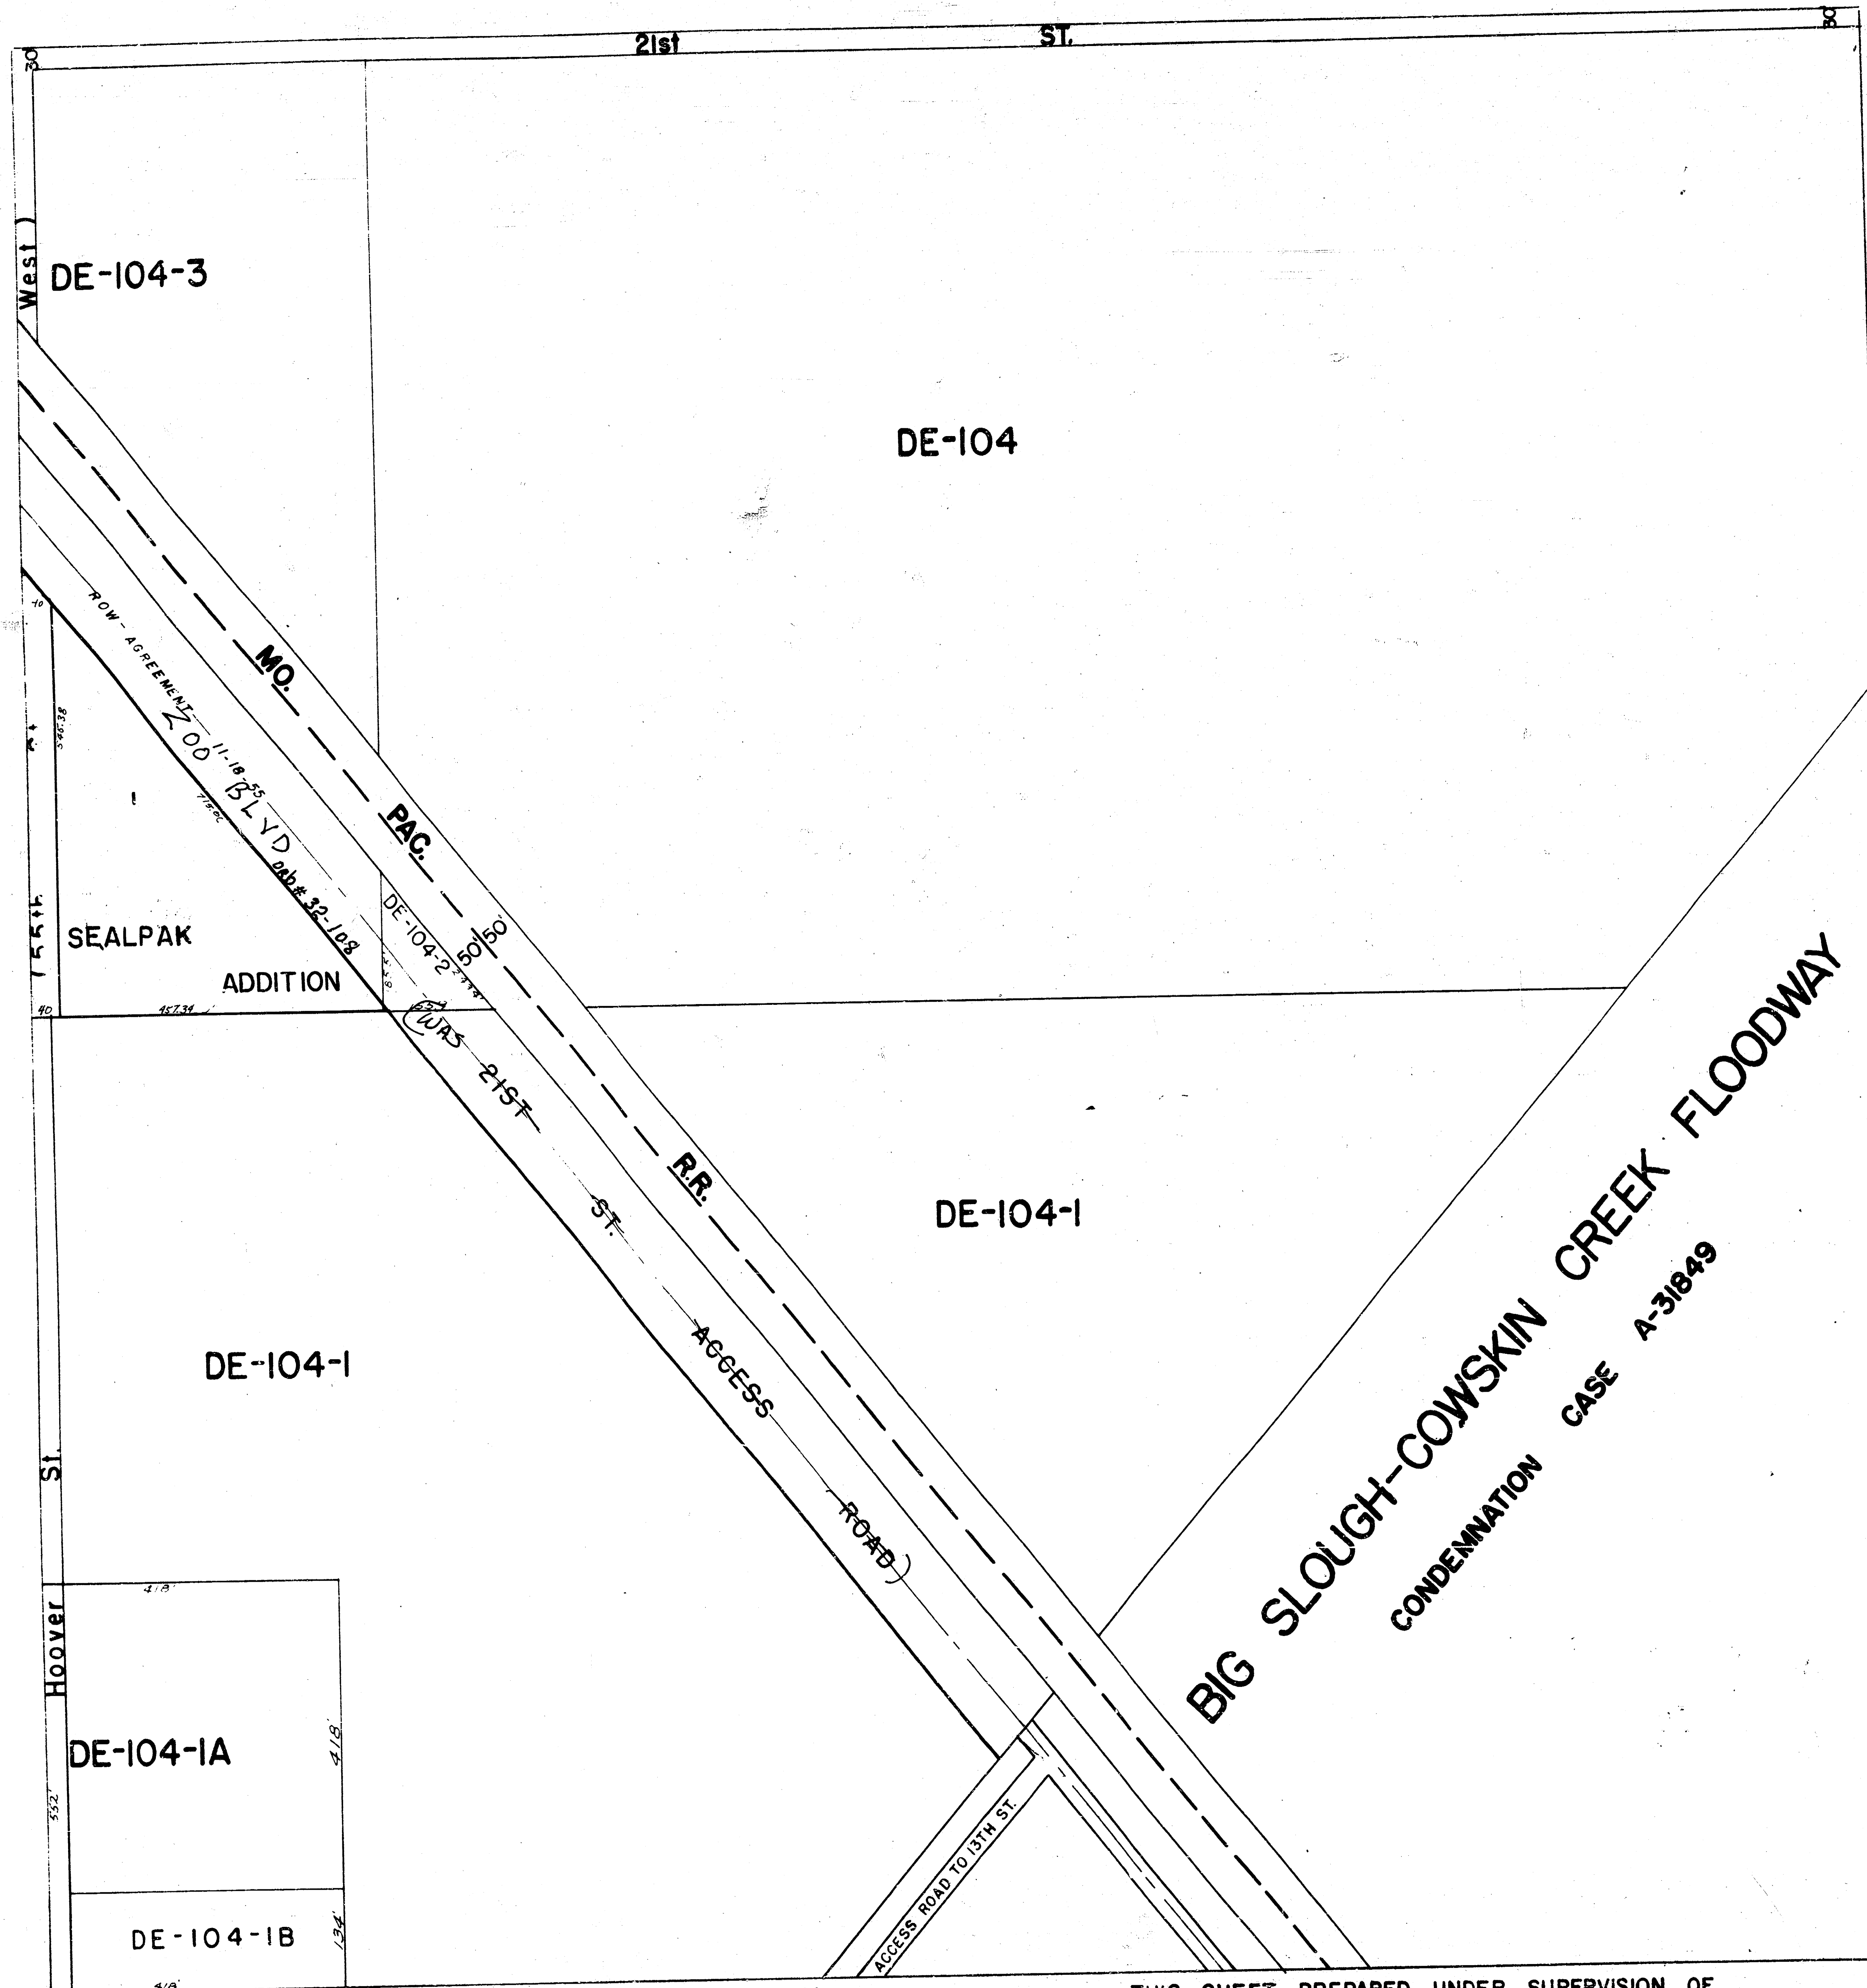

THIS SHEET PREPARED UNDER SUPERVISION OF
W.O. WILLIAMS, SEDGWICK COUNTY CLERK