

T 27 S
SHEET 182

T 27 S
SHEET 11

T 28 S

T 28 S

R 1 W

R 1 E

R 2 E

R 1 W

R 1 E


R 2 E

SHEET 86

SHEET 10

• CATHODE TEST PAINT

12

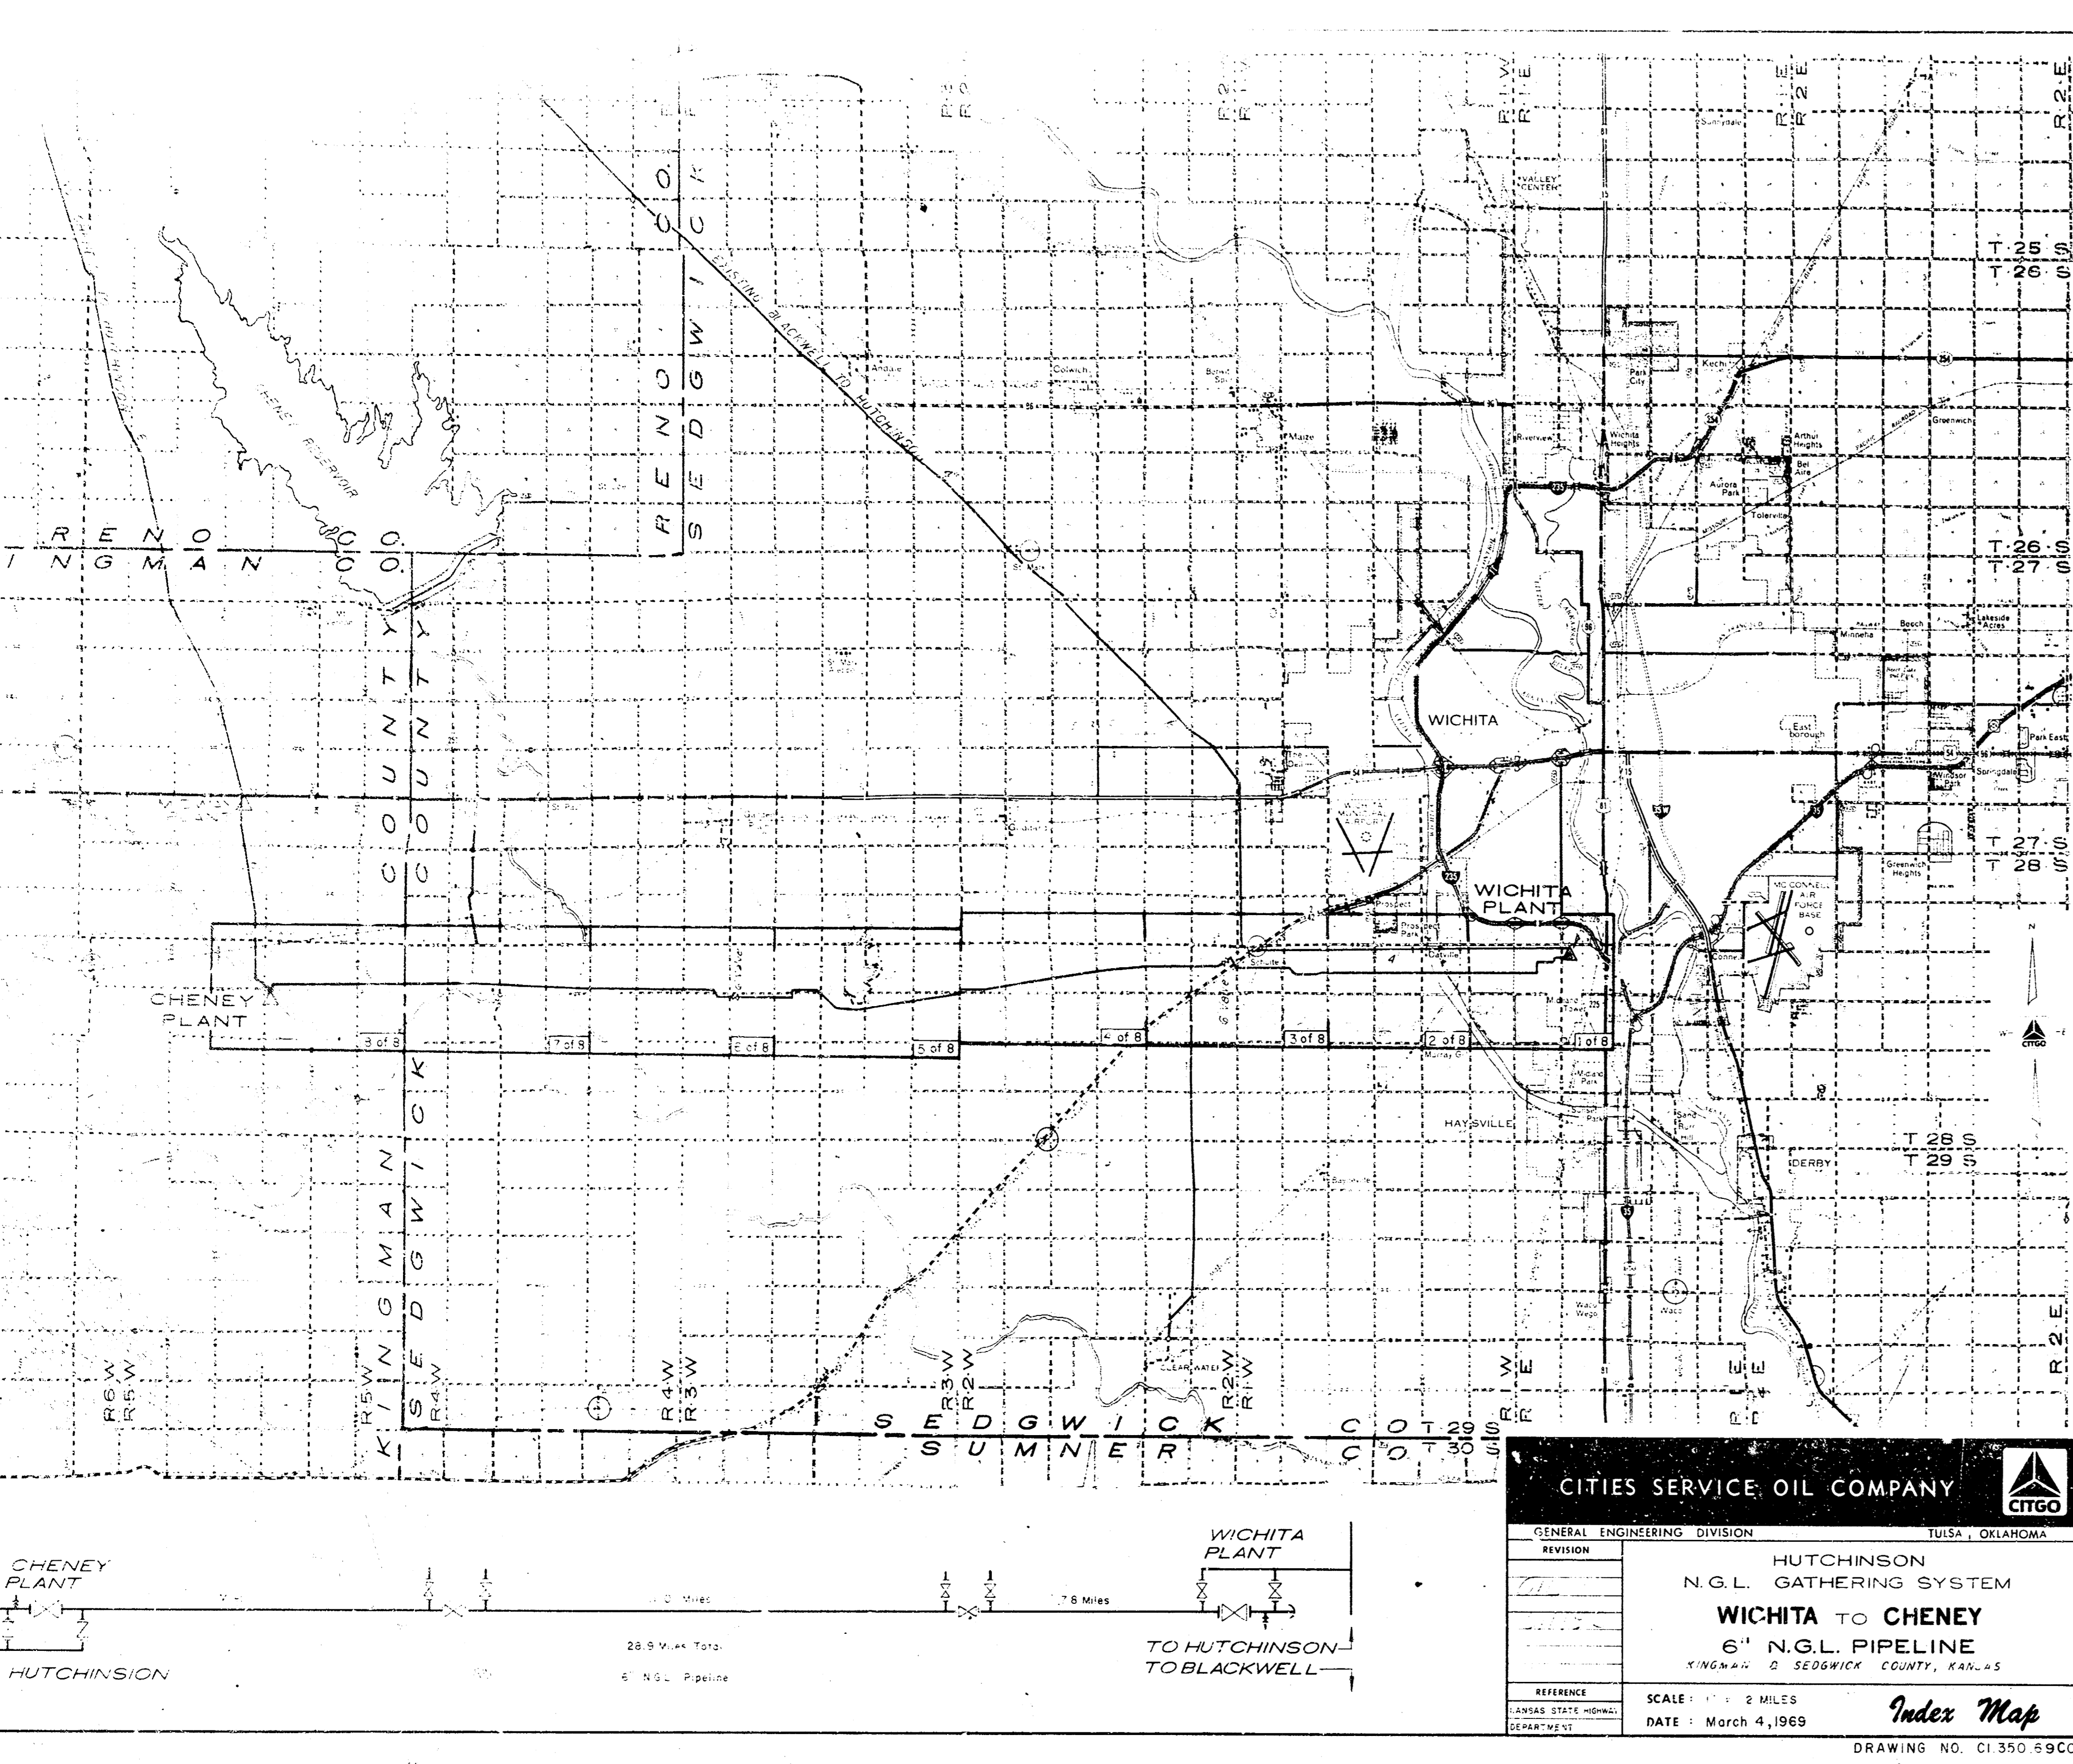

CITIES SERVICE OIL COMPANY


GENERAL ENGINEERING DIVISION TULSA, OKLAHOMA

HUTCHINSON
N.G.L. GATHERING SYSTEM
WICHITA TO CHENEY
6" N.G.L. PIPELINE
KINGMAN & SEDGWICK COUNTIES, KAN.


SCALE: 2 MILES
DATE: March 4, 1969

Index Map

DRAWING NO. CI 350-9900

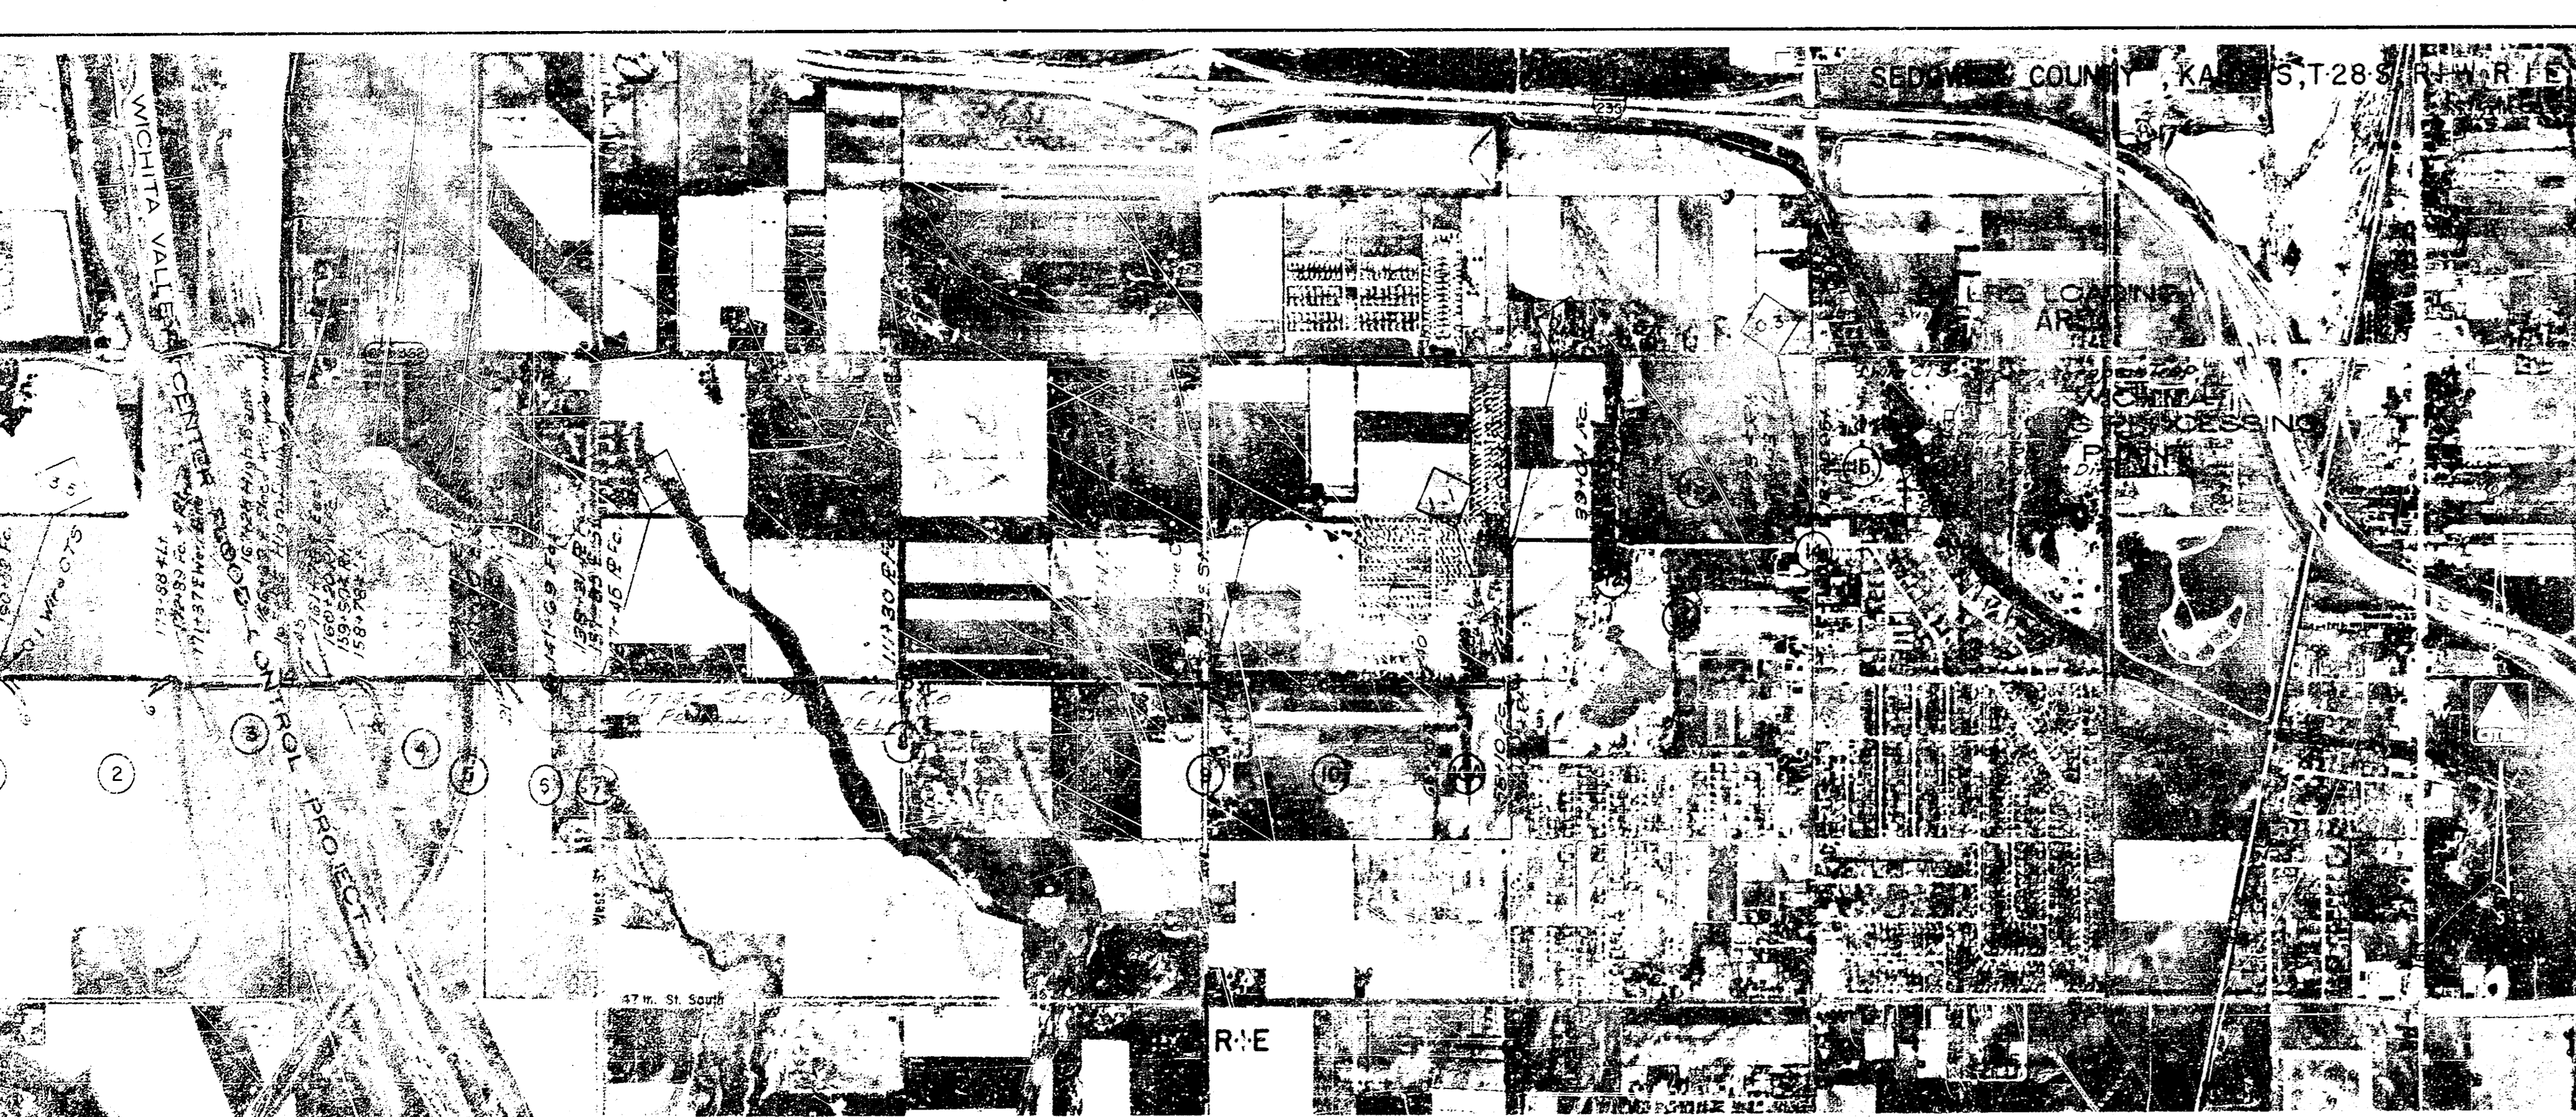

NO.	OWNER	RODS NO.	OWNER	RODS NO.	OWNER	RODS NO.	WT.	O.D.	WALL TH.	FROM	TO	FEET	MILES	MFG.	TYPE	COATING	REVISIONS	RECHAIN BOOK	DATE	DRAWN BY	CHECKED BY

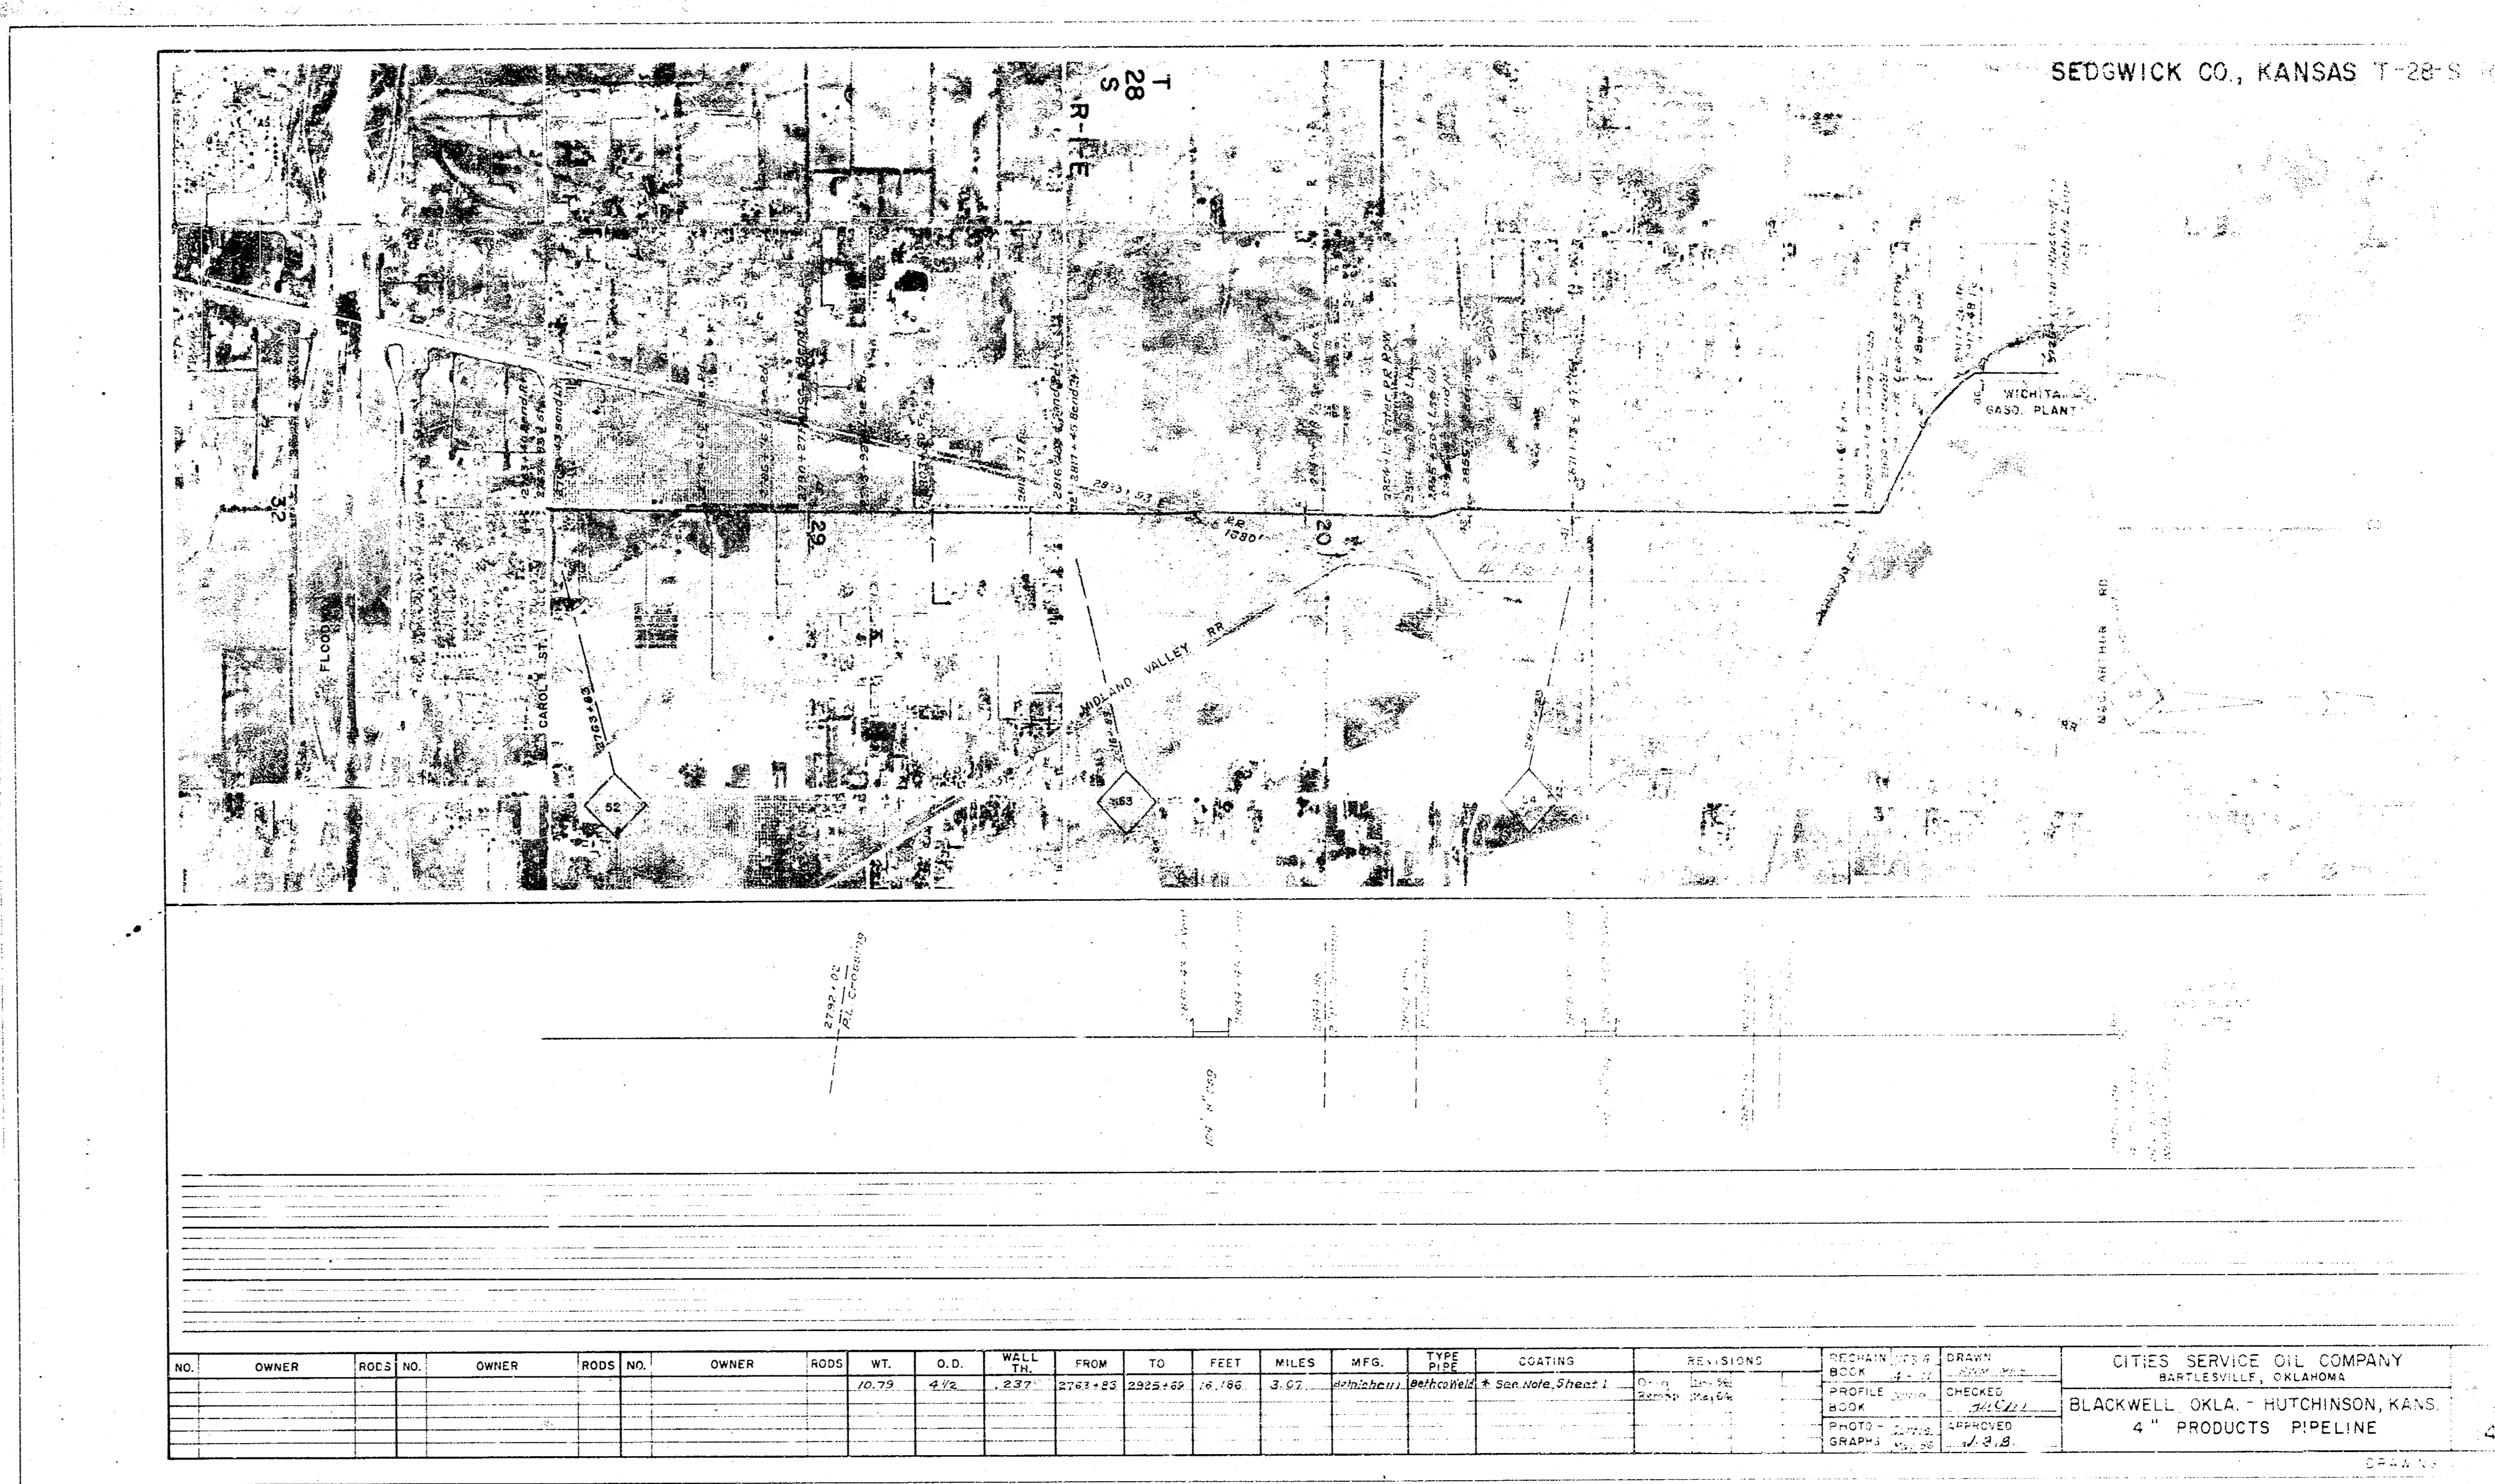

