R 1 W | R 1 E | R 2 E

T 27 S

T 28 S

WICHITA

WICHITA MUNICIPAL AIRPORT

WICHITA AIR FORCE BASE

ARKANSAS RIVER

BIG SLOUGH CREEK

WEST MERIDIAN

BROADWAY

HYDRAULIC

HILLSIDE

DOUGLAS

CENTRAL

KELLOGG

HARRY

PAWNEE

STUCKEY

HAPPY HAN

SENECA

ROCK ROAD

WEBB ROAD

TYLER ROAD

SEDGWICK ROAD

37th ST.

29th ST.

21st ST.

13th ST.

250

255

260

5

SHEET 182


SHEET 86


SHEET 10

SHEET 11

12

• CATHODIC TEST POINT

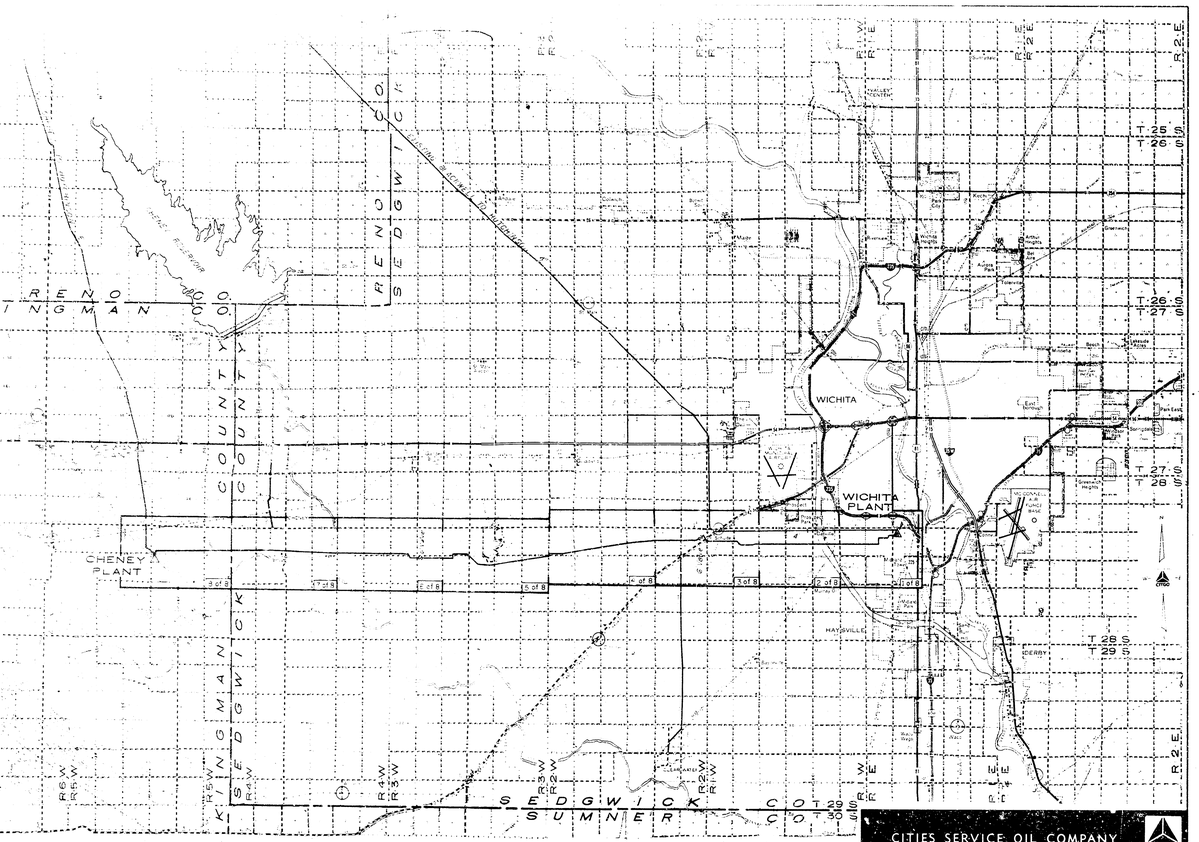

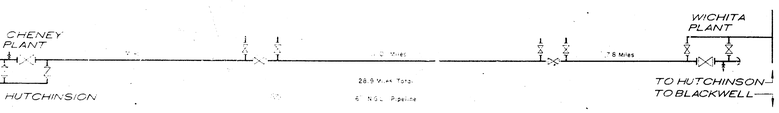

CITIES SERVICE OIL COMPANY
CITGO
GENERAL ENGINEERING DIVISION — TULSA, OKLAHOMA

REVISION


REFERENCE
KANSAS STATE HIGHWAY DEPARTMENT

HUTCHINSON
N.G.L. GATHERING SYSTEM
WICHITA TO **CHENEY**
6" N.G.L. PIPELINE
KINGMAN & SEDGWICK COUNTY, KANSAS

SCALE: 1" = 2 MILES
DATE: March 4, 1969

Index Map


DRAWING NO. CI 350-69C0

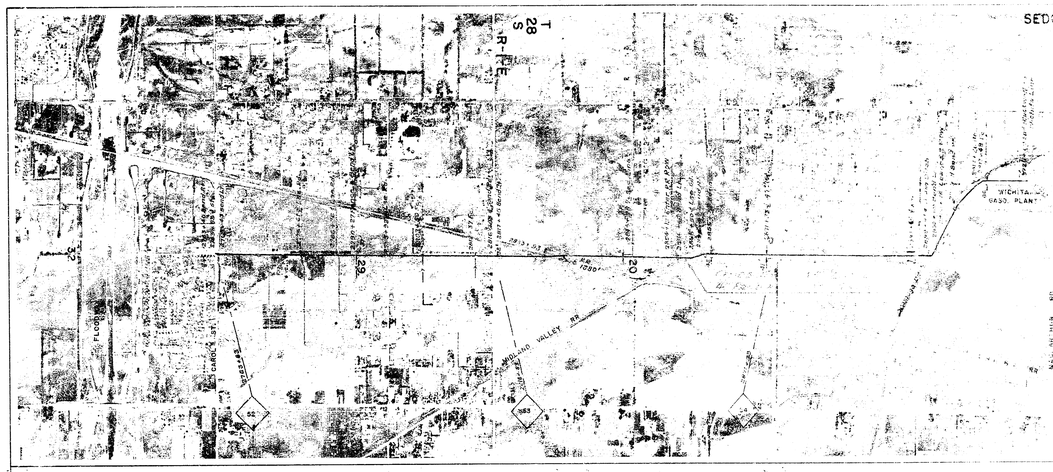


NO.	OWNER	RODS	NO.	OWNER	RODS	NO.	OWNER	RODS	WT.	O.D.	WALL TH.	FROM	TO	FEET	MILES	MFG.	TYPE PIPE	COATING	REVISIONS
									10.79	4.5	.237	2747+23	2925+69	16,746	3.02	Arbitrary	Bethlehem	* See note, Sheet 1	Orig. Dwg. Same

RECHAIN BOOK 1-3 — DRAWN
PROFILE BOOK — CHECKED
PHOTO-GRAPHS — APPROVED

CITIES SERVICE OIL COMPANY
BARTLESVILLE, OKLAHOMA
BLACKWELL OKLA. - HUTCHINSON, KANS.
4" PRODUCTS PIPELINE

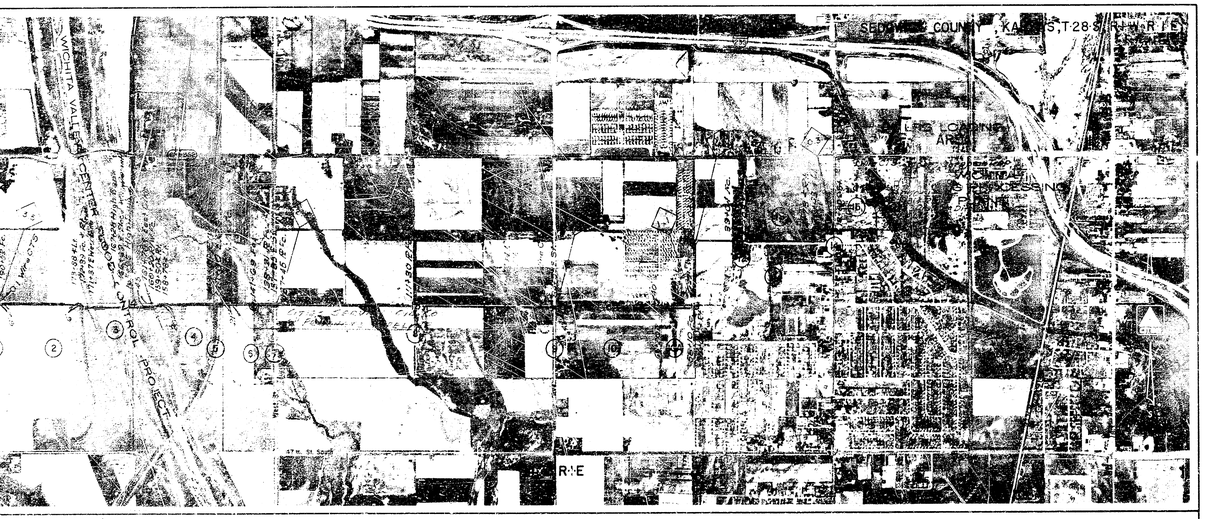

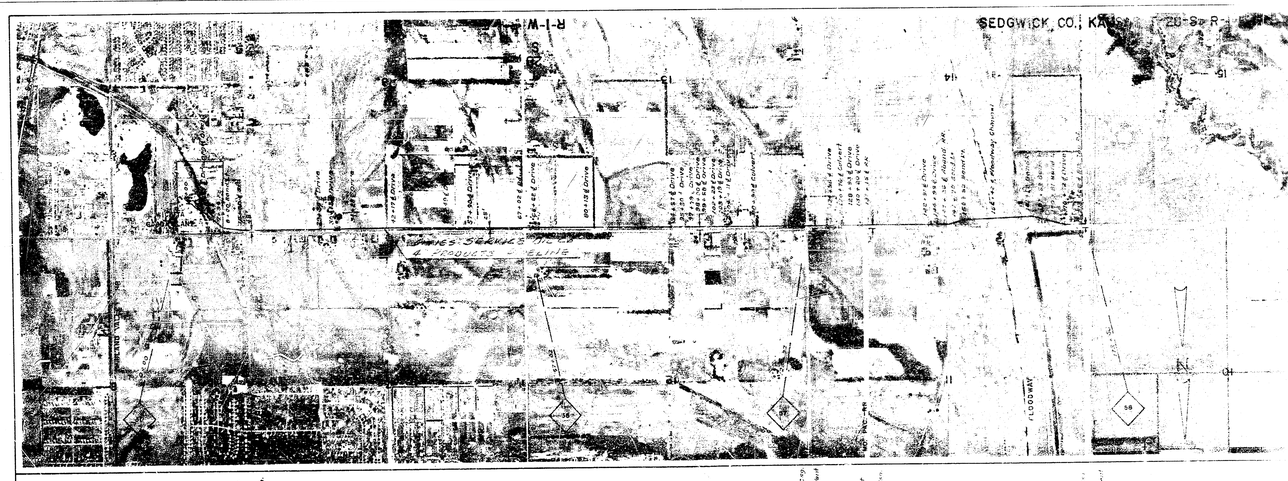

NO.	OWNER	RODS	NO.	OWNER	RODS	NO.	OWNER	RODS	WT.	O.D.	WALL TH.	FROM	TO	FEET	MILES	MFG.	TYPE PIPE	COATING	REVISIONS
									10.79	4.5	.237	0+00	173+66	17,366	3.29	Bethlehem	Bethlehem	* See note, Sheet 1	Orig. Dwg. Same

RECHAIN BOOK 1-23 — DRAWN
PROFILE BOOK — CHECKED
PHOTO-GRAPHS Curtis Wright — APPROVED

CITIES SERVICE OIL COMPANY
BARTLESVILLE, OKLAHOMA
BLACKWELL OKLA. - HUTCHINSON, KANS.
4" PRODUCTS PIPELINE

NO.	OWNER	RODS	NO.	OWNER	RODS	NO.	OWNER	RODS	WT.	O.D.	WALL TH.	FROM	TO	FEET	MILES	MFG.	TYPE PIPE	COATING	REVISIONS
									10.79	4.5	.237	0+00	173+66	17,366	3.29	Bethlehem	Bethlehem	* See note, Sheet 1	Orig. Dwg. Same

RECHAIN BOOK 1-3 — DRAWN
PROFILE BOOK — CHECKED
PHOTO-GRAPHS — APPROVED

CITIES SERVICE OIL COMPANY
BARTLESVILLE, OKLAHOMA
BLACKWELL OKLA. - HUTCHINSON, KANS.
4" PRODUCTS PIPELINE