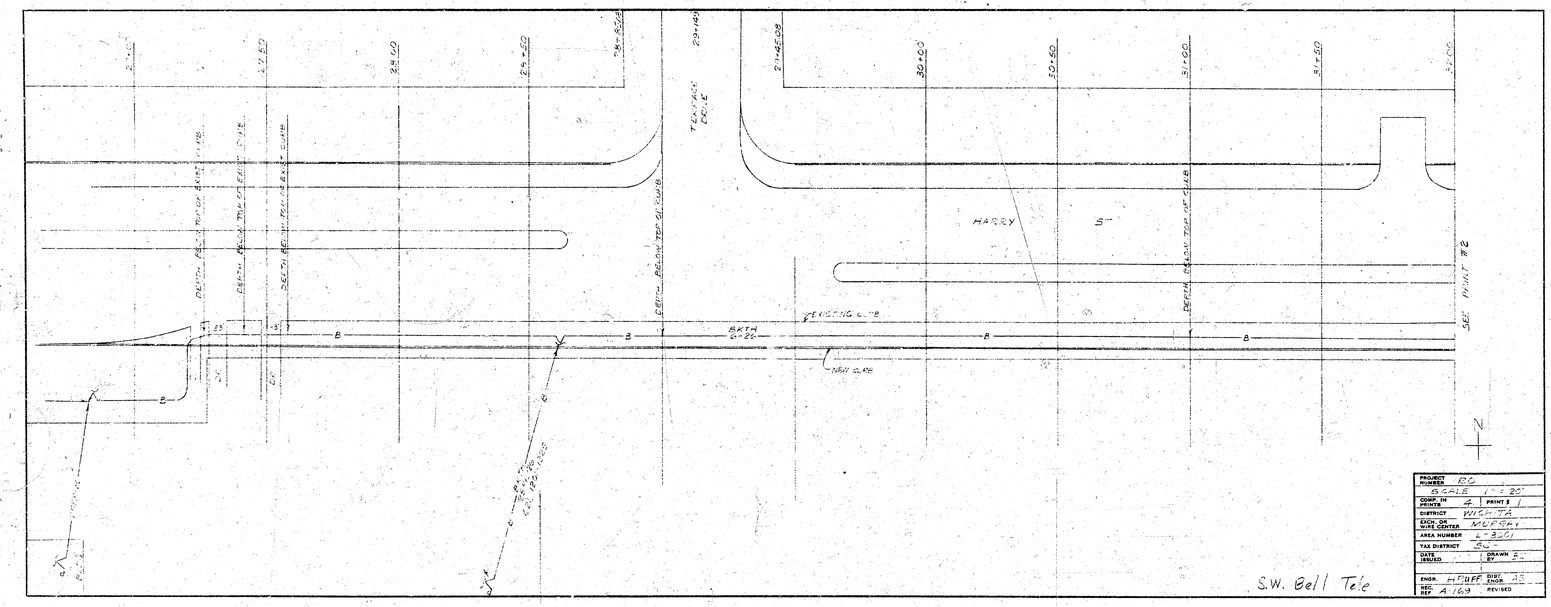
HARRY
ST
EXISTING C.L.
NEW C.L.
SEE PLAN SHT #2
TELEPHONE POLE
S.W. Bell Tele
N
PROJECT NUMBER RC
SCALE 1" = 20'
COMP. IN PRINTS 4 PRINT # 1
DISTRICT WICHITA
EXCH. OR WIRE CENTER MURRAY
AREA NUMBER CT 9211
TAX DISTRICT SC
DATE ISSUED DRAWN BY
ENGR. HPUFF REVI. ENGR. AS
REF. A-169 REVISED

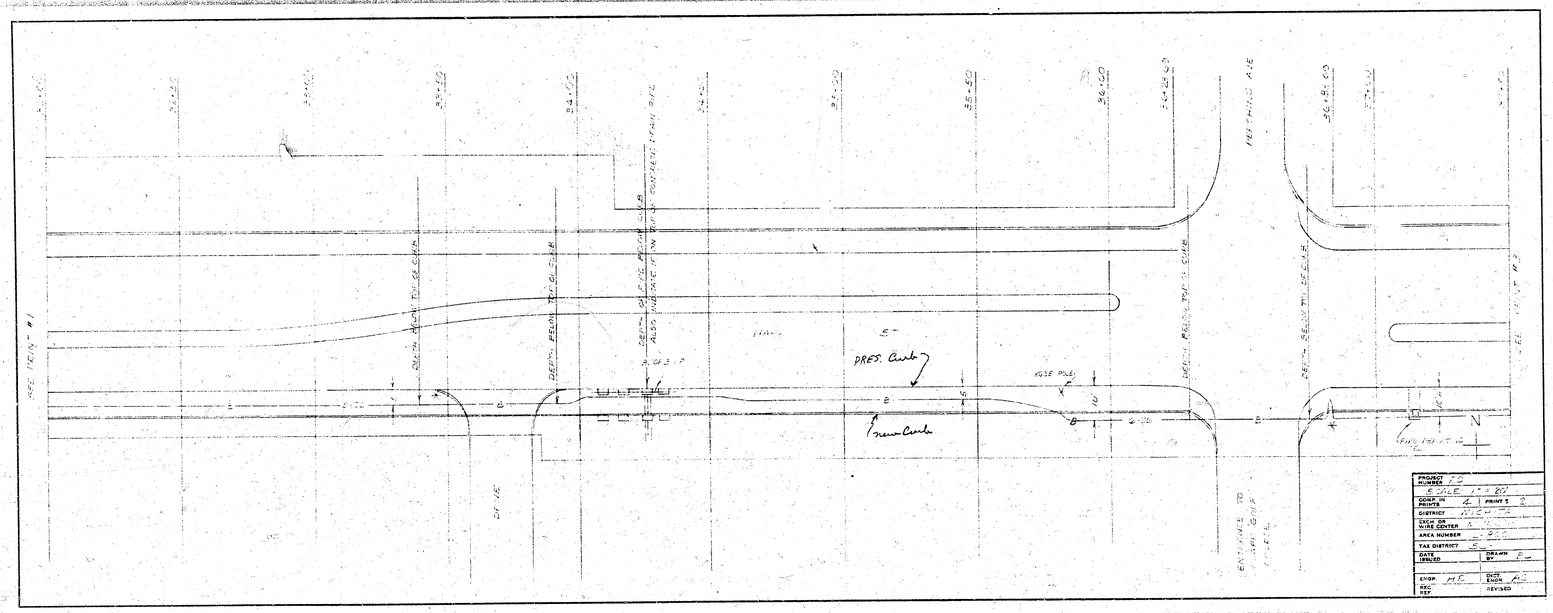
PROJECT NO.
SCALE 1" = 20'
CORP. IN PRINTS
DISTRICT
EXCH OR WIRE CENTER
AREA NUMBER
TAX DISTRICT
DATE TRACED
DRAWN BY
CHKD. BY
REC. REF.
REVISED
PROP. CURB
FIRE HYD.
N

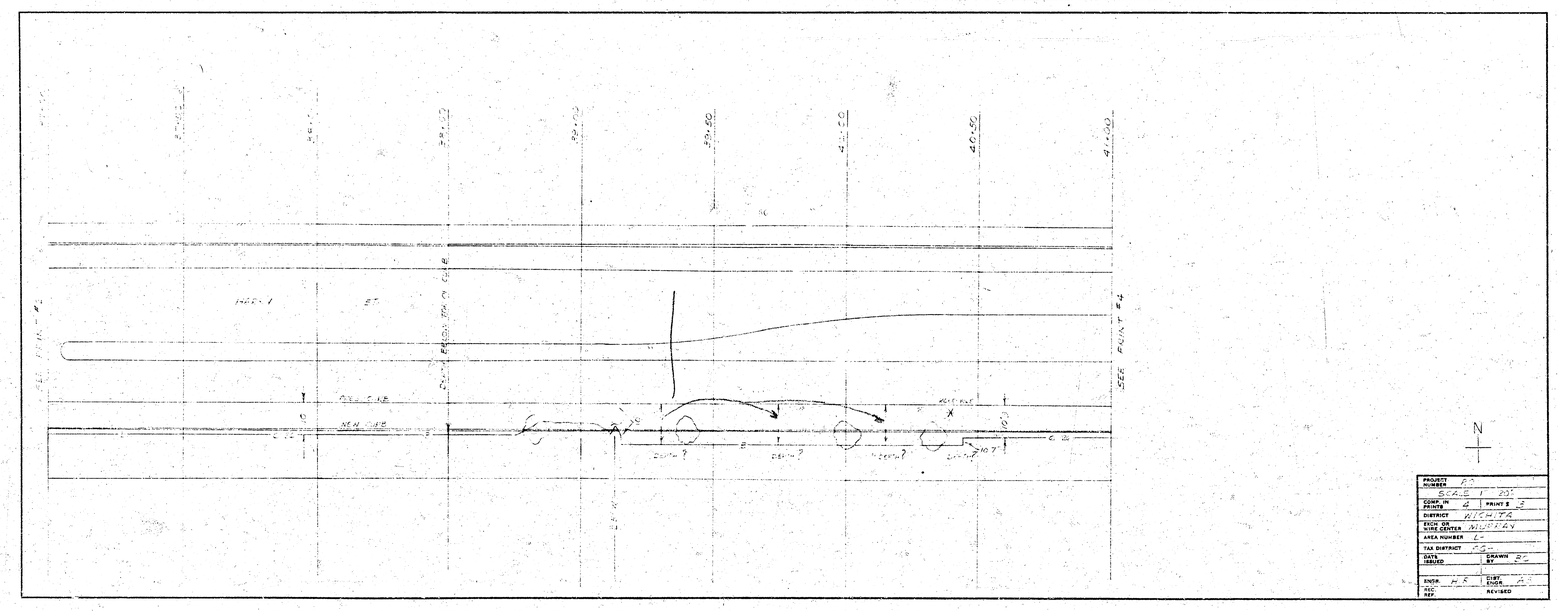

PROJECT NUMBER	
SCALE	1" = 20'
SHEET IN PRINT	PRINT #
DISTRICT	WICHITA
AREA NUMBER	
TAX DISTRICT	
DATE ISSUED	DRAWN BY
ENGR.	DIST. ENGR.
REC. REF.	REVISED

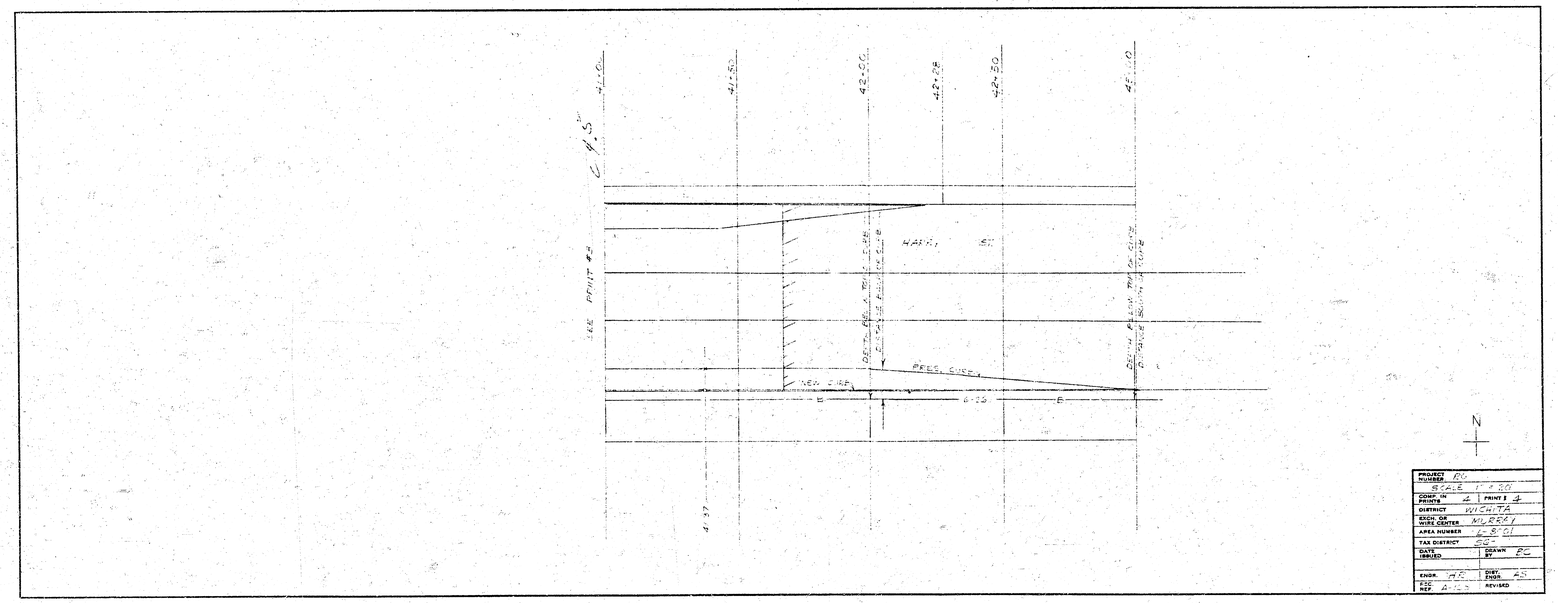

PROJECT NUMBER	RC
DISTRICT	WICHITA
EXCH. OR WIRE CENTER	MURRAY
AREA NUMBER	L-8-01
TAX DISTRICT	SC
DATE ISSUED	DRAWN BY EC
FCC REF.	REVISED