FIRST ST

SECOND ST

DOUGLAS

WILLIAMS

ENGLISH

WACO ST

WEBB ST

WICHITA ST

WATER

MAIN

MARKET

BROADWAY

TOPEKA

EMPORIA

K.G.&E.

WICHITA CLUB

SCOTTISH RITE TEMPLE

S.W.B.T.

WESTERN LITHOGRAPH

WESTERN UNION BLDG.

LASSEN HOTEL

NEW PLAZA BLDG.

NEW UNION NAT'L BANK BLDG.

SWEITER BLDG.

CENTRAL BLDG.

BOSTYN BLDG.

YEAGER BLDG.

Commodore Hotel

CITY HALL

INNES PARKING BLDG.

INNES STOKE

SUTTON PLACE

UNION NAT BANK

WARDS

NEW LIBRARY

GREYEY BLDG.

ALL PROPERTY ON THIS SHEET IN P.A.-51.

WU TEL. CO

C-9190-A.10.

WICHITA KANS.-CITY PLANT

SEC-A-

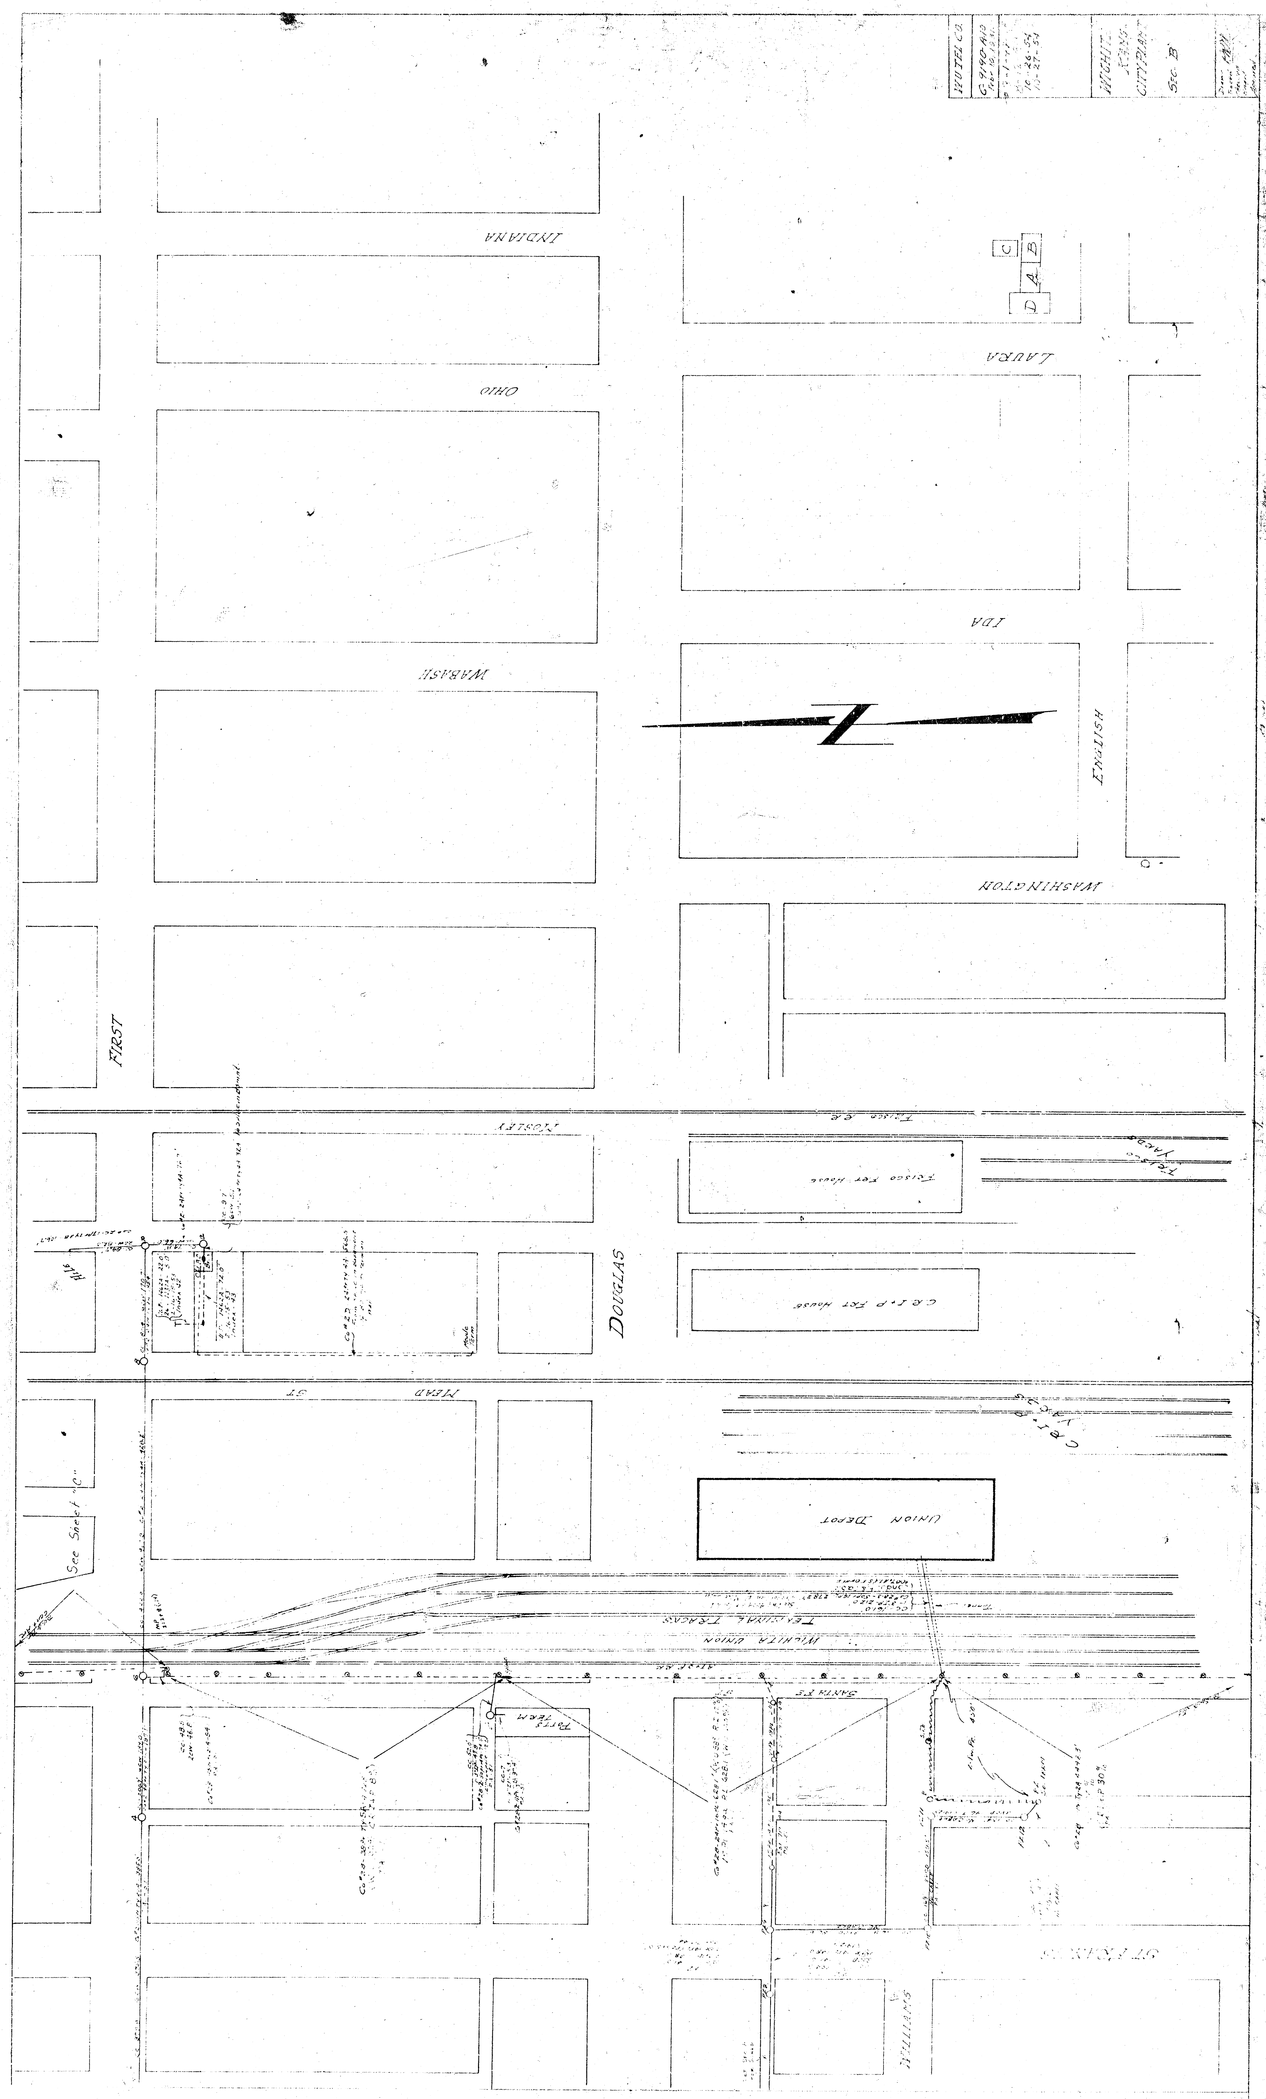
INDIANA
OHIO
WABASH
FIRST
LAURA
IDA
KANSAS
WASHINGTON
DOUGLAS
MAIN ST
UNION DEPOT
ATCHISON TOPEKA & SANTA FE
SANTA FE
ALAMEDA
See Sheet No. 1
A
B
C
D

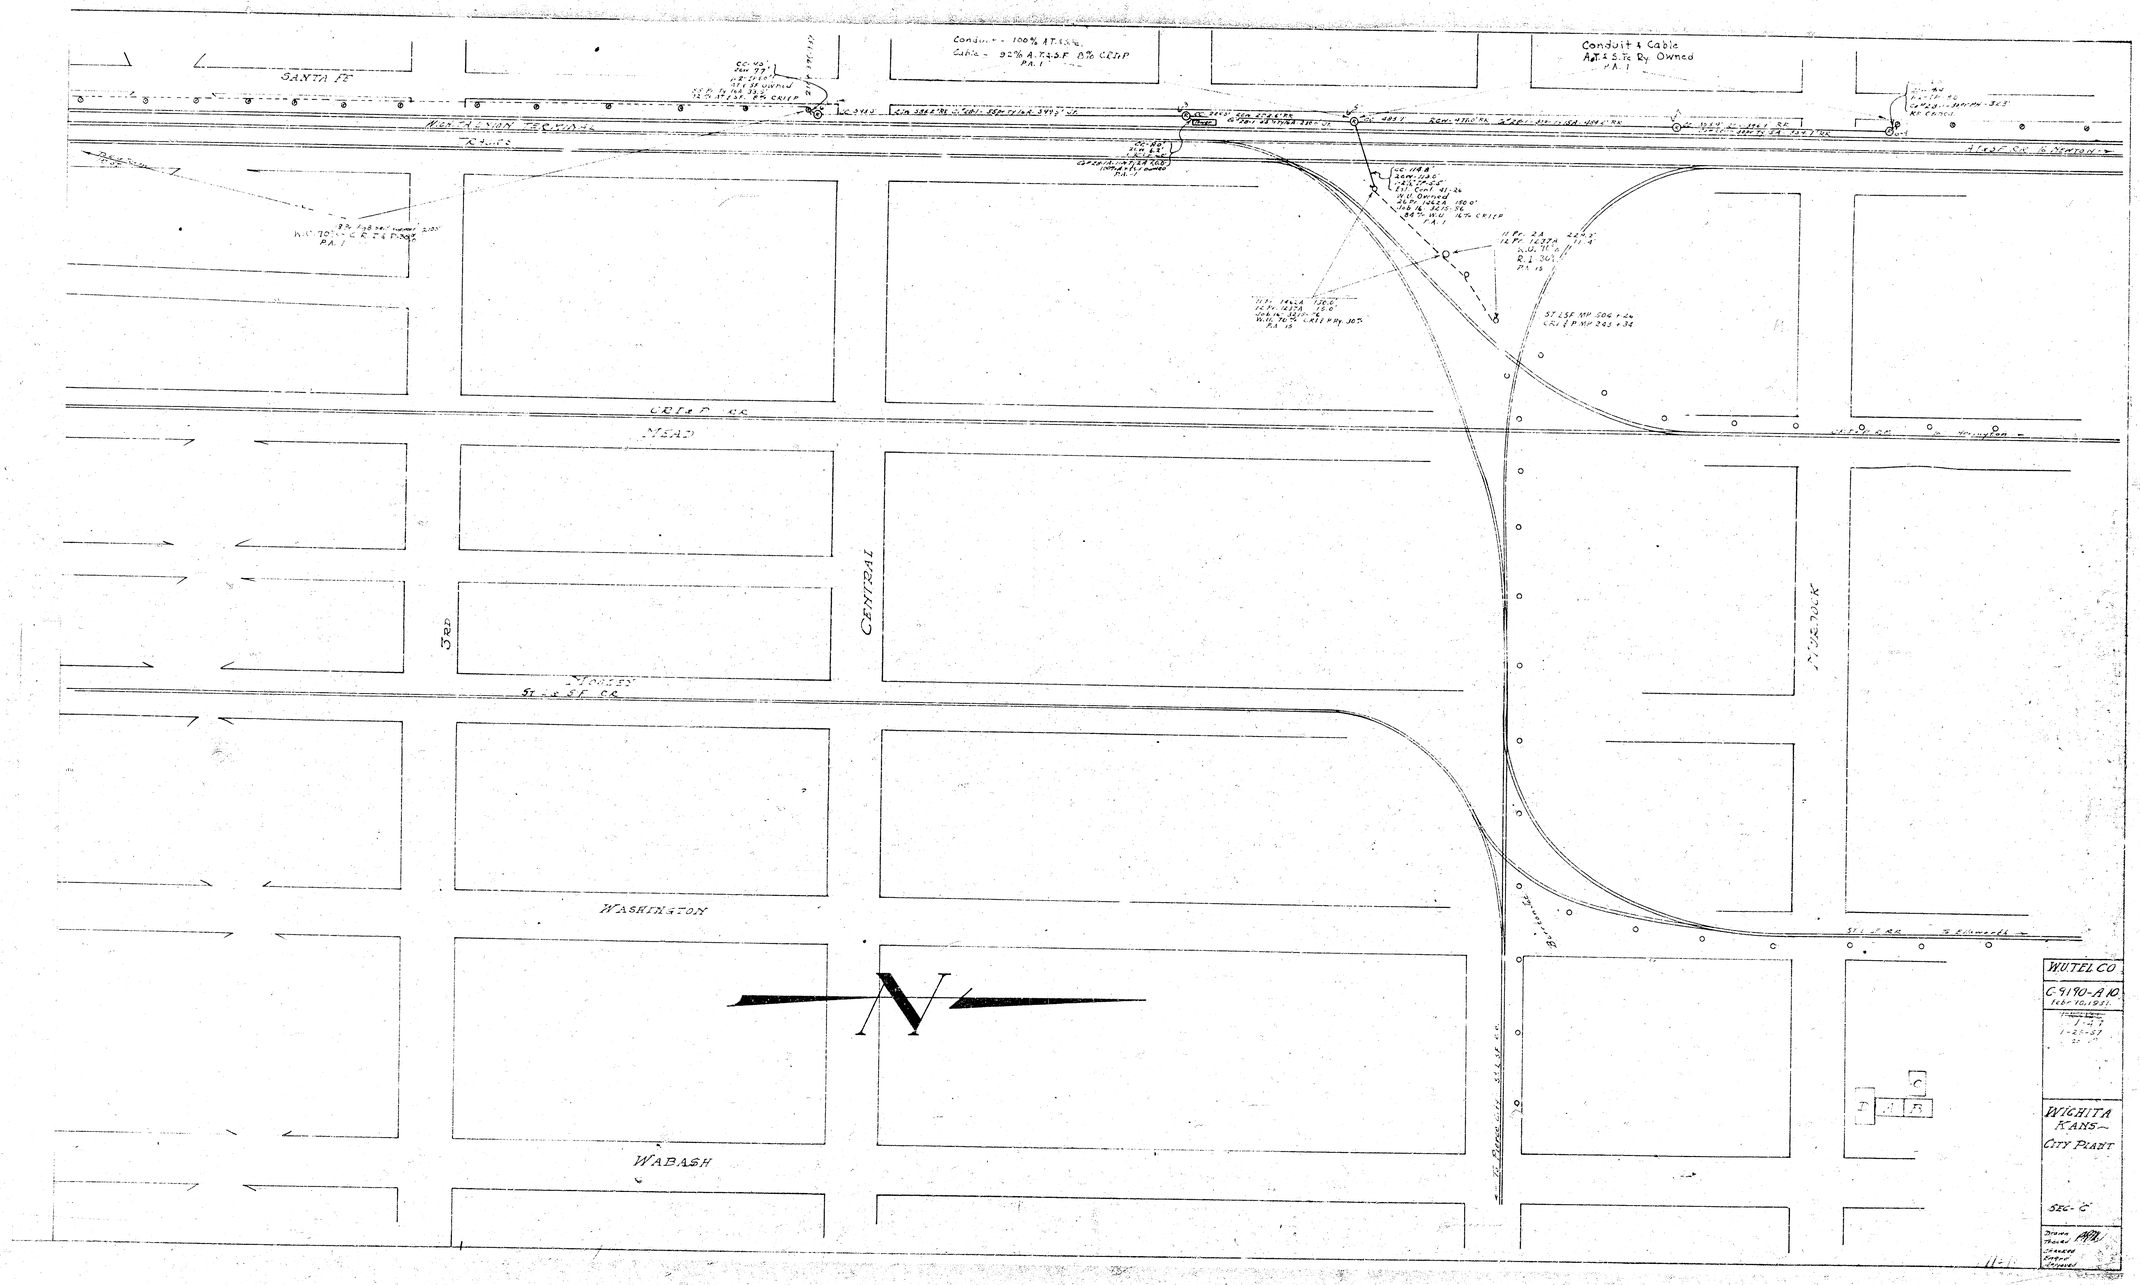
SANTA FE
Conduit - 100% A.T.&S.Fe.
Cable - 92% A.T.&S.F. 8% C.R.I.&P. P.A.1
Conduit & Cable
A.T.&S.Fe Ry Owned
P.A.1
MISSOURI PACIFIC
C.R.I.&P.
ATSF or N Newton
W.U. 70 C.R.I.&P.
P.A.1
CRI&P or
MEAD
CENTRAL
3RD
ST L-S-F or RR
WASHINGTON
WABASH
Pt Pac
ST L-S-F or RR
E Ellsworth
WUTEL CO
C-9190-A10
WICHITA KANS.
CITY PLANT
SEC. C
DRAWN
TRACED
DESIGN
CHECKED
A
B
C
D

N

Boulevard Hotel

4 Gutters 500.0 L.

CC-22.9
2-CWD 2.0↓
SA-1-M 30 P. Ty 15A-51.5
100% MoP&C

CC-178.5
2-CWD 160.7
SA 1-M-30 P. Ty 15A
100% MoP&C

WACO

5T

Jefferson Terrace

WEBB

M.P. DEPOT

Gunite Ty 5A 1283

DOUGLAS ST

FIRST ST

SECOND ST

THIRD ST

WICHITA ST

M.P. RR

E-470-27

See Sec. A

W.U. TEL CO.
C 9190-A 10
Feb 7, 1951
1-11-52
4-9-53
1-8-69

CITY PLANT

SEC-D

NOTE:

FIRST ST

K.G.&E.

WICHITA CLUB

SCOTTISH RITE TEMPLE

WESTERN LITHOGRAPH

WESTERN UNION BLDG

WICHITA TOWN CO.

WACO ST

WEBB ST

WICHITA ST

GAYETY BLDG.

LASSEN HOTEL

NEW PLAZA BLDG

NEW UNION NAT'L BANK BLDG

SWEITER BLDG

DOUGLAS ST

CENTRAL BLDG

BOSTON BLDG.

BEACON BLDG

Cascade Hotel

WILLIAMS

WHEELER-KELLY HARDWAY

INNES STORE

UNION NAT BANK

WARIS

CIVIC CENTER

NEW LIBRARY

CITY HALL

INNES PARKING BLDG

SUTTON PLACE

ENGLISH

WATER

MAIN

MARKET

BROADWAY

TOPEKA

EMPORIA

ALL PROPERTY ON THIS SHEET IN P.A.-5L

WU TEL CO

C-9190-AID

WICHITA KANS. CITY PLAN

SEC-A-

WATER CO.

WICHITA KANS. CITY PLANT

Sec. B

INDIANA

OHIO

WABASH

FIRST

LAURA

IDA

ENGLISH

WASHINGTON

TROSLEY

Texico Ft. House

G.C. & S.F. Ft. House

DOUGLAS

MEAD ST

See Sheet 10

Union Depot

WICHITA UNION TERMINAL TRACKS

SANTA FE

ST FRANCIS

WILLIAM

SANTA FE

WICHITA TERMINAL

R.4.E.3

MEAD

3RD

CENTRAL

WASHINGTON

WABASH

N. ROCK

WUTEL CO

C.9190-A10

WICHITA KANS— CITY PLANT

SEC- C

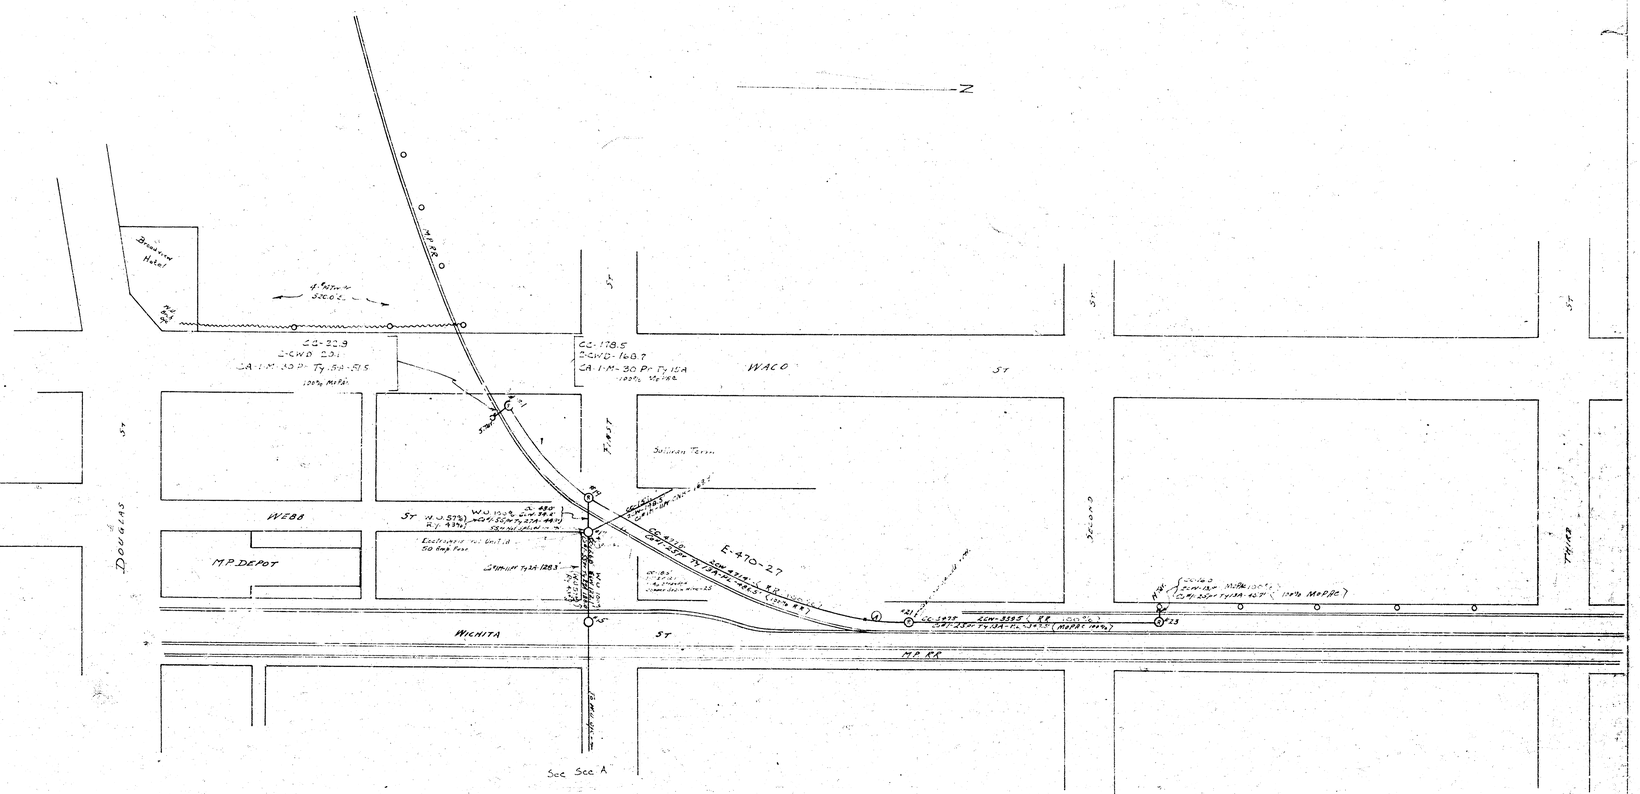

(A) 50mm rubber 600 to MH 21

NOTE: 55M - MH 3 TO MH 4 43% TOA - 57% WU
25M - MH 3 - MH 4 TOA - 100% MoPac
30M - MH 3 TO A - 100% MoPac

	C	
D	A	B

W.U.TEL CO.
C-5190-A-10
Feb 7, 1931.
1-12-37
4-9-38
1-8-69

WICHITA-KS.
CITY PLANT

SEC-D