




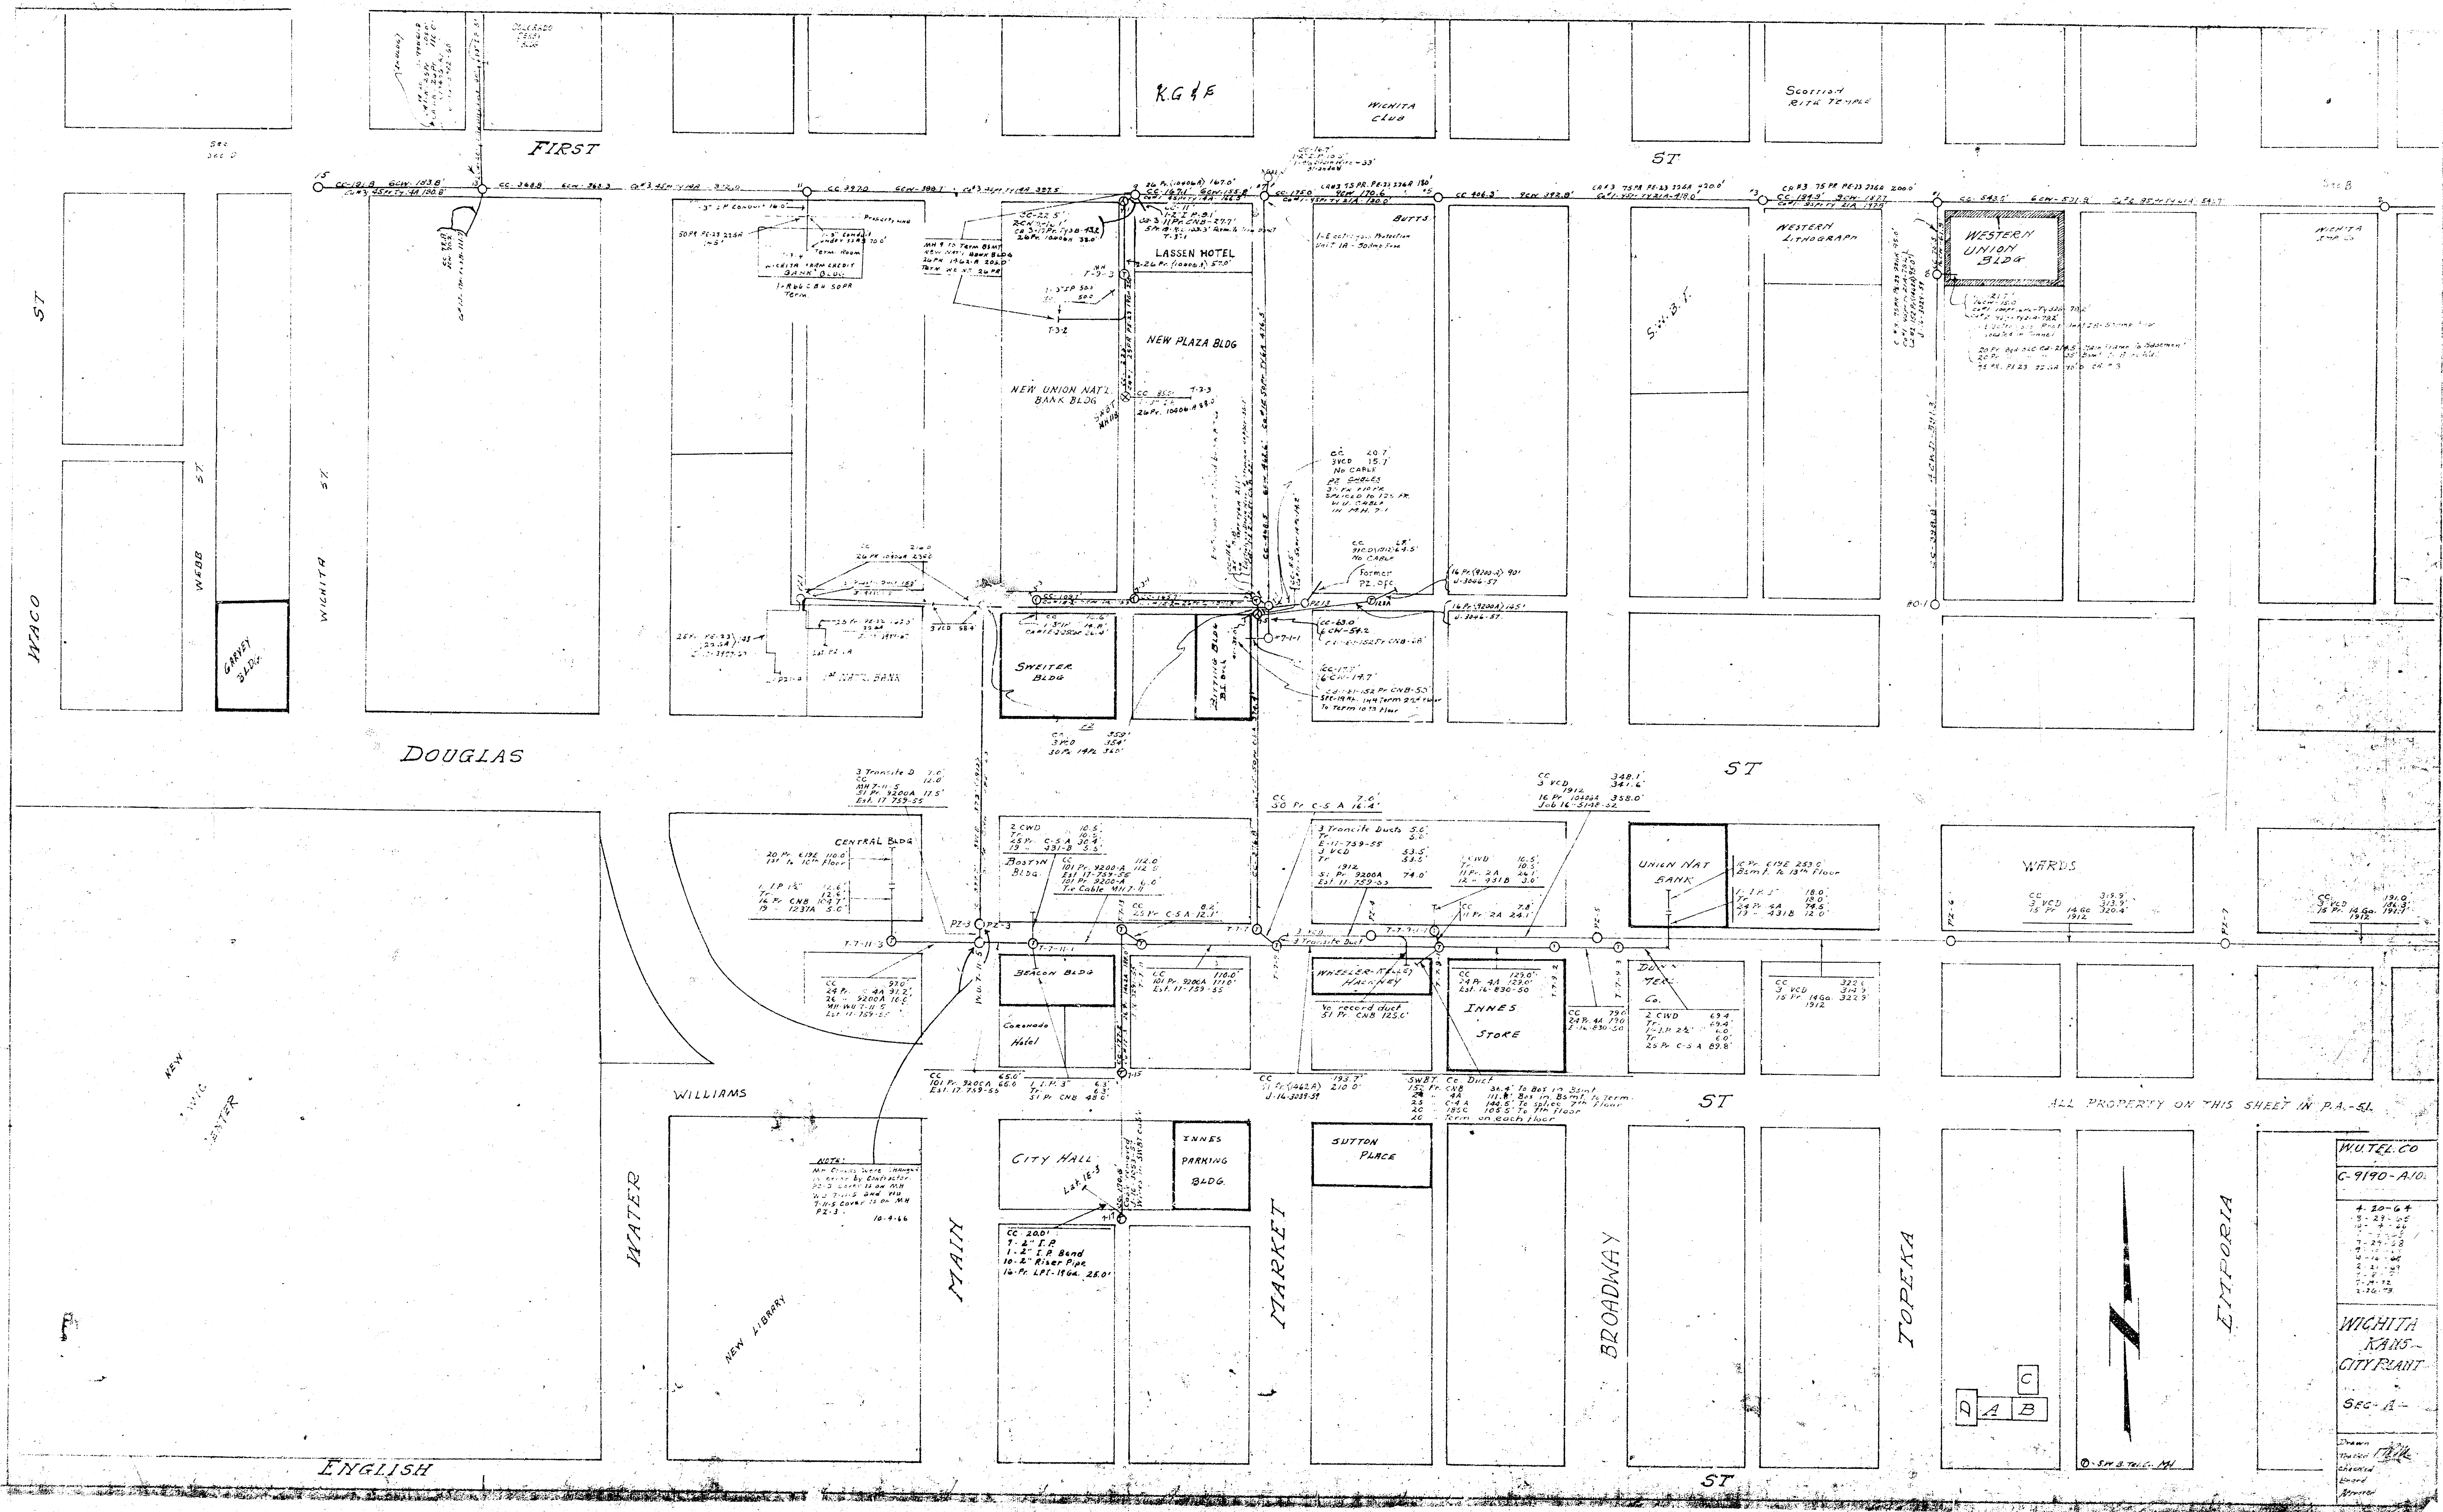



WATER CO	
C-9190-A-10	
4.50-6.4	
1.23-2.5	
WICHITA KANSAS CITY PLANT	
SEC. A	
Drawn	TH
Checked	
Approved	

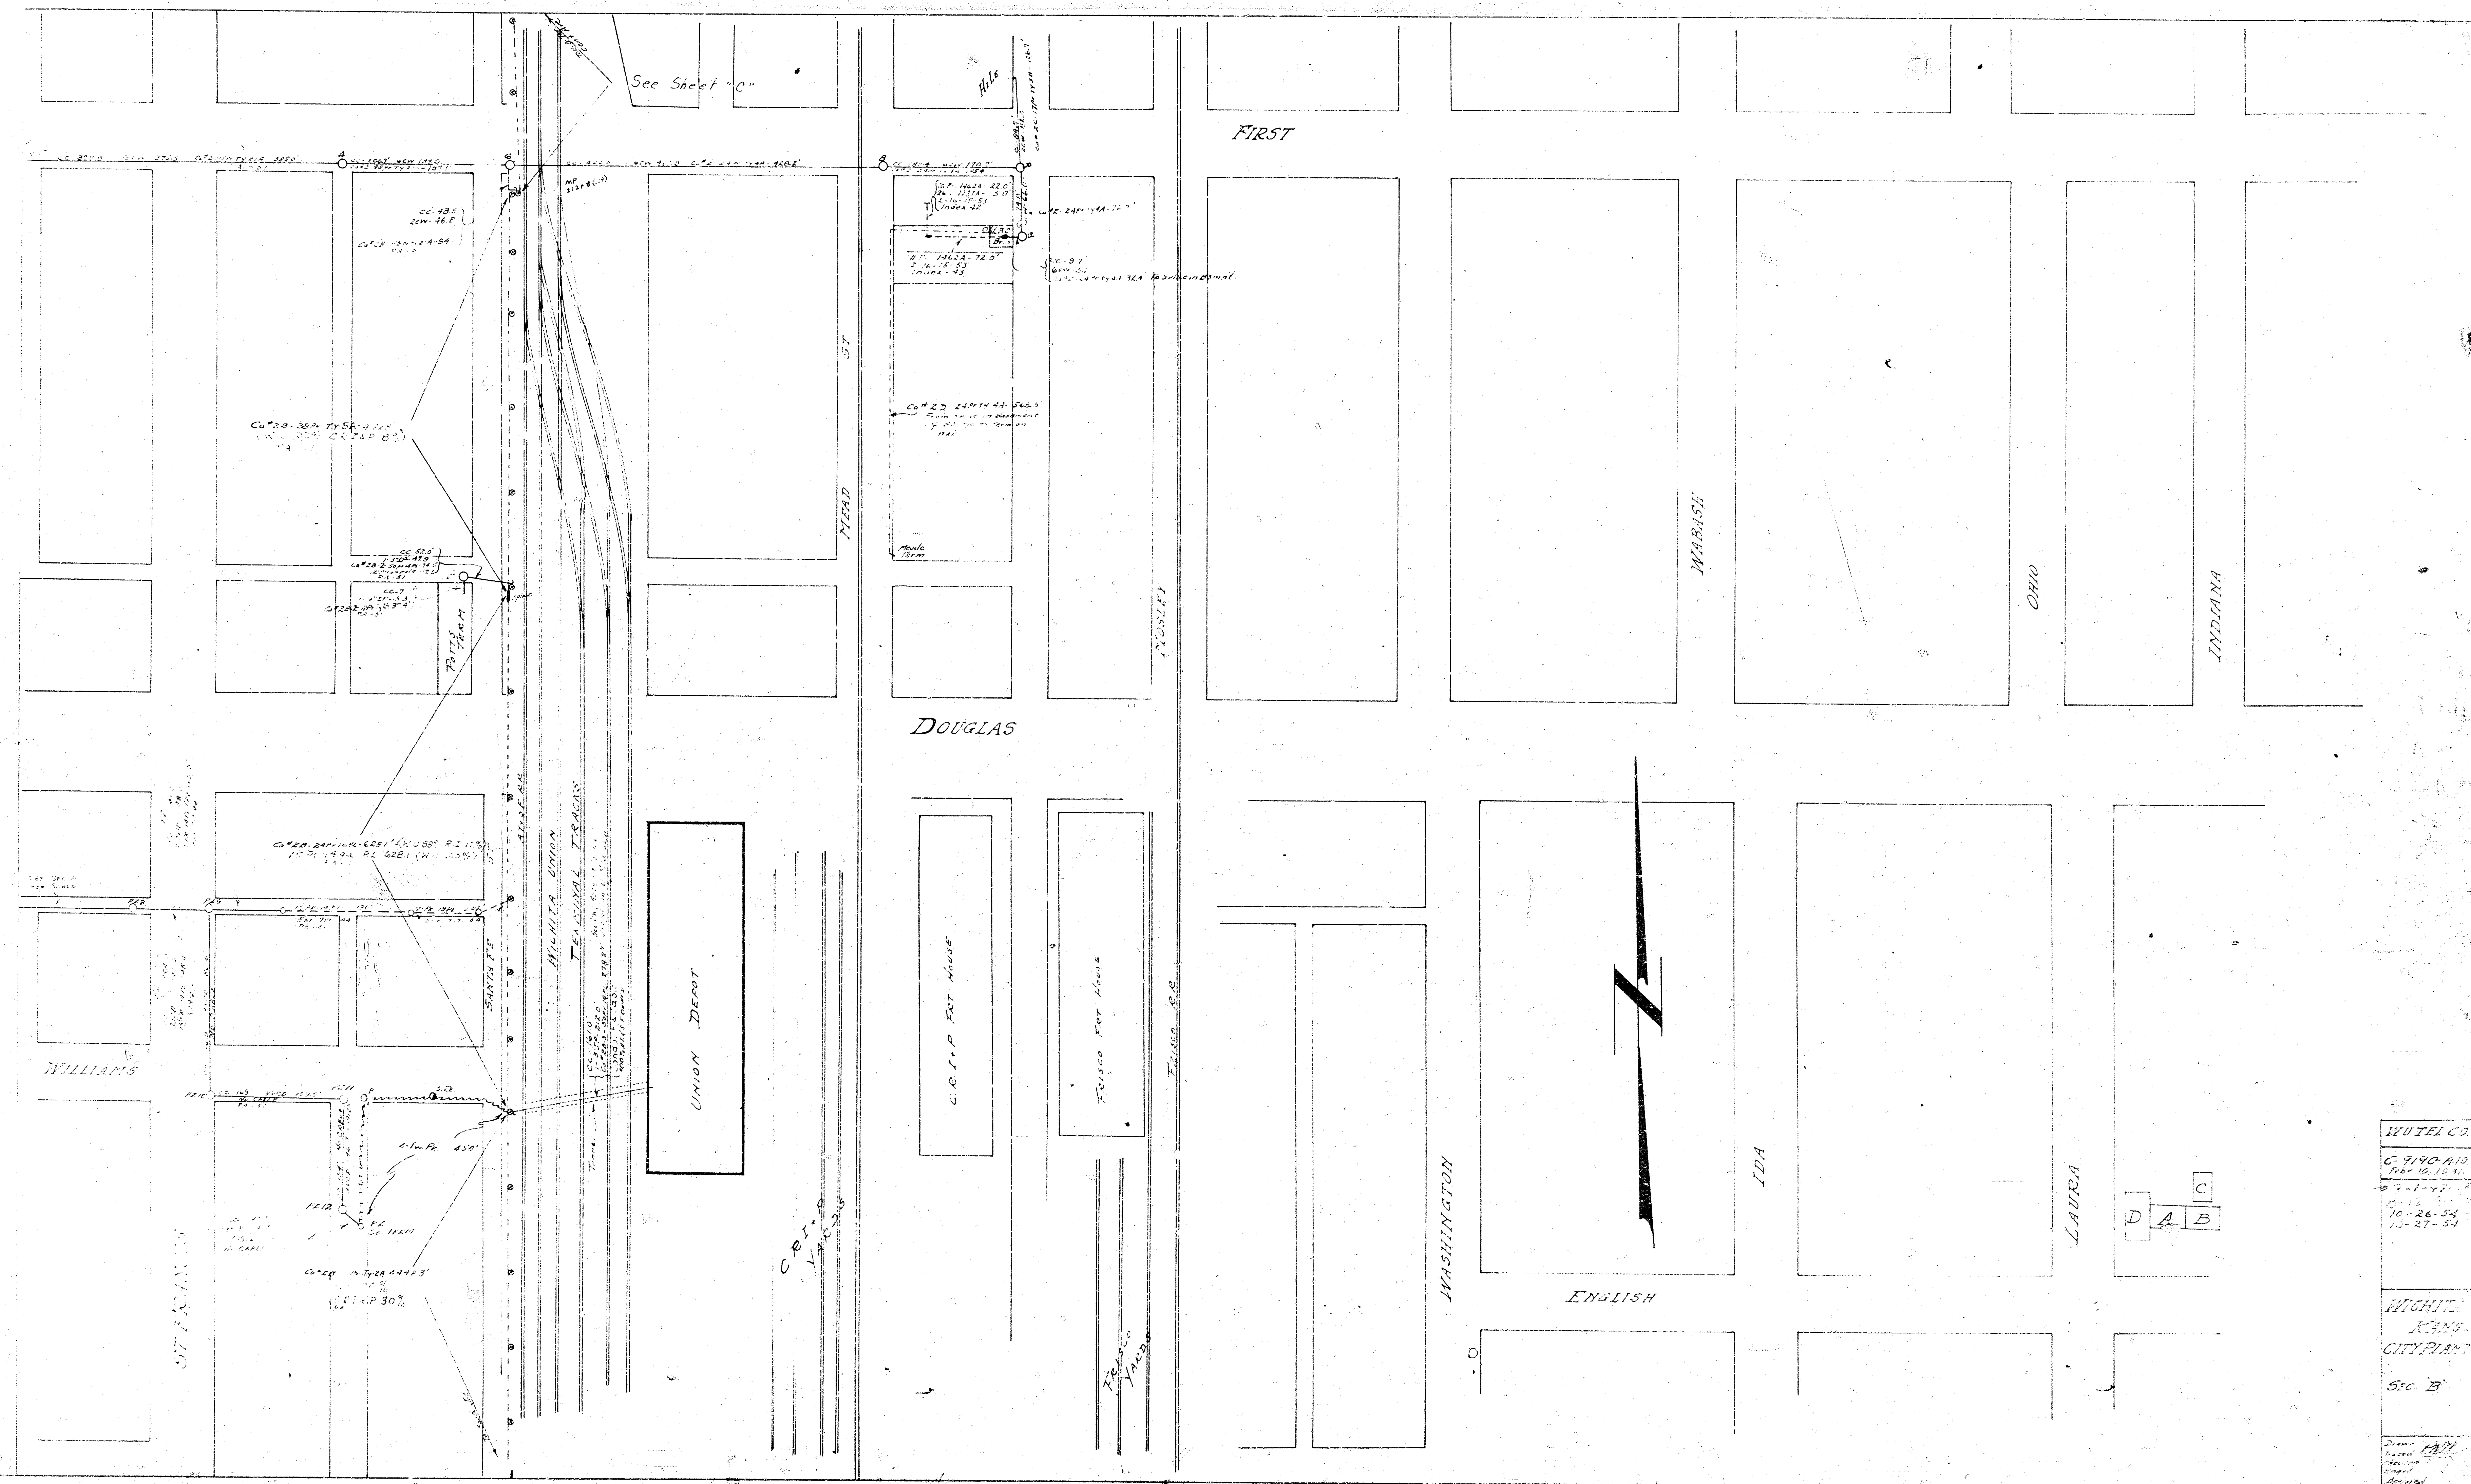

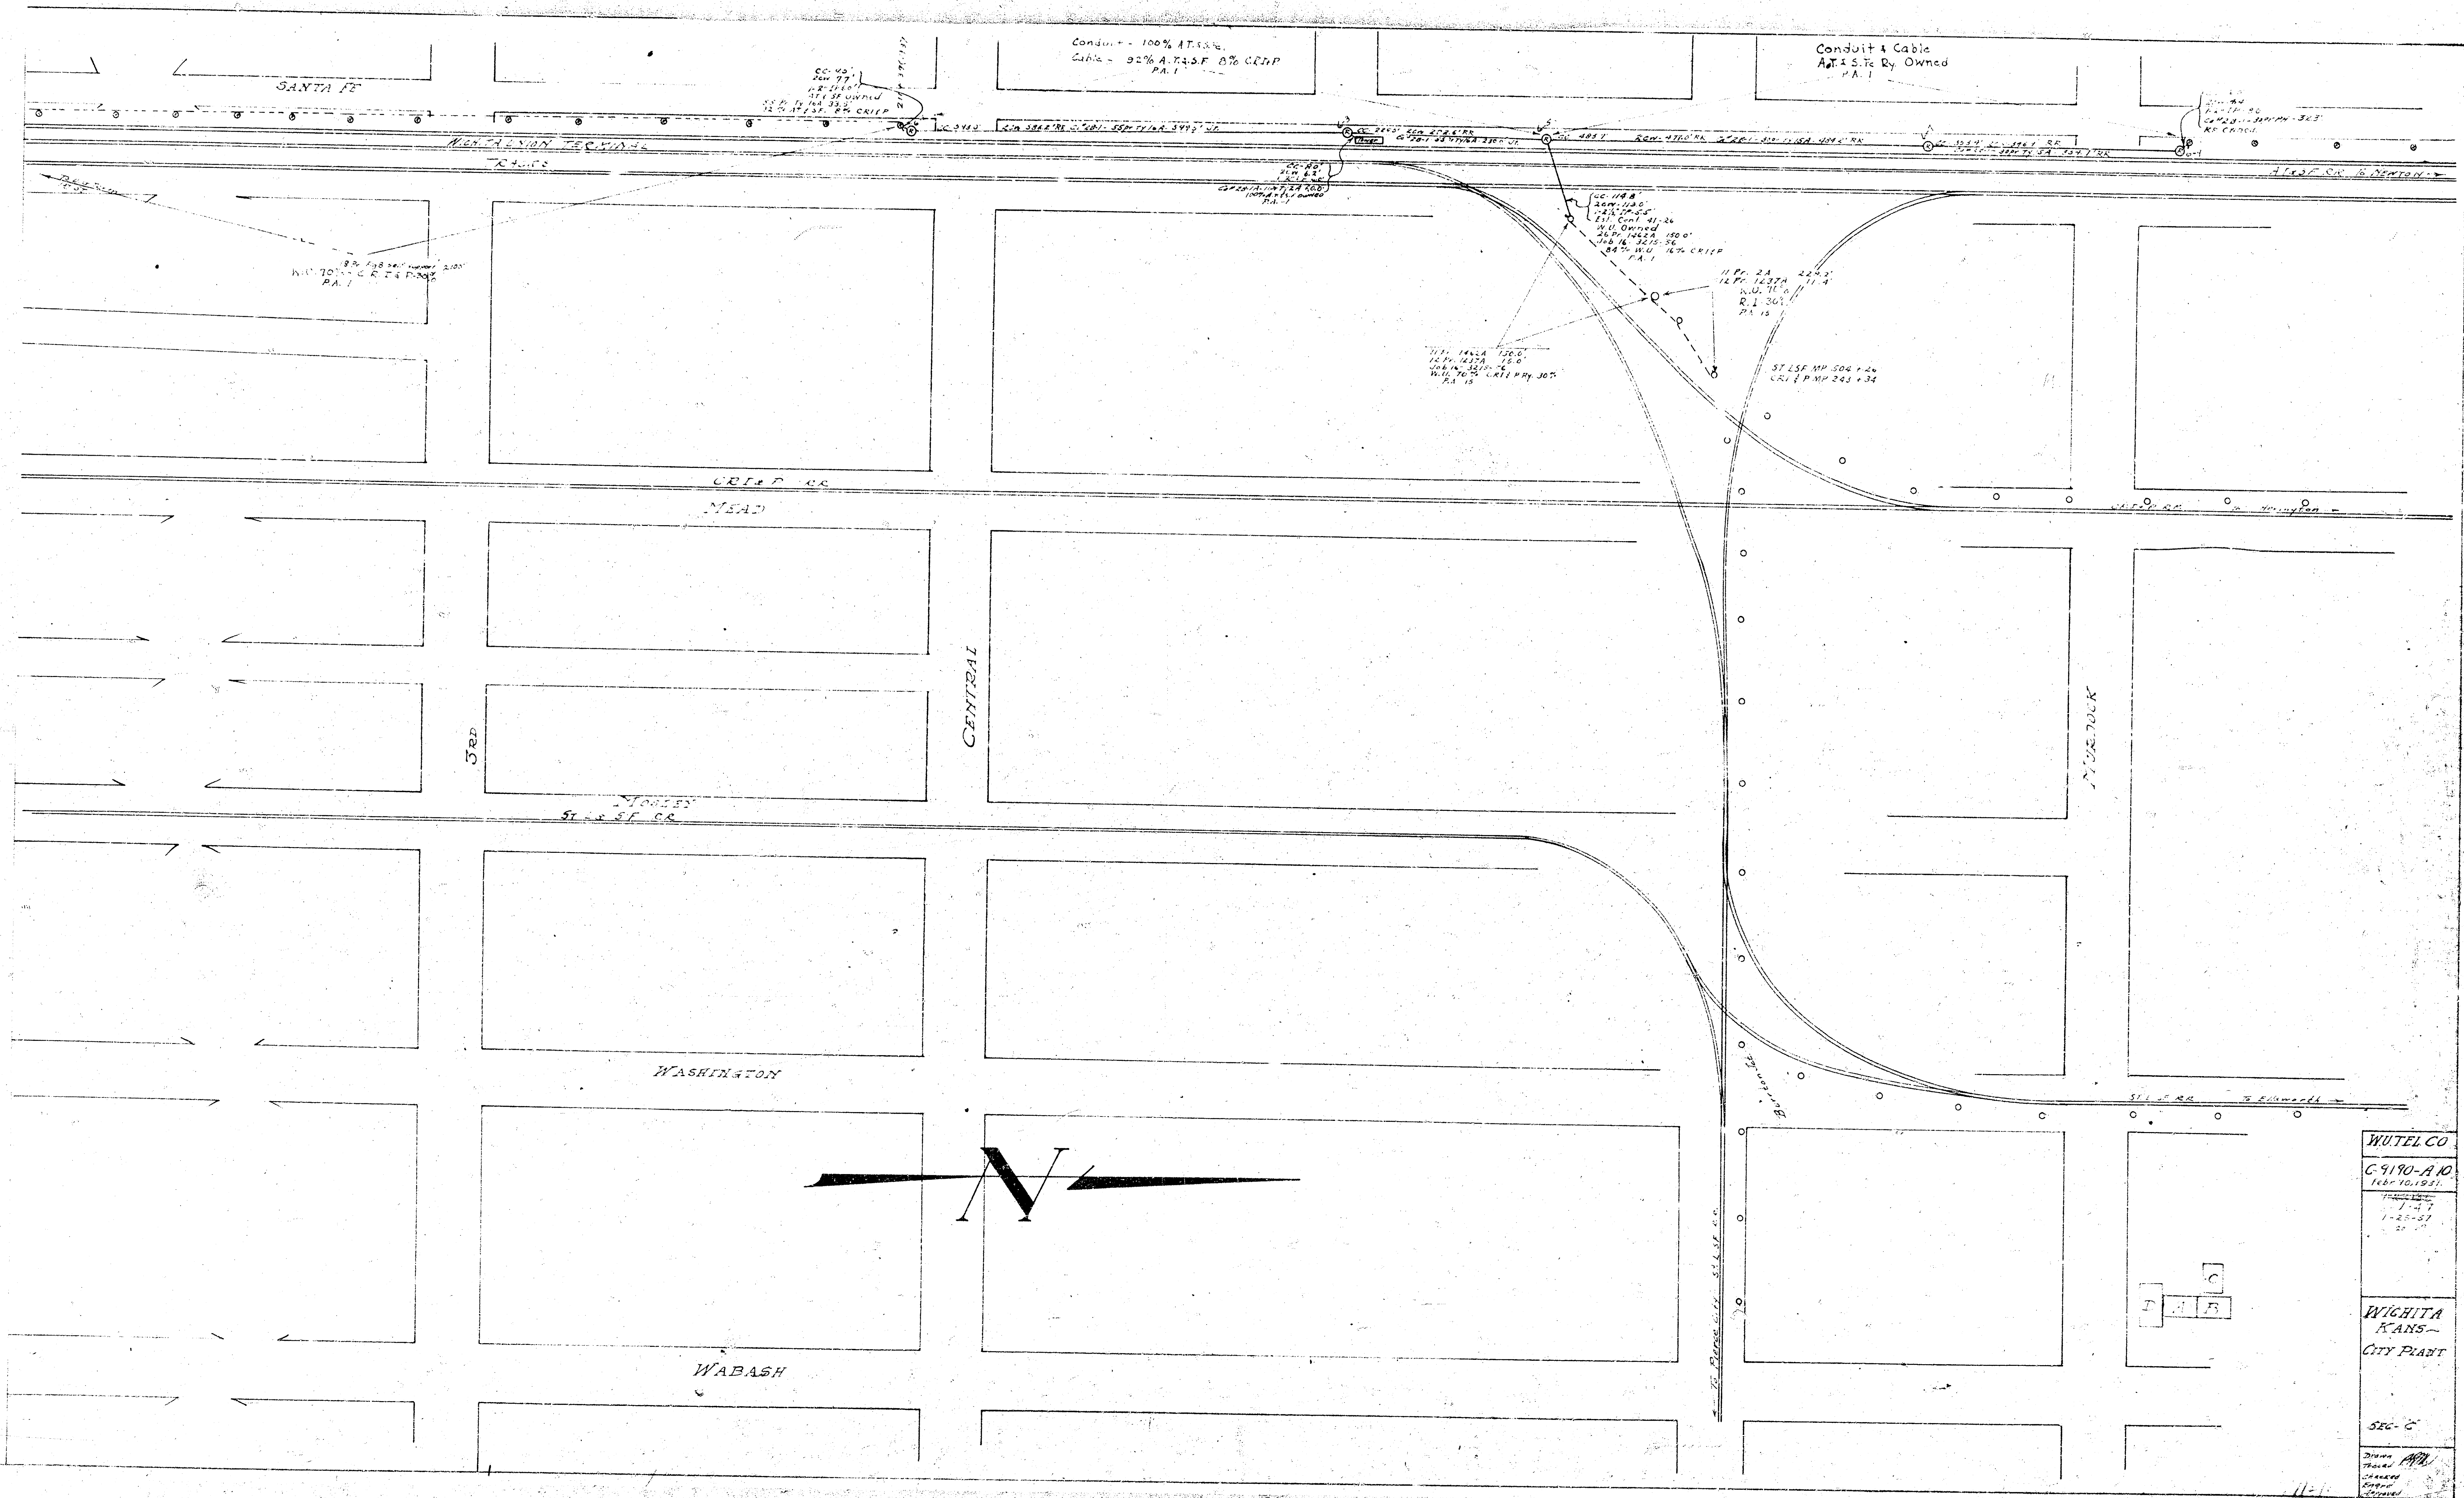


WUTEL CO.
C-9180-A 10
Feb 10, 1921
1-25-27
WICHITA
KANS.
CITY PLANT
Drawn by [signature]
Checked by [signature]
Engineer [signature]

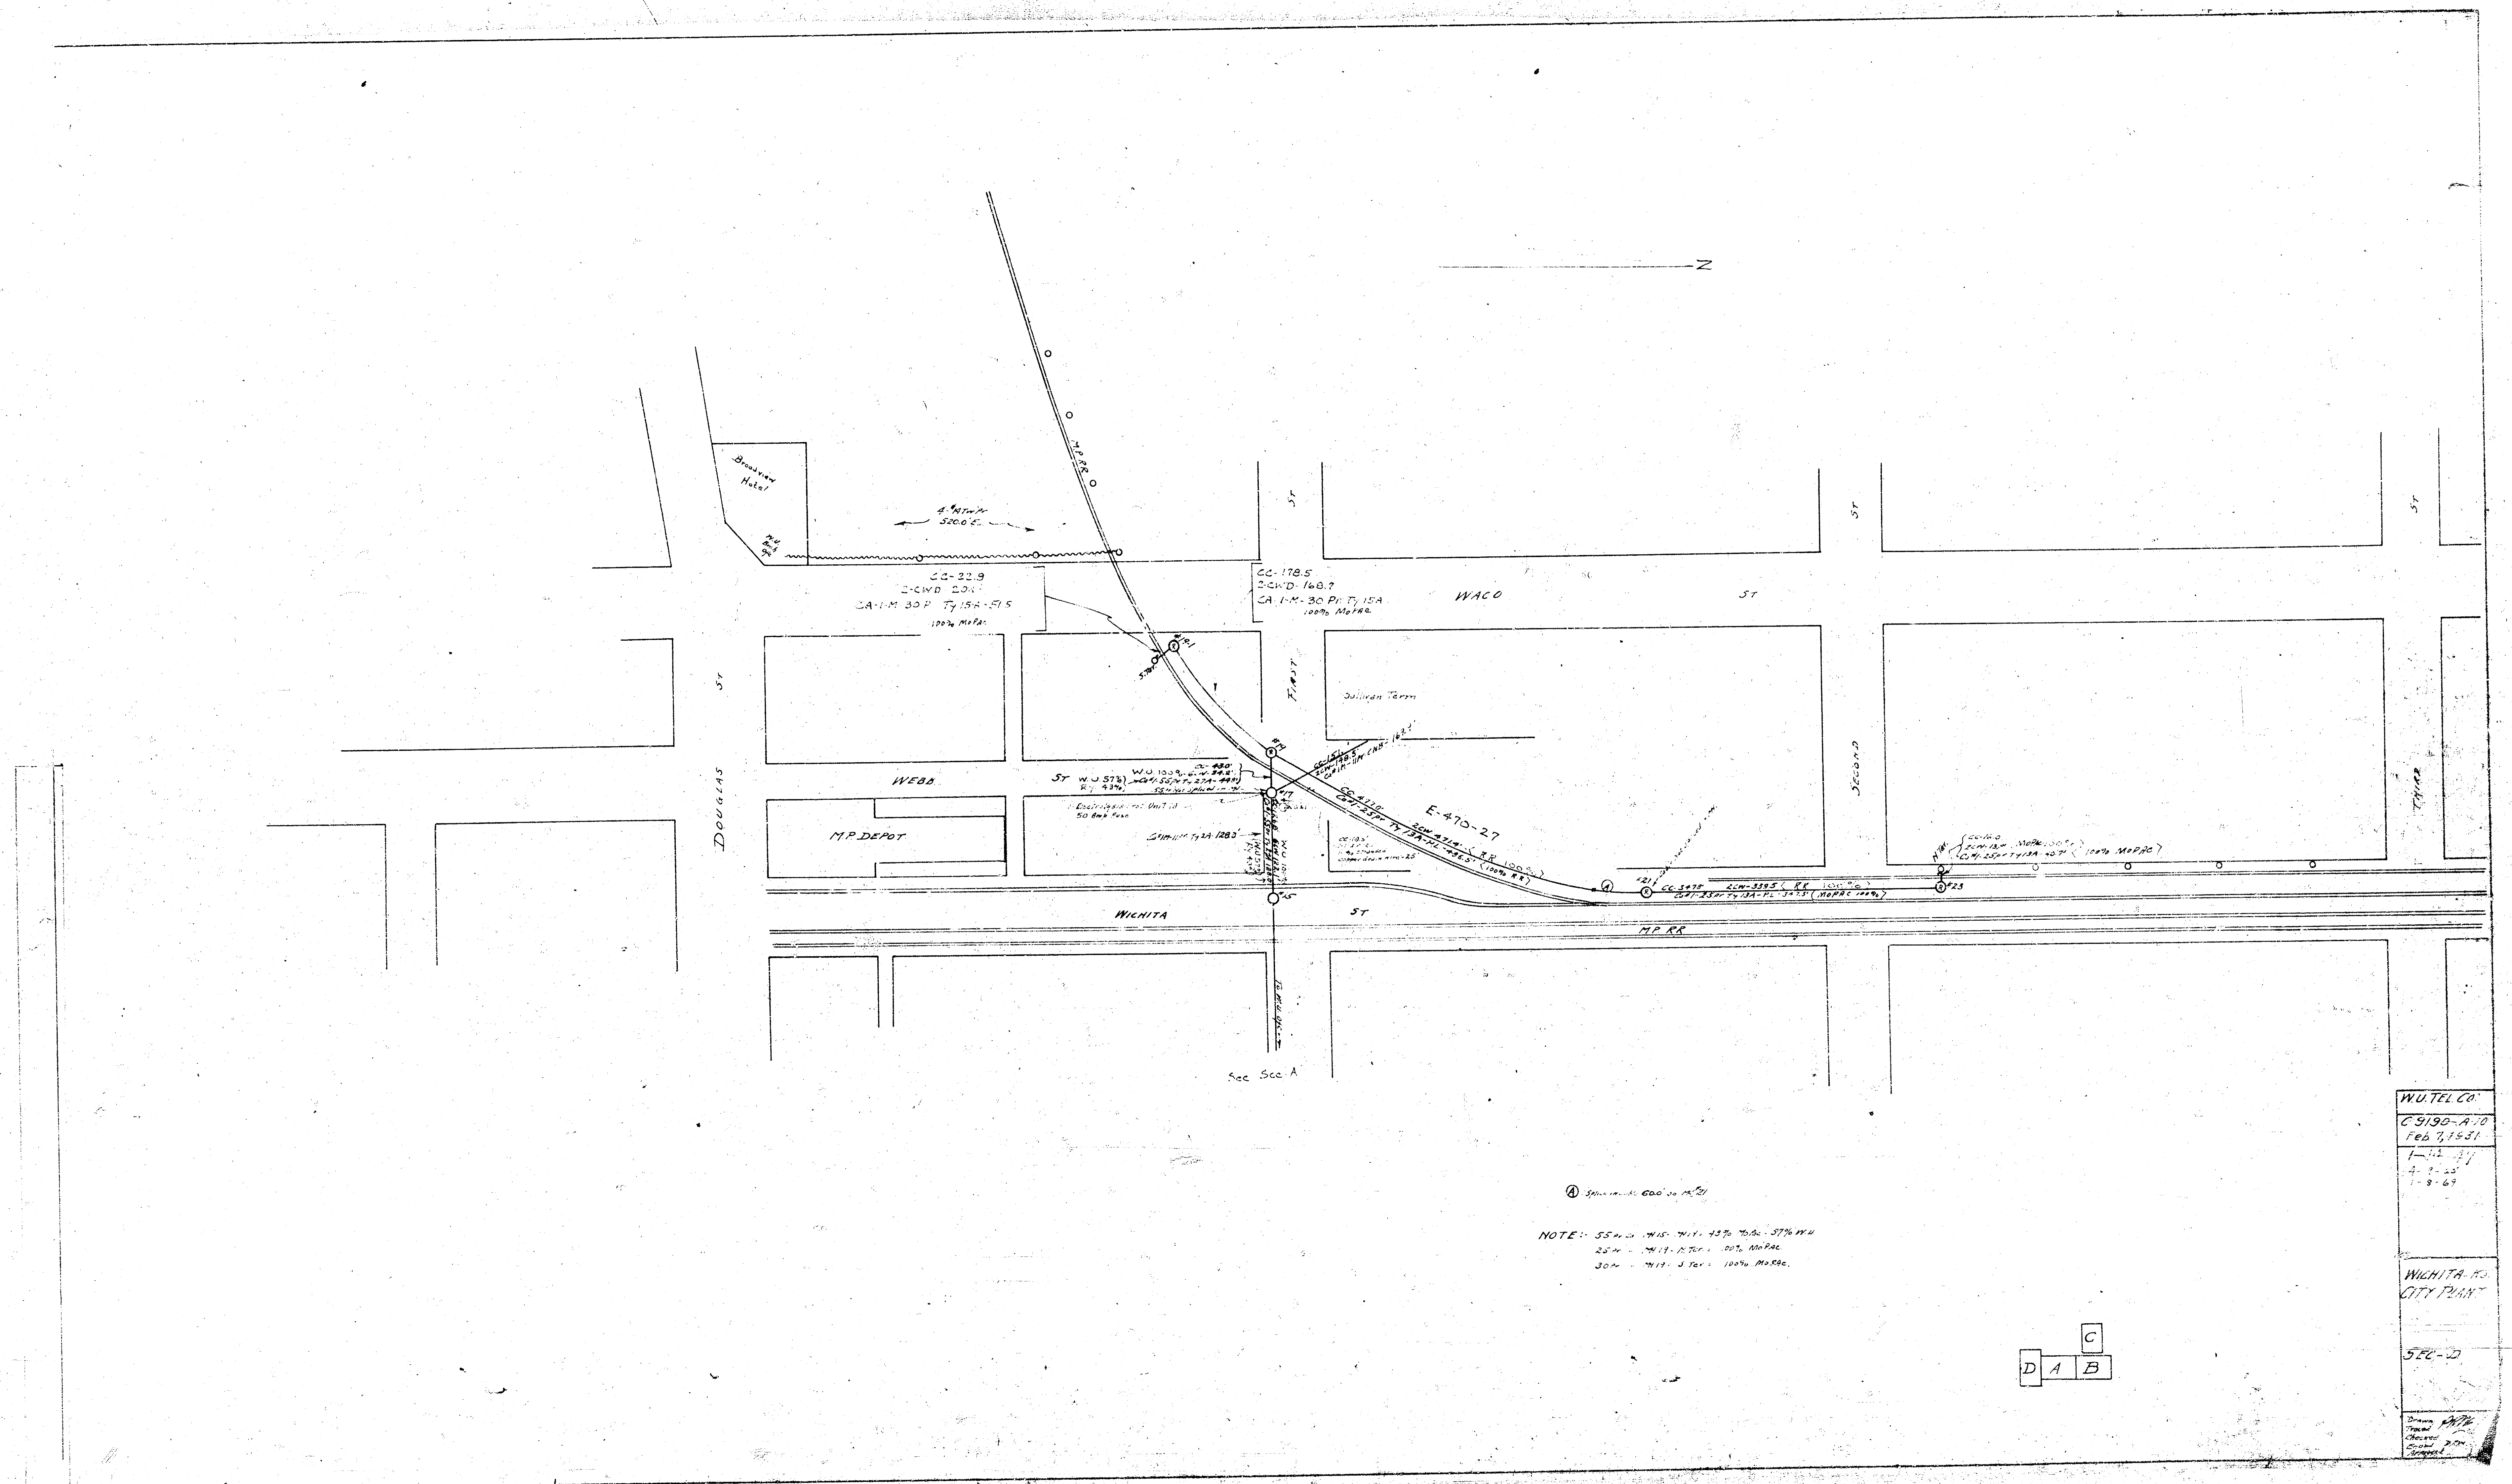


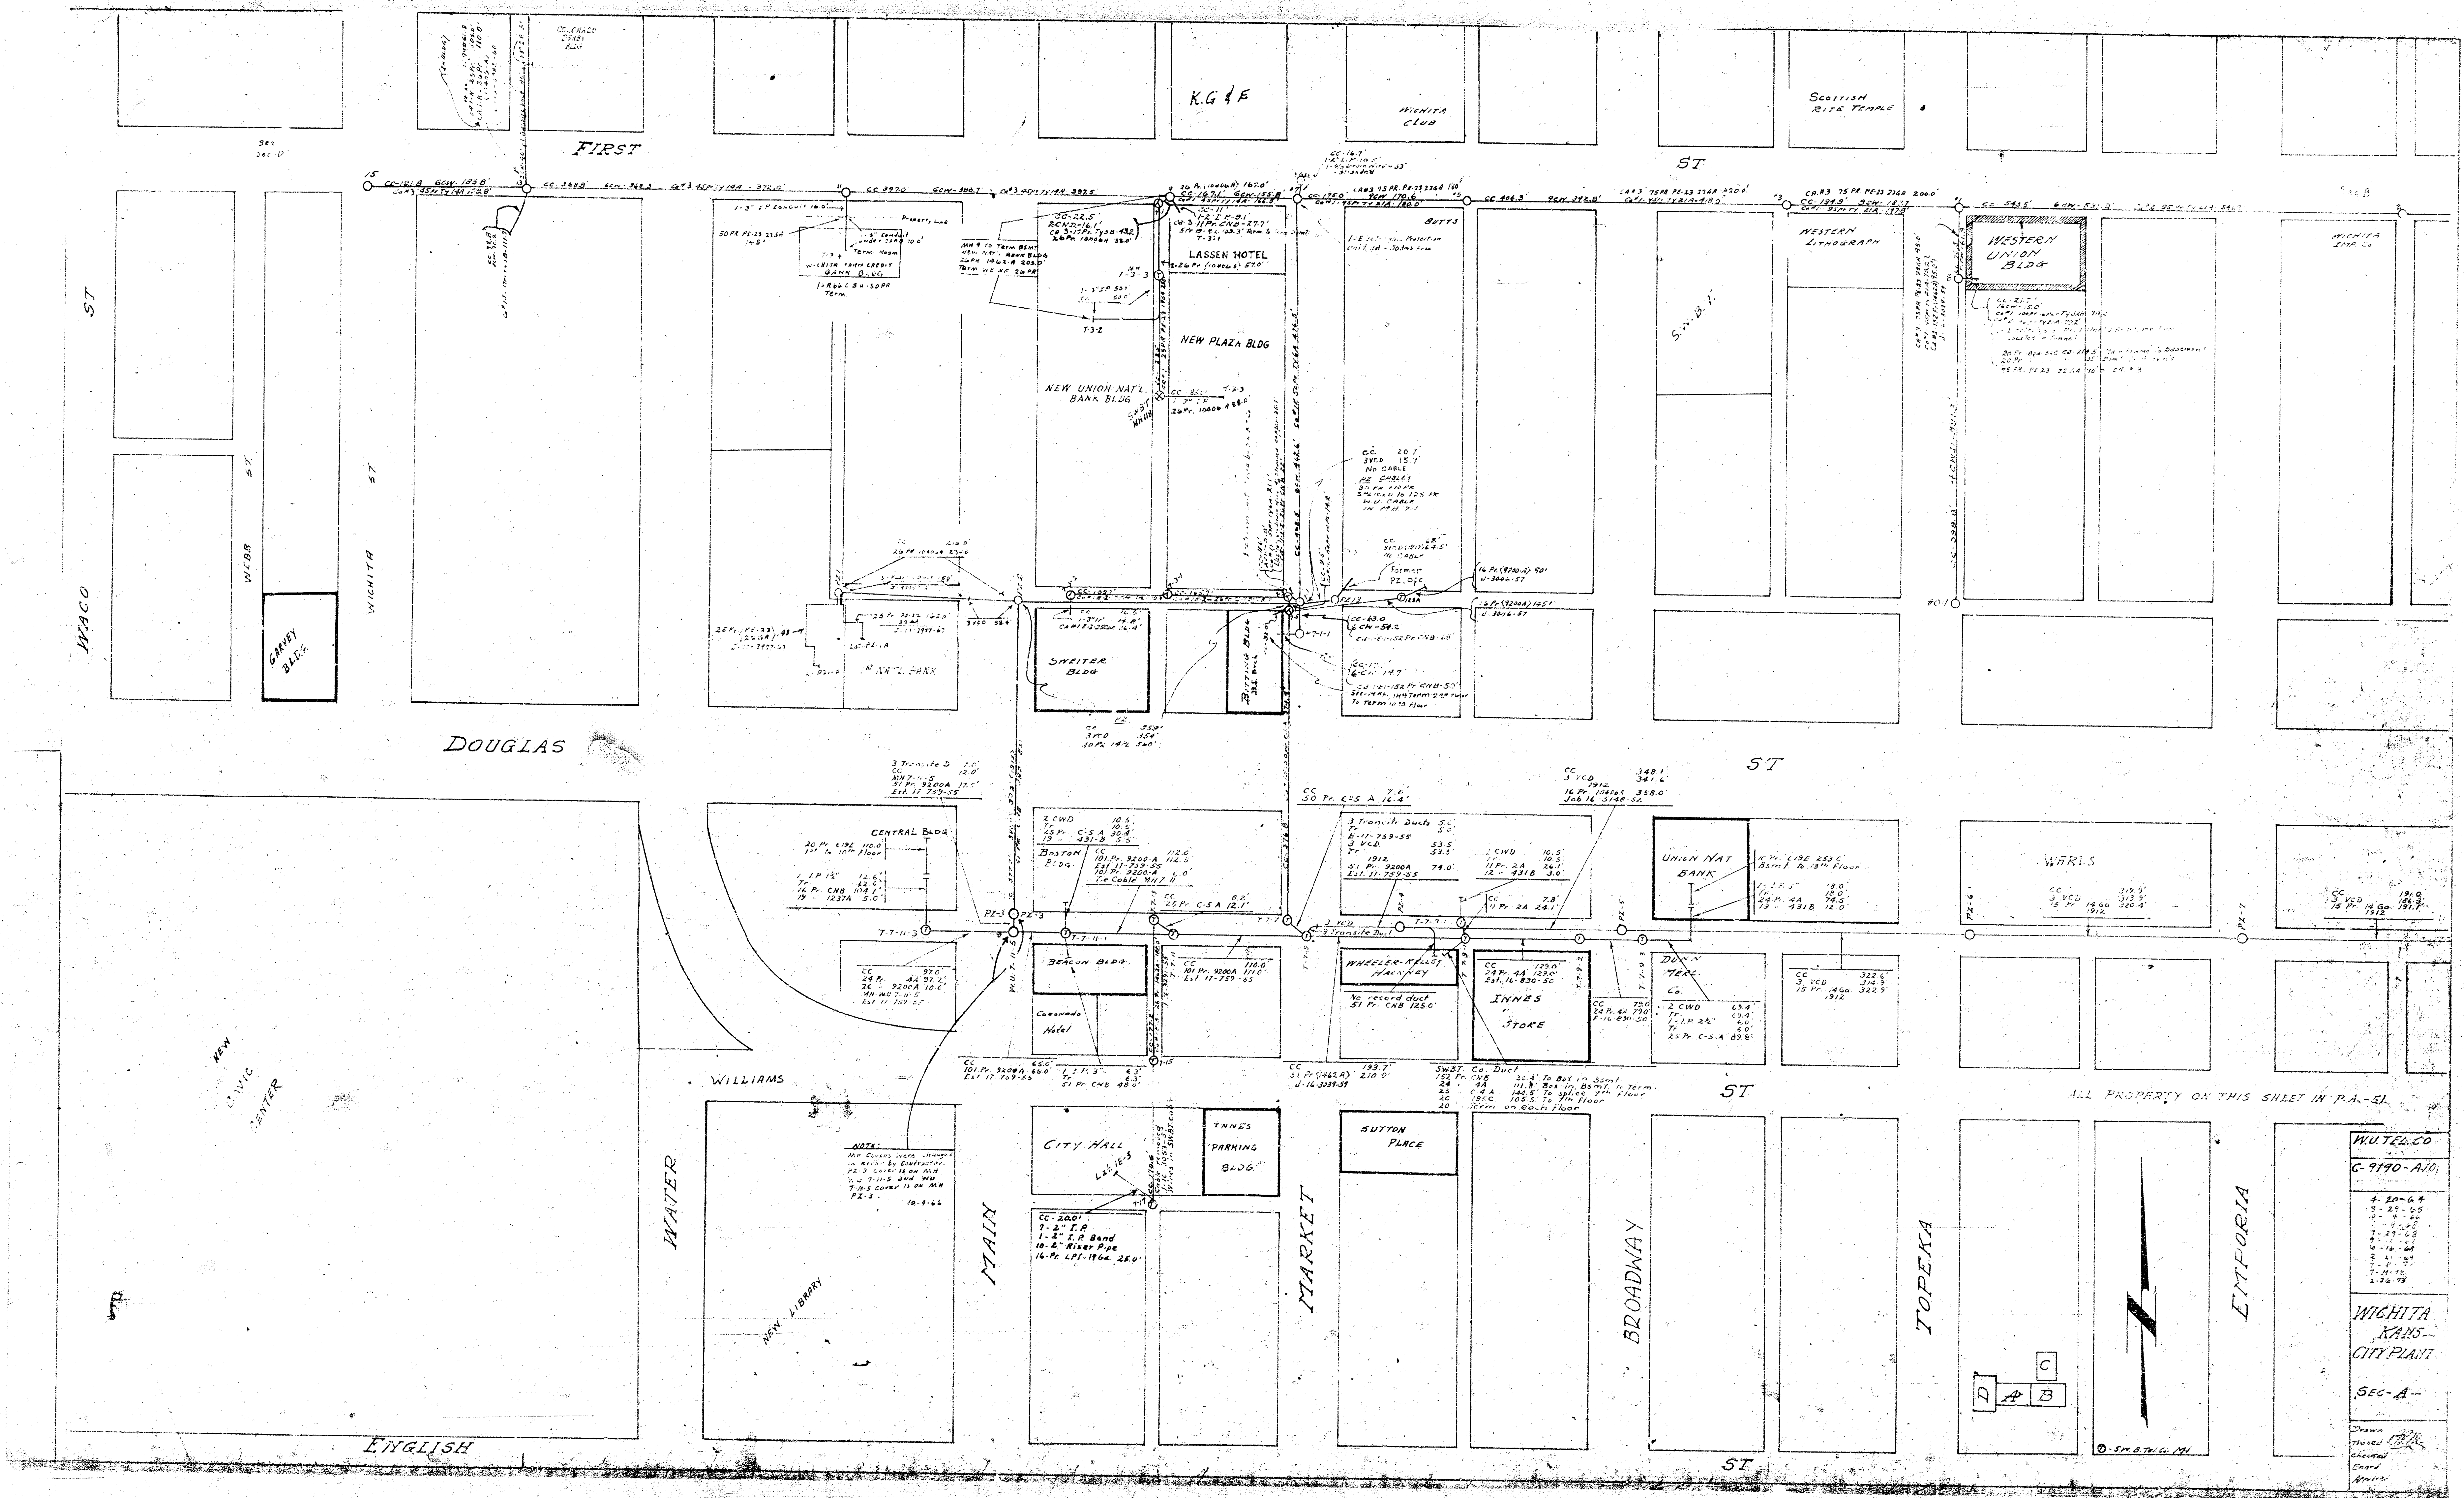


WICHITA
KANSAS
CITY PLAT
SEC. A

Drawn
Checked
Correct
Approved

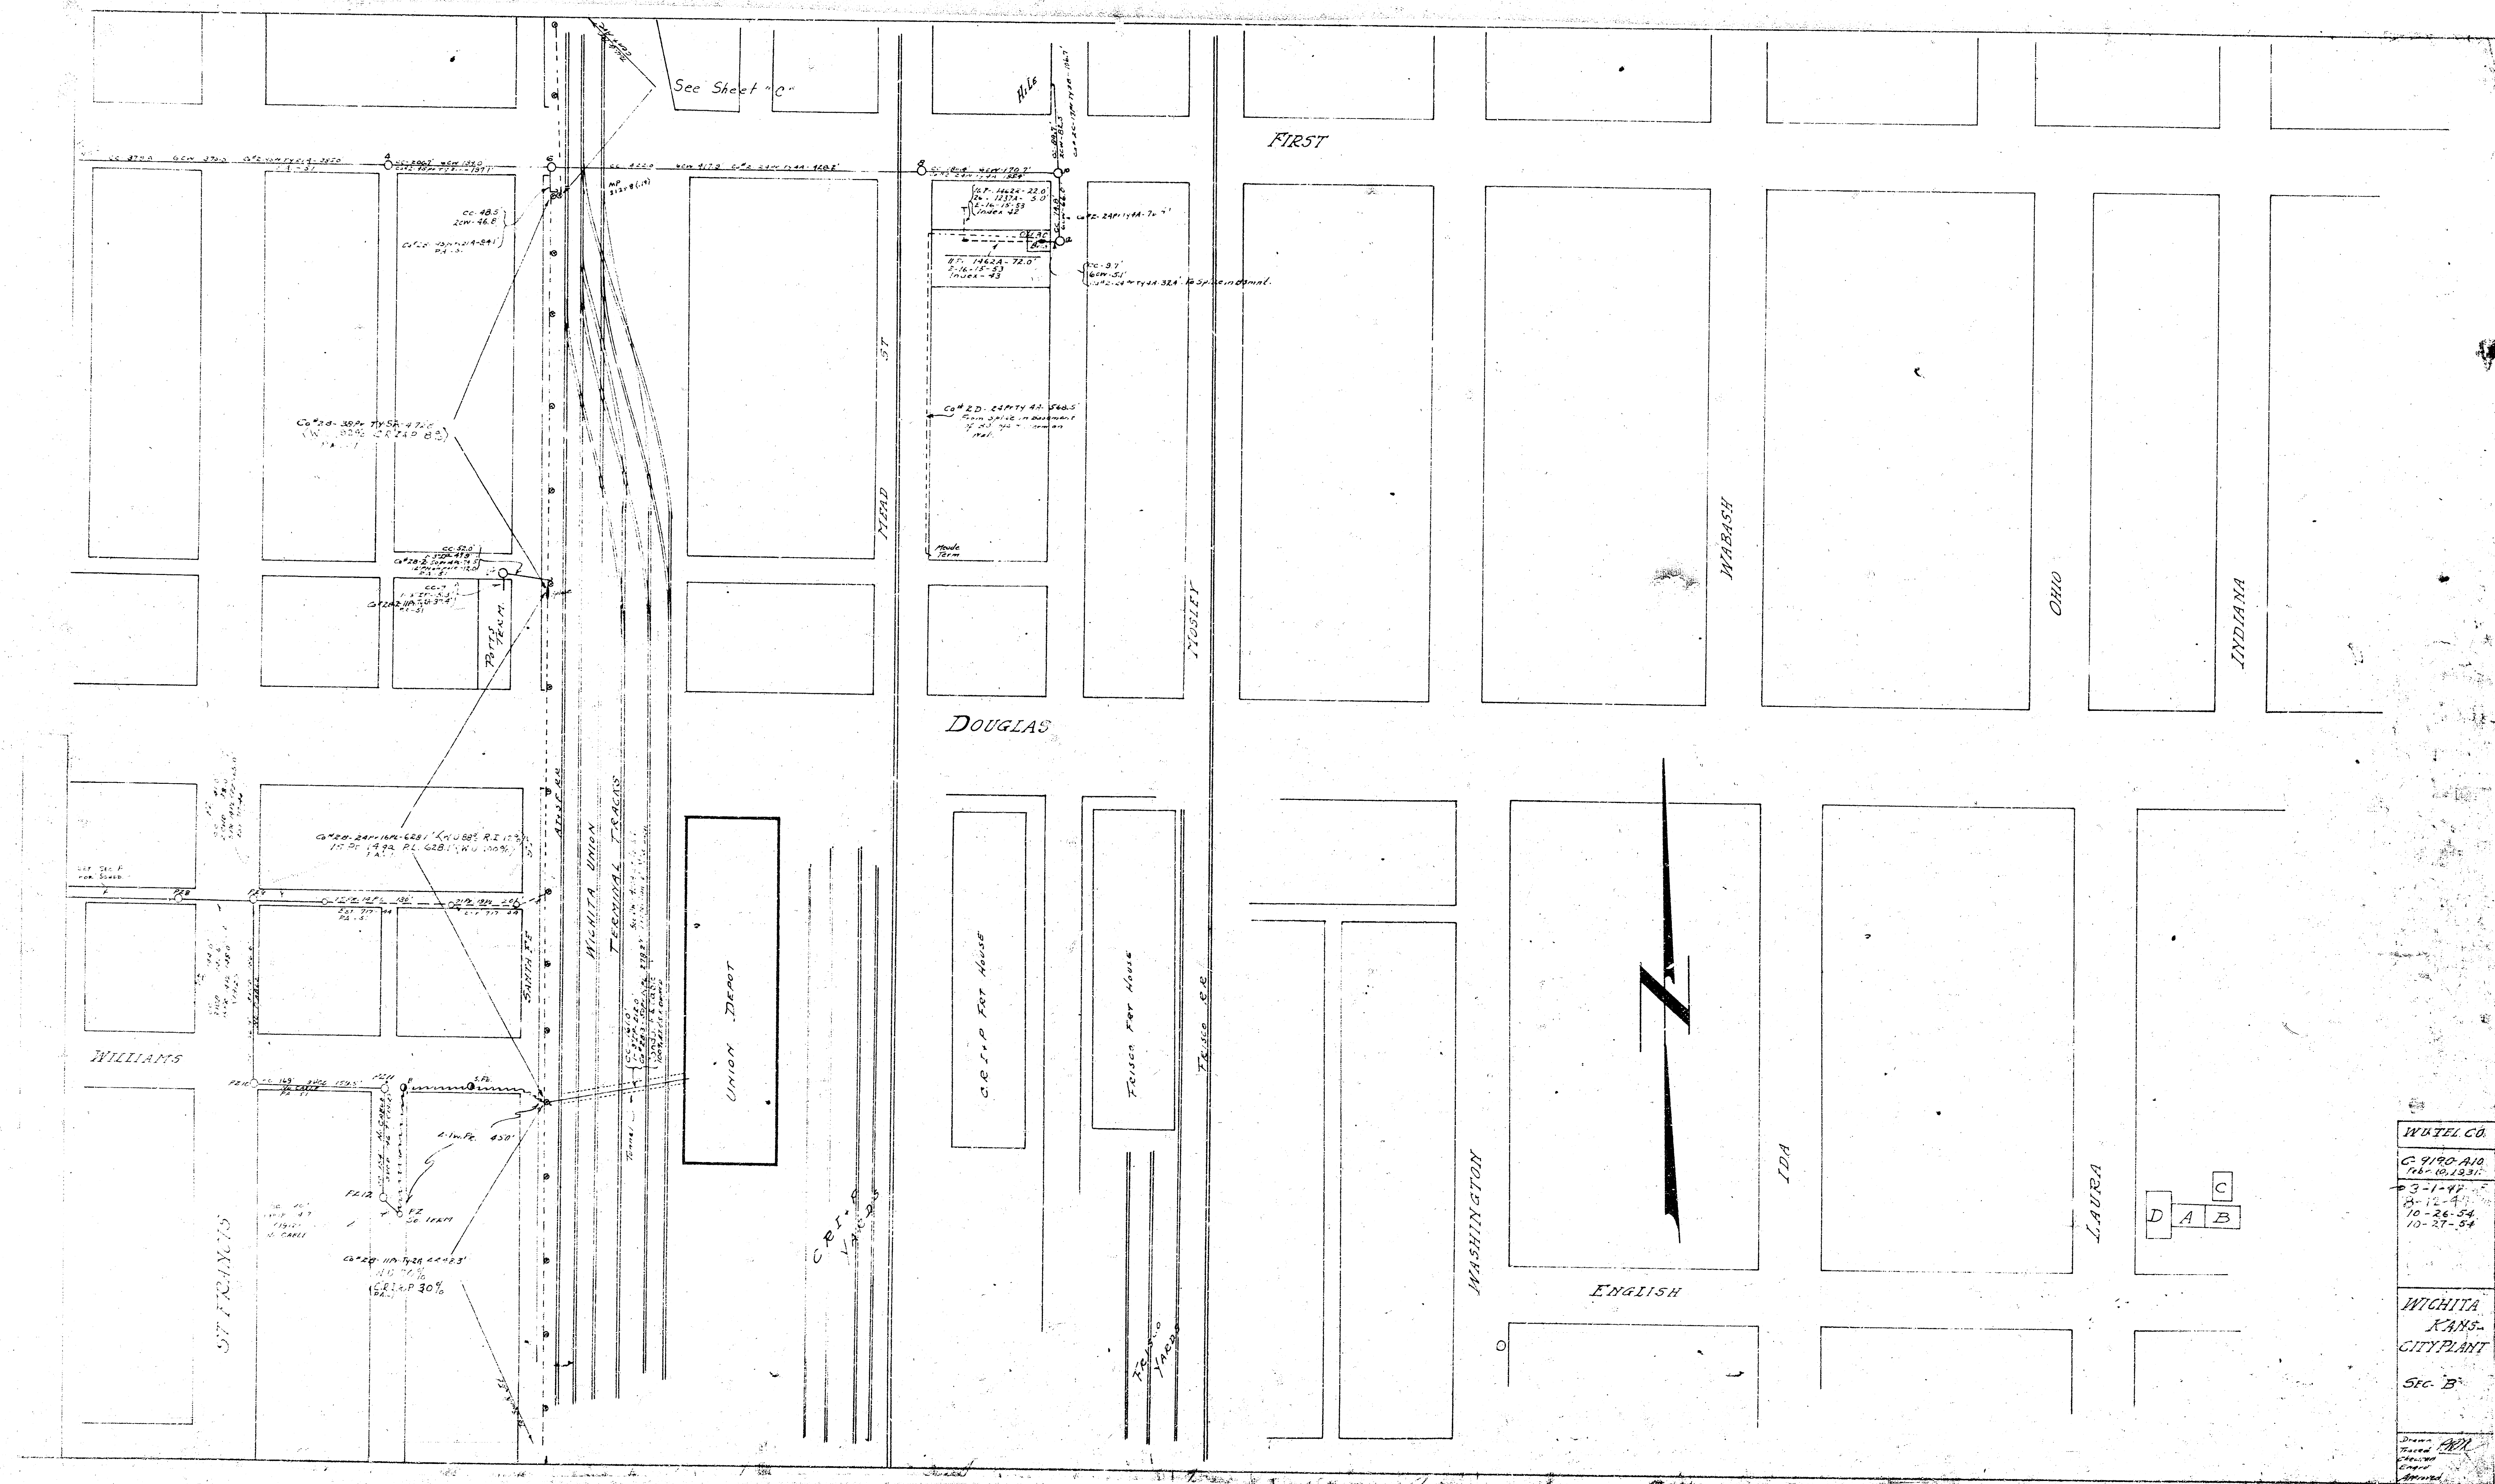

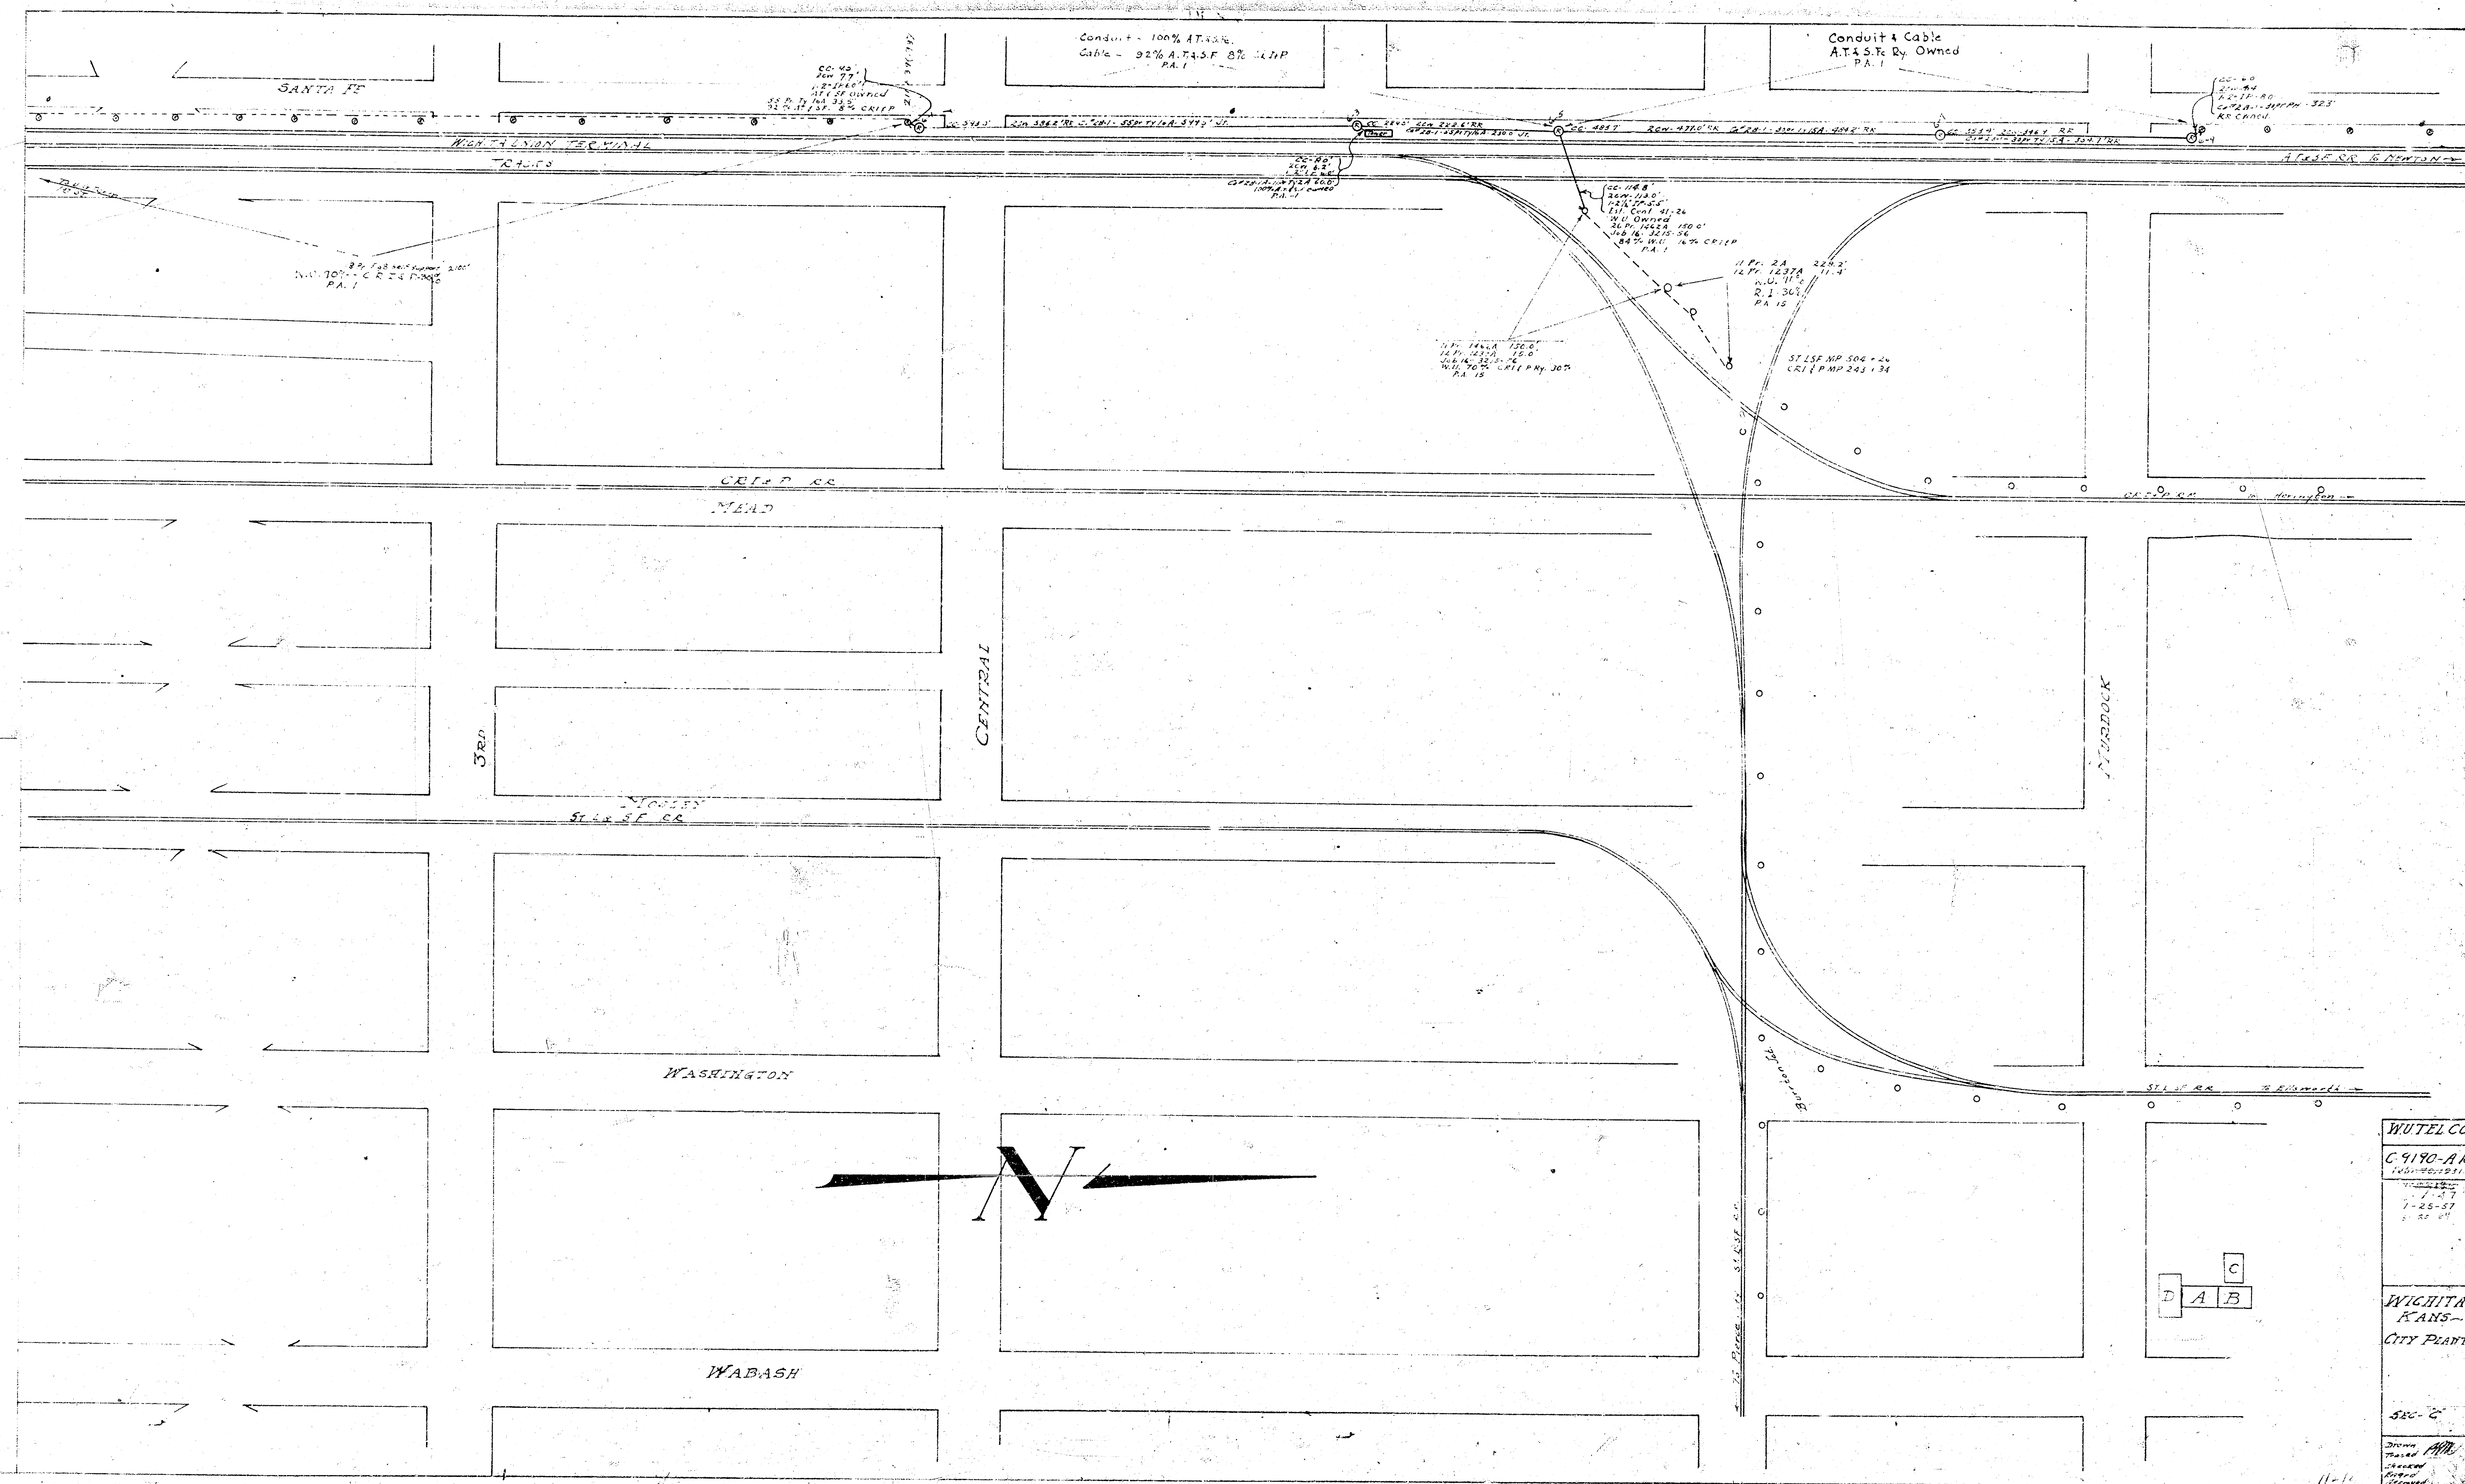

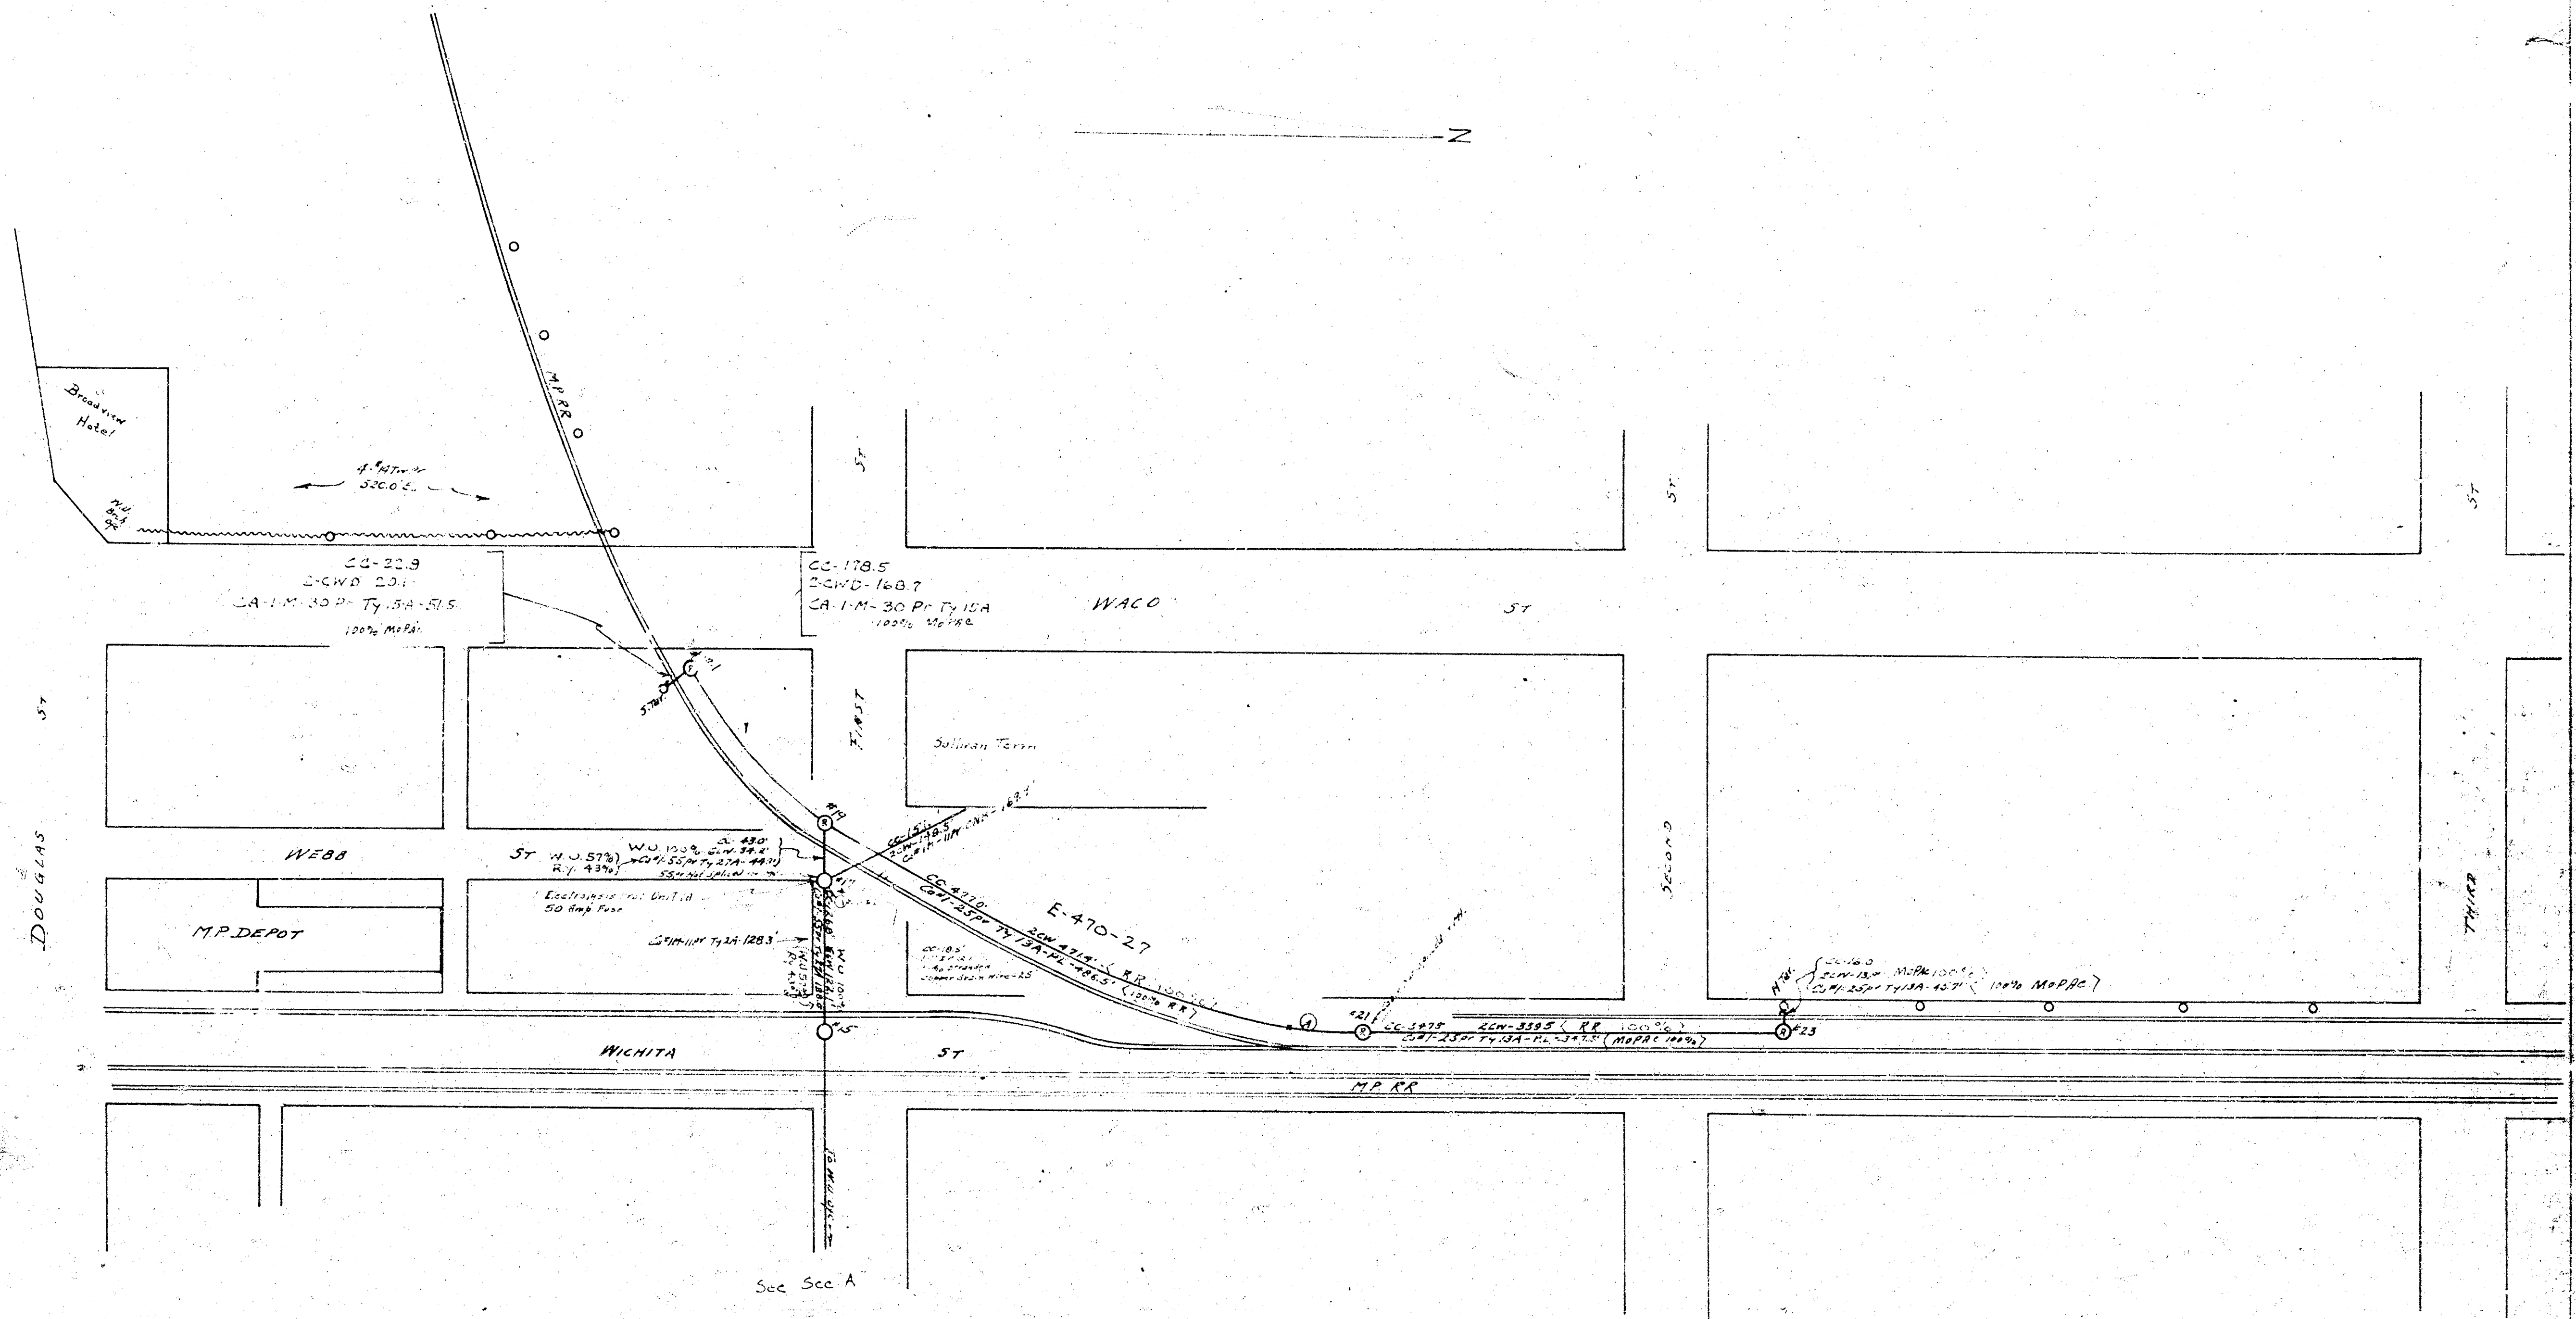



C
D A B

WUTEL CO.
C-9190-A70
Feb 7, 1931
1-14-37
4-9-35
1-8-37

WICHITA, KS.
CITY PLANT


