



WICHITA UNDER
SHOWING POSITION OF
AUGUST 8, 1930
CITY

~ CODE ~

NORTH AND WEST ARE TOP OF QUARTER SECTIONS
 DICTS OUT. RED IN RED ARE OWNED BY CITY

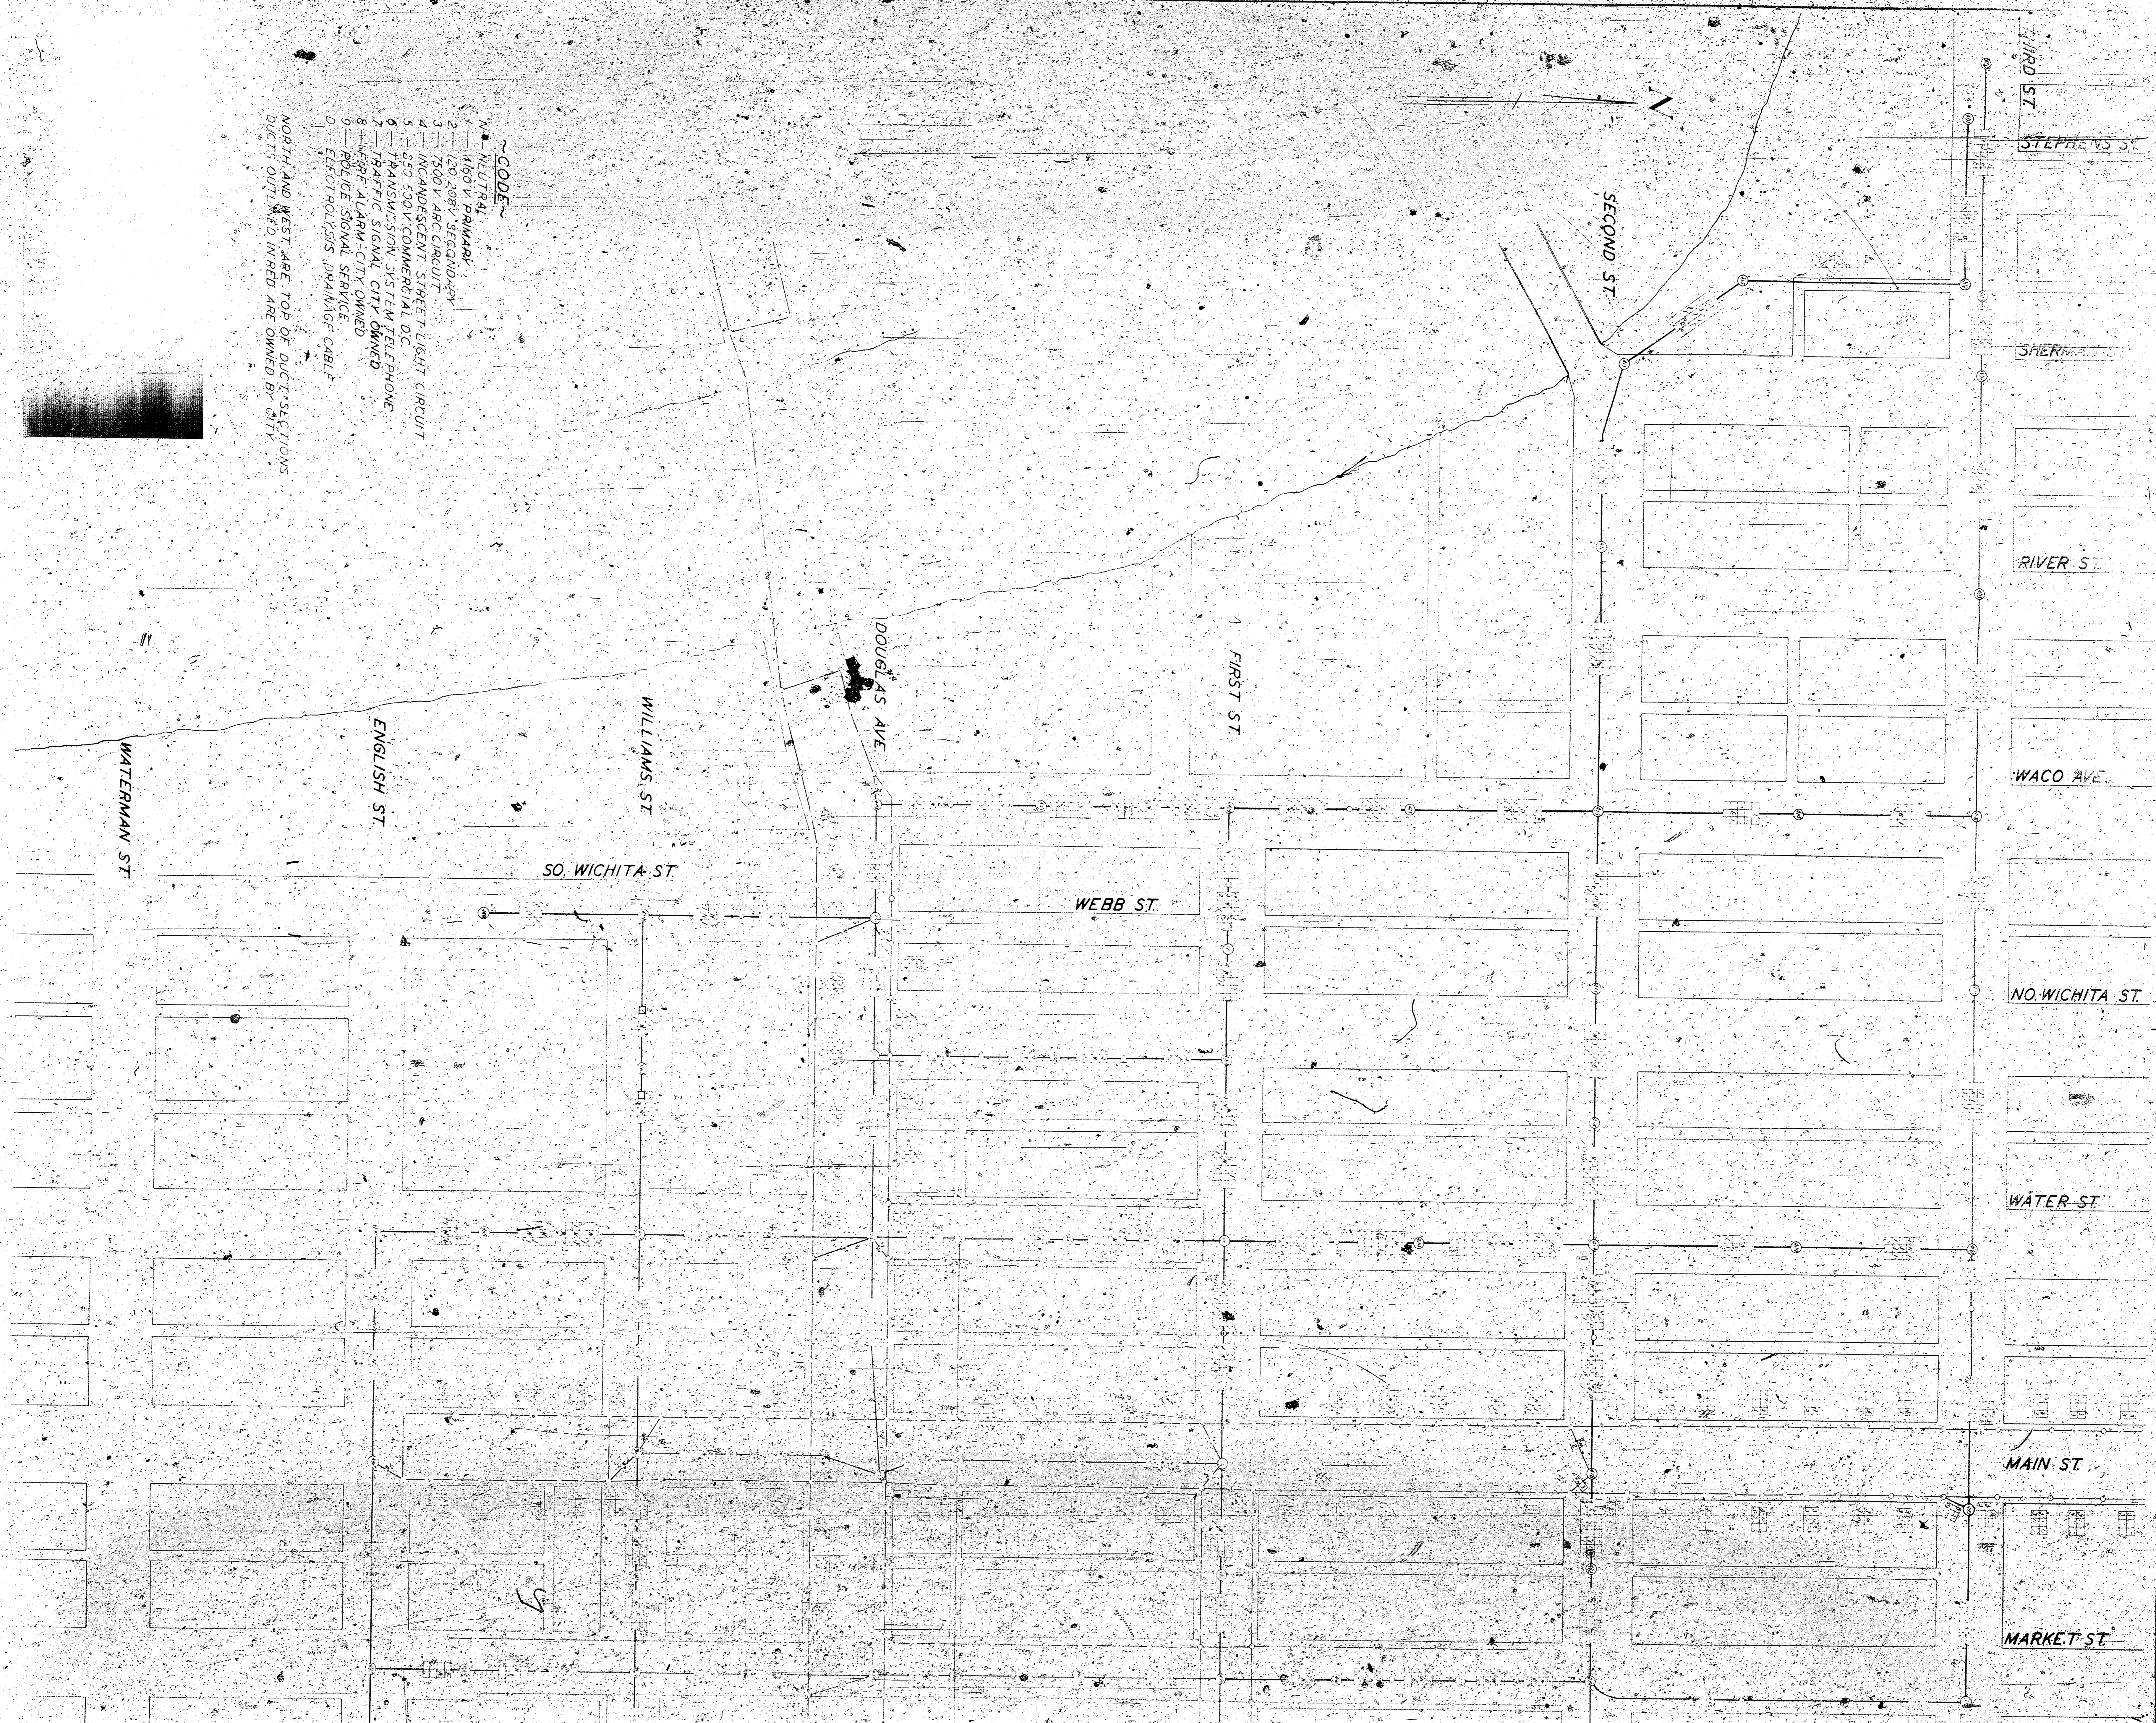

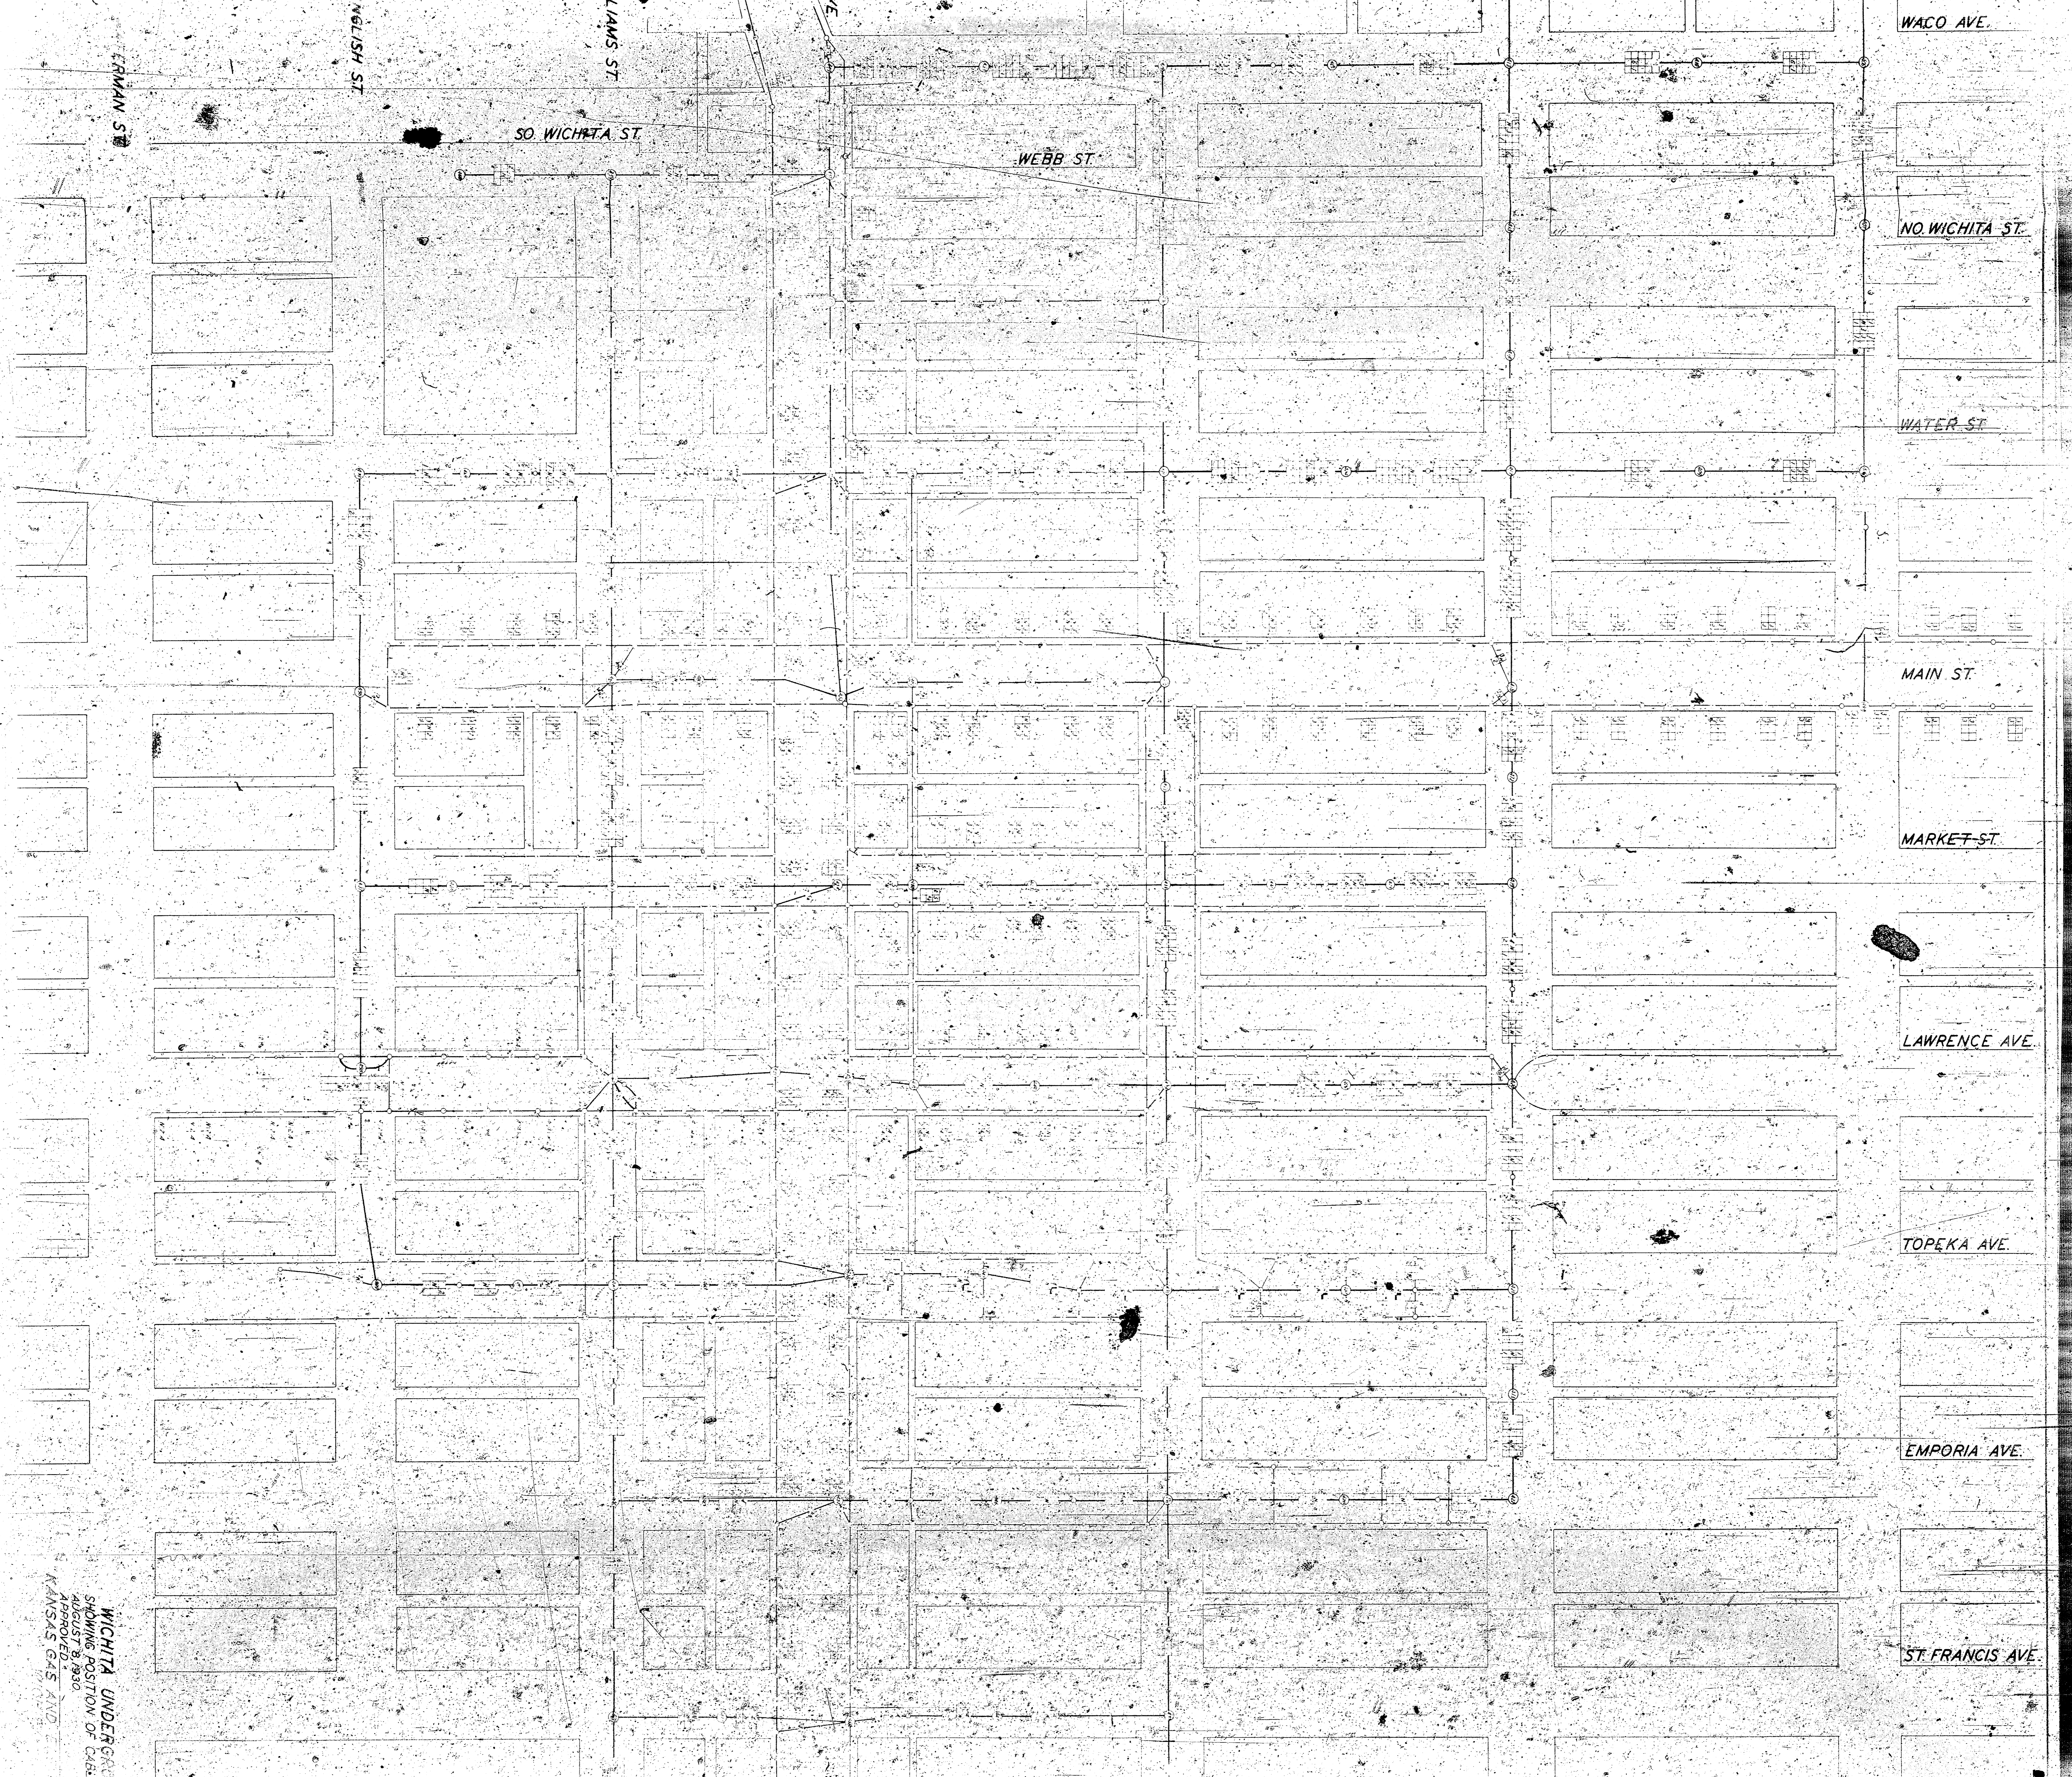

WACO AVE.

NO. WICHITA ST.

WATER ST.

MAIN ST.

MARKET ST.

LAWRENCE AVE.

TOPEKA AVE.

EMPORIA AVE.

ST. FRANCIS AVE.

SO. WICHITA ST.

WEBB ST.

ERMAN ST.

ENGLISH ST.

LAMPS ST.

WICHITA UNDERGROUND
AUGUST 8, 1930
APPROVED
KANSAS GAS AND
LIGHT CO.

| | | |
|-------------|------|--------|
| DESIGNED BY | 2008 | 8-8-30 |
| CHECKED BY | 2008 | 8-8-30 |
| DATE | | |

N — NEUTRAL
 2 — 120 208V SECONDARY
 3 — 7500 V ARC CIRCUIT
 4 — INCANDESCENT STREET LIGHT CIRCUIT
 5 — 250 500V COMMERCIAL D.C.
 6 — TRANSMISSION SYSTEM TELEPHONE
 7 — TRAFFIC SIGNAL CITY OWNED
 8 — FIRE ALARM CITY OWNED
 9 — POLICE SIGNAL SERVICE

NORTH AND WEST ARE TOP OF DUCT SECTIONS
 DUCTS OUTLINED IN RED ARE OWNED BY CITY

