





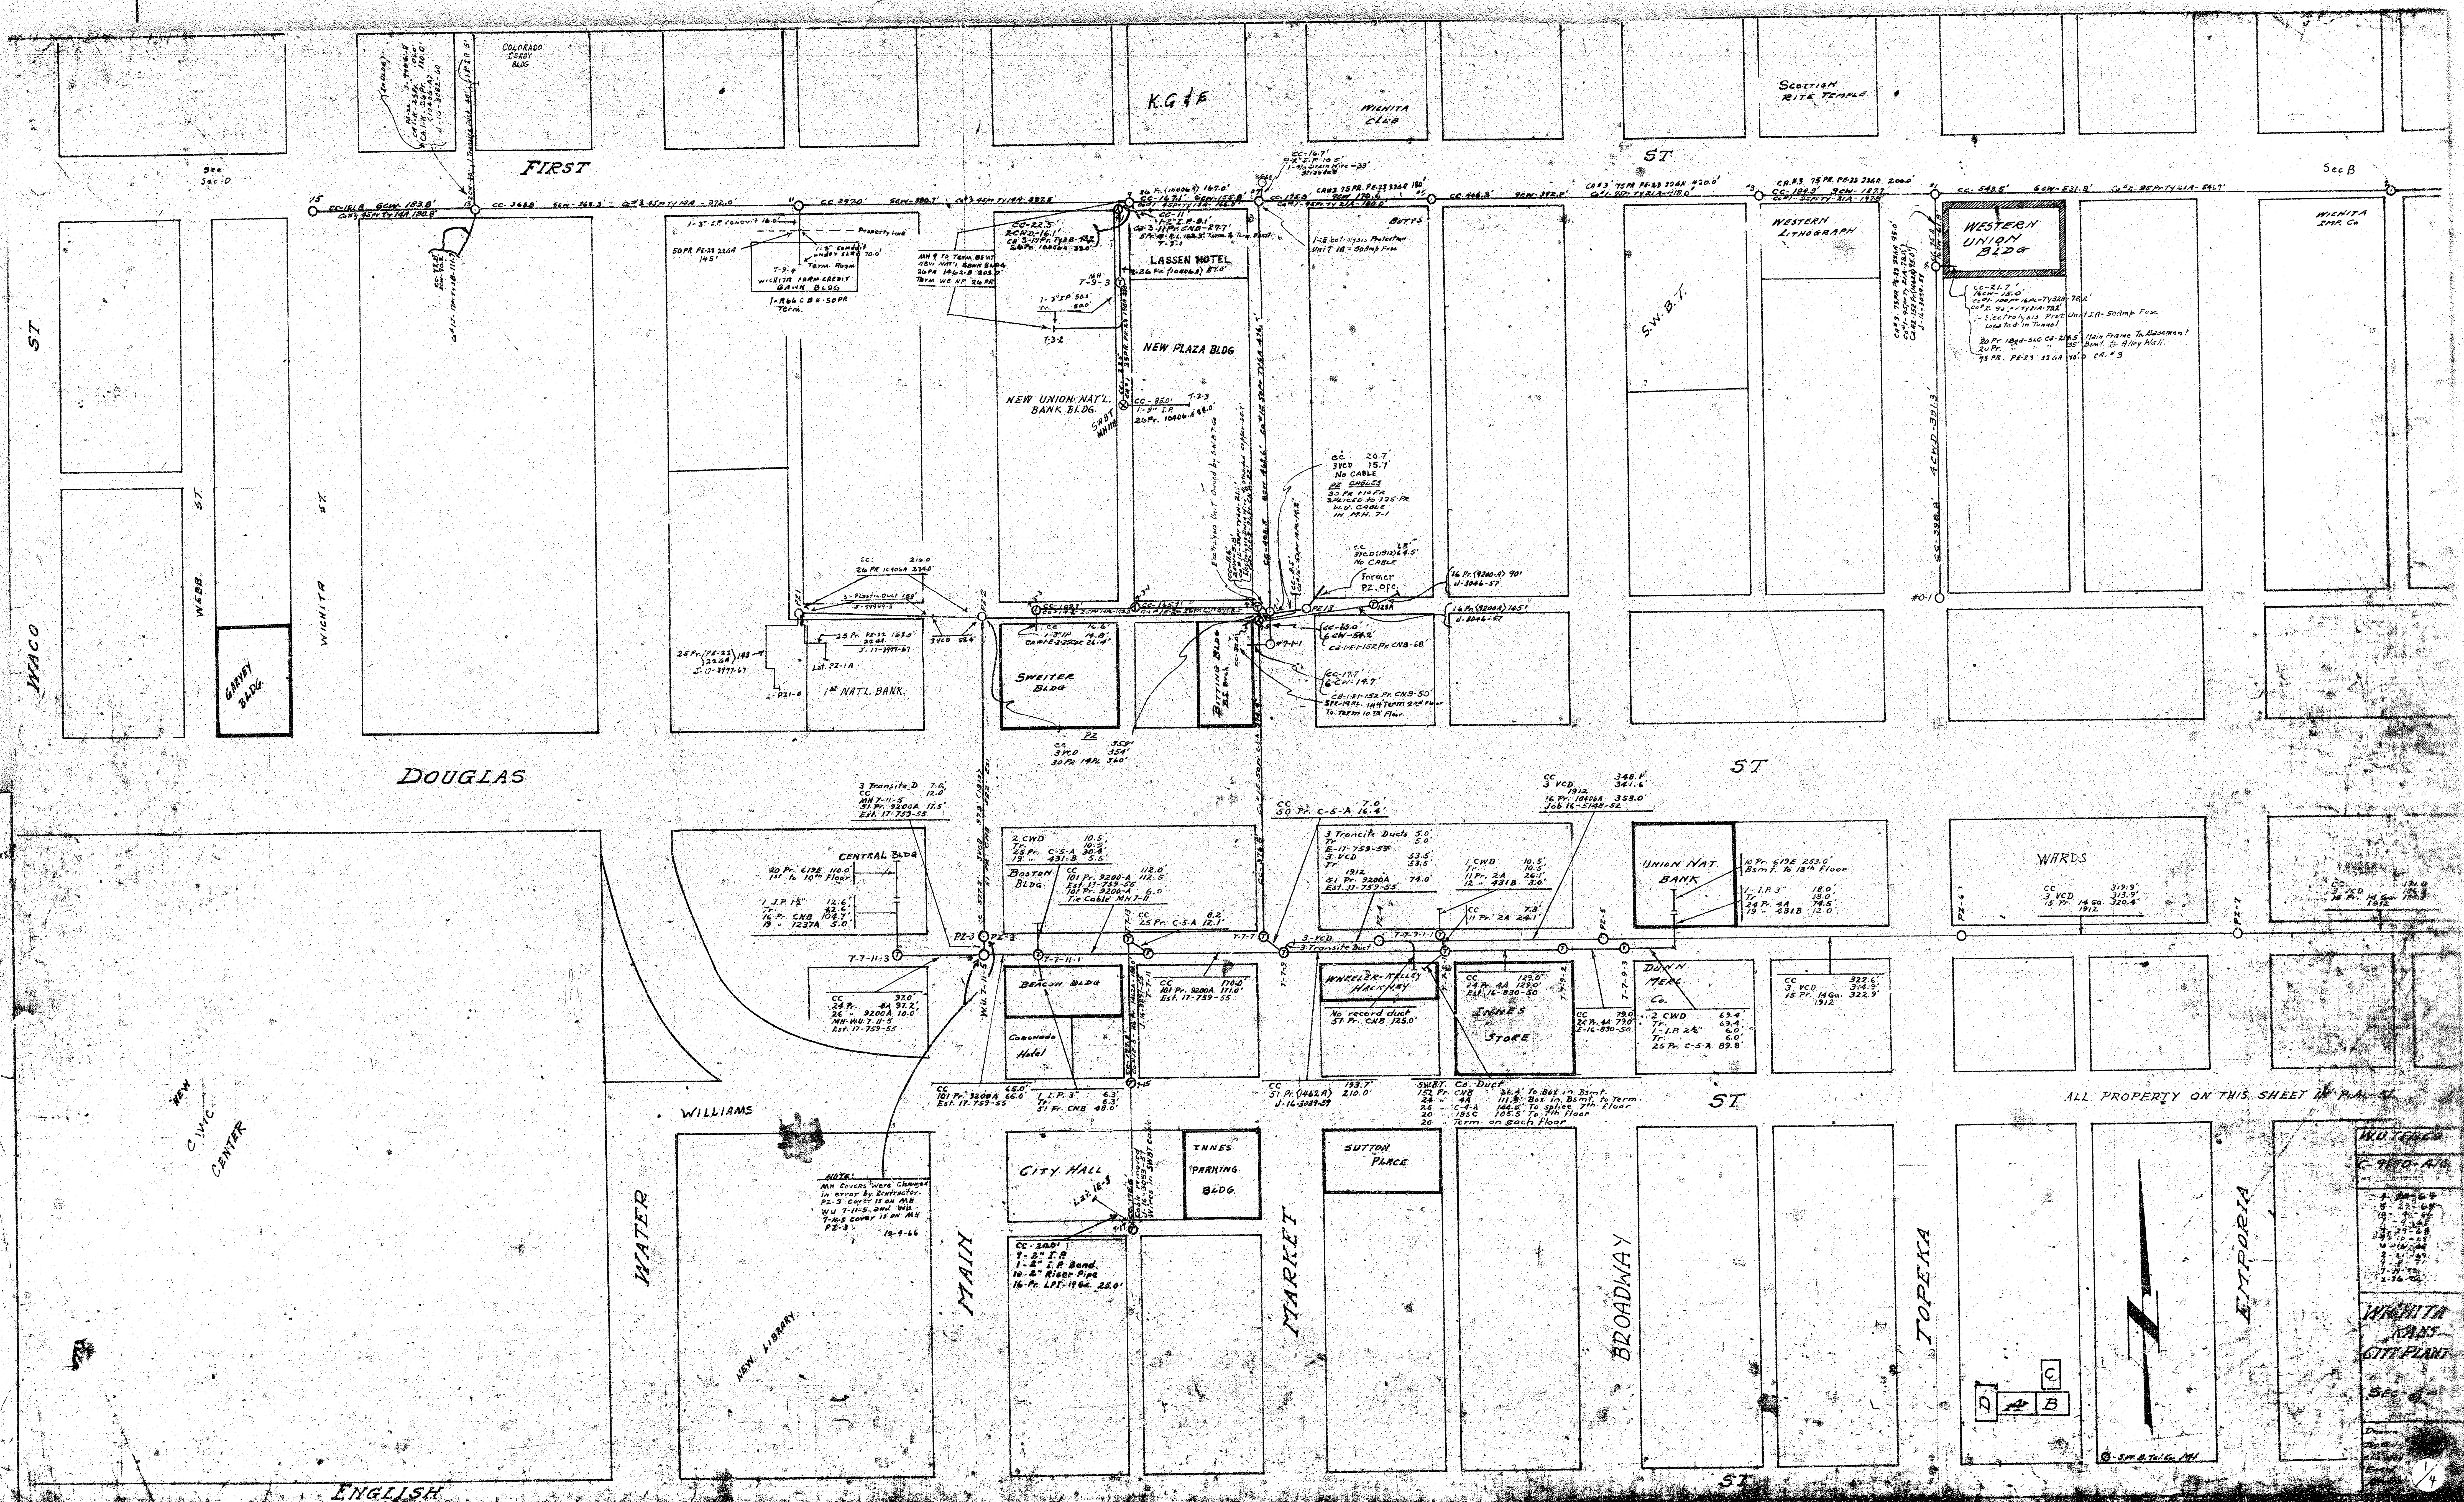


WATER
CITY
10-20

WATER
CITY
10-20

WATER
CITY
10-20

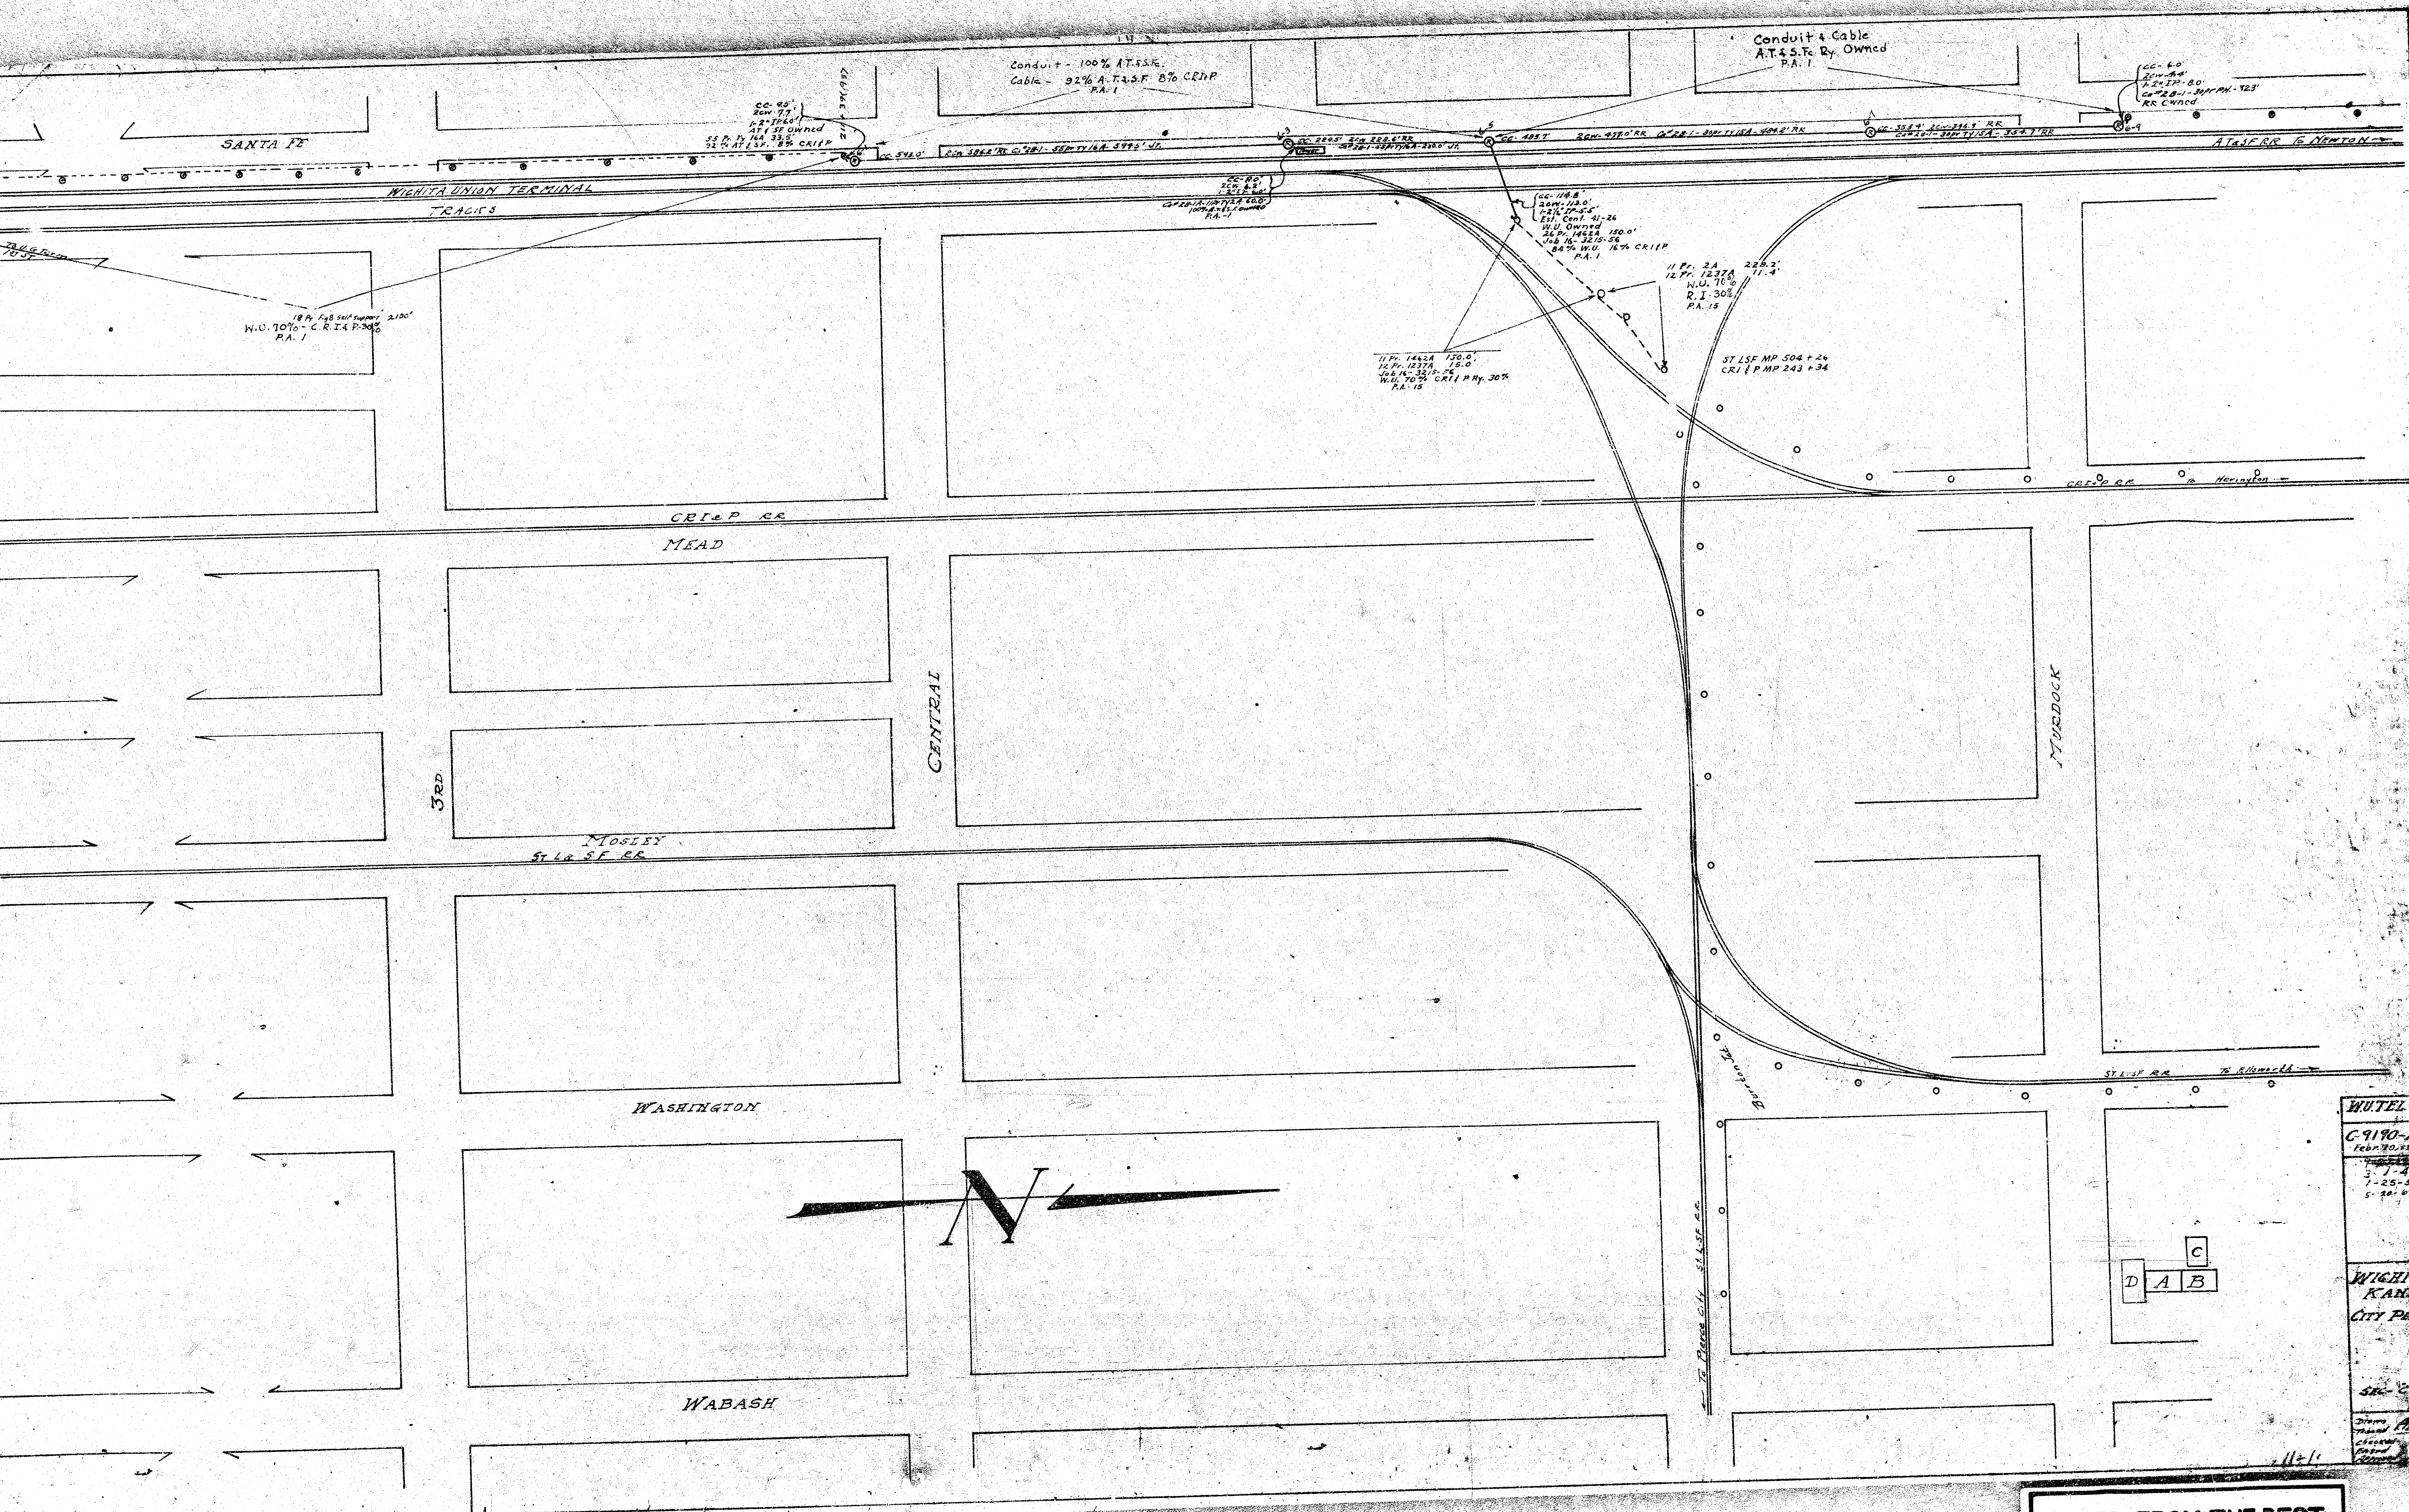

WUTEL CO
C-9190-A-10
Feb. 10, 1931
1-25-57
5-20-67
WICHITA
KANSAS
CITY PLANT
3/4
SEC. 2
11-11

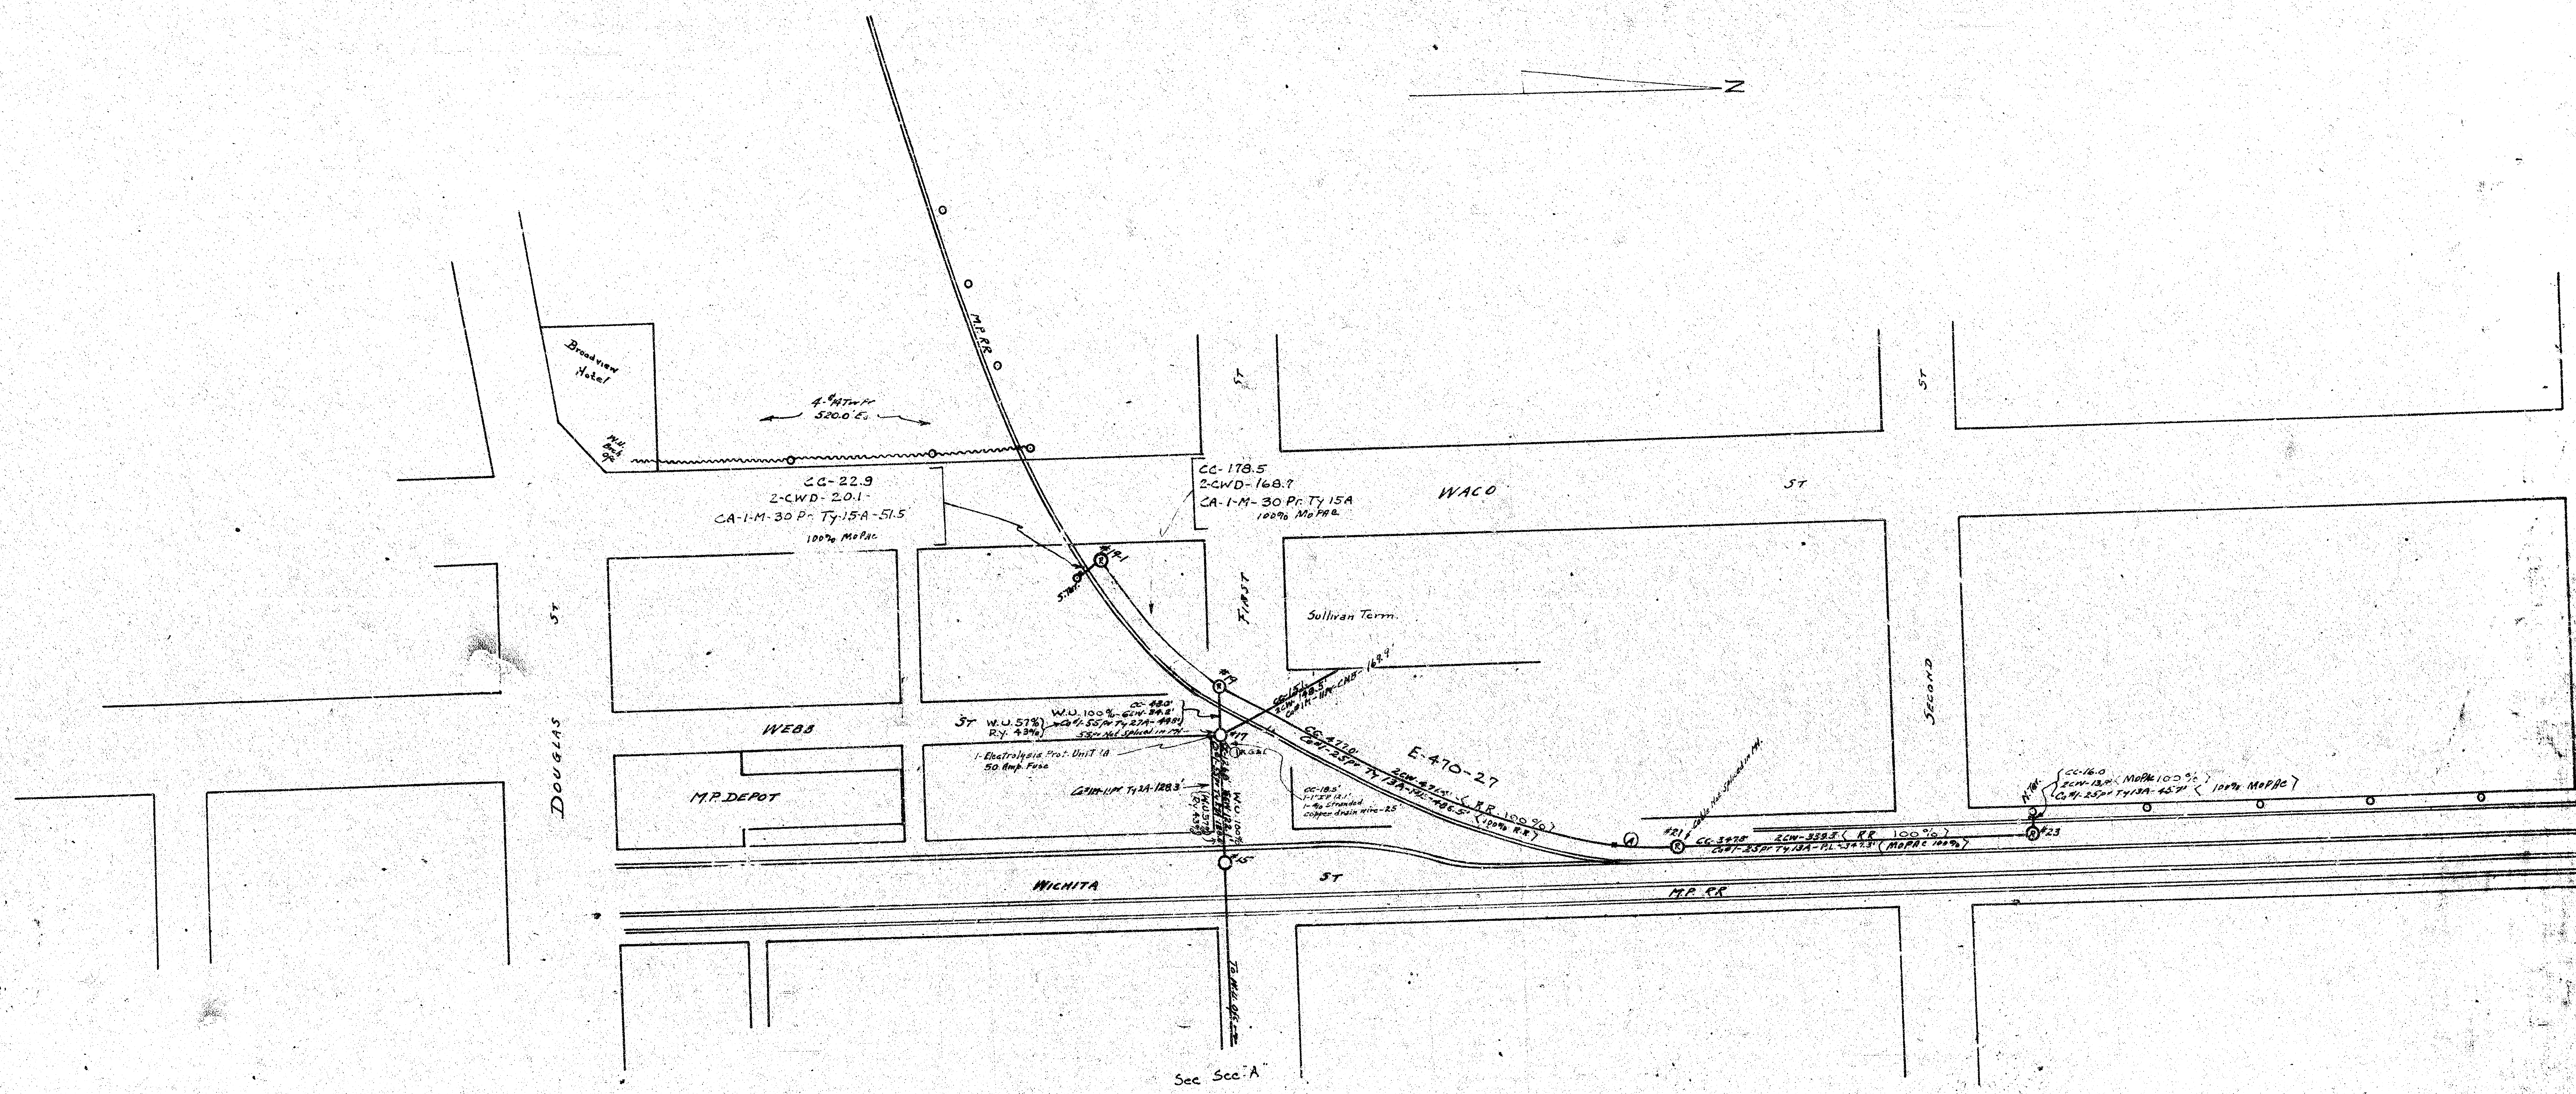

NOTE: 55' to 145' - 14.1' - 43% MoPac - 57% W.U.
 25' - 14.1' - 14.1' - 100% MoPac
 30' - 14.1' - 5.7' - 100% MoPac

C
 D A B

WUTEL CO
 C-9130-A-18
 Feb 7, 1938
 1-14-47
 4-7-63
 1-8-63
 WICHITA-KC
 CITY PLANT

4/4
 SEC-D