


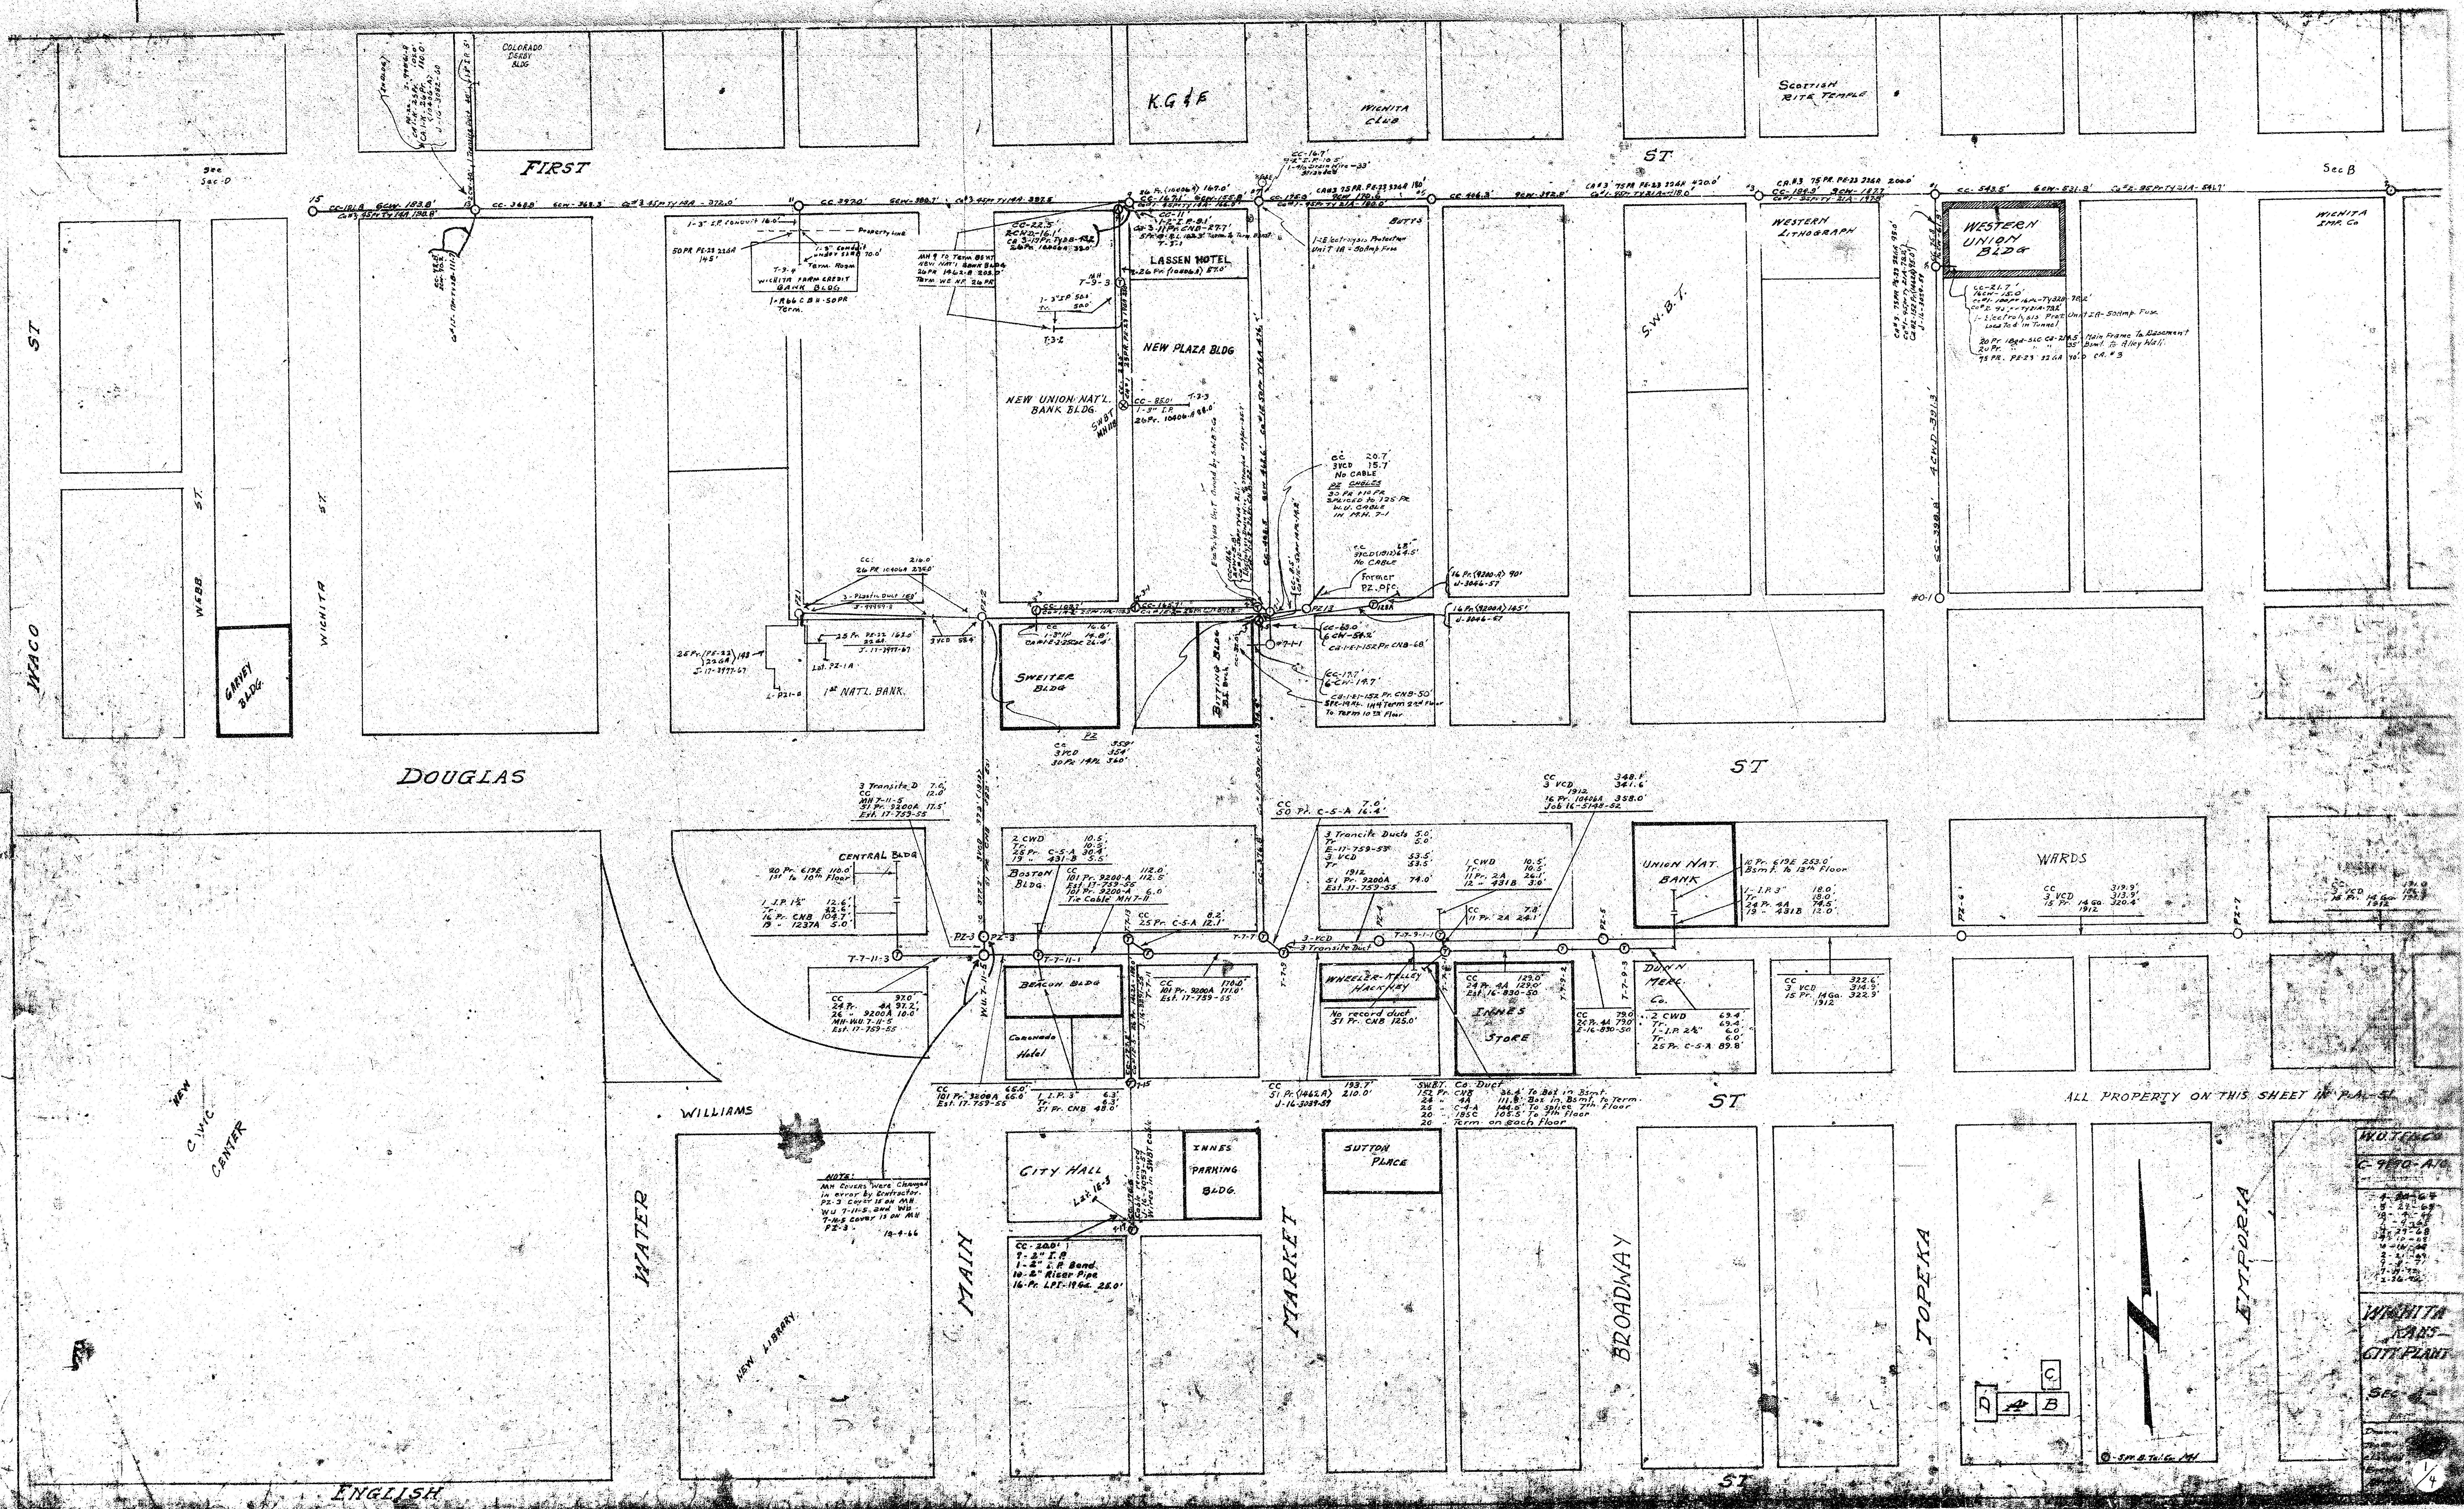



WATER


C
D A B

