



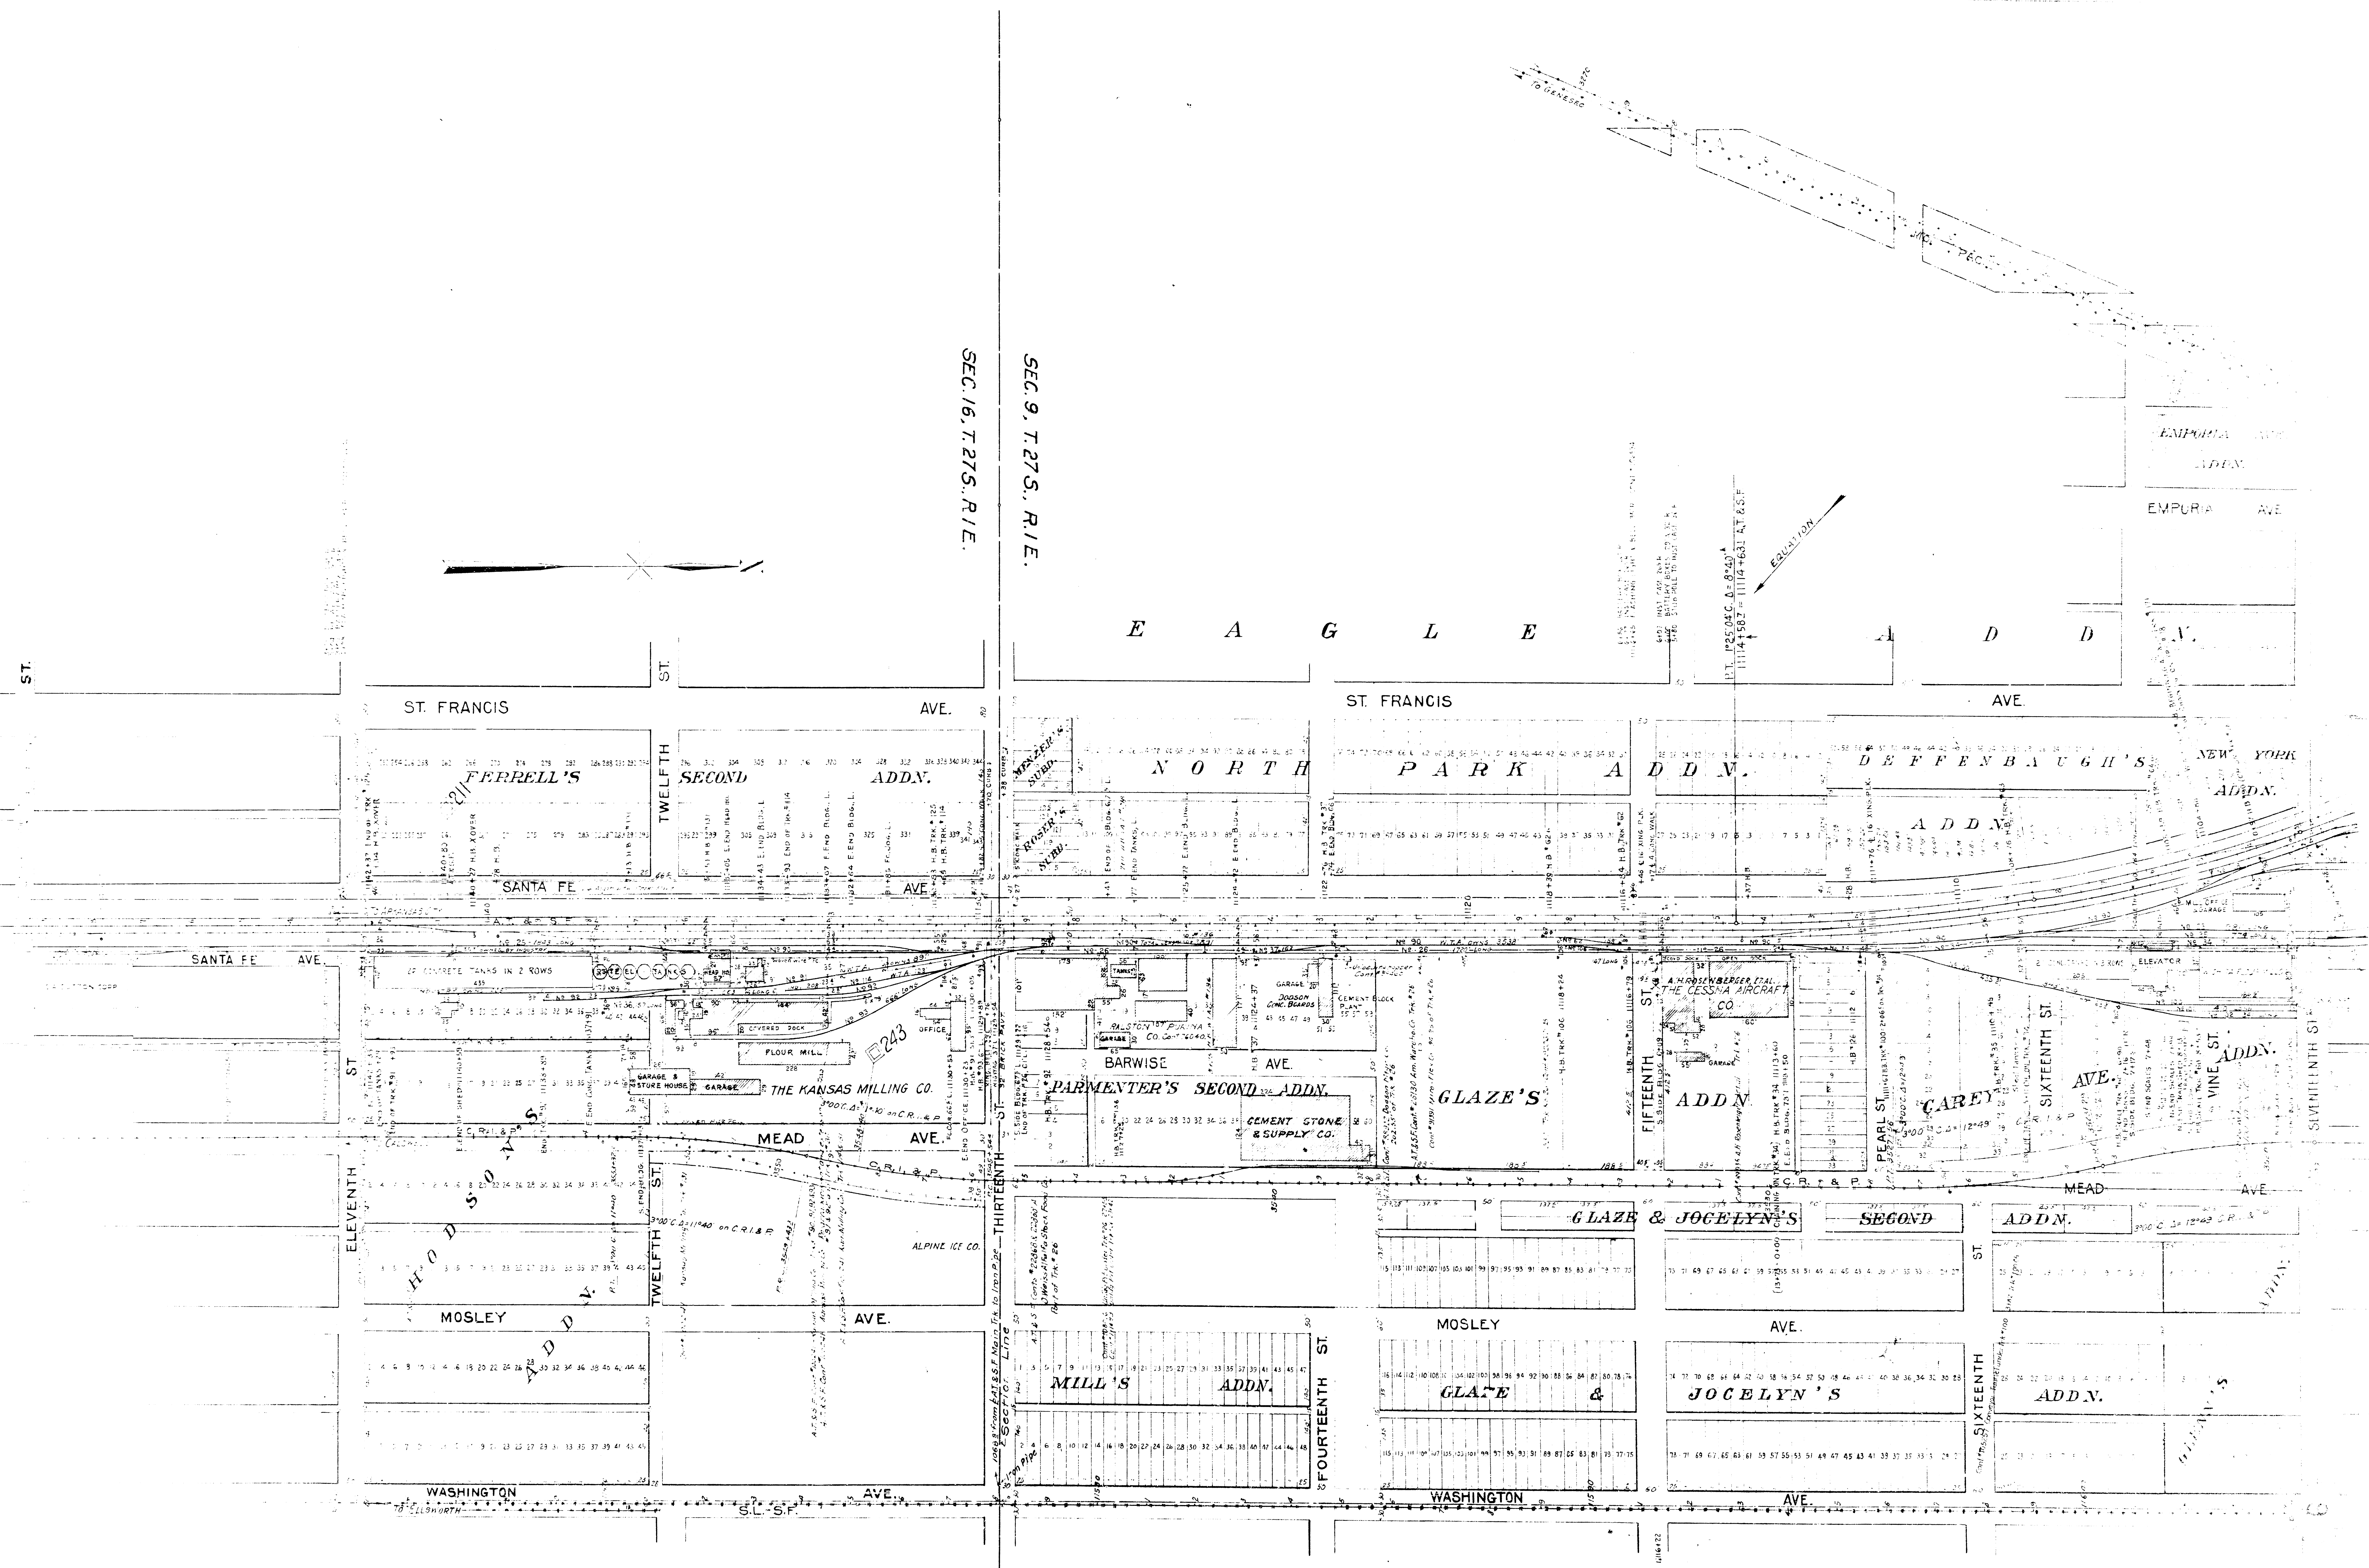


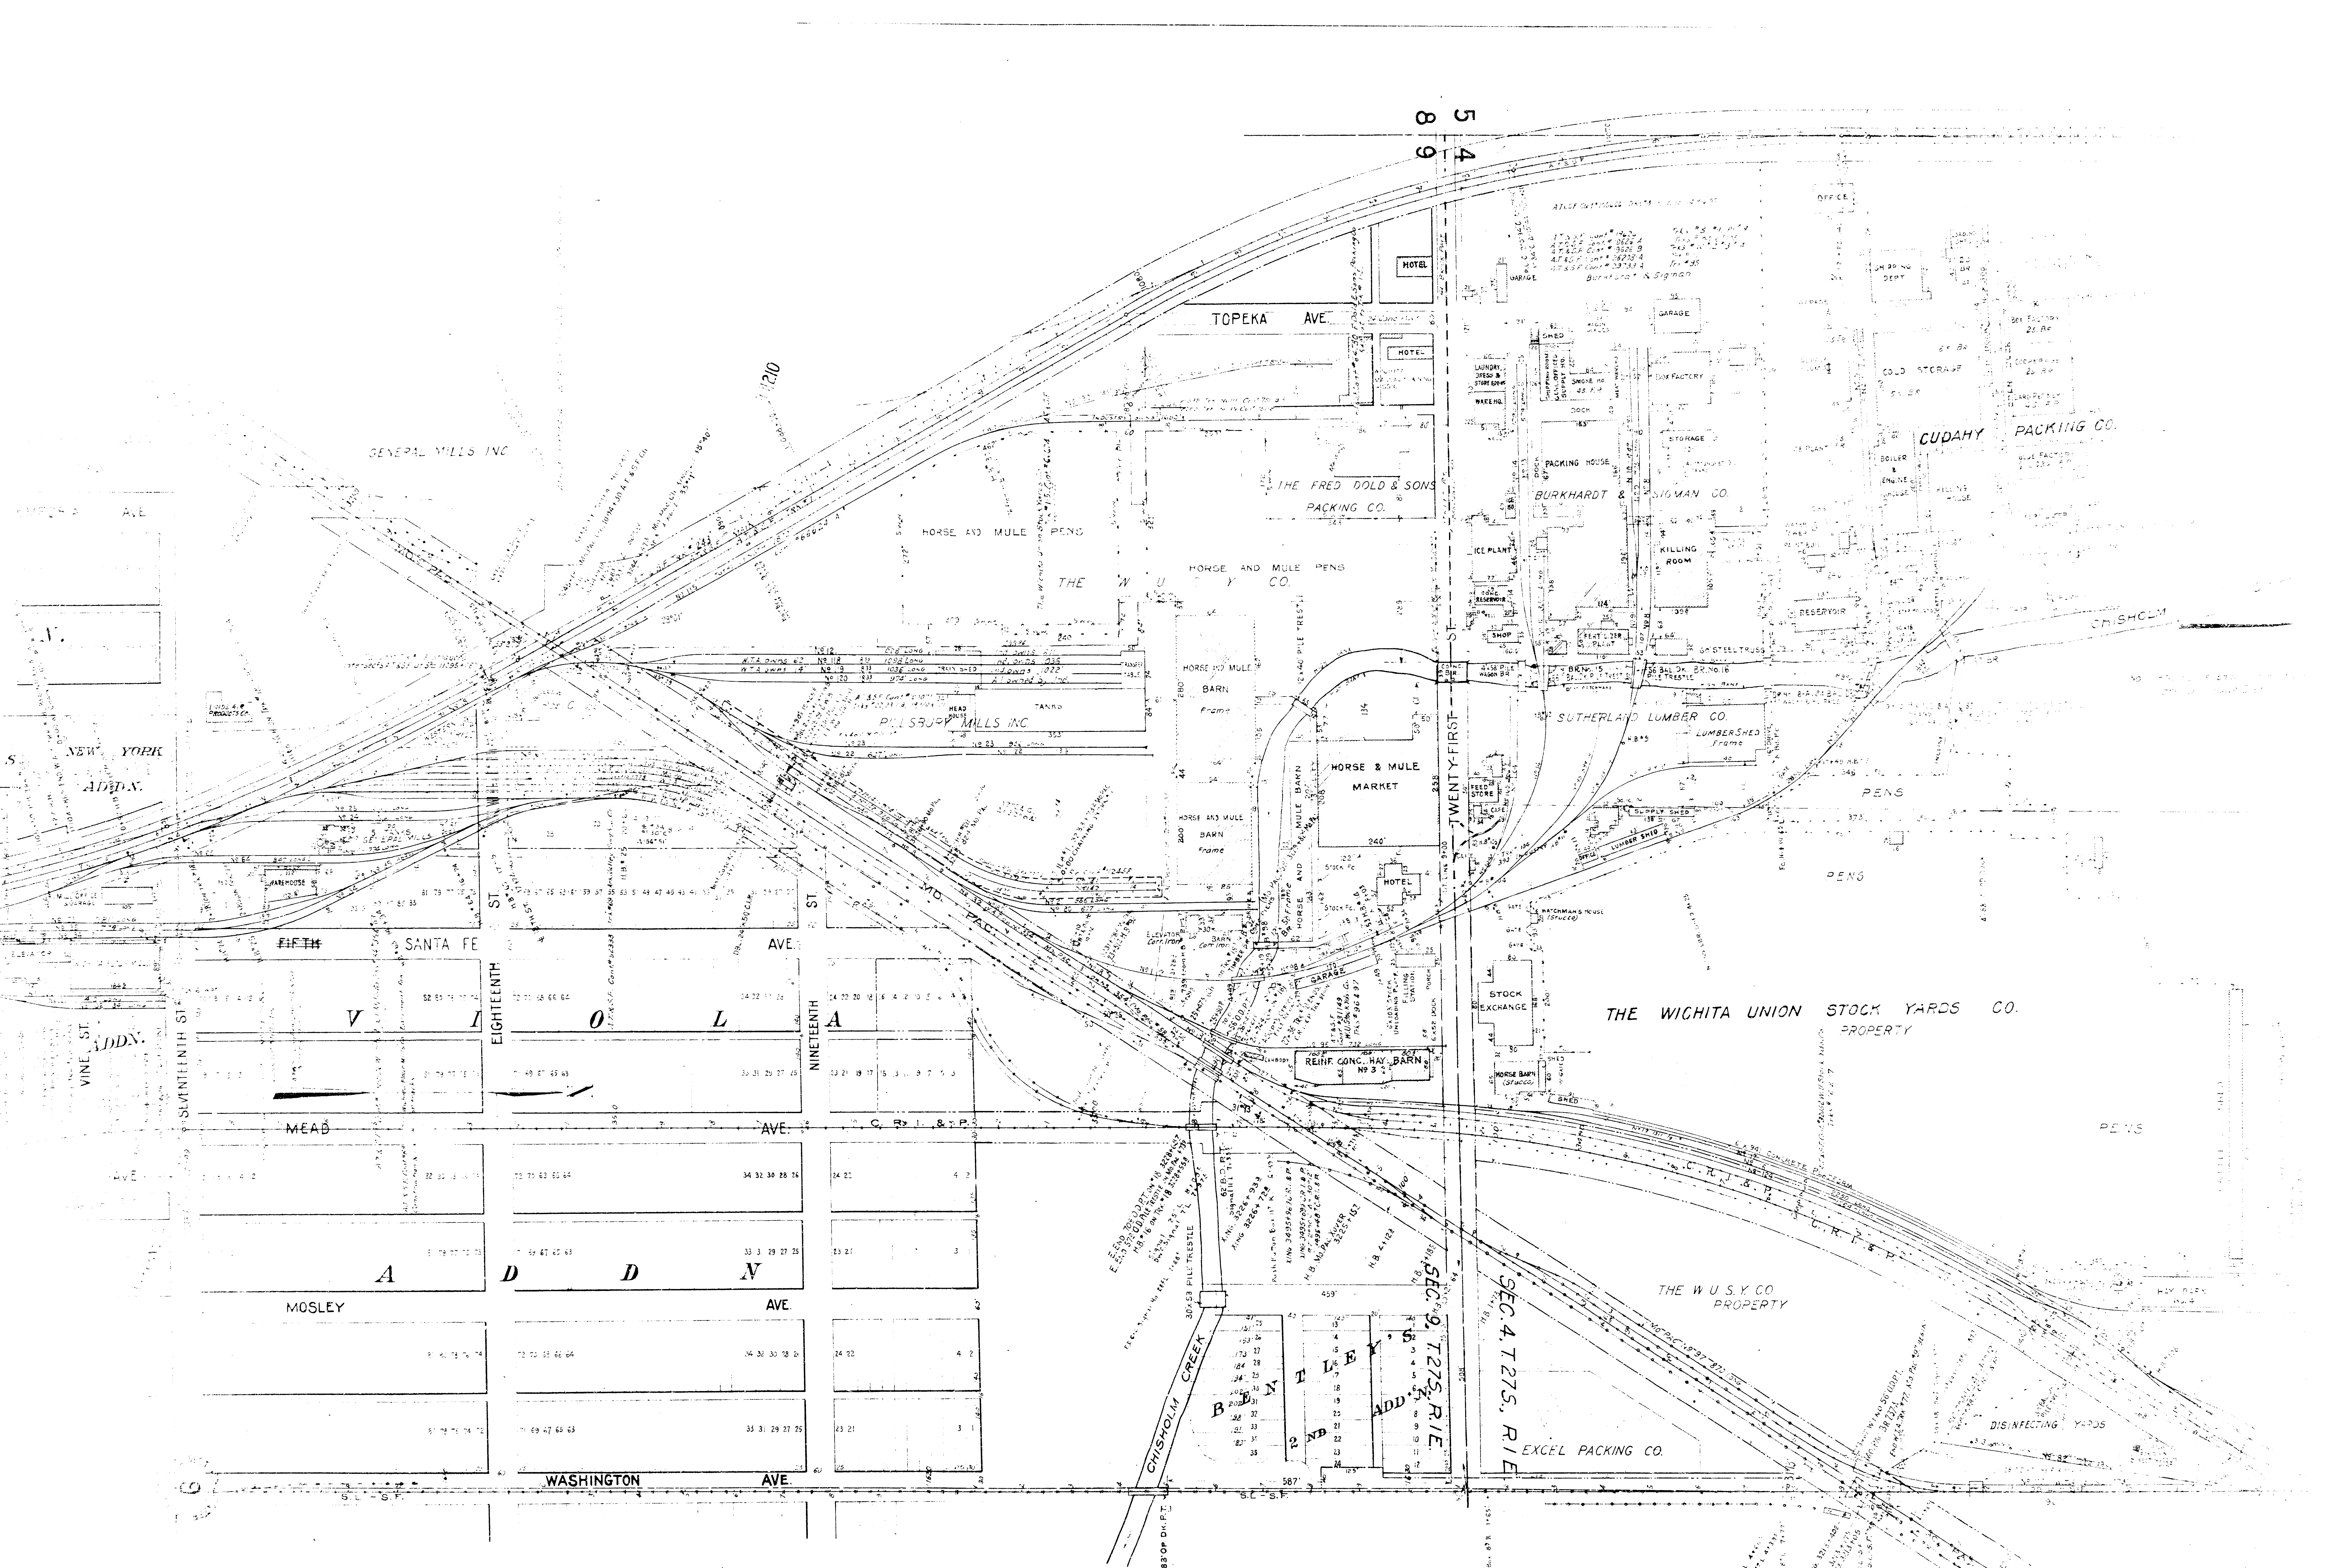




Cont. #99885 Construction, maintenance and operation of an automatic interlocking plant and signal system for four crossings. Placed in service Feb. 10, 1949.



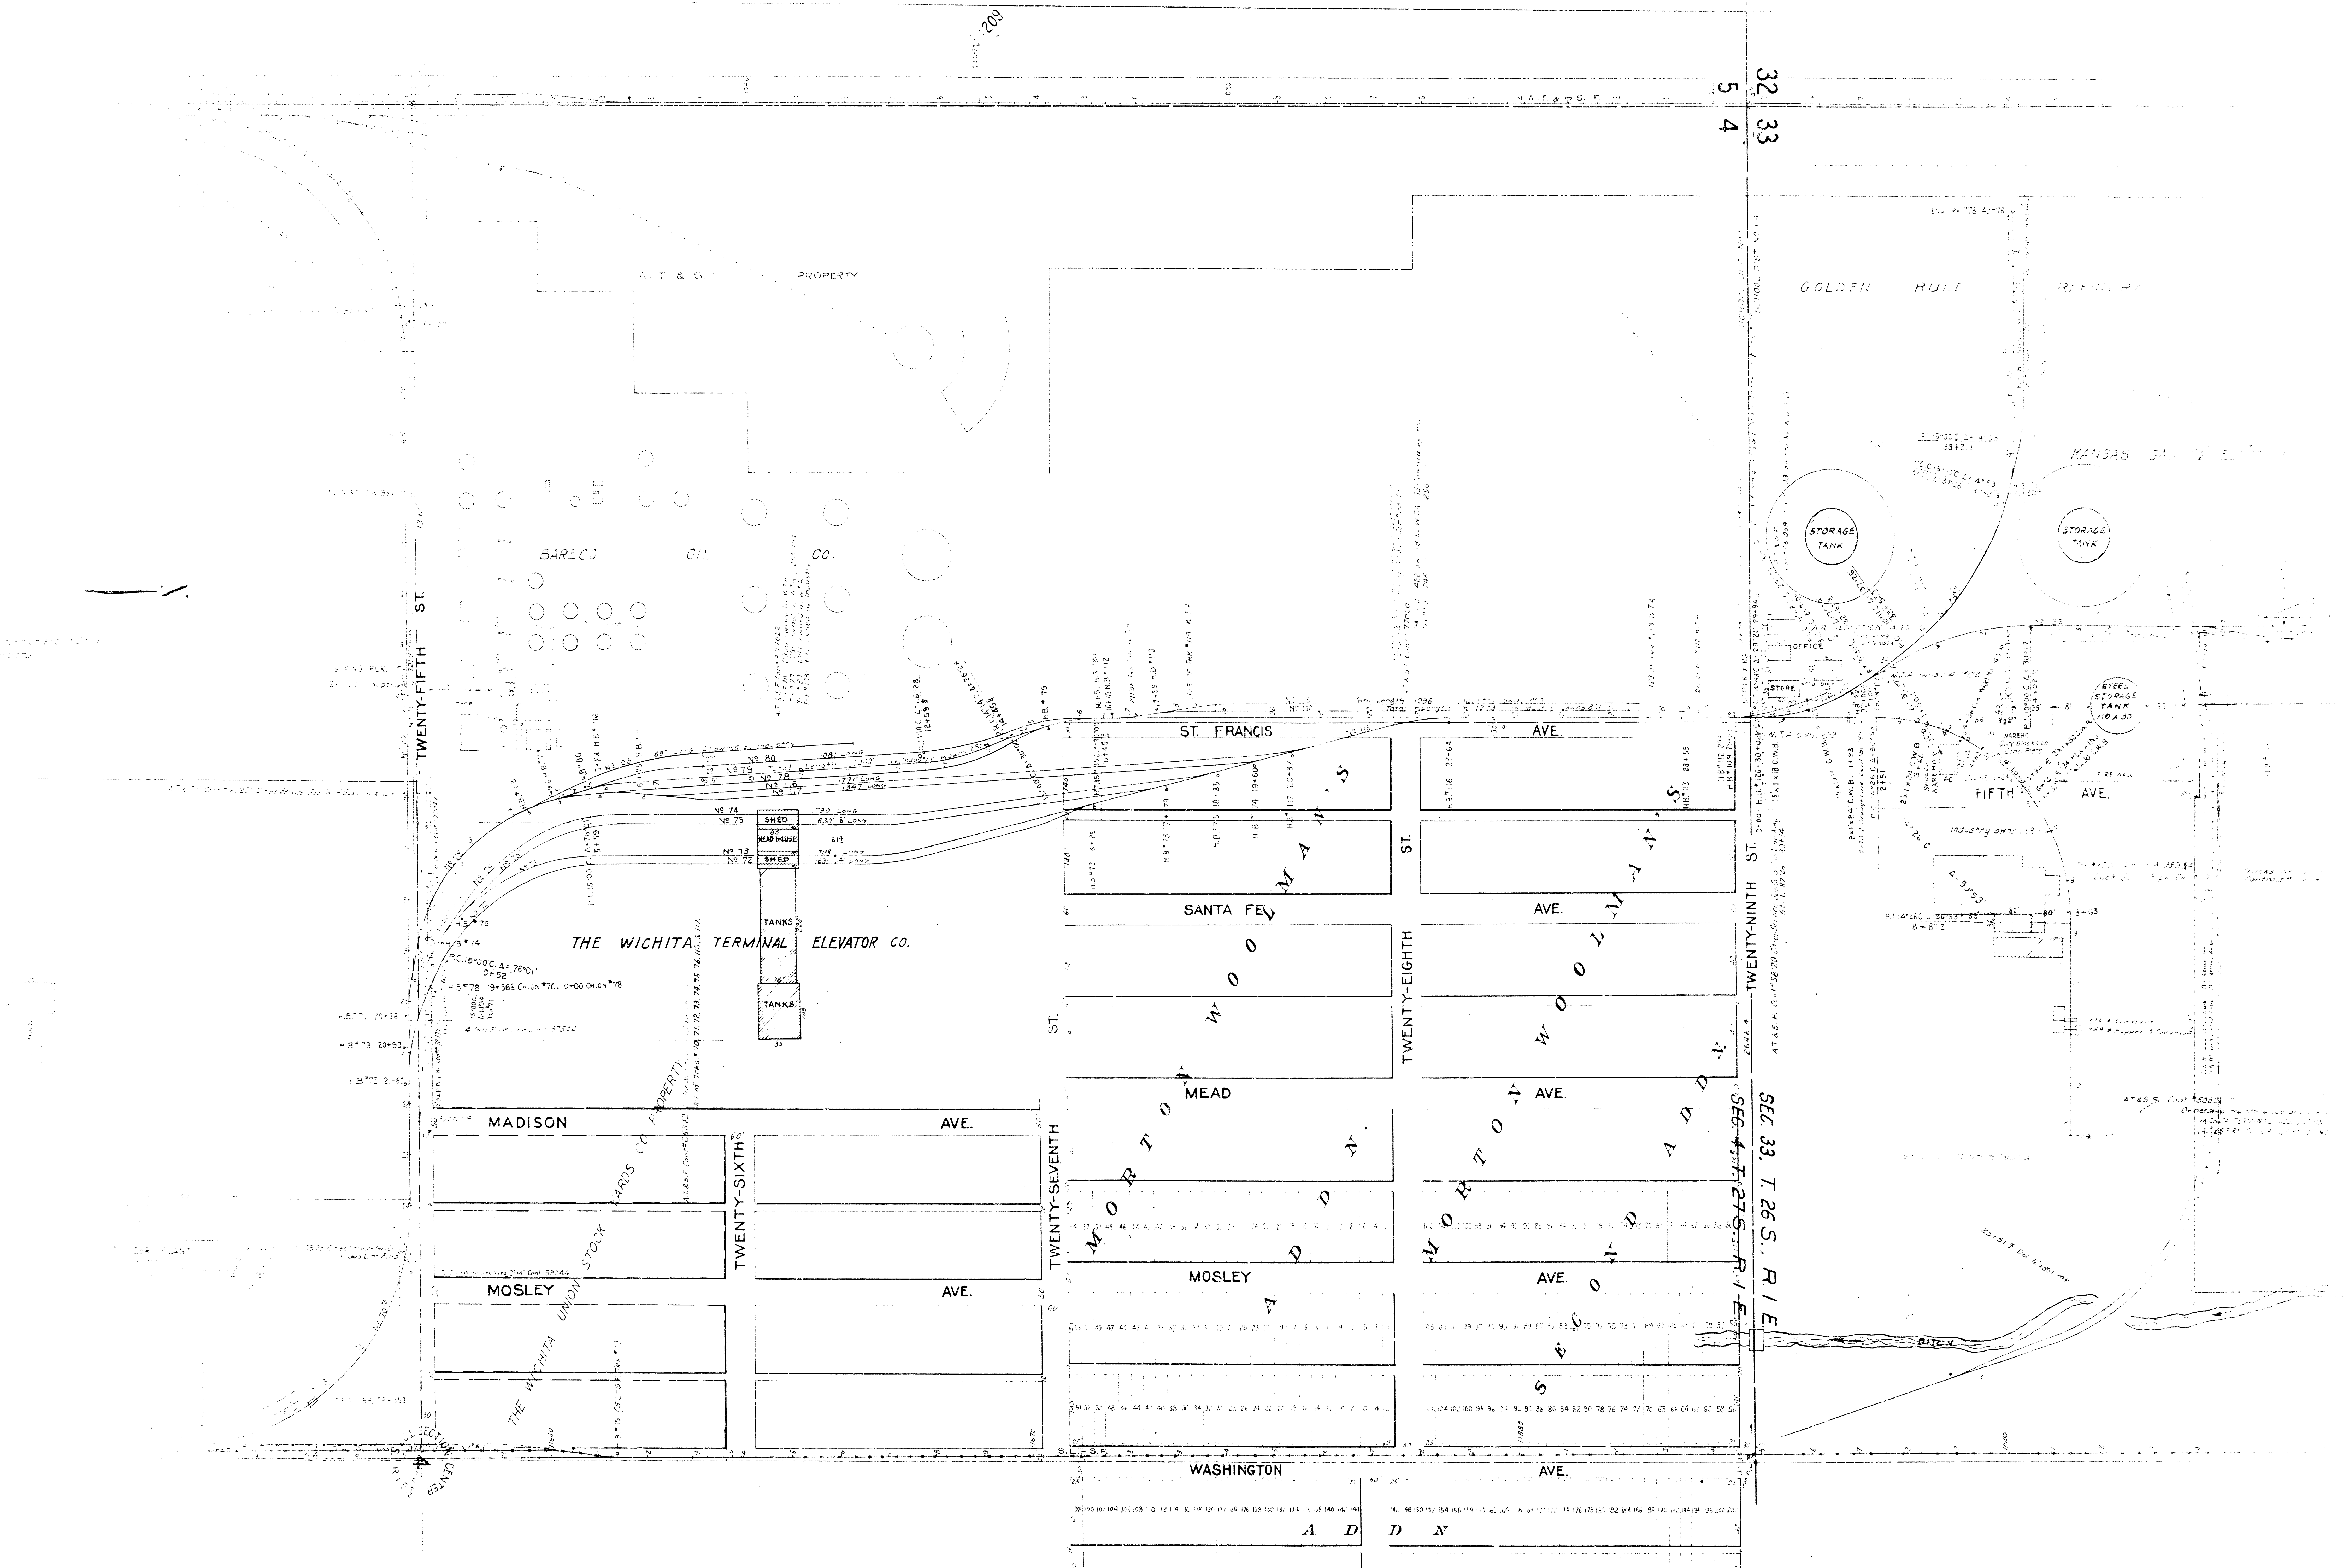



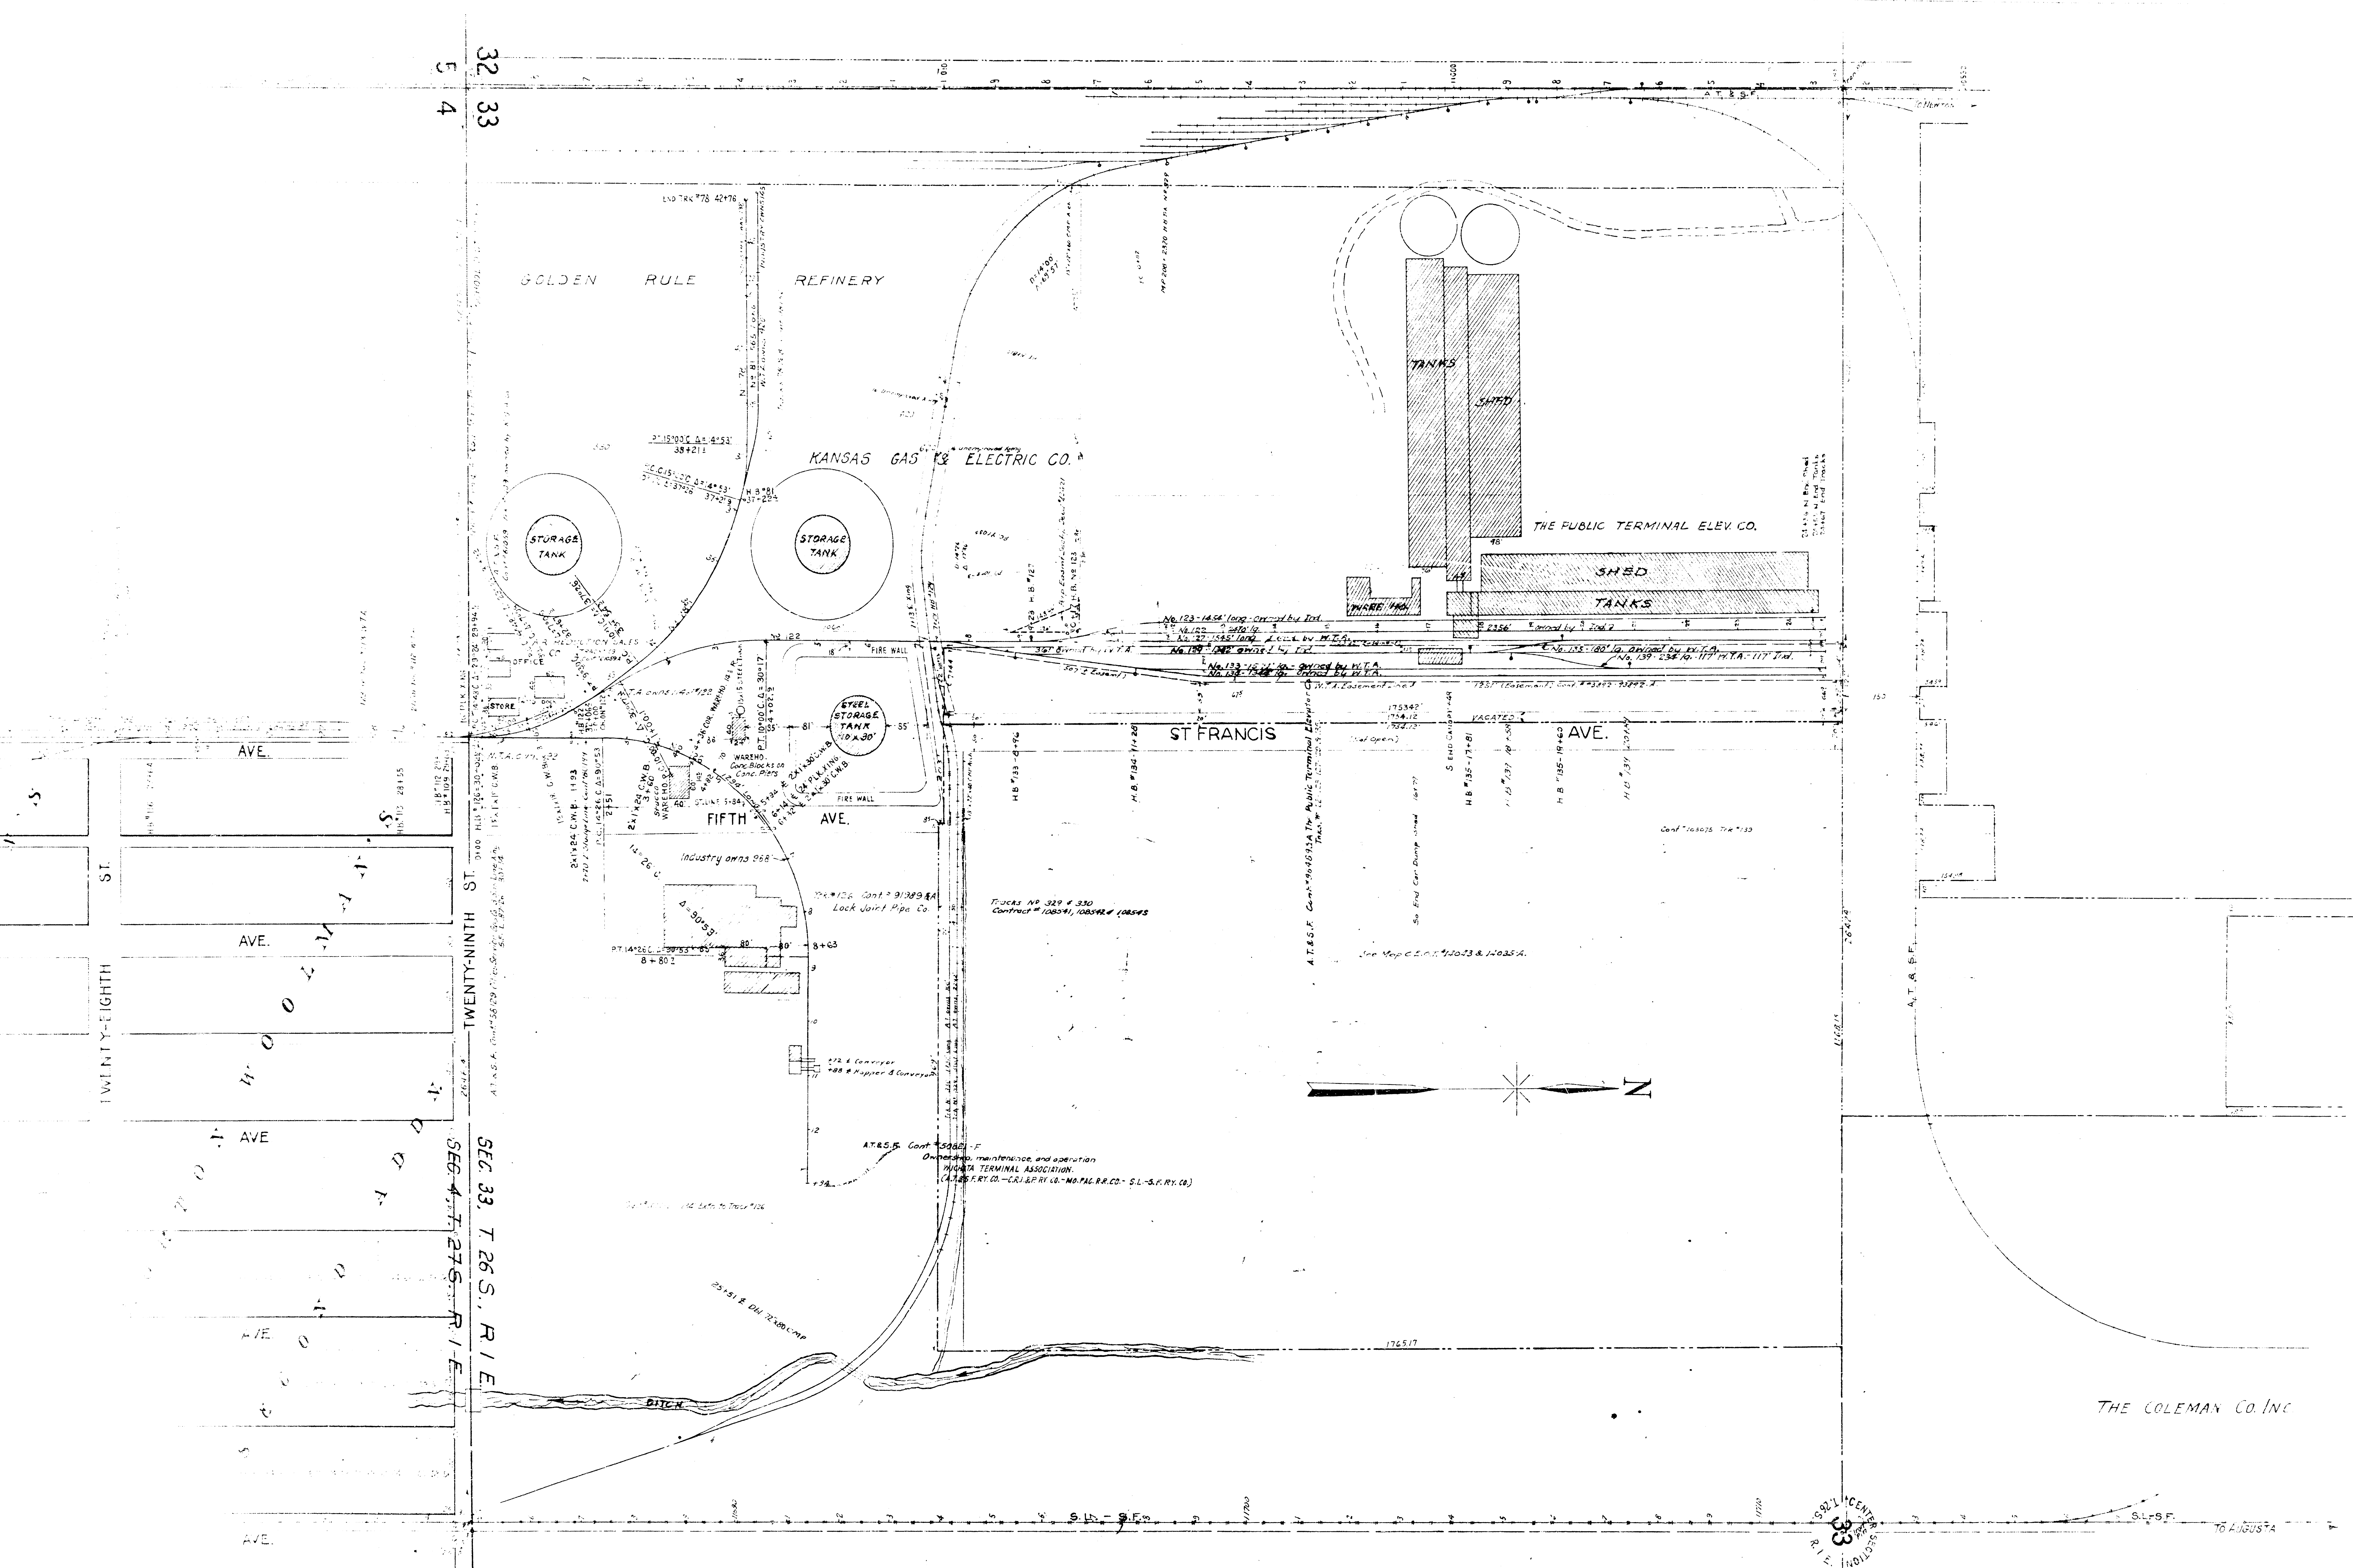

STATION MAP - TRACKS AND STRUCTURES  
**WICHITA**  
SEDGWICK COUNTY, KANSAS  
WICHITA TERMINAL ASSOCIATION  
COMPRISED OF  
THE AT.&S.F. RY CO. THE C.R.I. & P. RY CO.