



REVISED AS TO	SOURCE	DATE	DRAFTSMAN
Initial Yrs. Sup.	151516 1532B	12-31-39	J. A. Wolfram
Revised to 1532B	1531012 1531B	1-31-40	A. G. Stevenson
Revised to 1531B	1531012 1531B	1-31-40	A. G. Stevenson
Revised to 1531B	1531012 1531B	1-31-40	A. G. Stevenson

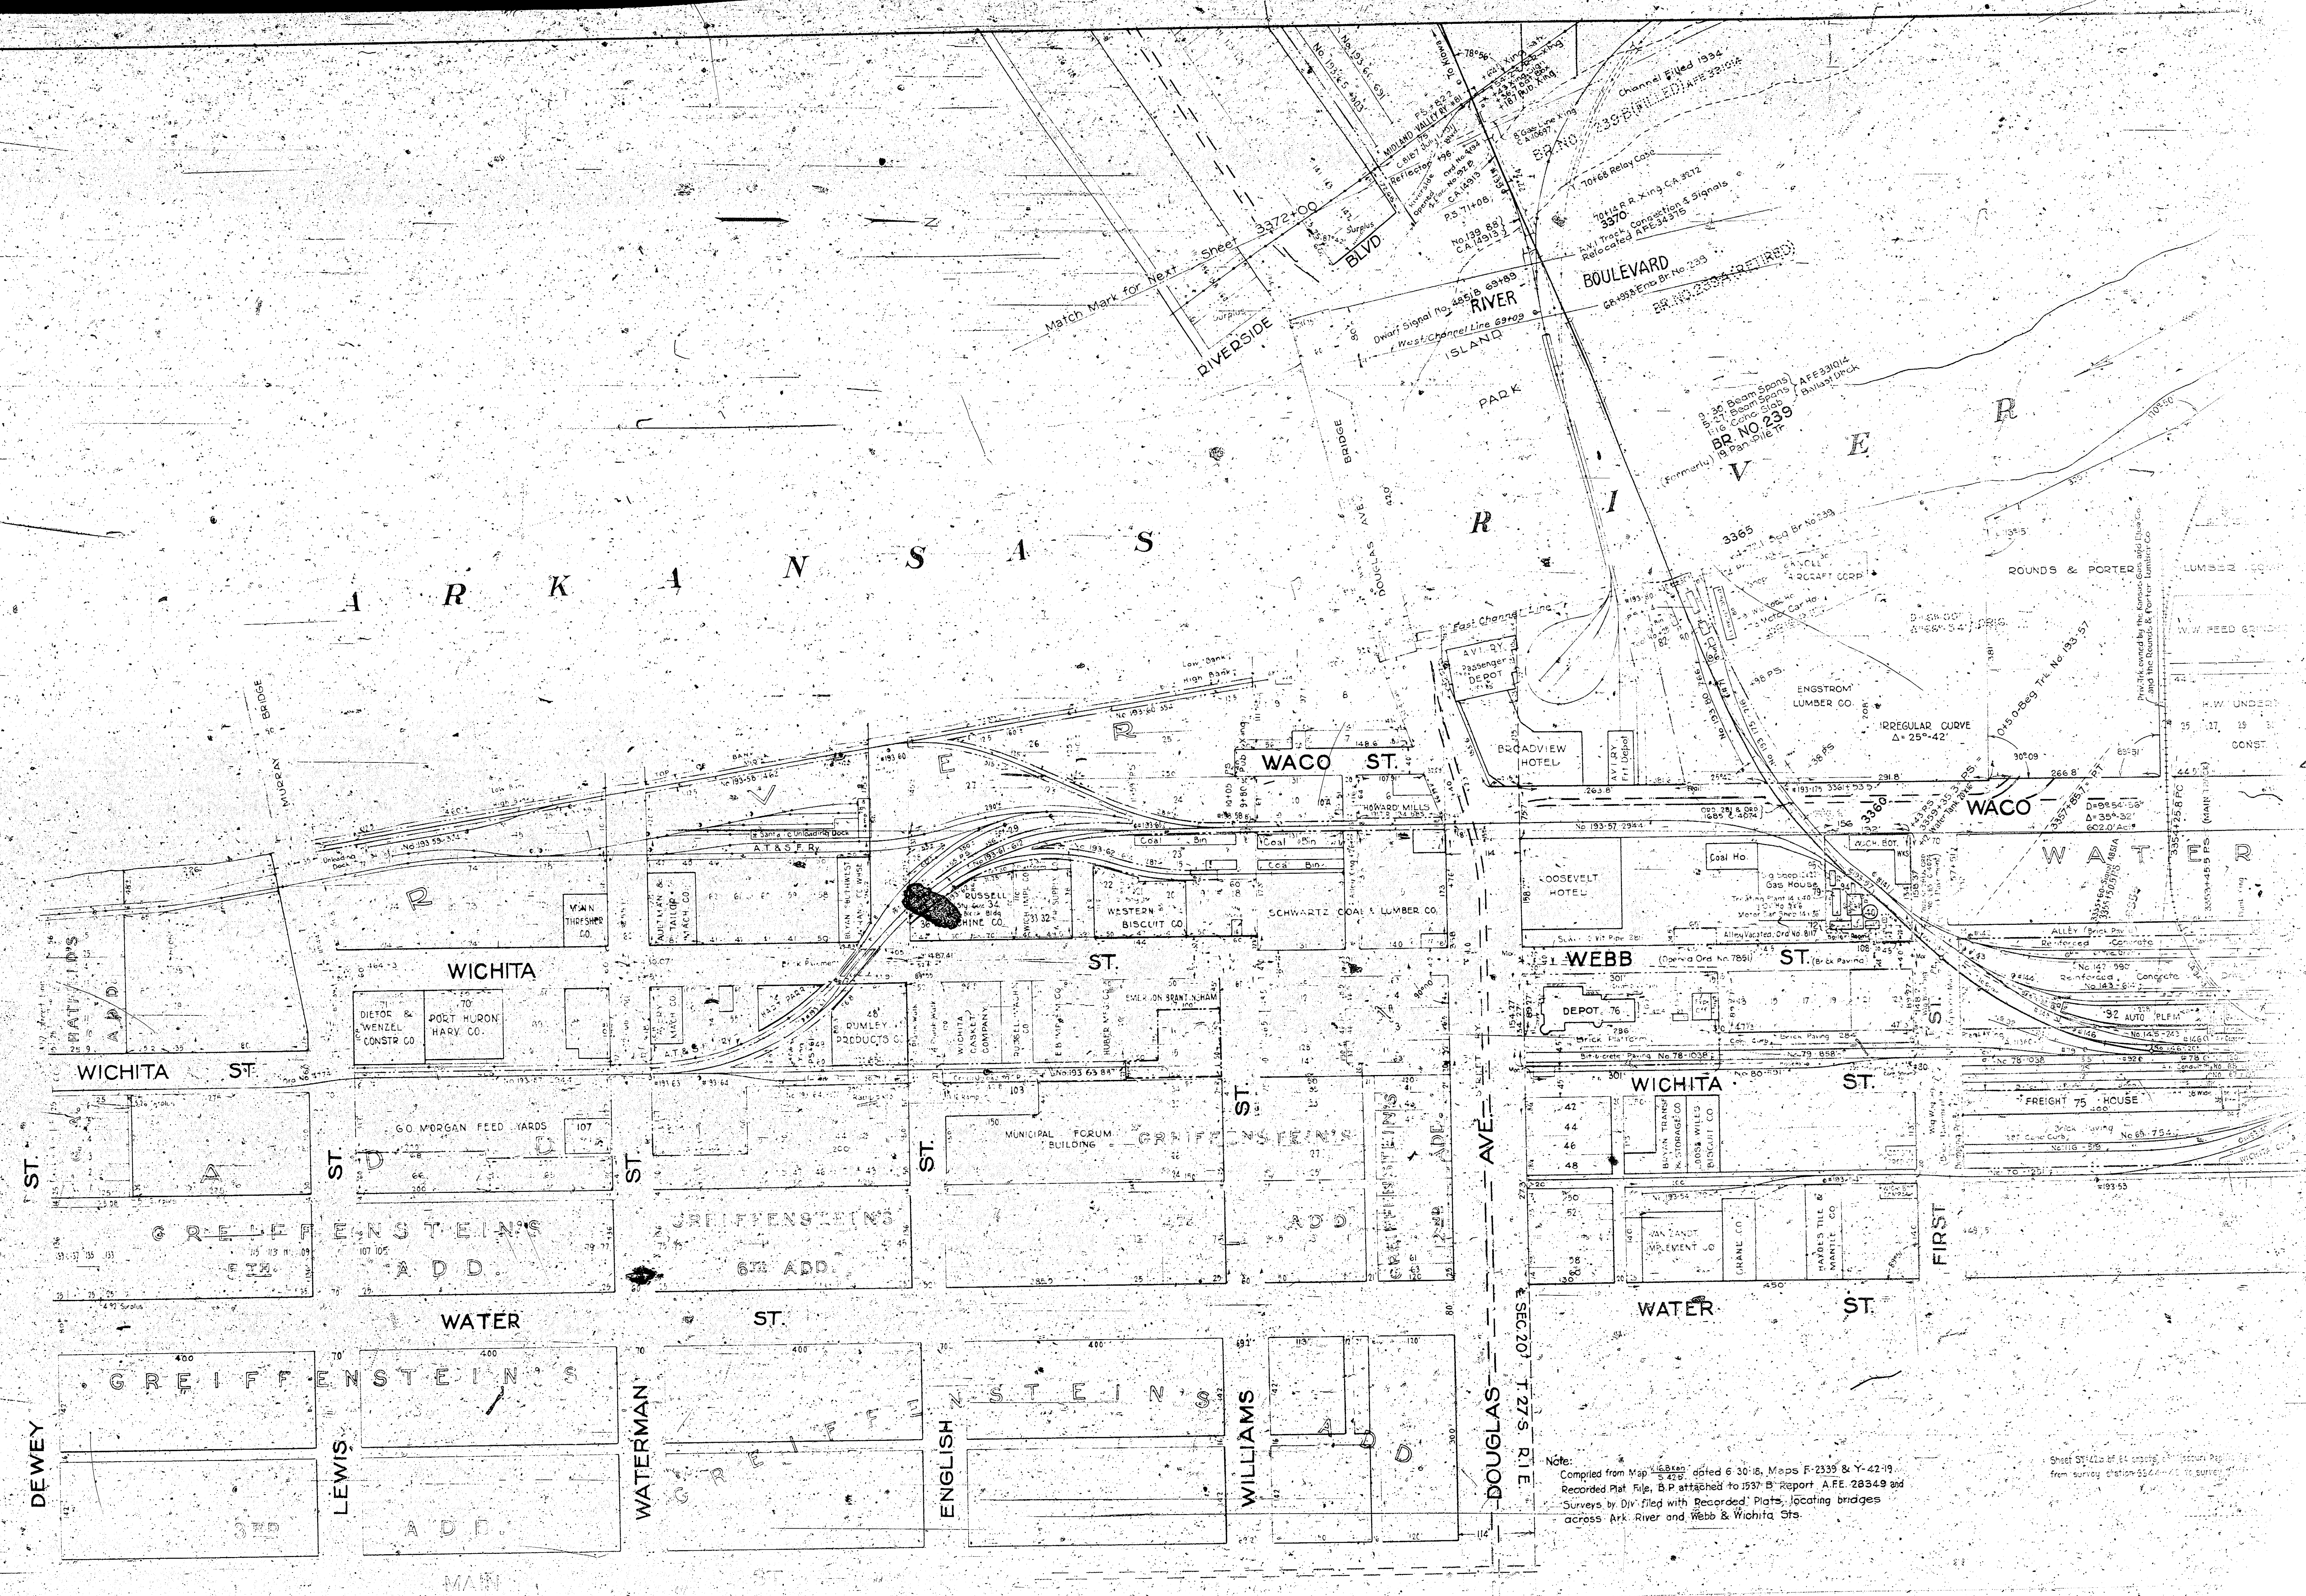

Note: Compiled from Map 4-8-11, dated 6-30-18, Maps F-2339 & Y-42-19. Recorded Plat File, B.P. attached to 2537 B Report A.F.E. 28349 and Surveys by Div. filed with Recorded Plats, locating bridges across Ark. River and Webb & Wichita Sts.

Sheet 2 of 2 of 21 sheets. (Total 42 sheets) from survey station 151516 to station 1531012.

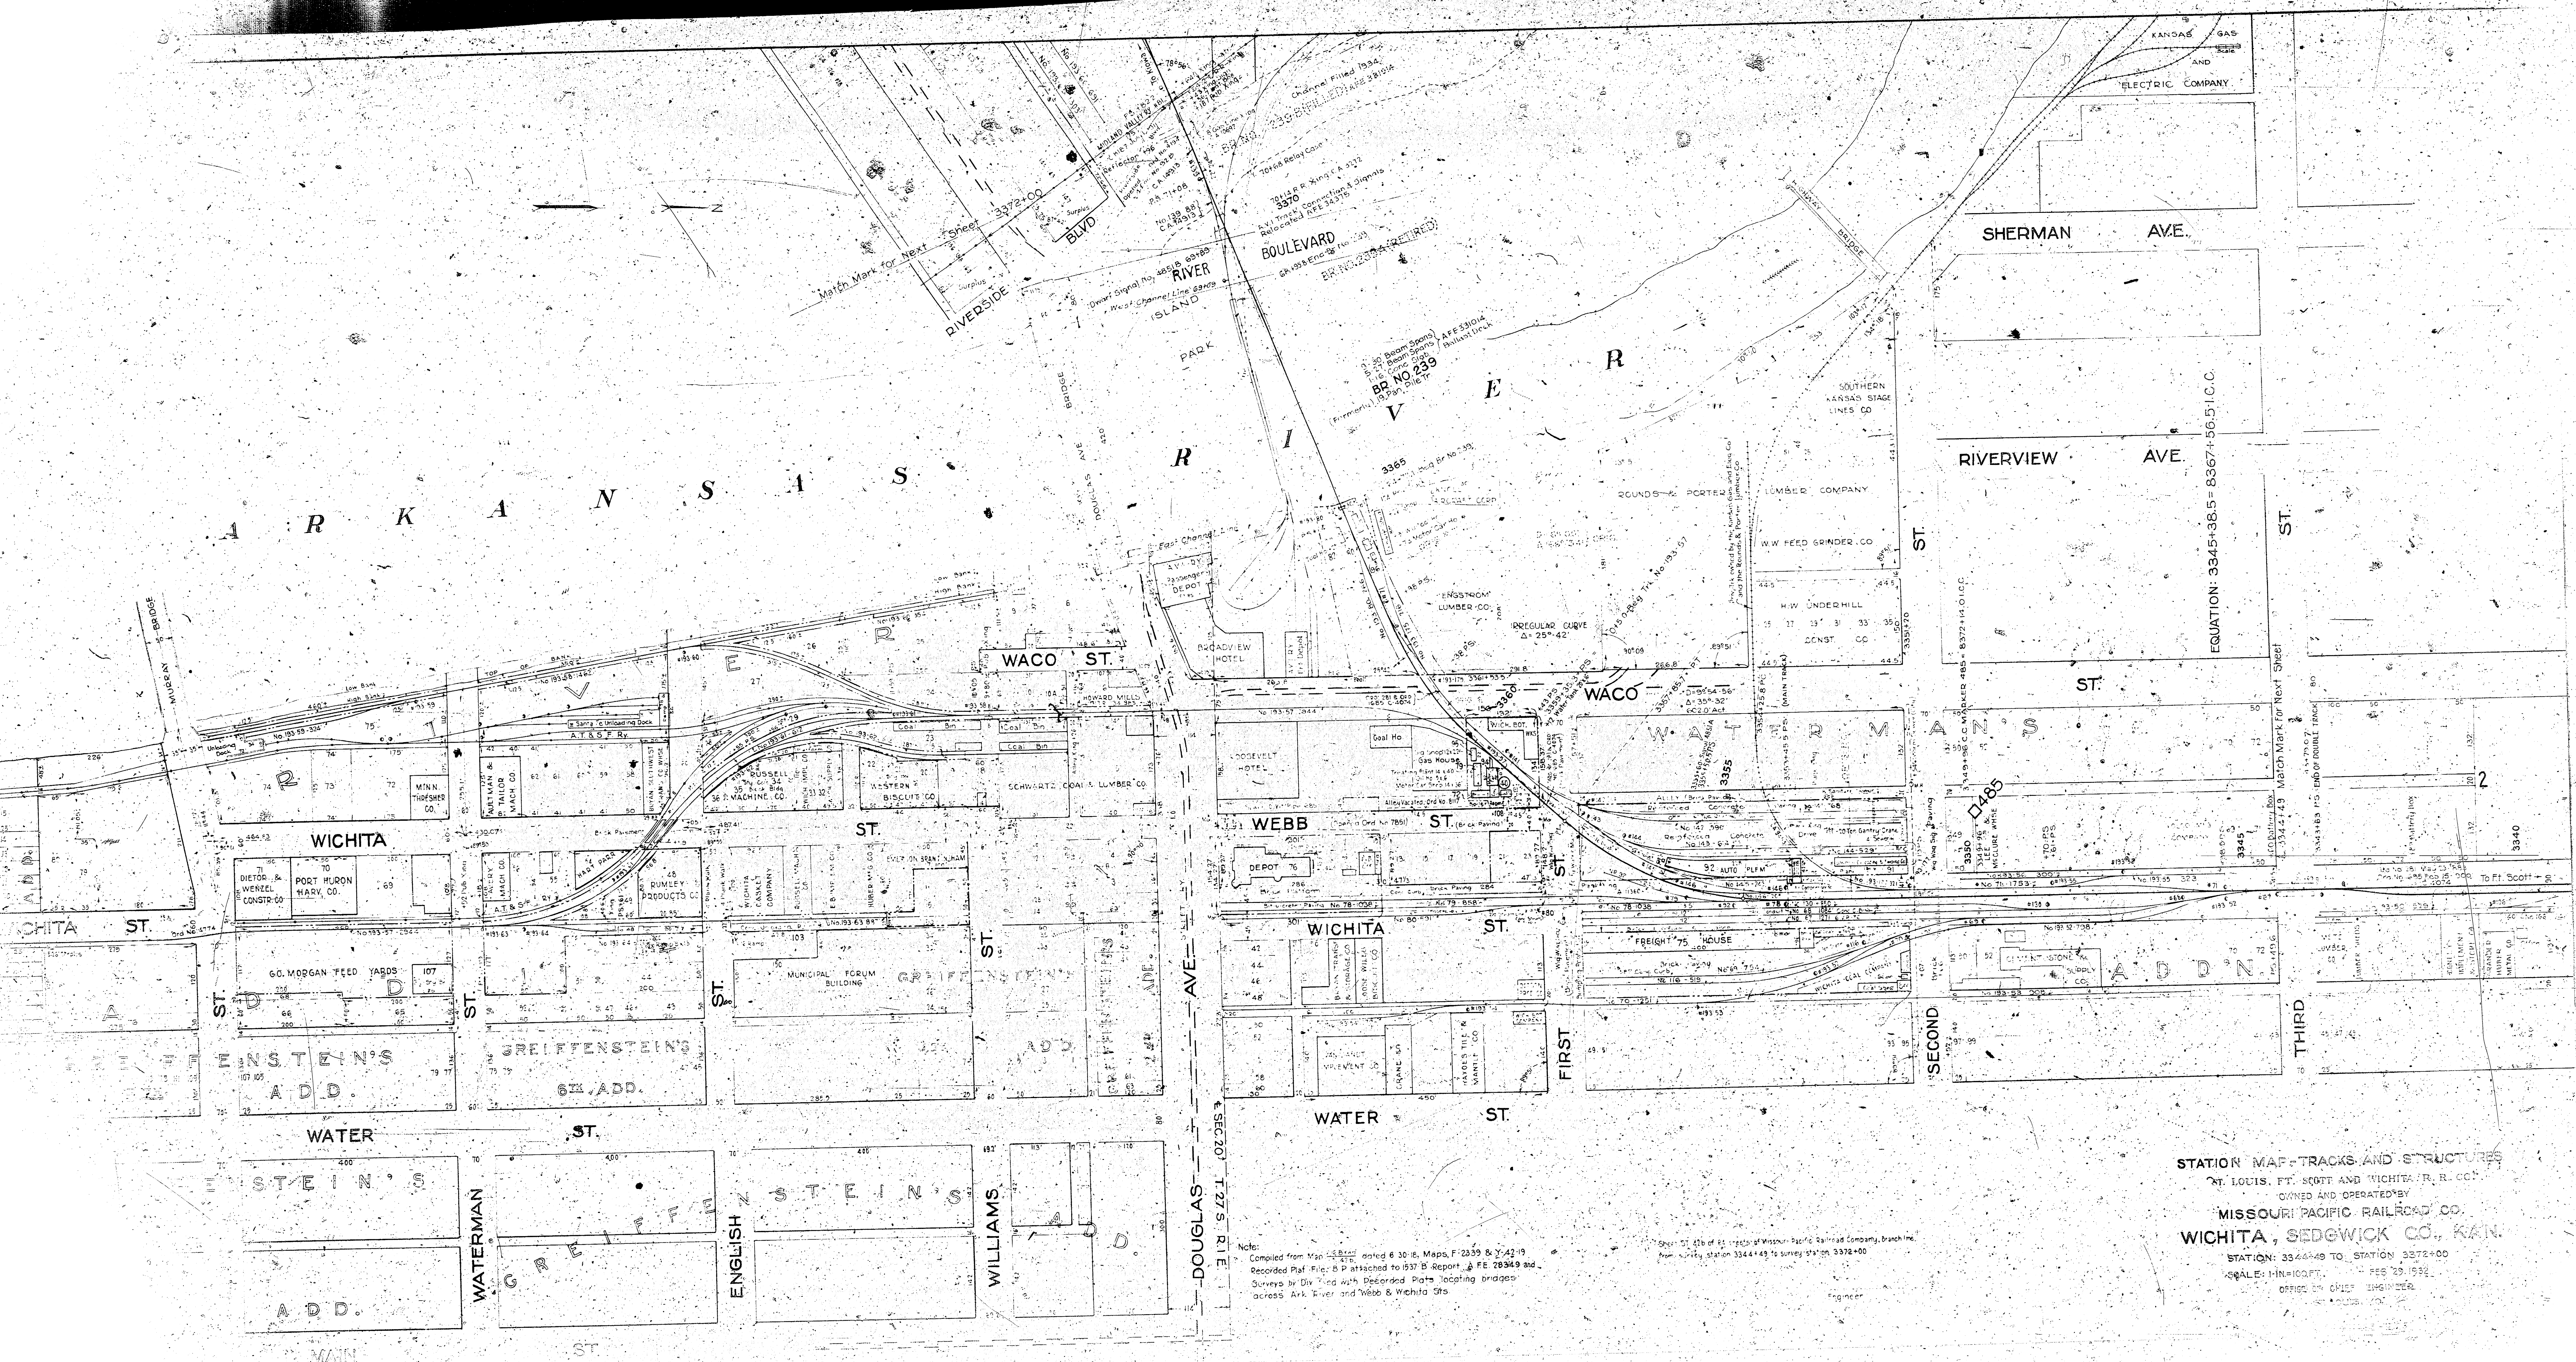

STATION MAP - TRACKS AND STRUCTURES
ST. LOUIS, FT. SCOTT AND WICHITA, R. R. CO.
OWNED AND OPERATED BY
MISSOURI PACIFIC RAILROAD CO.
WICHITA, SEDGWICK CO., KAN.
STATION 3344+49 TO STATION 3372+00
SCALE: 1"=100 FT.
OFFICE OF CHIEF ENGINEER

Note:
Compiled from Map 1-3-37, dated 6-30-36, Maps F-2339 & Y-4219
Recorded Plat. File: B-P attached to 1937 B-Report, & FE 20349 and
Surveys by Div. 1 and 2, with Recorded Plats, including bridges
across Ark. River and Webb & Wichita R.R.

Sheet 17, 18 of 25, of Map of Missouri Pacific Railroad Company, Branching
from Station 3344+49 to Station 3372+00
Engineer