N

B.M. 130.45 ~ R' in Ritchie, N. cb. Orme, E.L. Bleckley.

Bleckley

Bleckley Ct.

Drive

Orme St.

remove

Bleckley Drive
S.L. Orme ~ ℄ cul-de-sac (include cul-de-sac)
30' conc. & curb
City of Wichita, Kansas
L. K. White ~ City Engineer
Sept. 1950 Proj.# C-10-69

4 2 3 S.L.

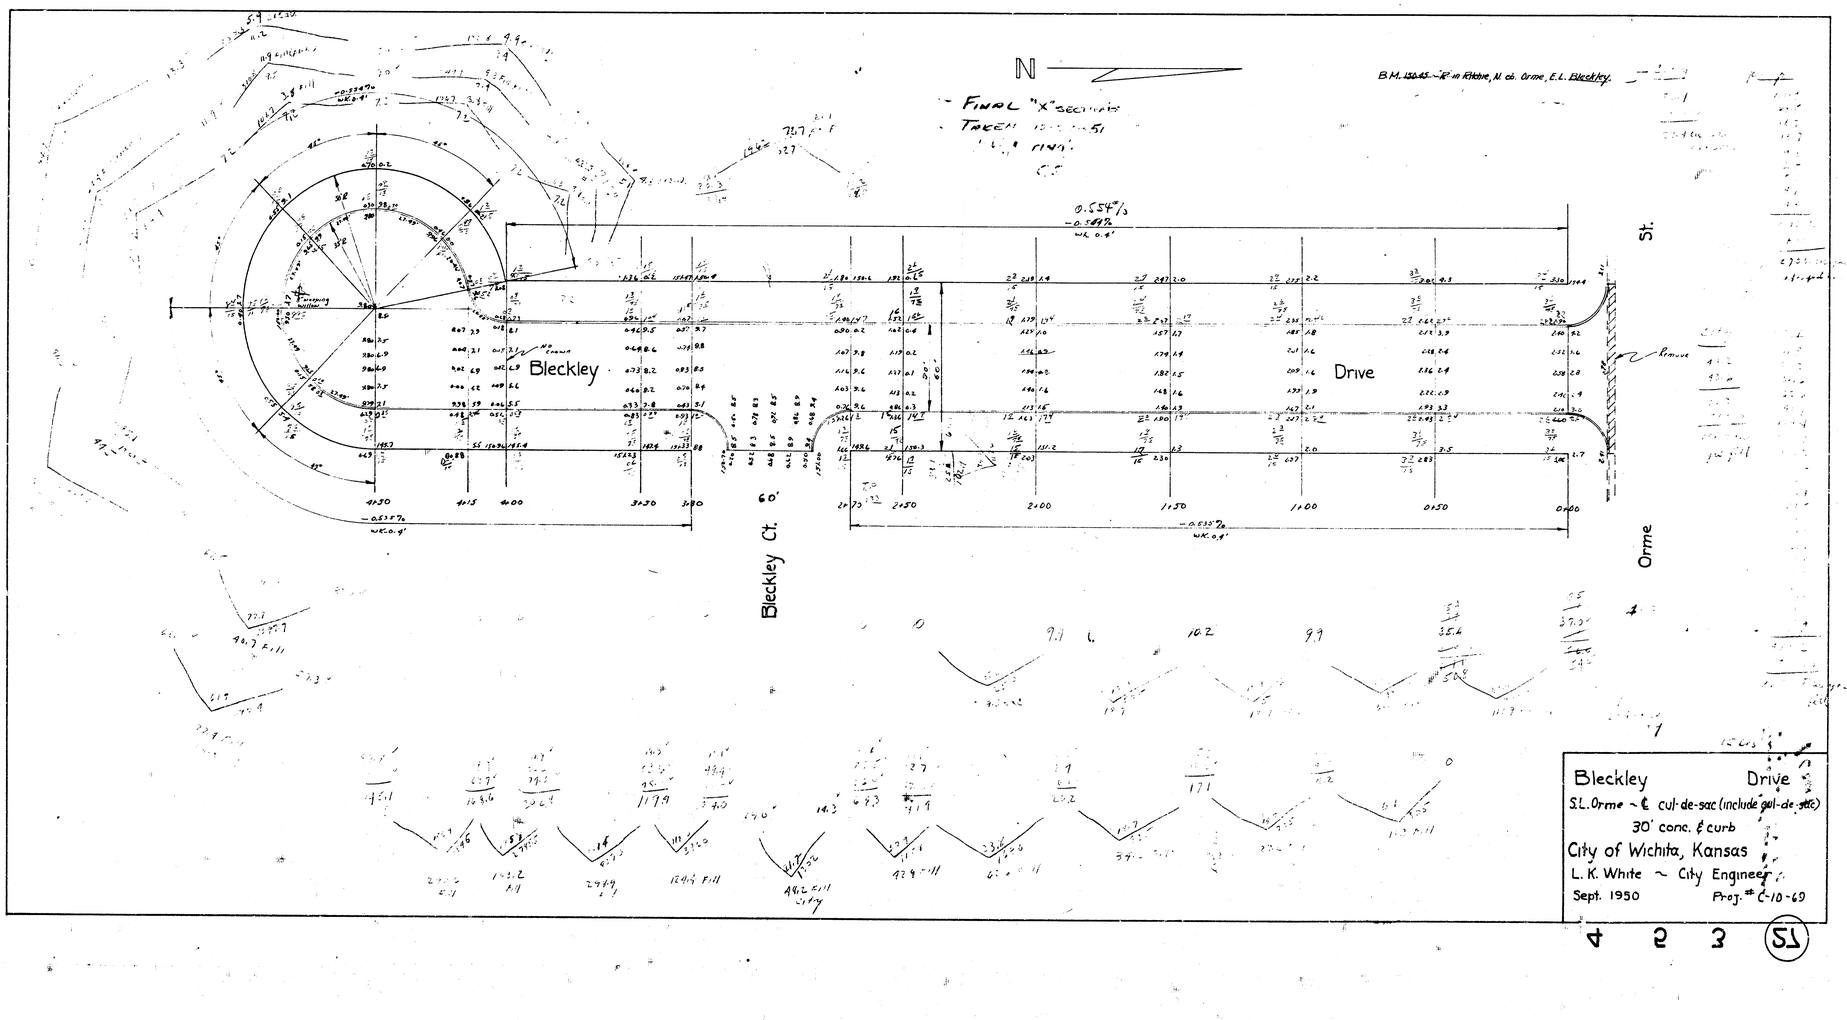
N
B.M. 150.45 ~ R in Ritchie, N. ob. Orme, E.L. Bleckley.
Bleckley
Drive
Bleckley Ct.
Orme
St.
60'
Remove
Bleckley Drive
S.L. Orme ~ ℄ cul-de-sac (include cul-de-sac)
30' conc. & curb
City of Wichita, Kansas
L. K. White ~ City Engineer
Sept. 1950
Proj. # C-10-69