


AVE.


Down

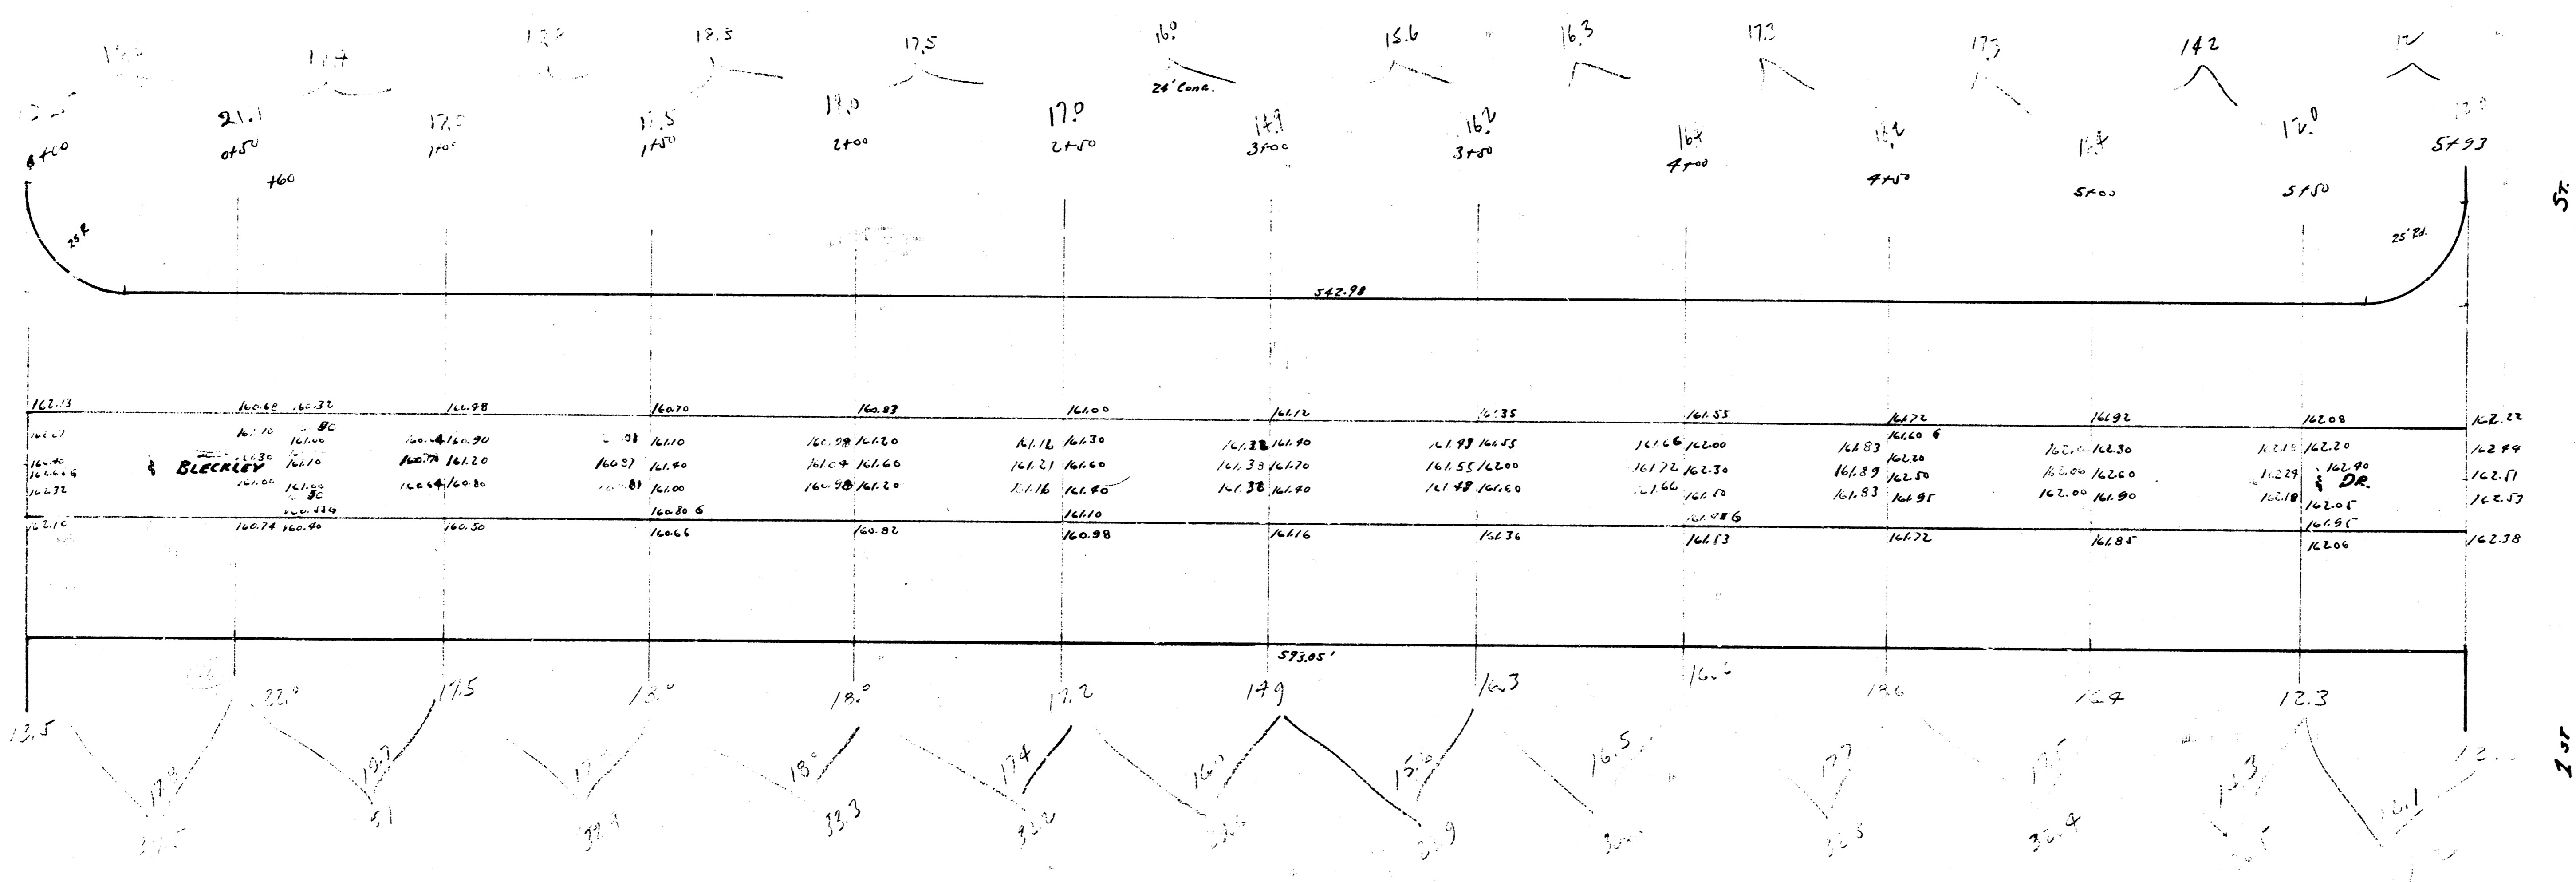

$$\frac{110 \times 3}{703} = 0.47$$

$$+ 101 = 101.47$$


Ave.

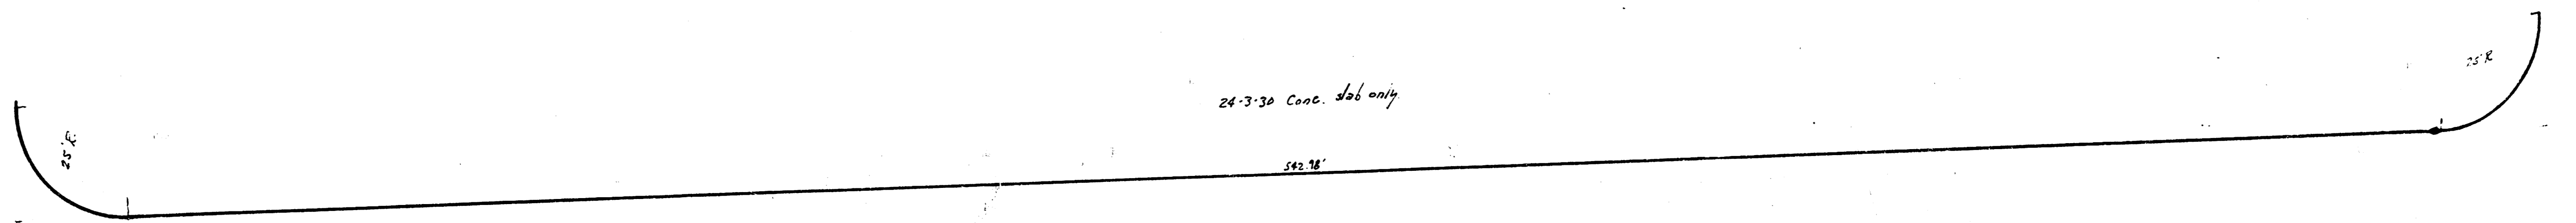


542.98'


25.2'

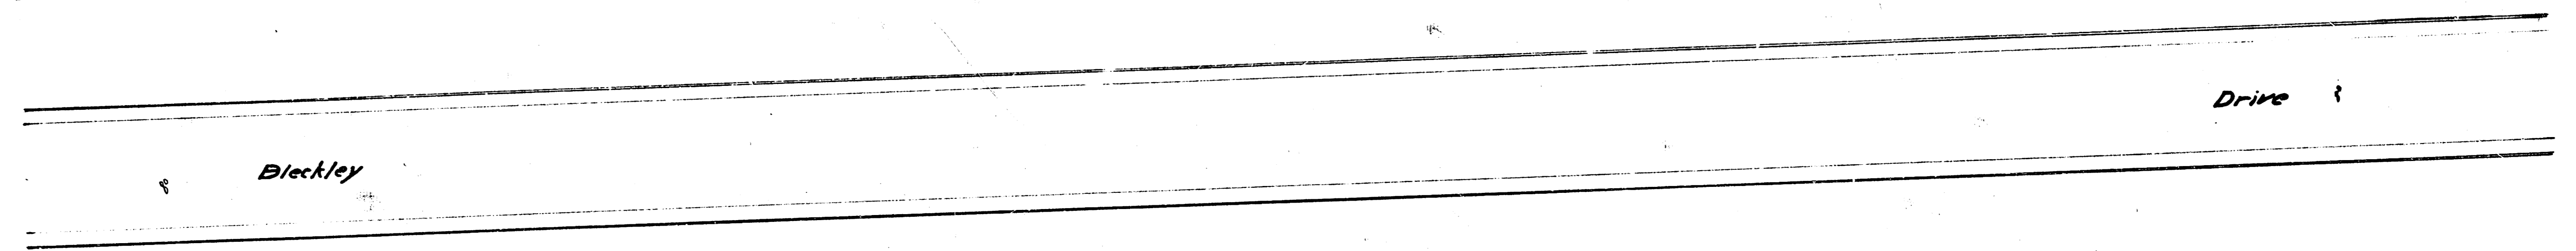

Bleckley

Drive

Douglas

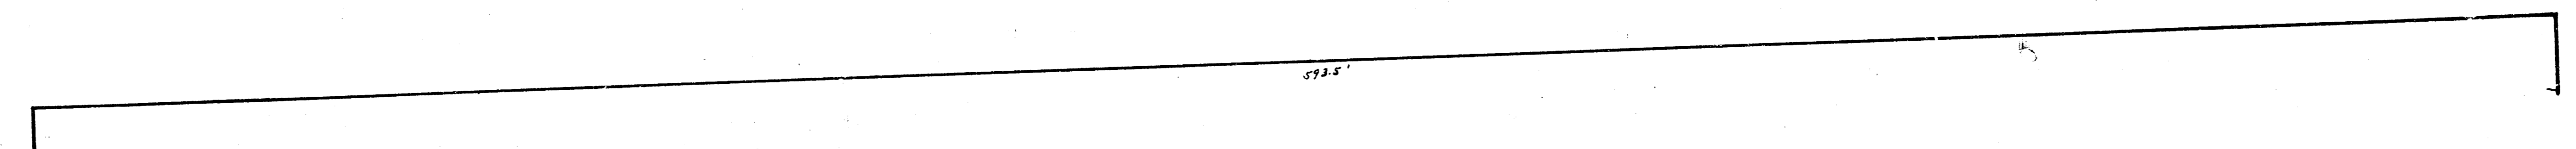


54'

14'

plan
for 1538
Bleckley Drive
at Douglas
St. First