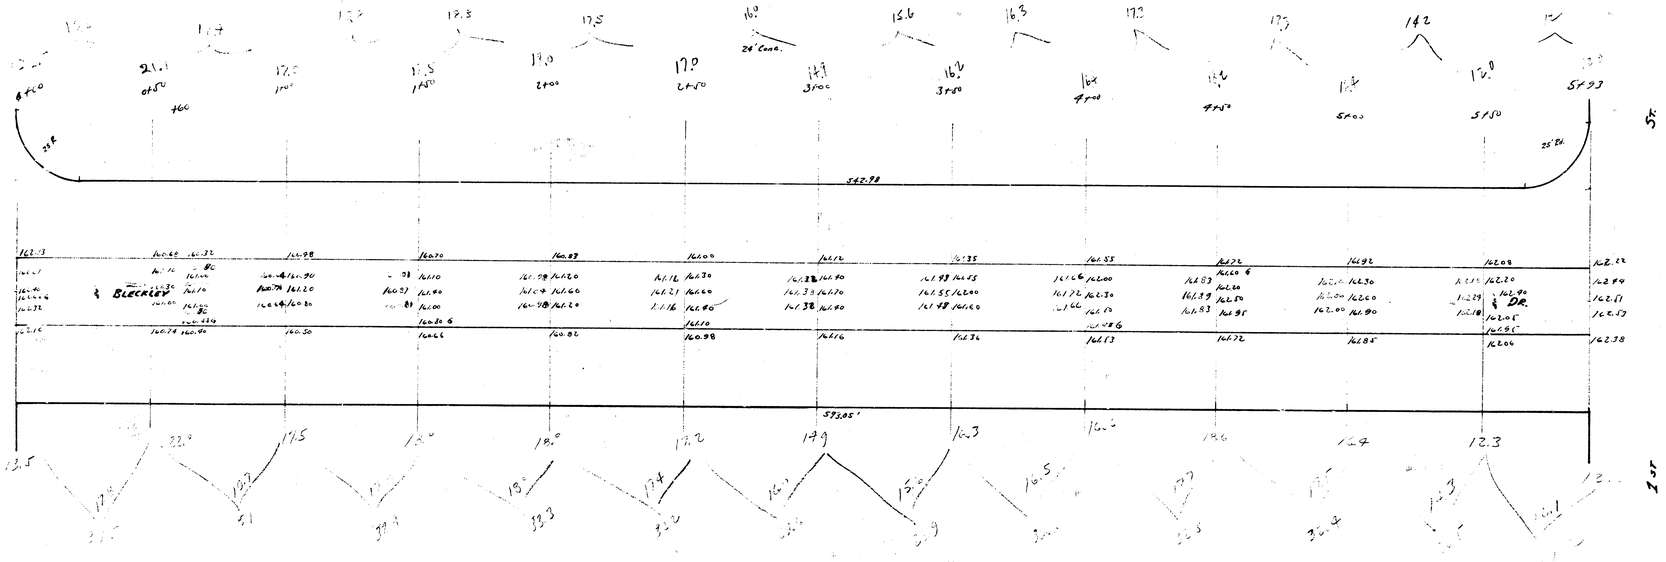
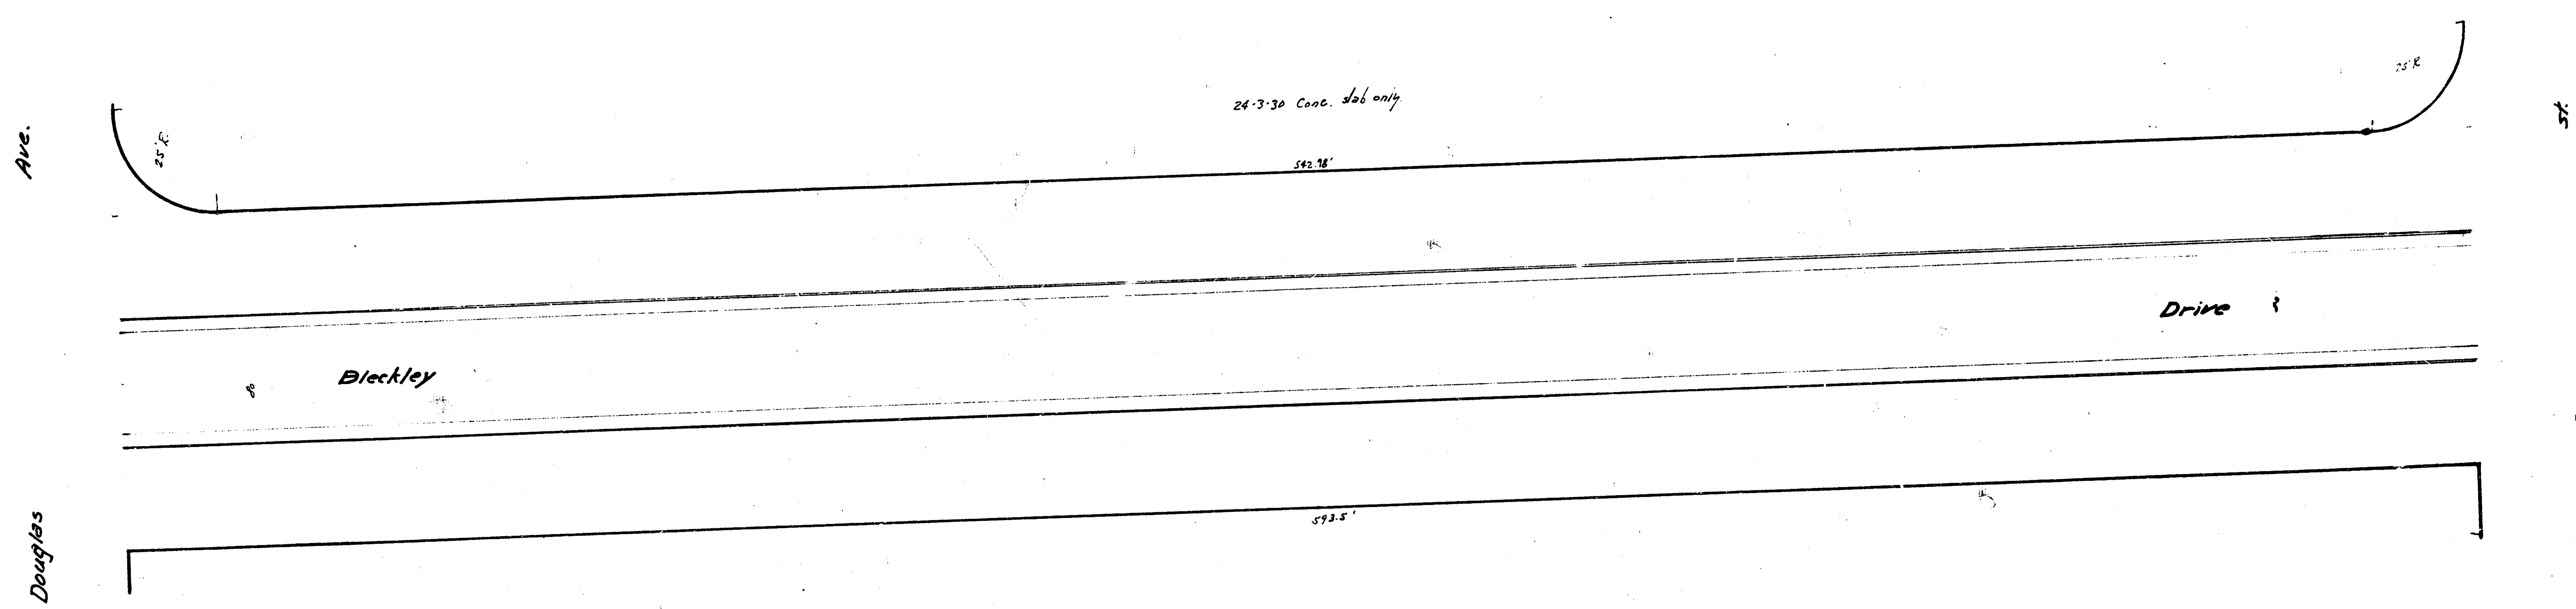

Douglas
Bleckley
S.I. 403+00



Pav. plan 1938
Bleckley Drive
W. Douglas
to
E. First