

FINAL "X" sections
 Taken 10-21-51
 L.K. WHITE, C.E.

B.M. 150.45 ~ P in Ritchie, Al. ch. Orme, E.L. Bleckley Drive.

Drive
 Bleckley Ct.


30' conc. curb
 City of Wichita, Kansas
 L.K. White ~ City Engineer
 Sept. 1950
 Proj. C-10-68

2172

propriet

289.2
 320.5
 44.4
 64.7
 311.9
 66.6
 78.7
 22.7
 70.7
 62.9
 61.7
 65.6
 71.0
 28.2
 70.0
 45.5
 20.2

9/20/41

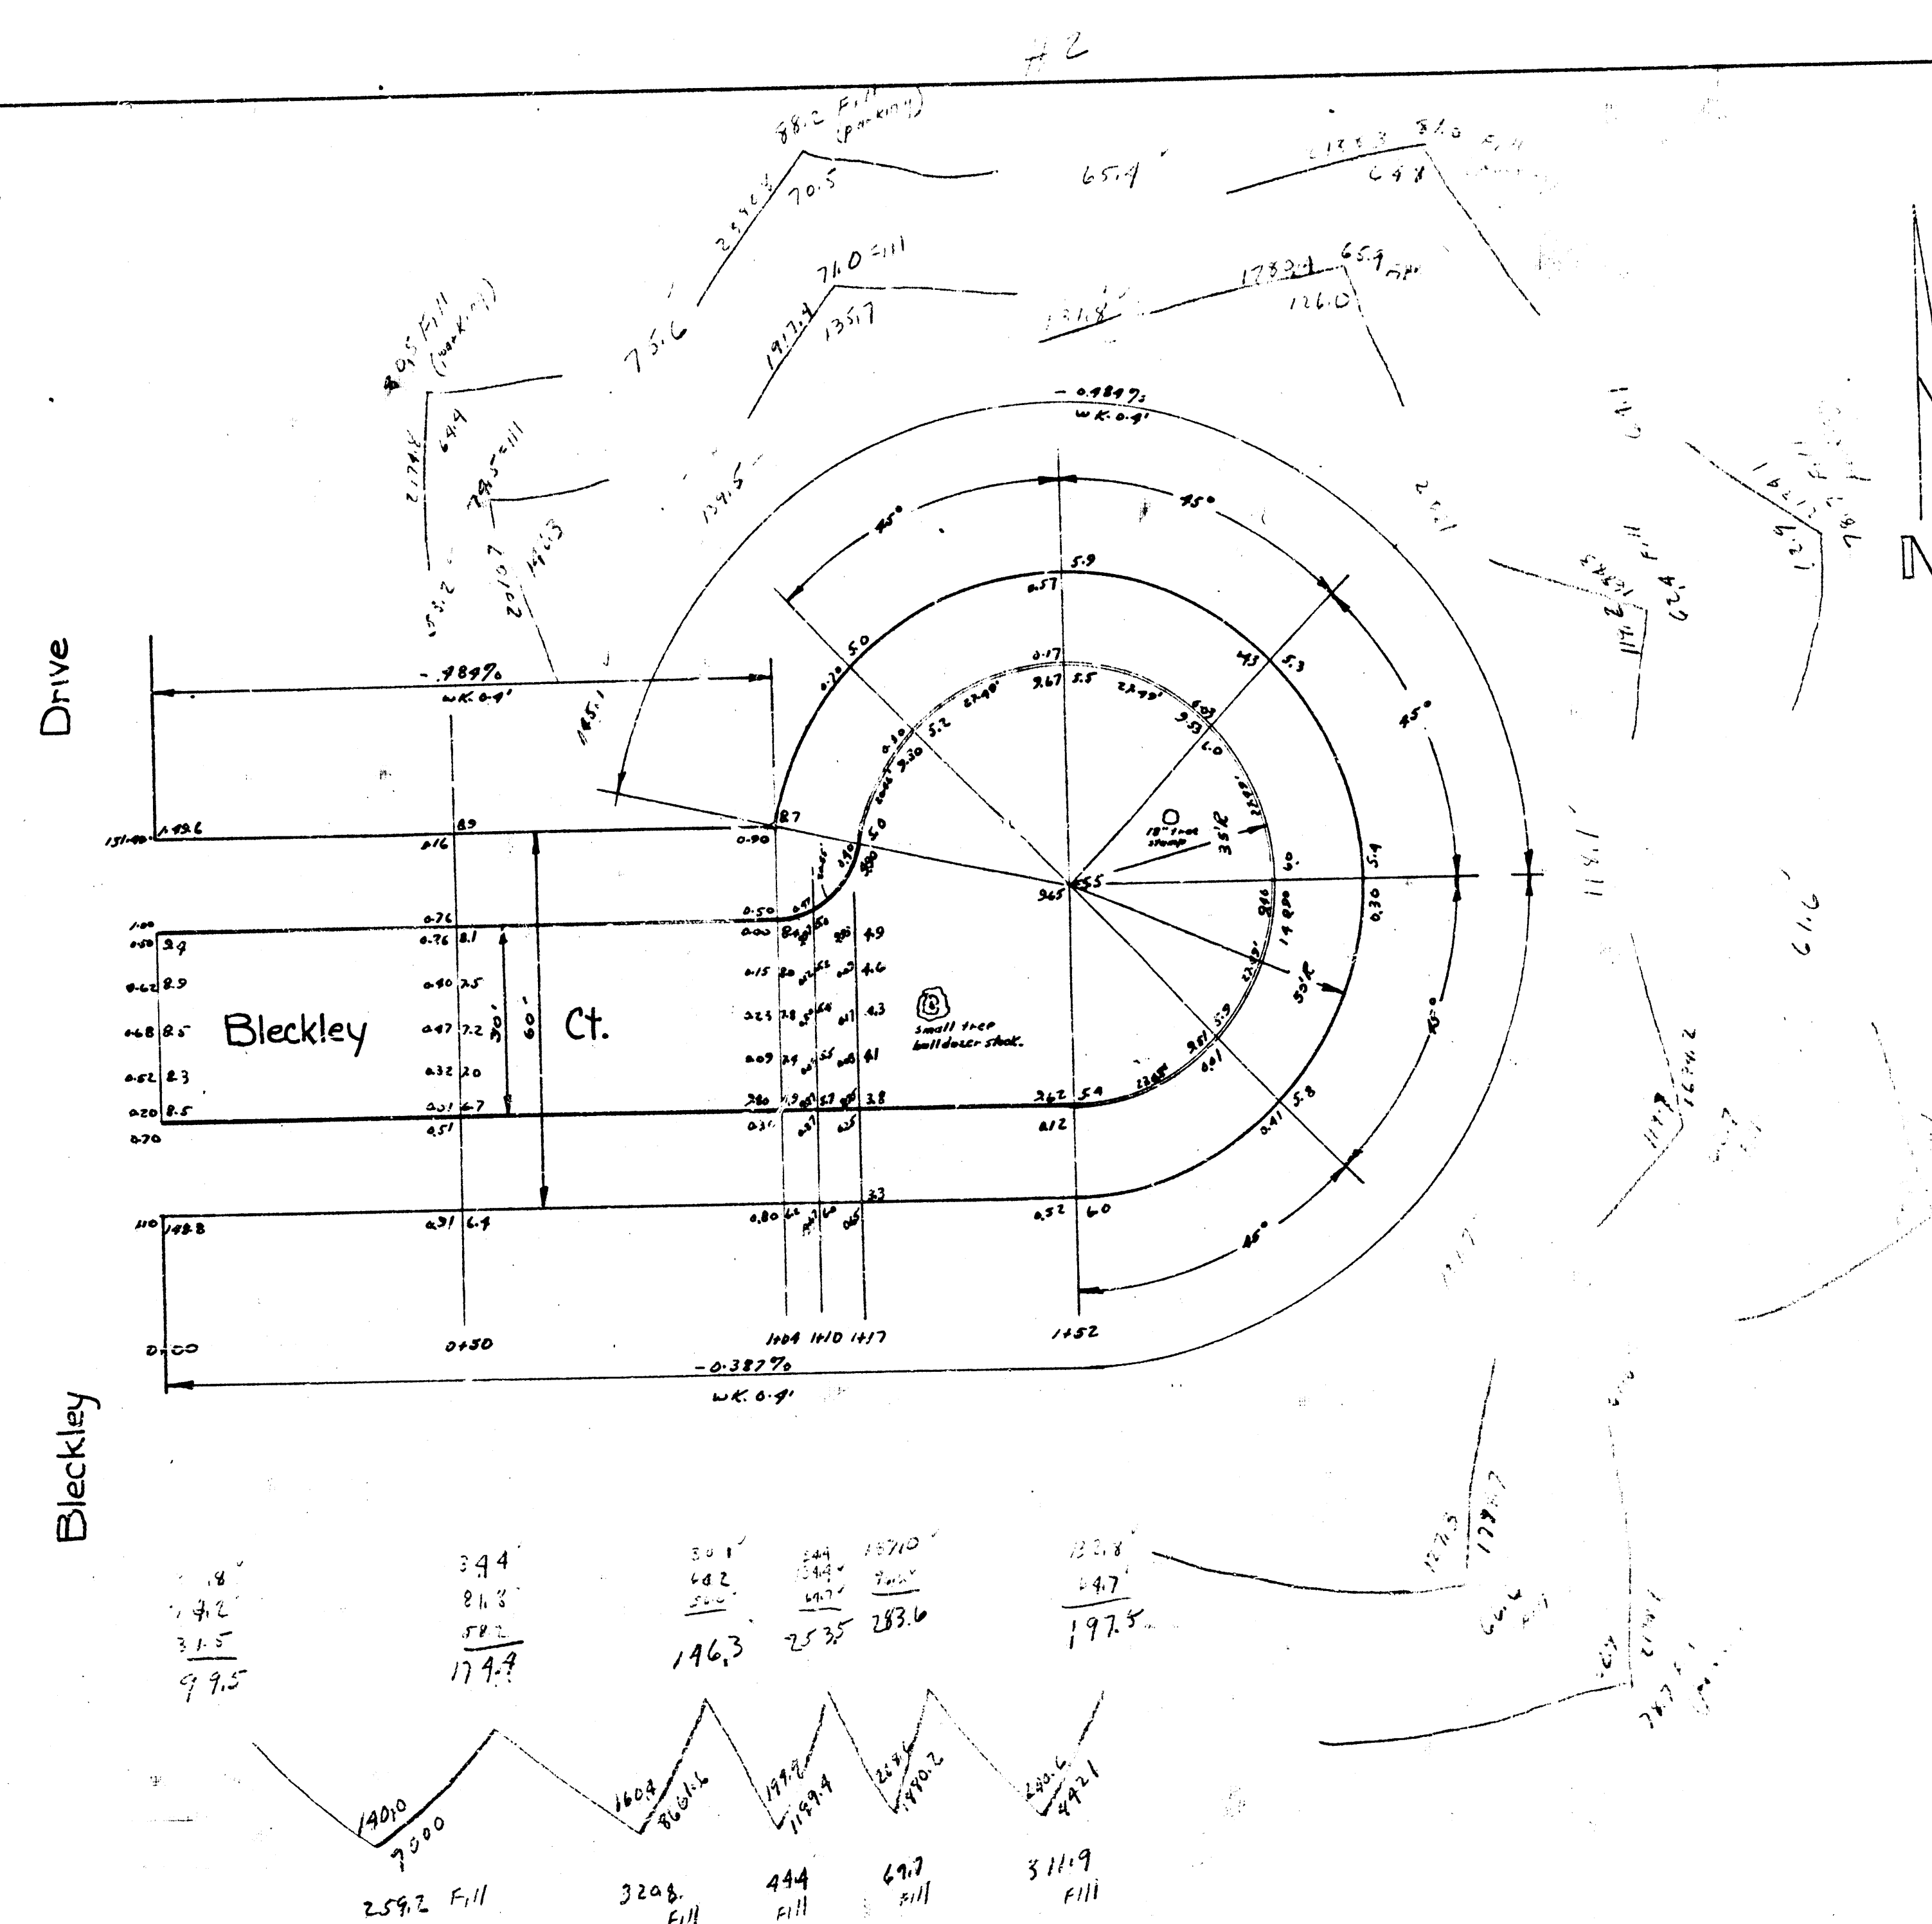

30' conc. & curb
City of Wichita, Kansas
L.K. White ~ City Engineer
Sept. 1950 Proj. # C-10-68