


S-5

B.M. 170.71 '6" in Globe E. end radius N.E. Cor. Second & W.B.Y. side Pkwy
B.M. 176.83 '6" in Globe 10' S. of S. end radius E.S. Patton & S.S. Second

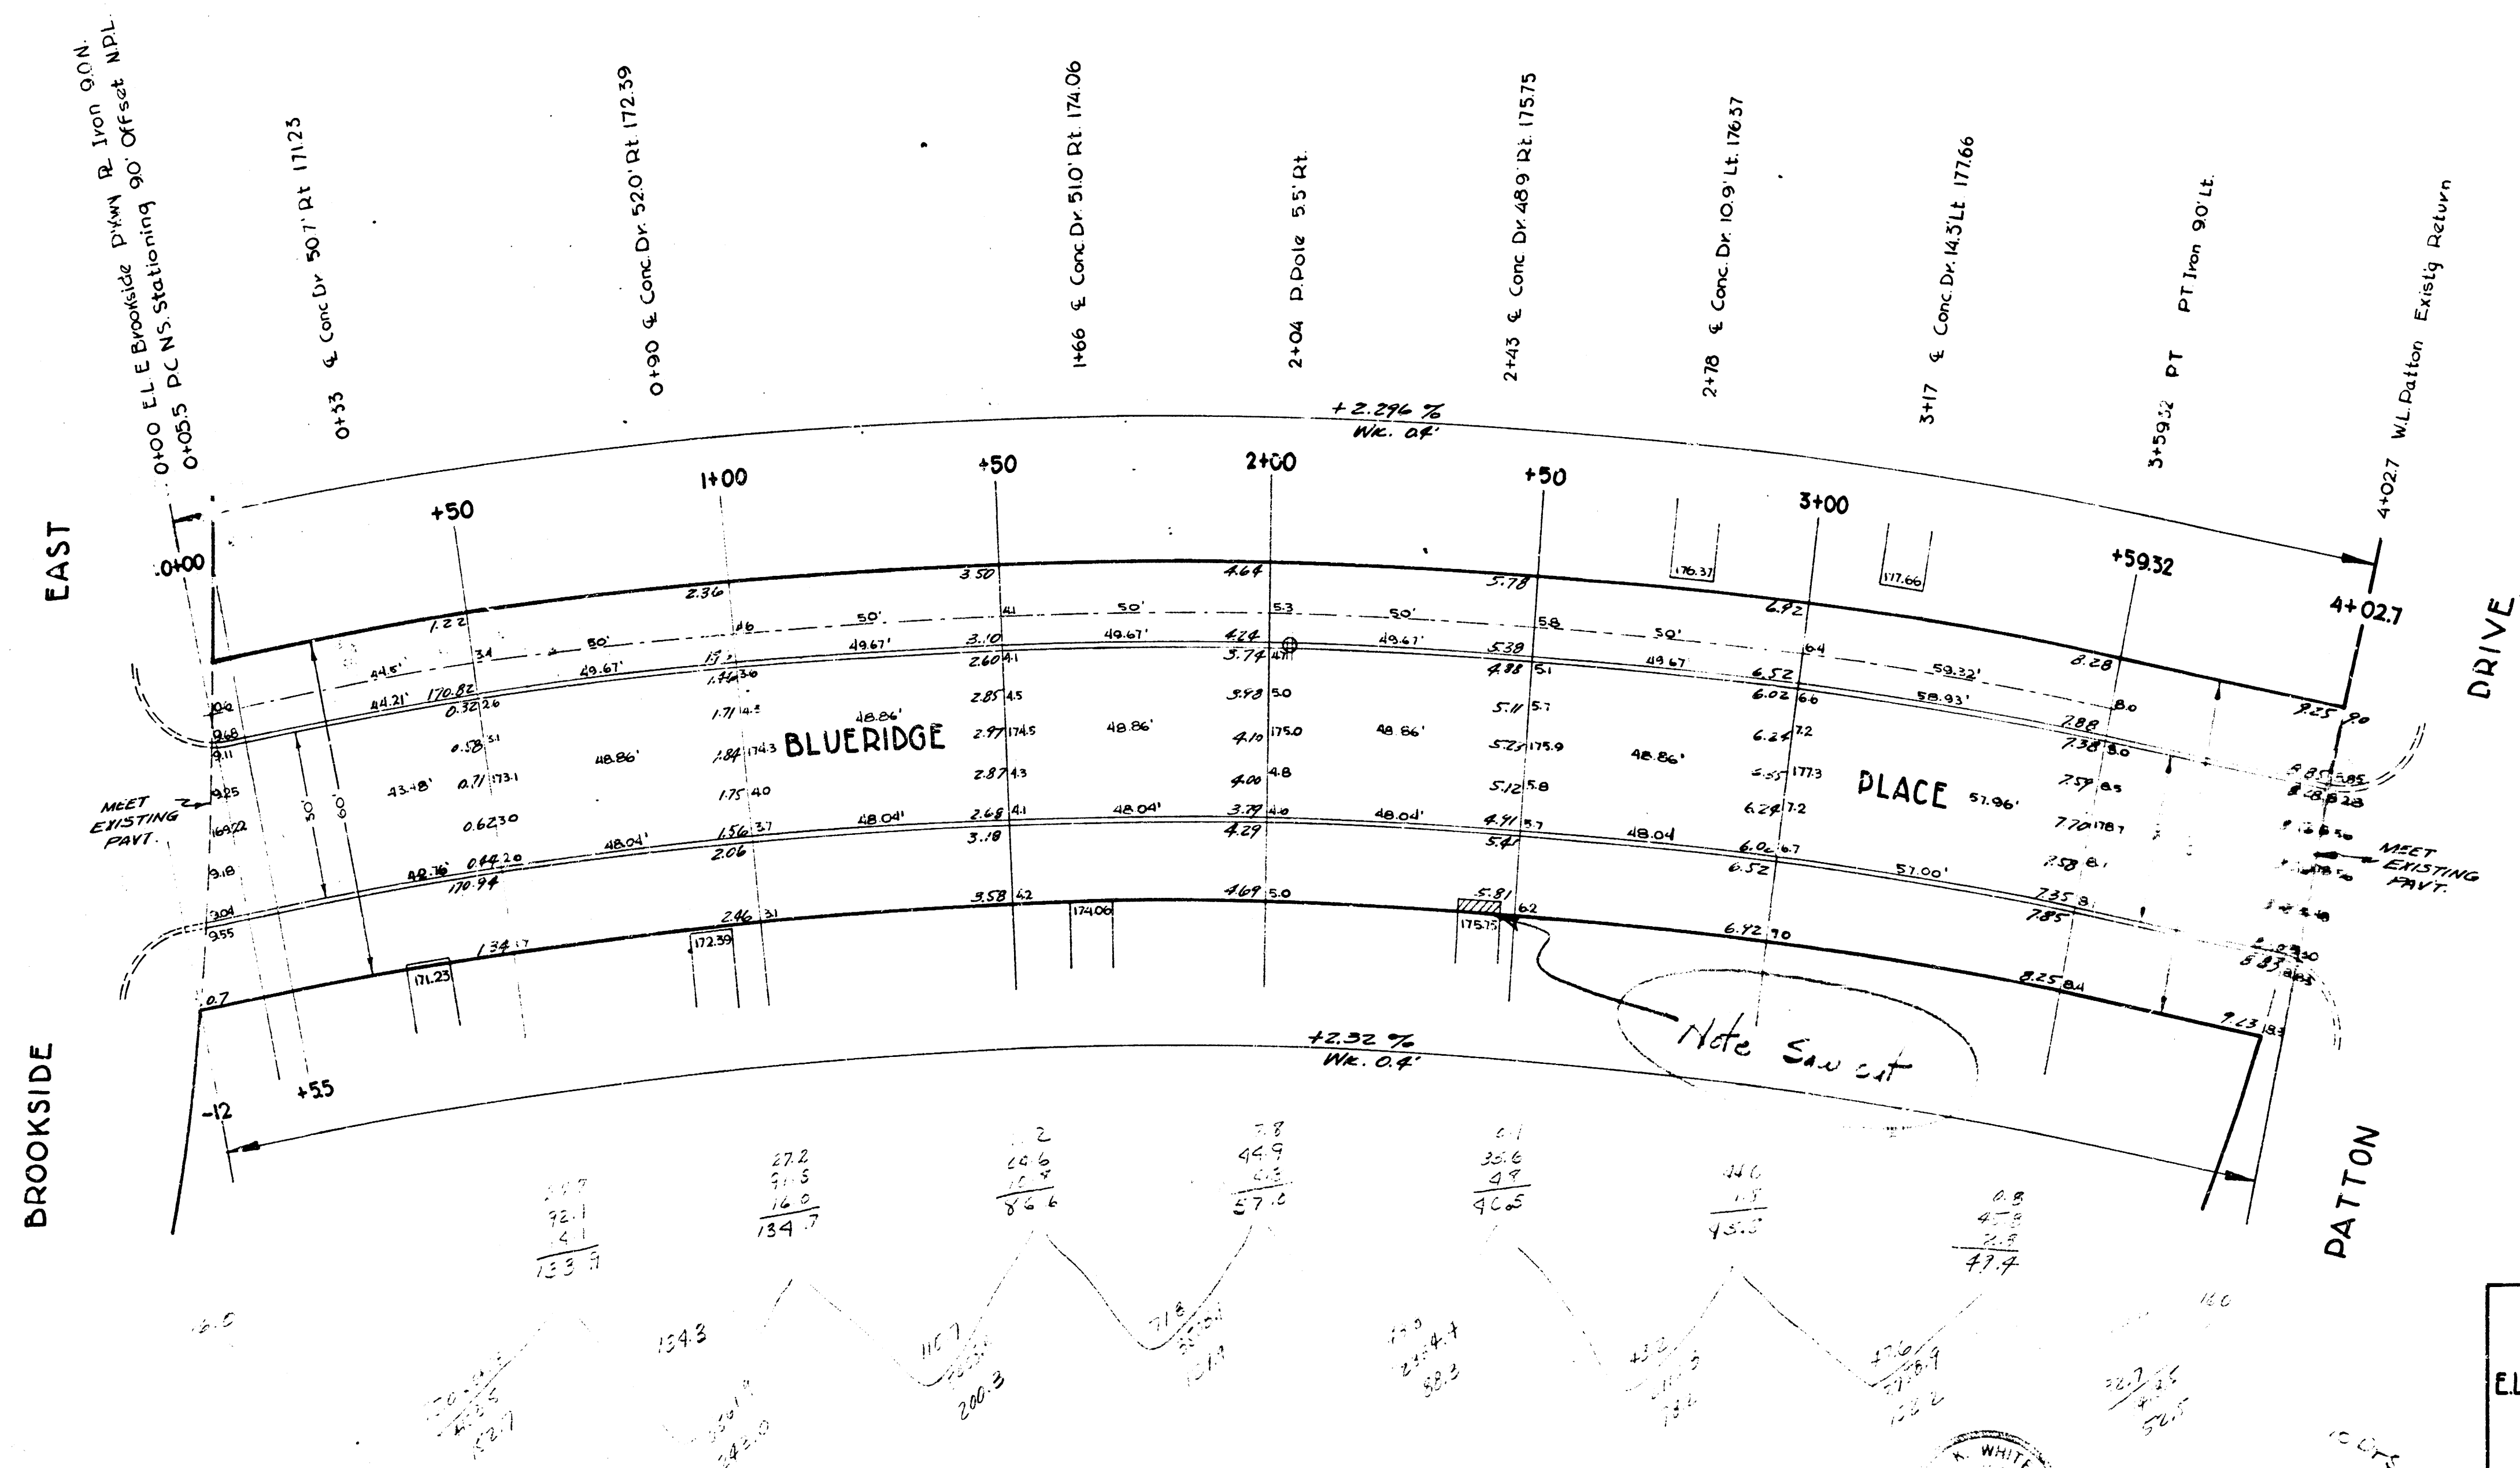

SCALE 1"=20'

BLUE RIDGE PLACE
EL. BROOKSIDE PKWY. TO WL. PATTON DR.
30' Conc. & Cb
CITY OF WICHITA, KANSAS
L.K. WHITE CITY ENGINEER
SEPT. 1951 PROJ. NO. C11-85