

H-7


BM: 140.77 Standard NW corner Woodlawn & Harry.
Stationing on E Boston going East.

Excavation	City	Property
Property	85.6	22.5
5.1	15.0	99.0
13.5	15.0	
12.5		
13.7		
12.3		
12.4		
12.5		
55.4		
23.2		
42.5		
5		
100.0		

TP 135.47 Iron NW corner Inverness & Boston.



Total Excavation	City
Property	129.6
101.0	112.15
51.9	
107.5	266.4
40.10	
117.7	

Total Fill	City
Property	24.1
24.1	24.1
3.5	
3.5	
392.4	

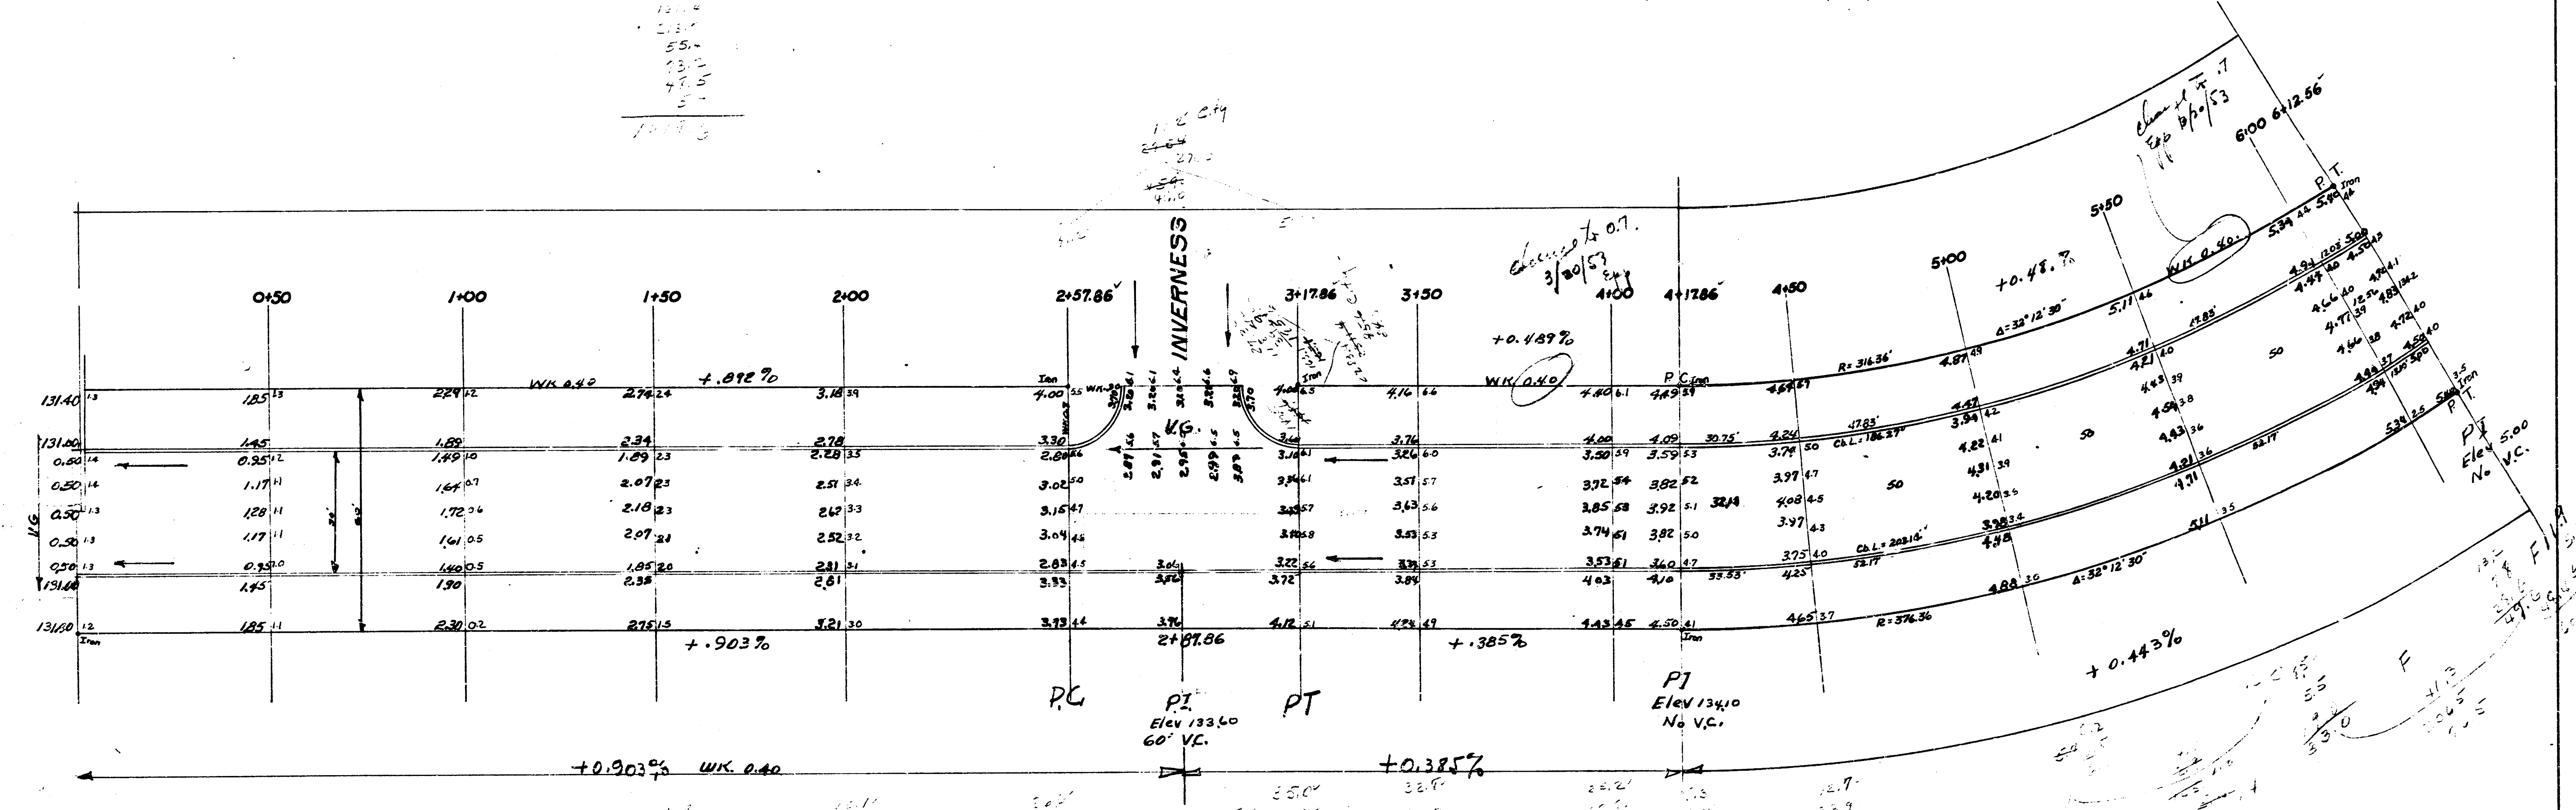

BOSTON ST.
EL. FABRIQUE TO WL. WOODLAWN
30' Conc. & Cb.
City of Wichita, Kansas
L.K. White City Engineer
Nov 1951 Proj No. C11-257.



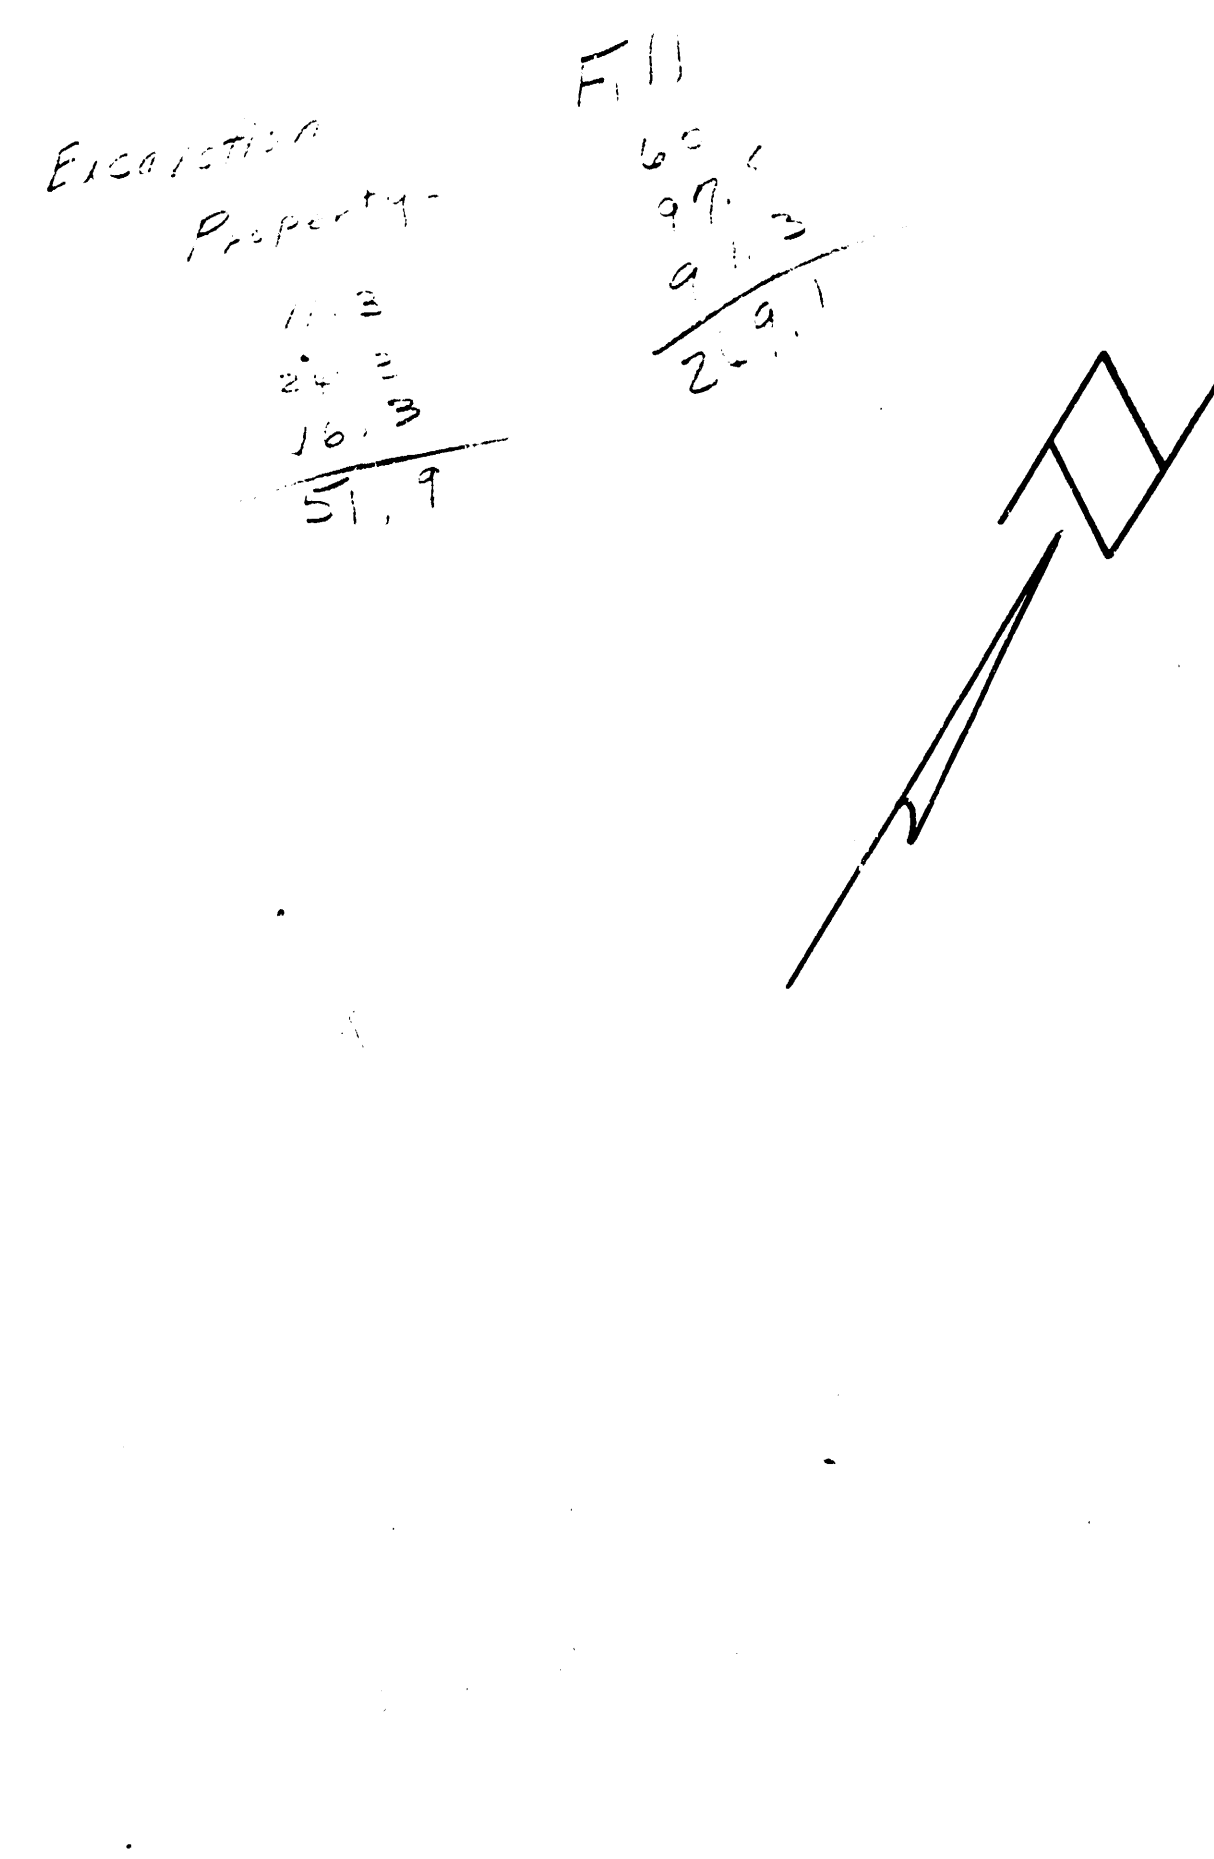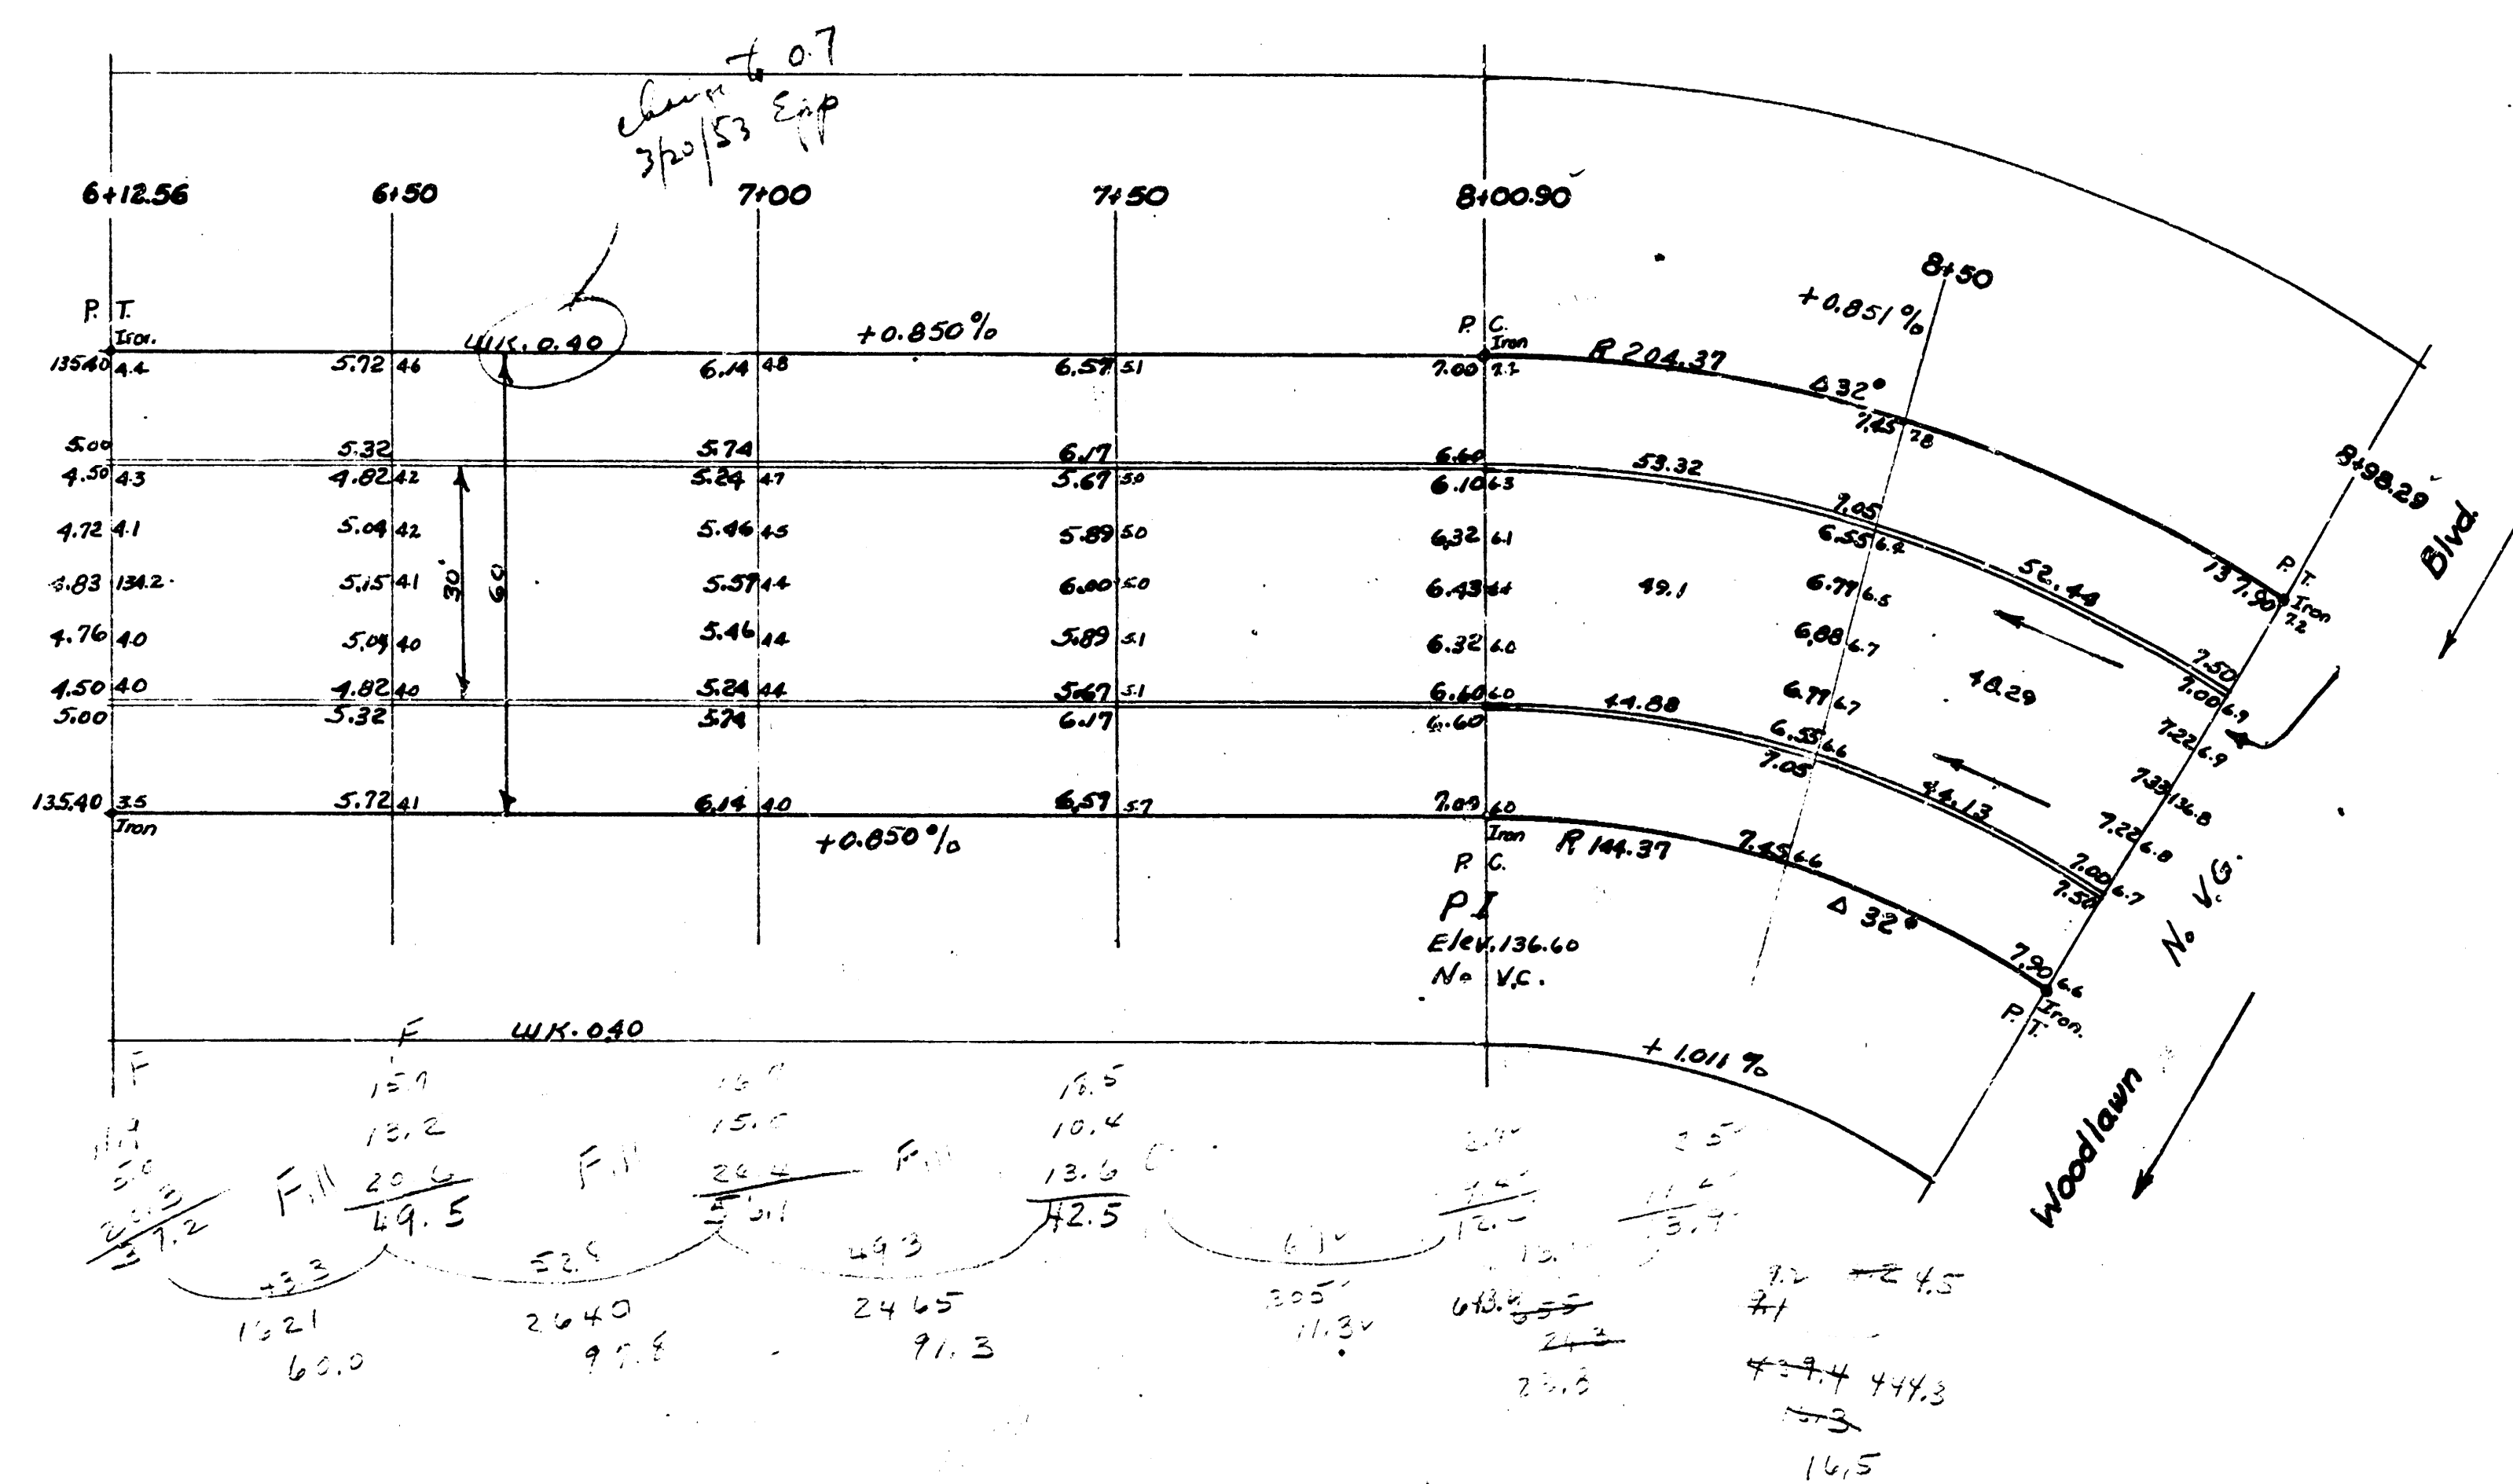

Note: Mix 1/3 Sand & Sheepfoot
Fill

BOSTON ST.

