



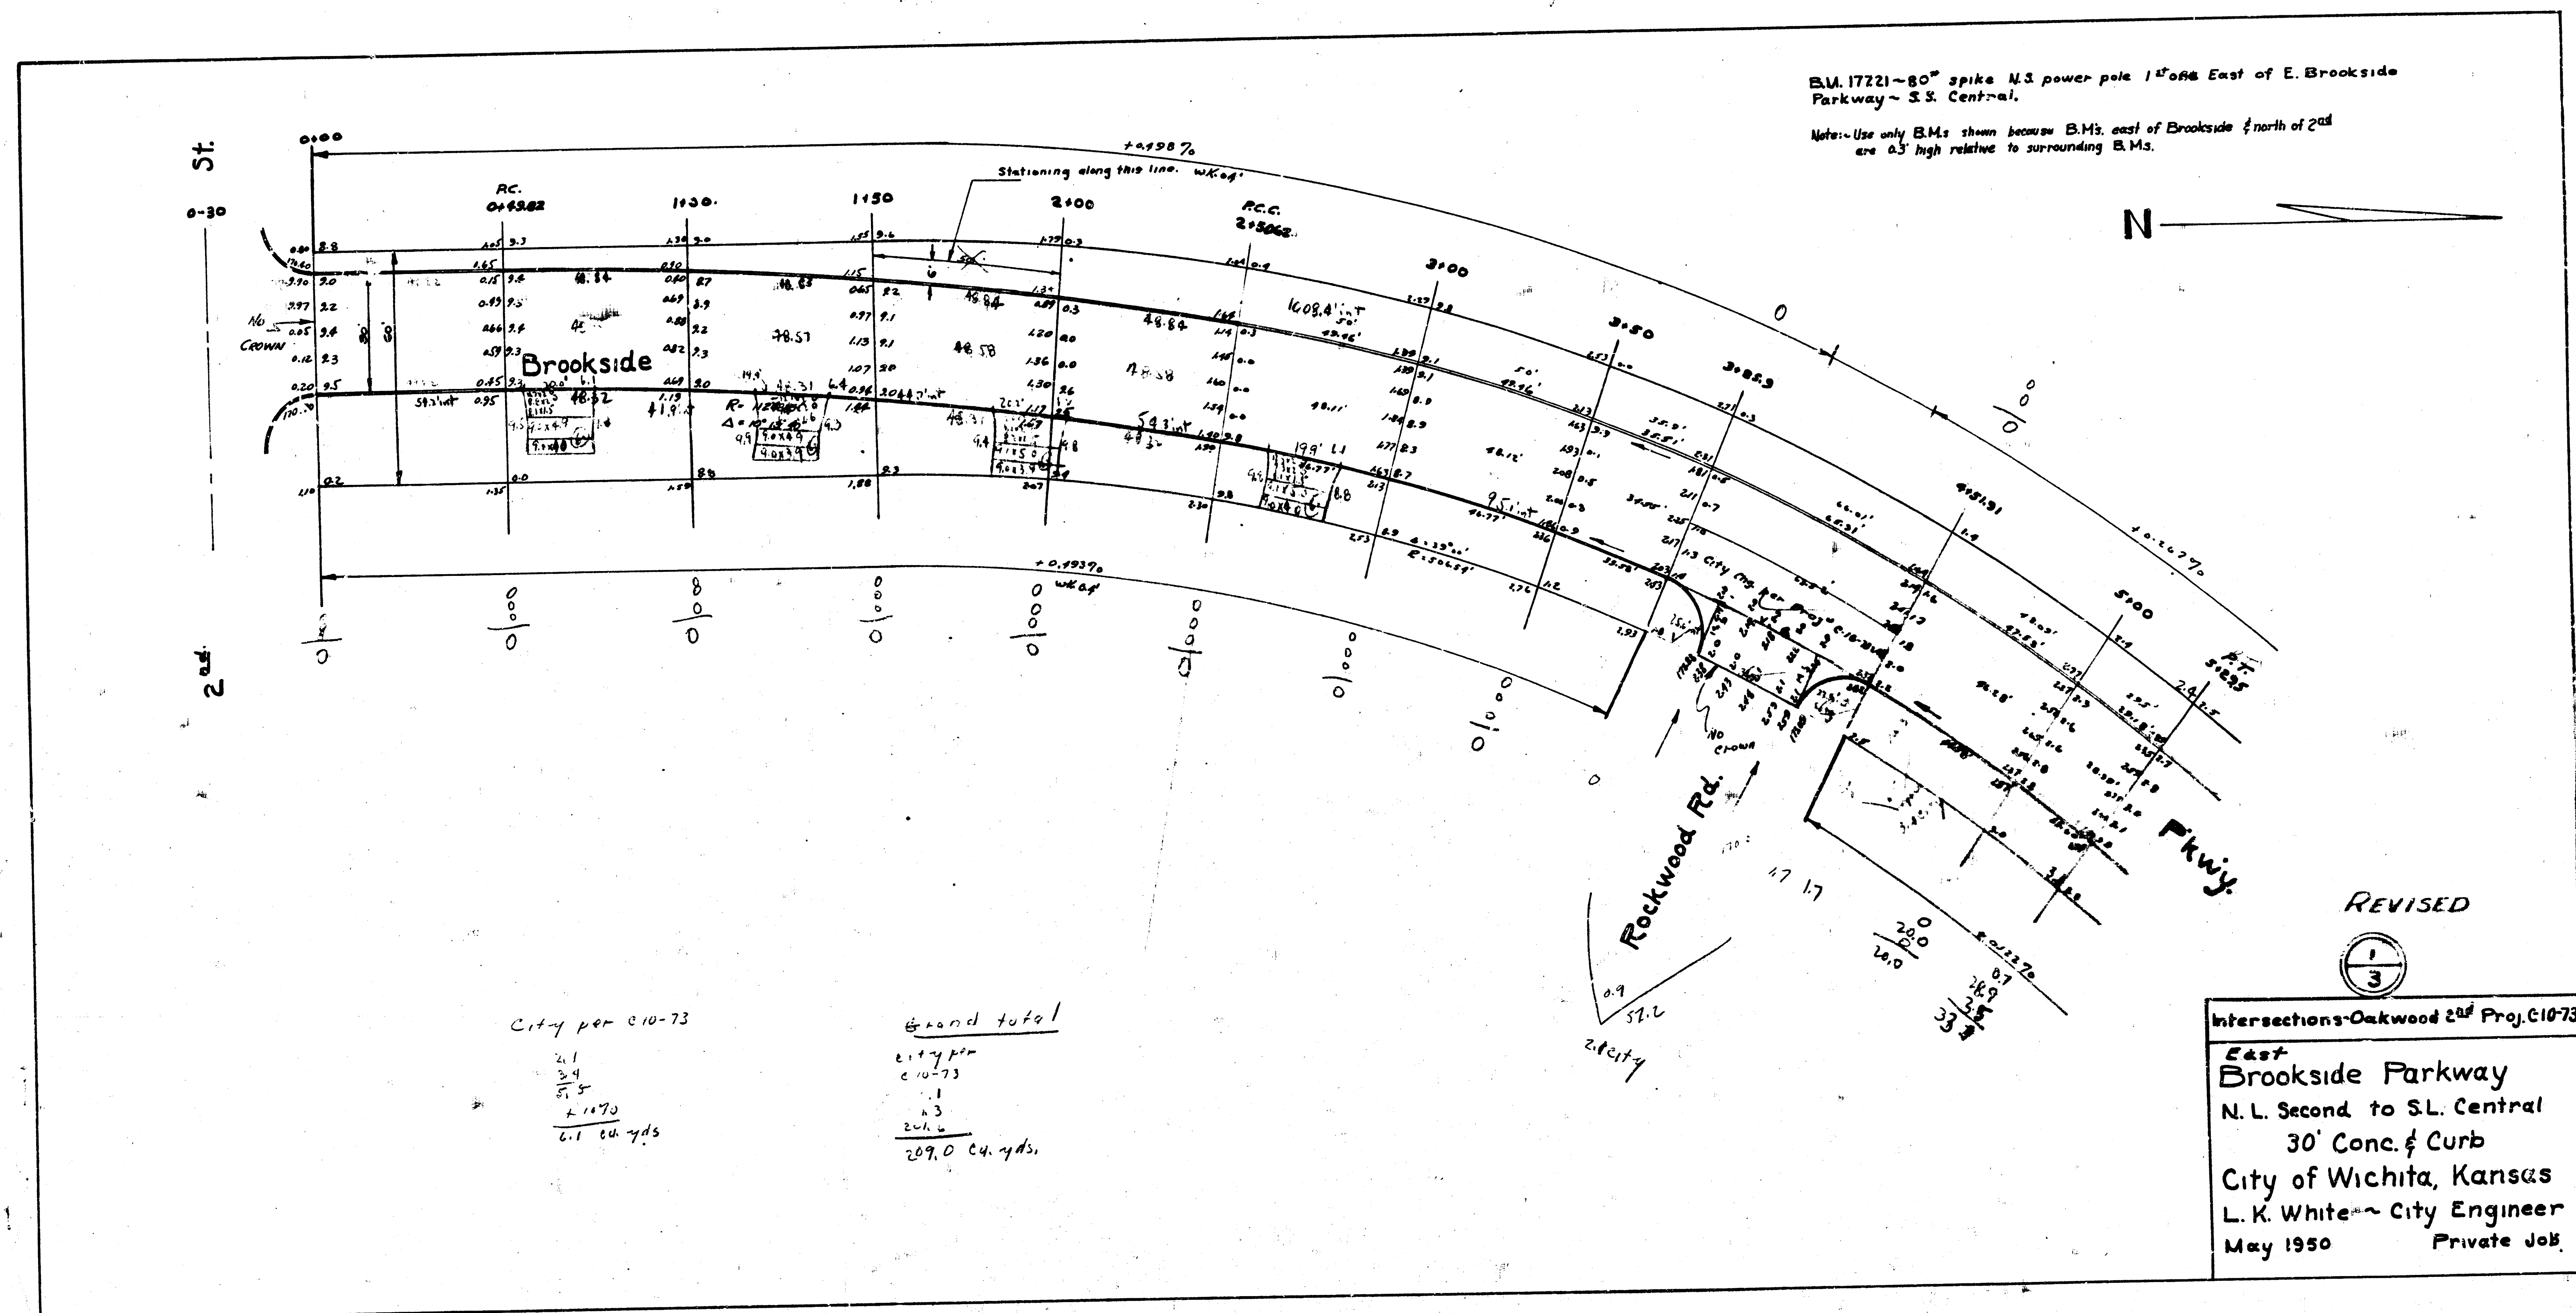


84 44

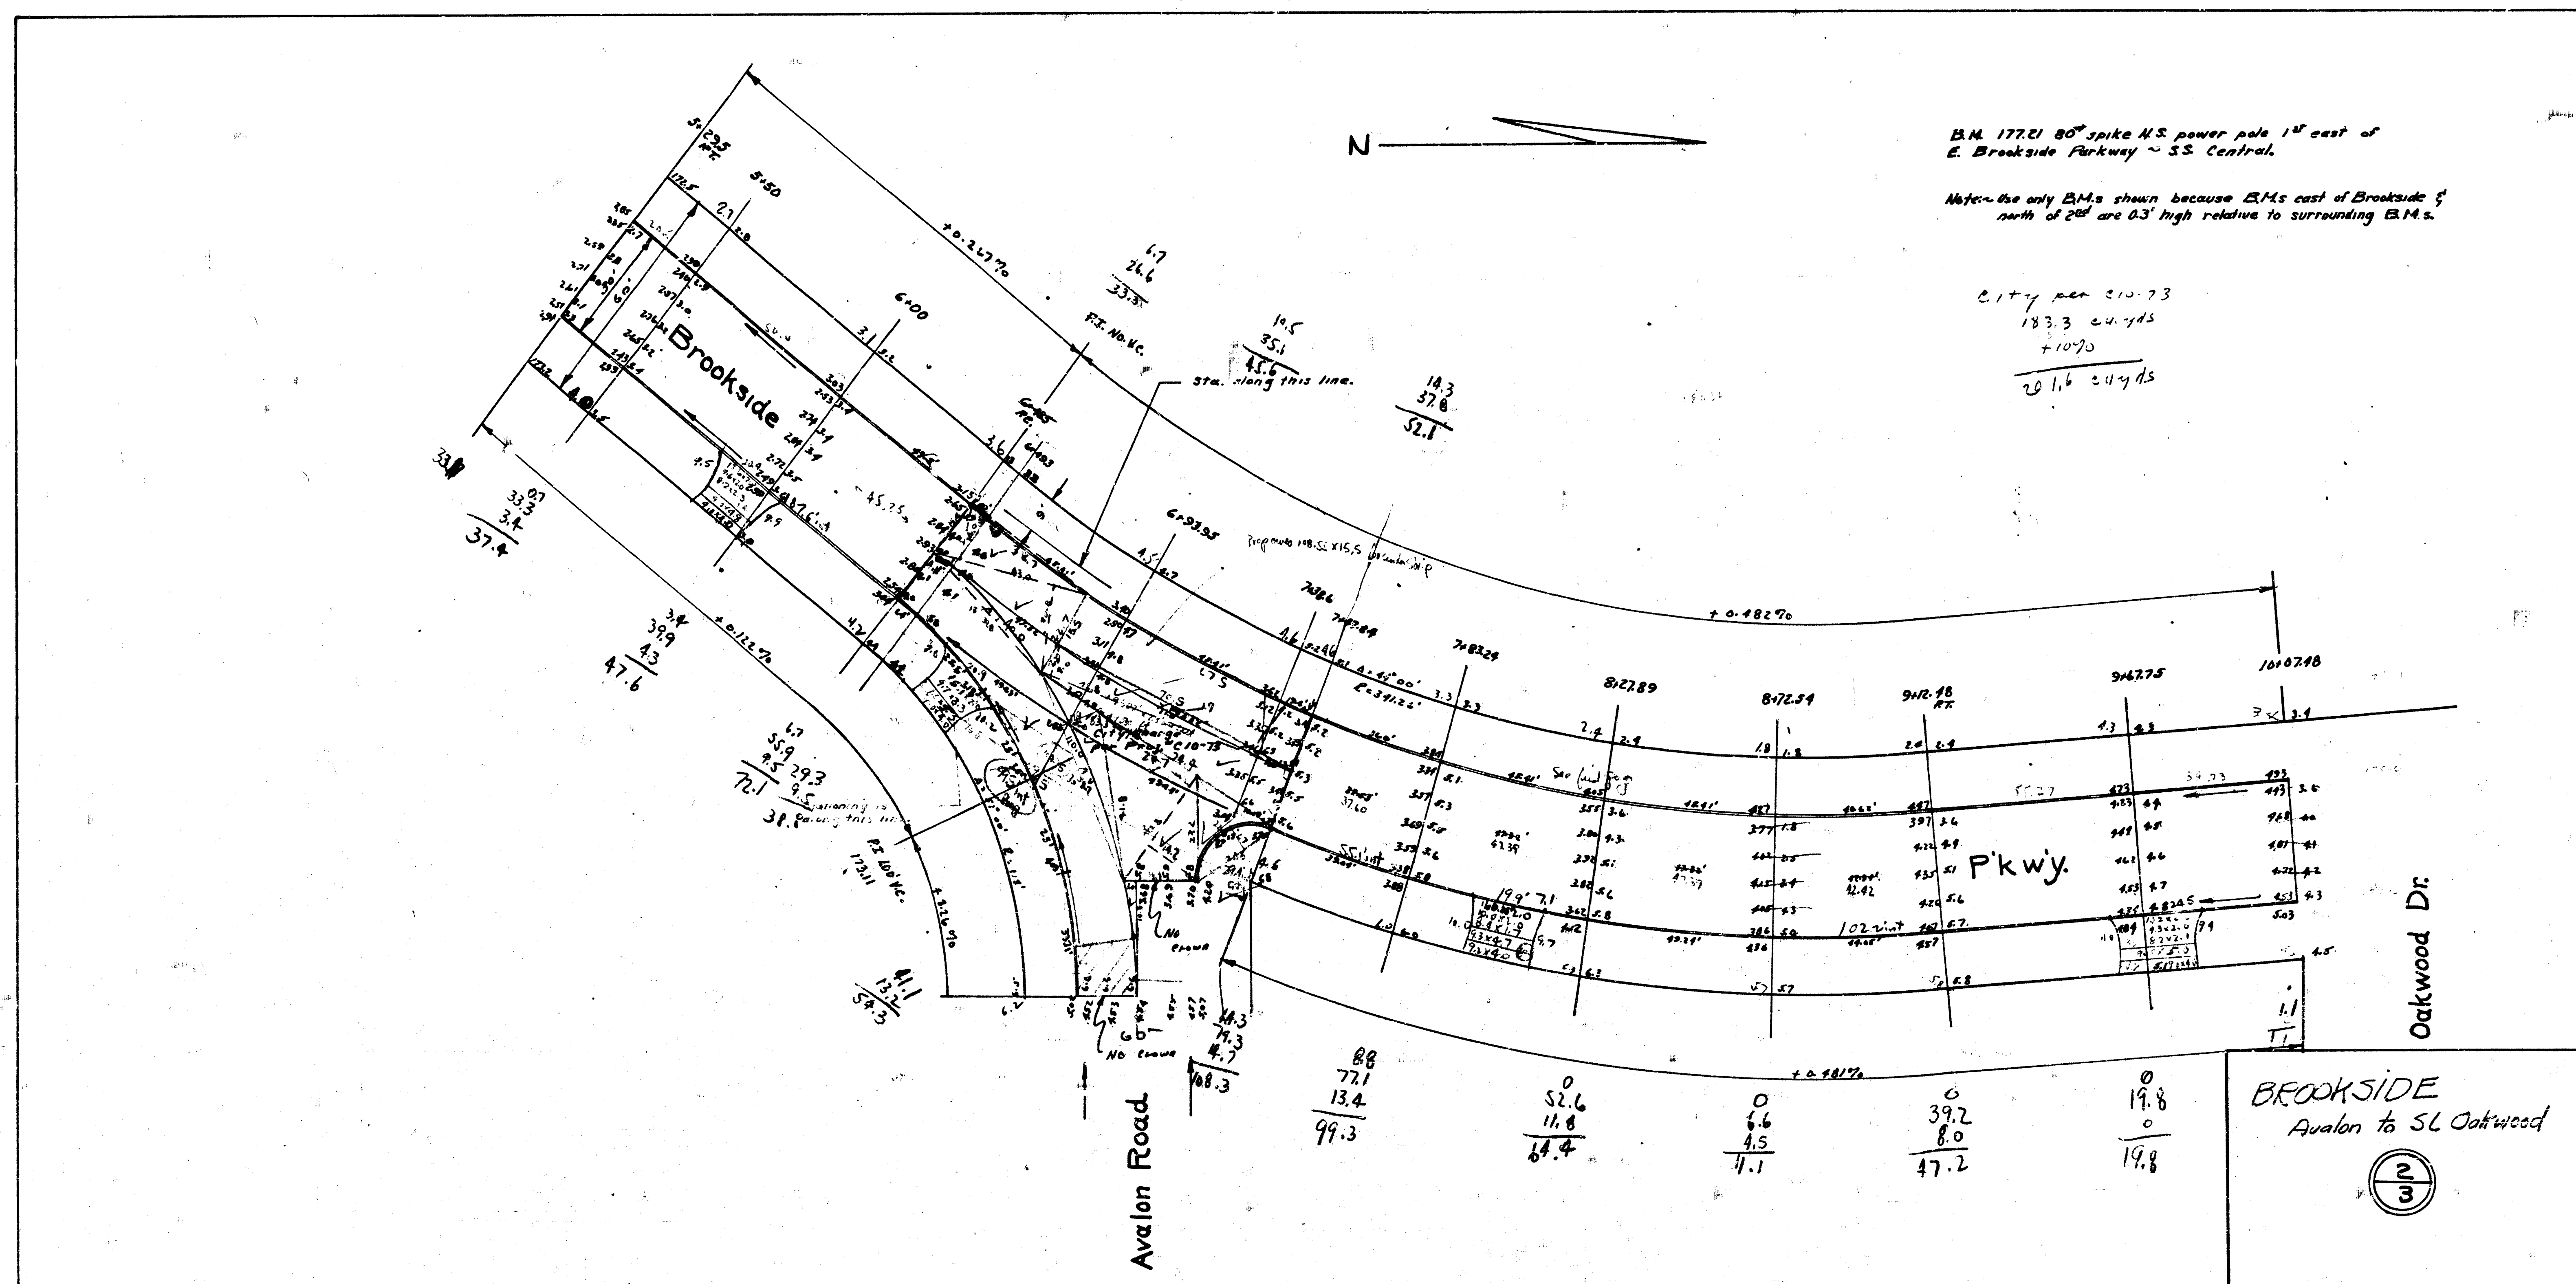

18h 24

City for
20-73
13
36
1.9
+ 0.75
2.14 yds.

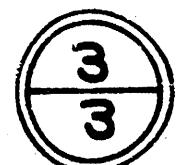

4 3 1 (54)