


B.M. 188.49 RR Spike S.S. HLP N.S. Cresthill
150' W. of W.L. Brookfield
B.M. 178.04 Standard, S.W. Cor. 9th & Armour
Chaining N. on W. 12

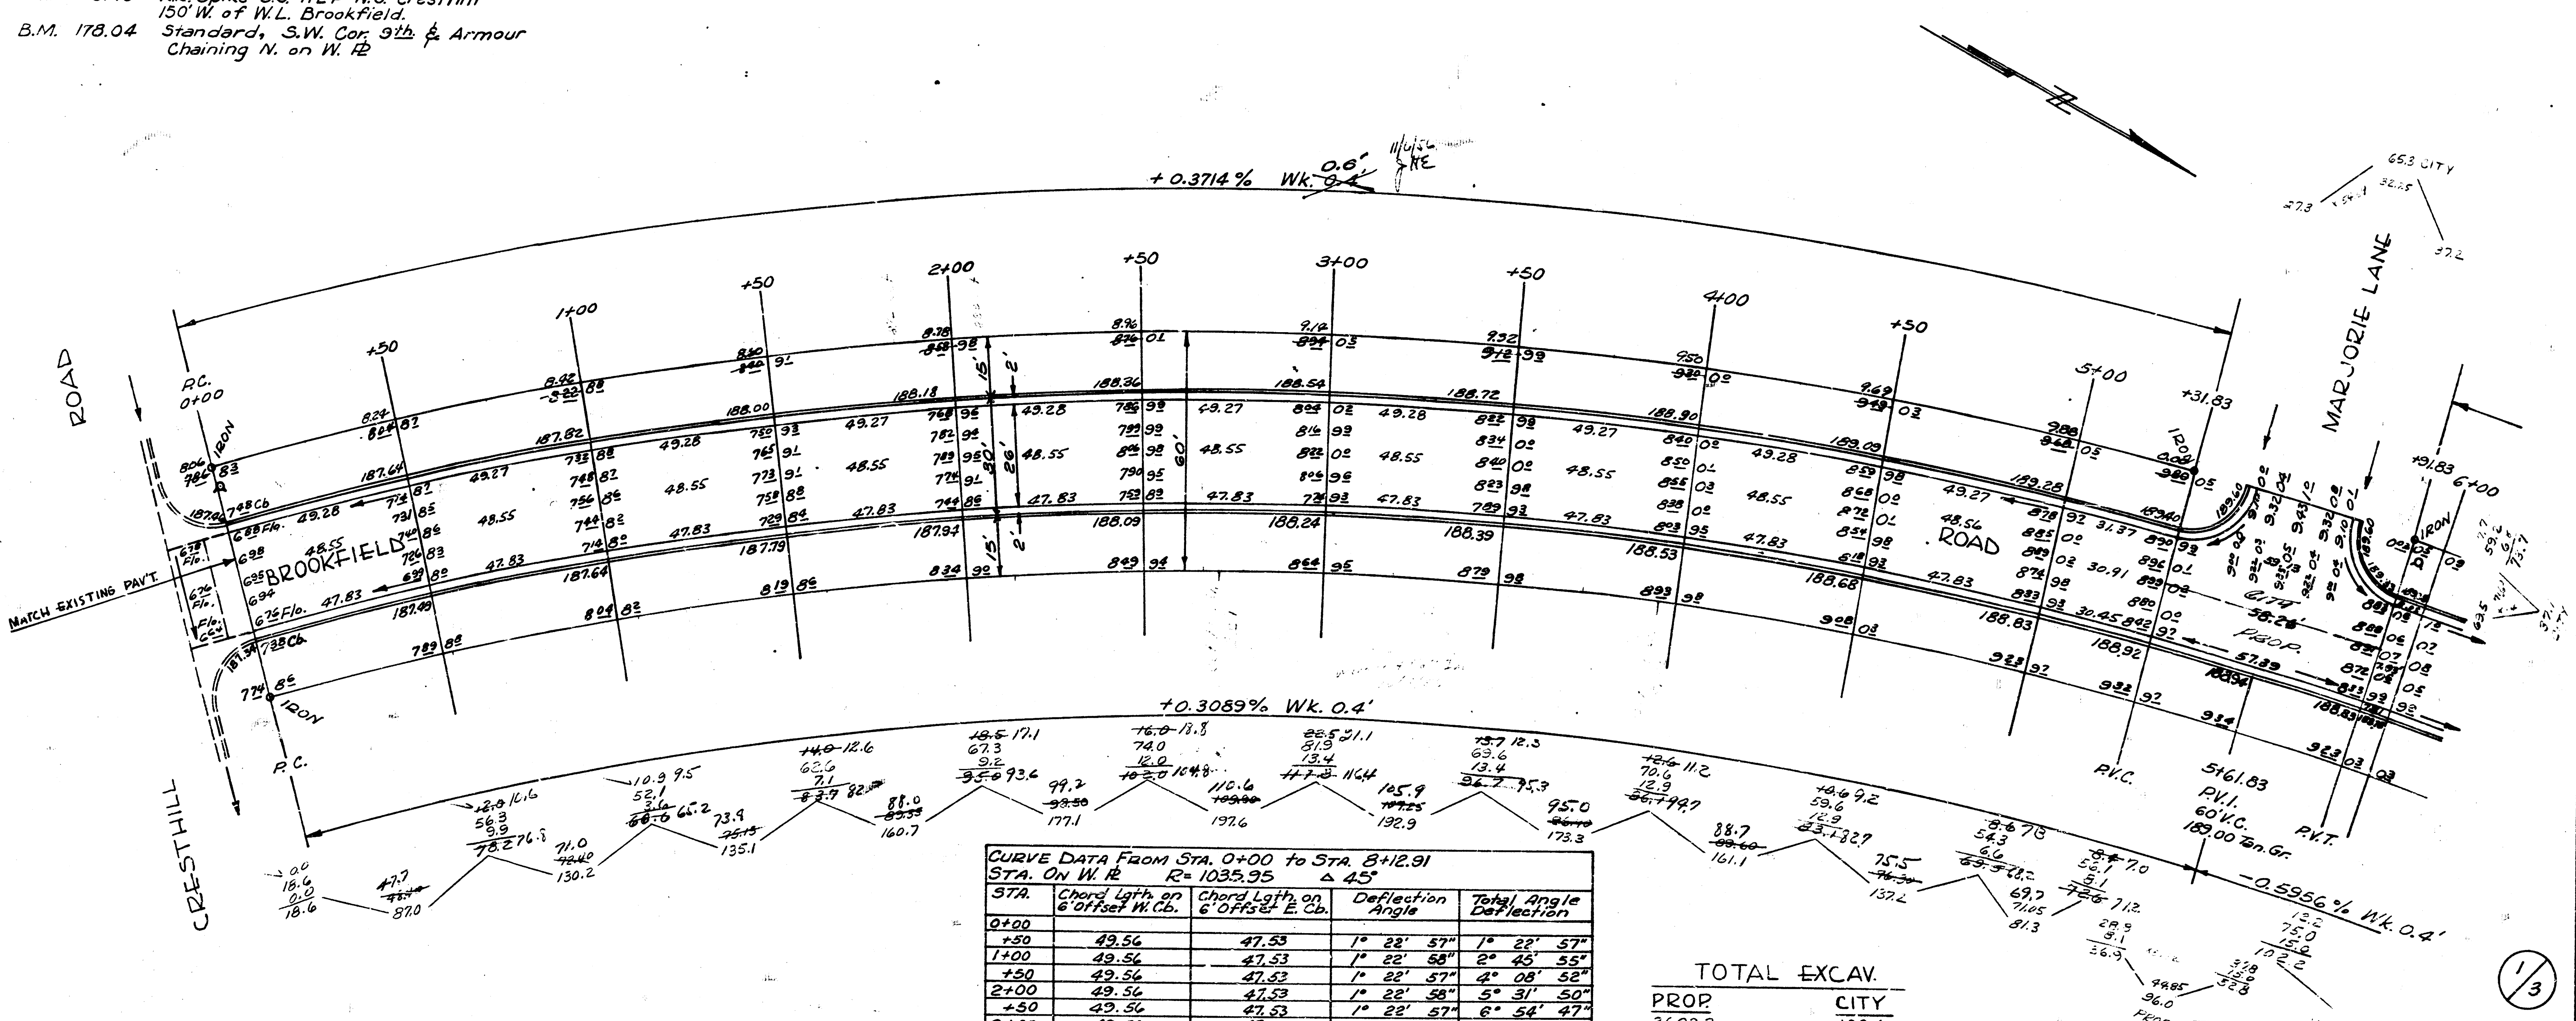


CURVE DATA FROM STA. 0+00 TO STA. 8+12.91
STA. ON W. 12 R=1035.95 Δ 45°


TOTAL EXCAV.
PROP 3602.2
CITY 102.4
3962.4 Cu. Yd. 112.6 Cu. Yd.

BROOKFIELD ROAD
N. CRESTHILL ROAD-S. L. NINTH ST.
26'-2'-30' A.C.
CITY OF WICHITA, KANS.
B.E. SMITH CITY ENGINEER
NOV. 1954 PROJ. NO. C14-309

