


B.M. 12087 "C" IN LONG WK. SO. SW COR. 17TH & BURNS

B.M. 12039 "R" IN RITCHIE N END WK. SW COR. 18TH & BURNS

N

ST

ST

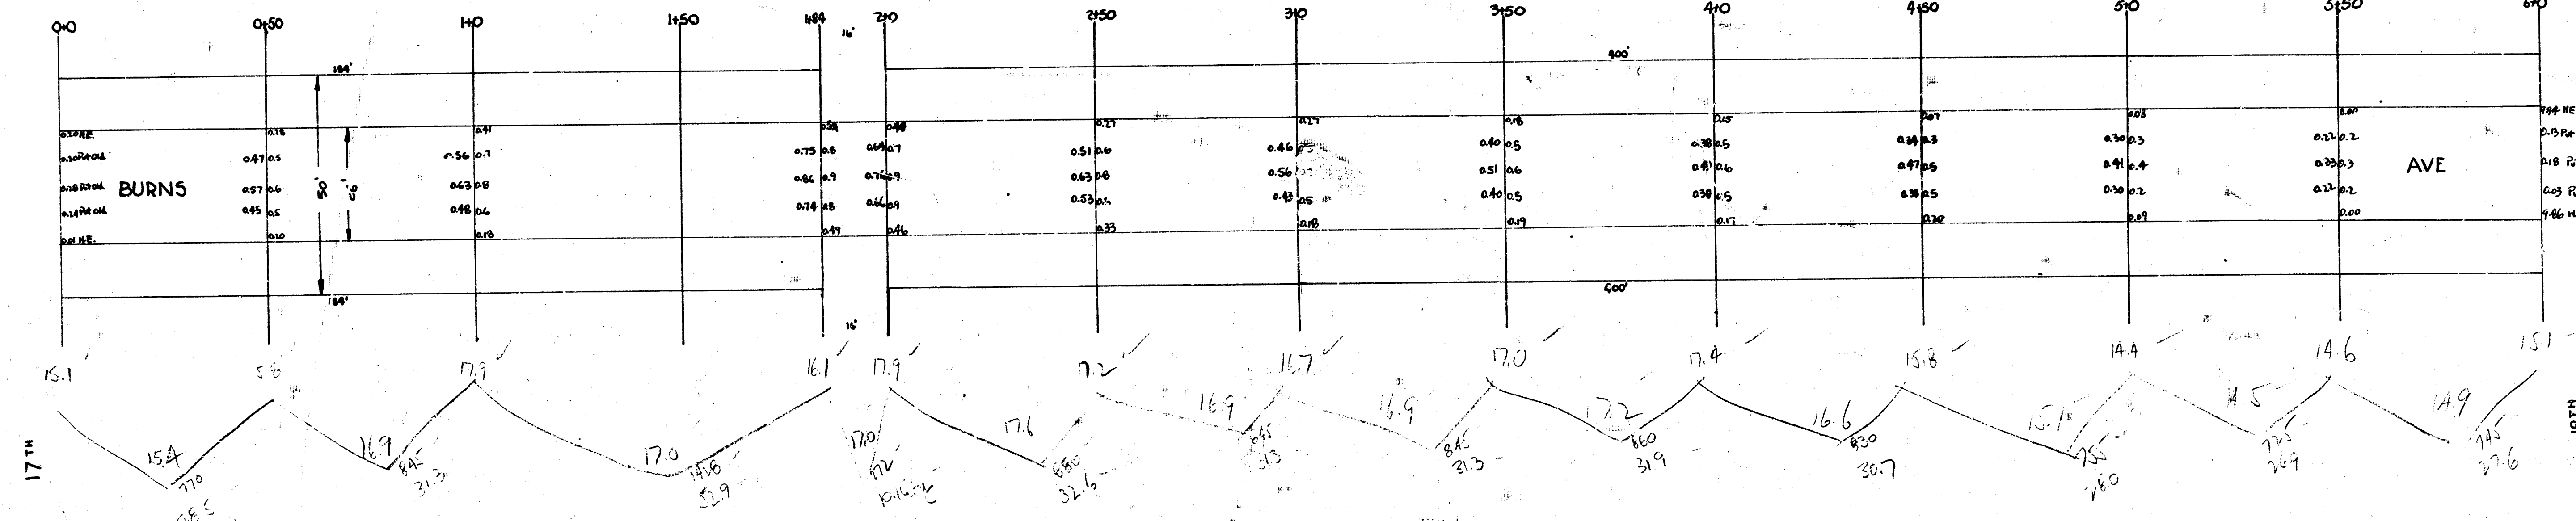

BURNS AVE
N.L. 17TH S.L. 18TH
26' A.C.
CITY of WICHITA, KANS.
L.K. WHITE CITY ENGINEER
JULY 1949 PROJ. NO. C19-120