


CAUTION
UNDERGROUND
UTILITIES

B.M. #1 122.28 RR. Spike S. Face RR NE Cor. Boyd & Central.
 B.M. #2 123.86 U.S. Engineering Bld. NW Cor. Hoover & Central.
 B.M. #3 124.53 SE. Cor. Concrete Porch 705 Boyd.

N
 Scale: 1" = 20'

NOTE: THE TYPE OF SUB-GRADE TREATMENT SHALL BE DETERMINED BY THE FIELD ENGINEER. SUB-GRADE TREATMENT MAY CONSIST OF THE TREATMENT, CEMENT TREATMENT, SE- GRADE MODIFICATION, OR ANY COMBINATION OF THESE.
 NOTE: CONTRACTOR TO GRADE PARKINGS, CLEAR THE RIGHT-OF-WAY, AND CONSTRUCT CONTRACTED FILL FOR FUTURE SIDEWALK. SIDEWALK SHALL BE CONSTRUCTED BY OTHERS.

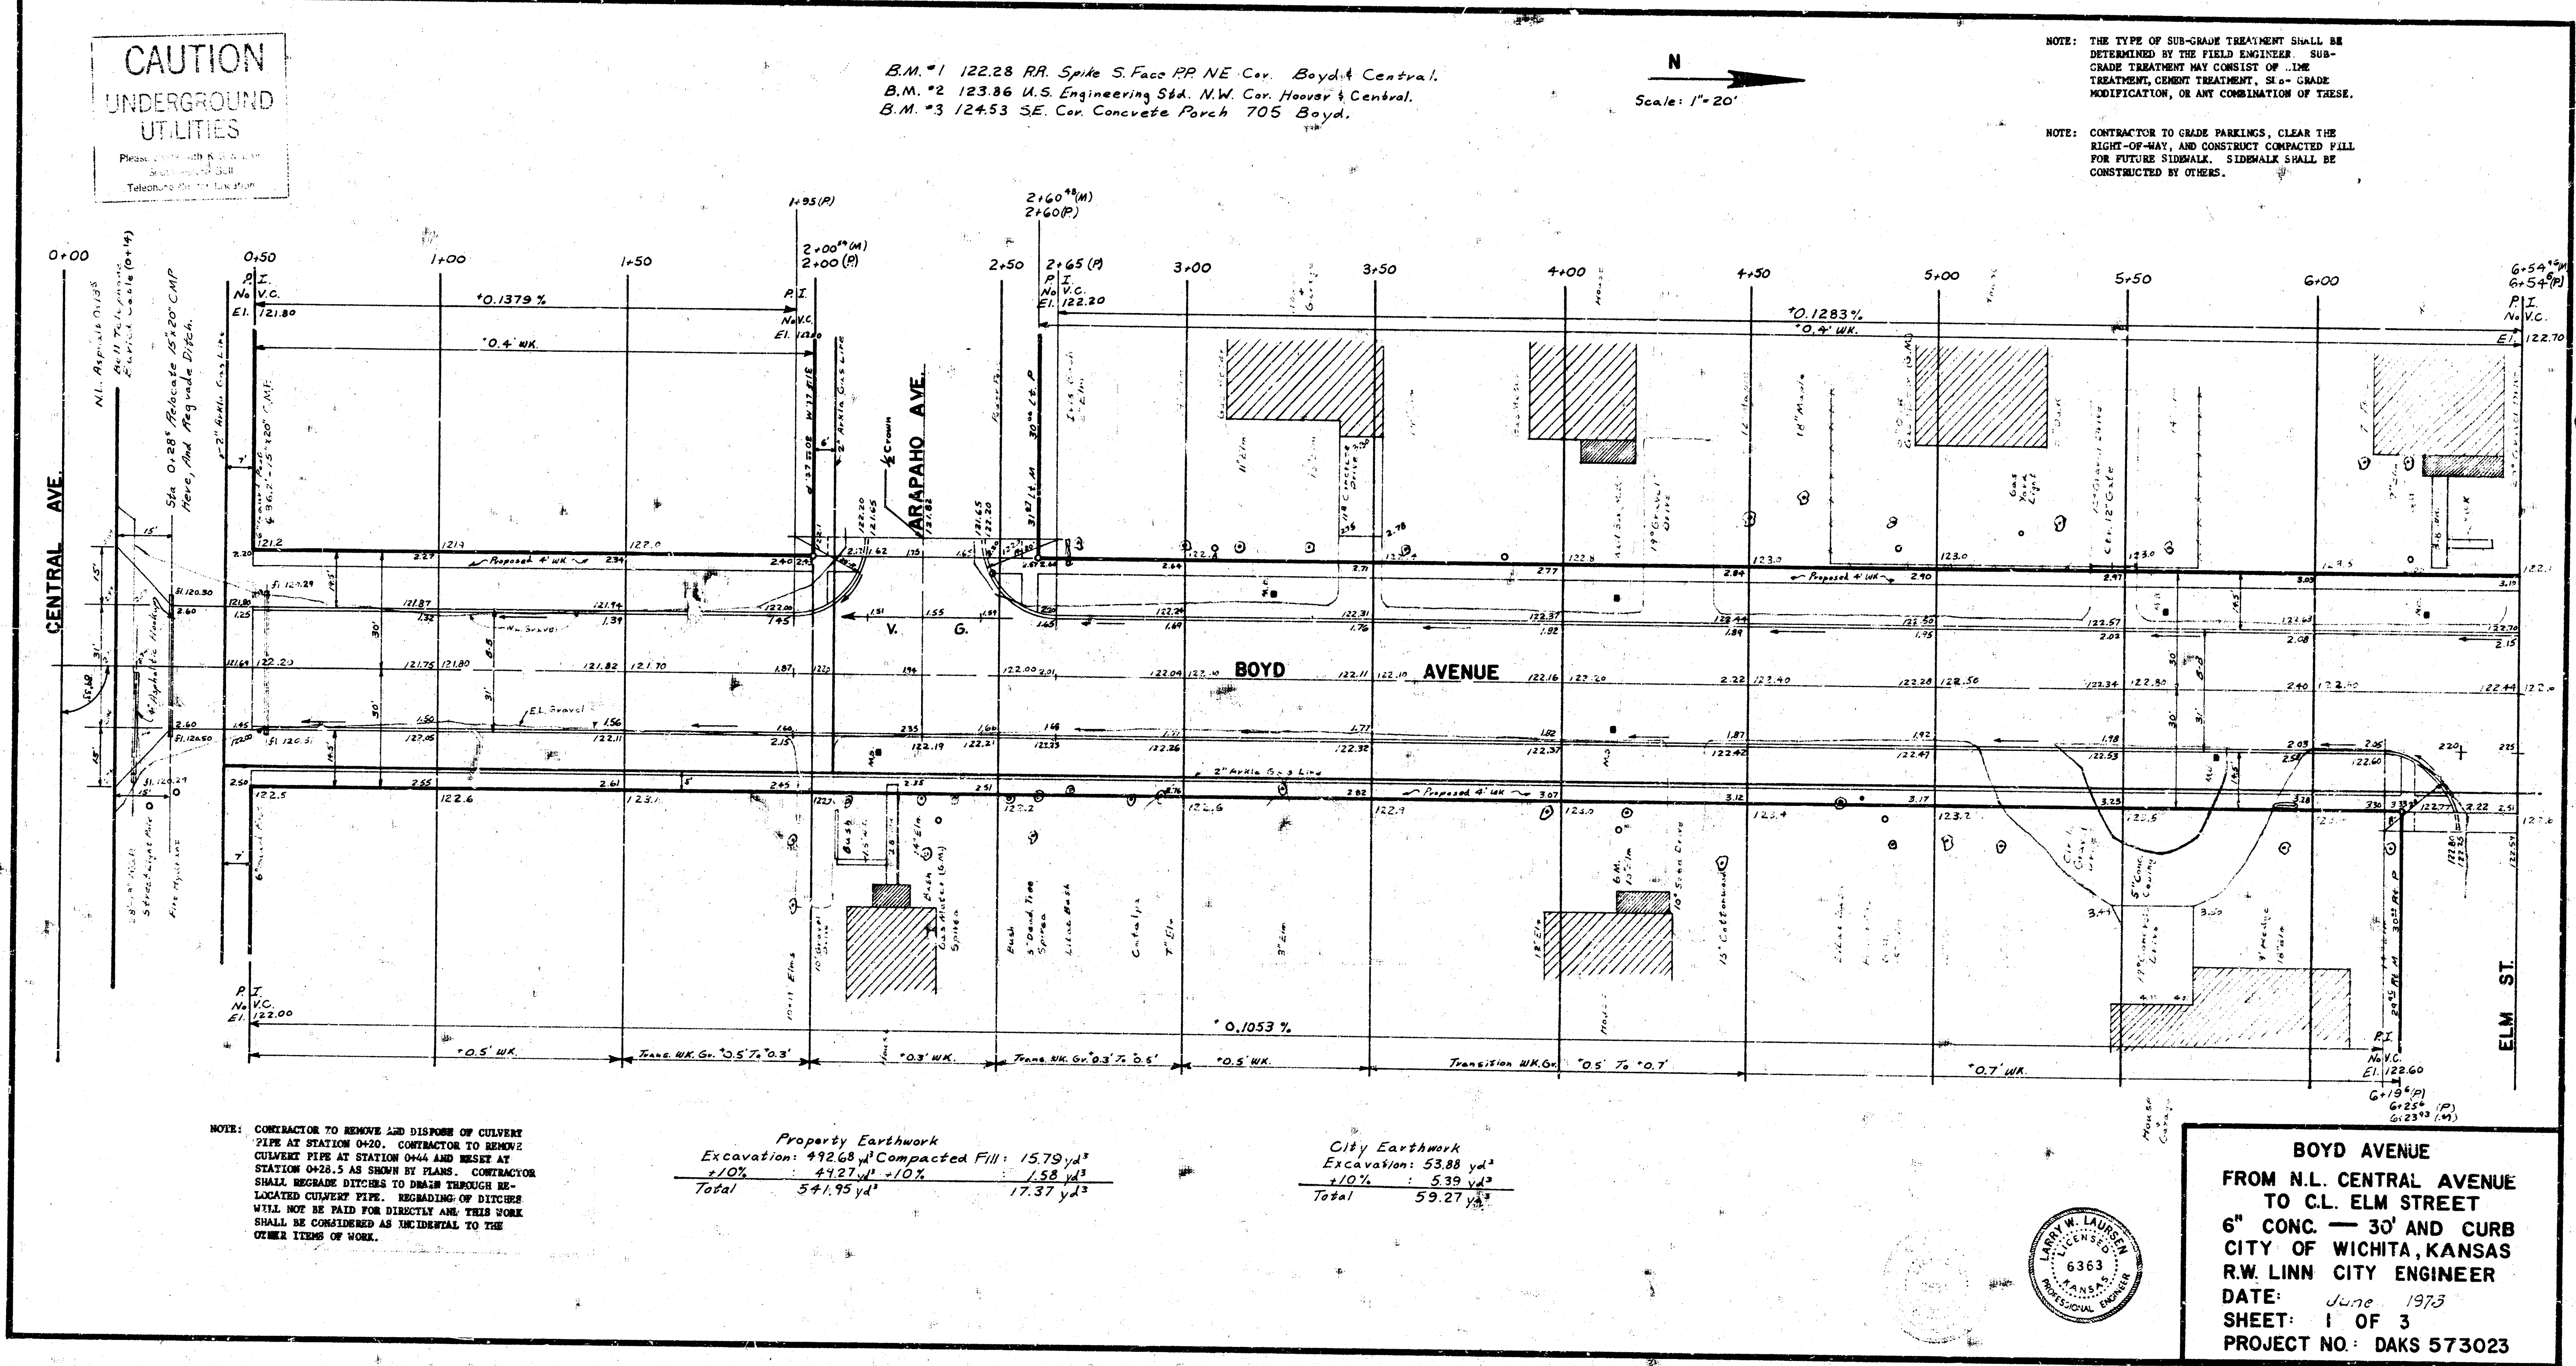


Property Earthwork
 Excavation: 492.68 yd³ Compacted Fill: 15.79 yd³
 Total : 541.95 yd³

City Earthwork
 Excavation: 53.88 yd³
 Total : 59.27 yd³



BOYD AVENUE
FROM N.L. CENTRAL AVENUE
TO CL. ELM STREET
6" CONC. - 30' AND CURB
CITY OF WICHITA, KANSAS
R.W. LINN CITY ENGINEER
 DATE: June 1973
 SHEET: 1 OF 3
 PROJECT NO: DAKS 573023