


 B.M. 102.48 "X" in Top Ch. E.S. Greenwood - 1' N.E. W.L. Boston

B.M. 104.40 "T" in Tray Top Hydt. N.W. Cr. Hydraulic & Boston

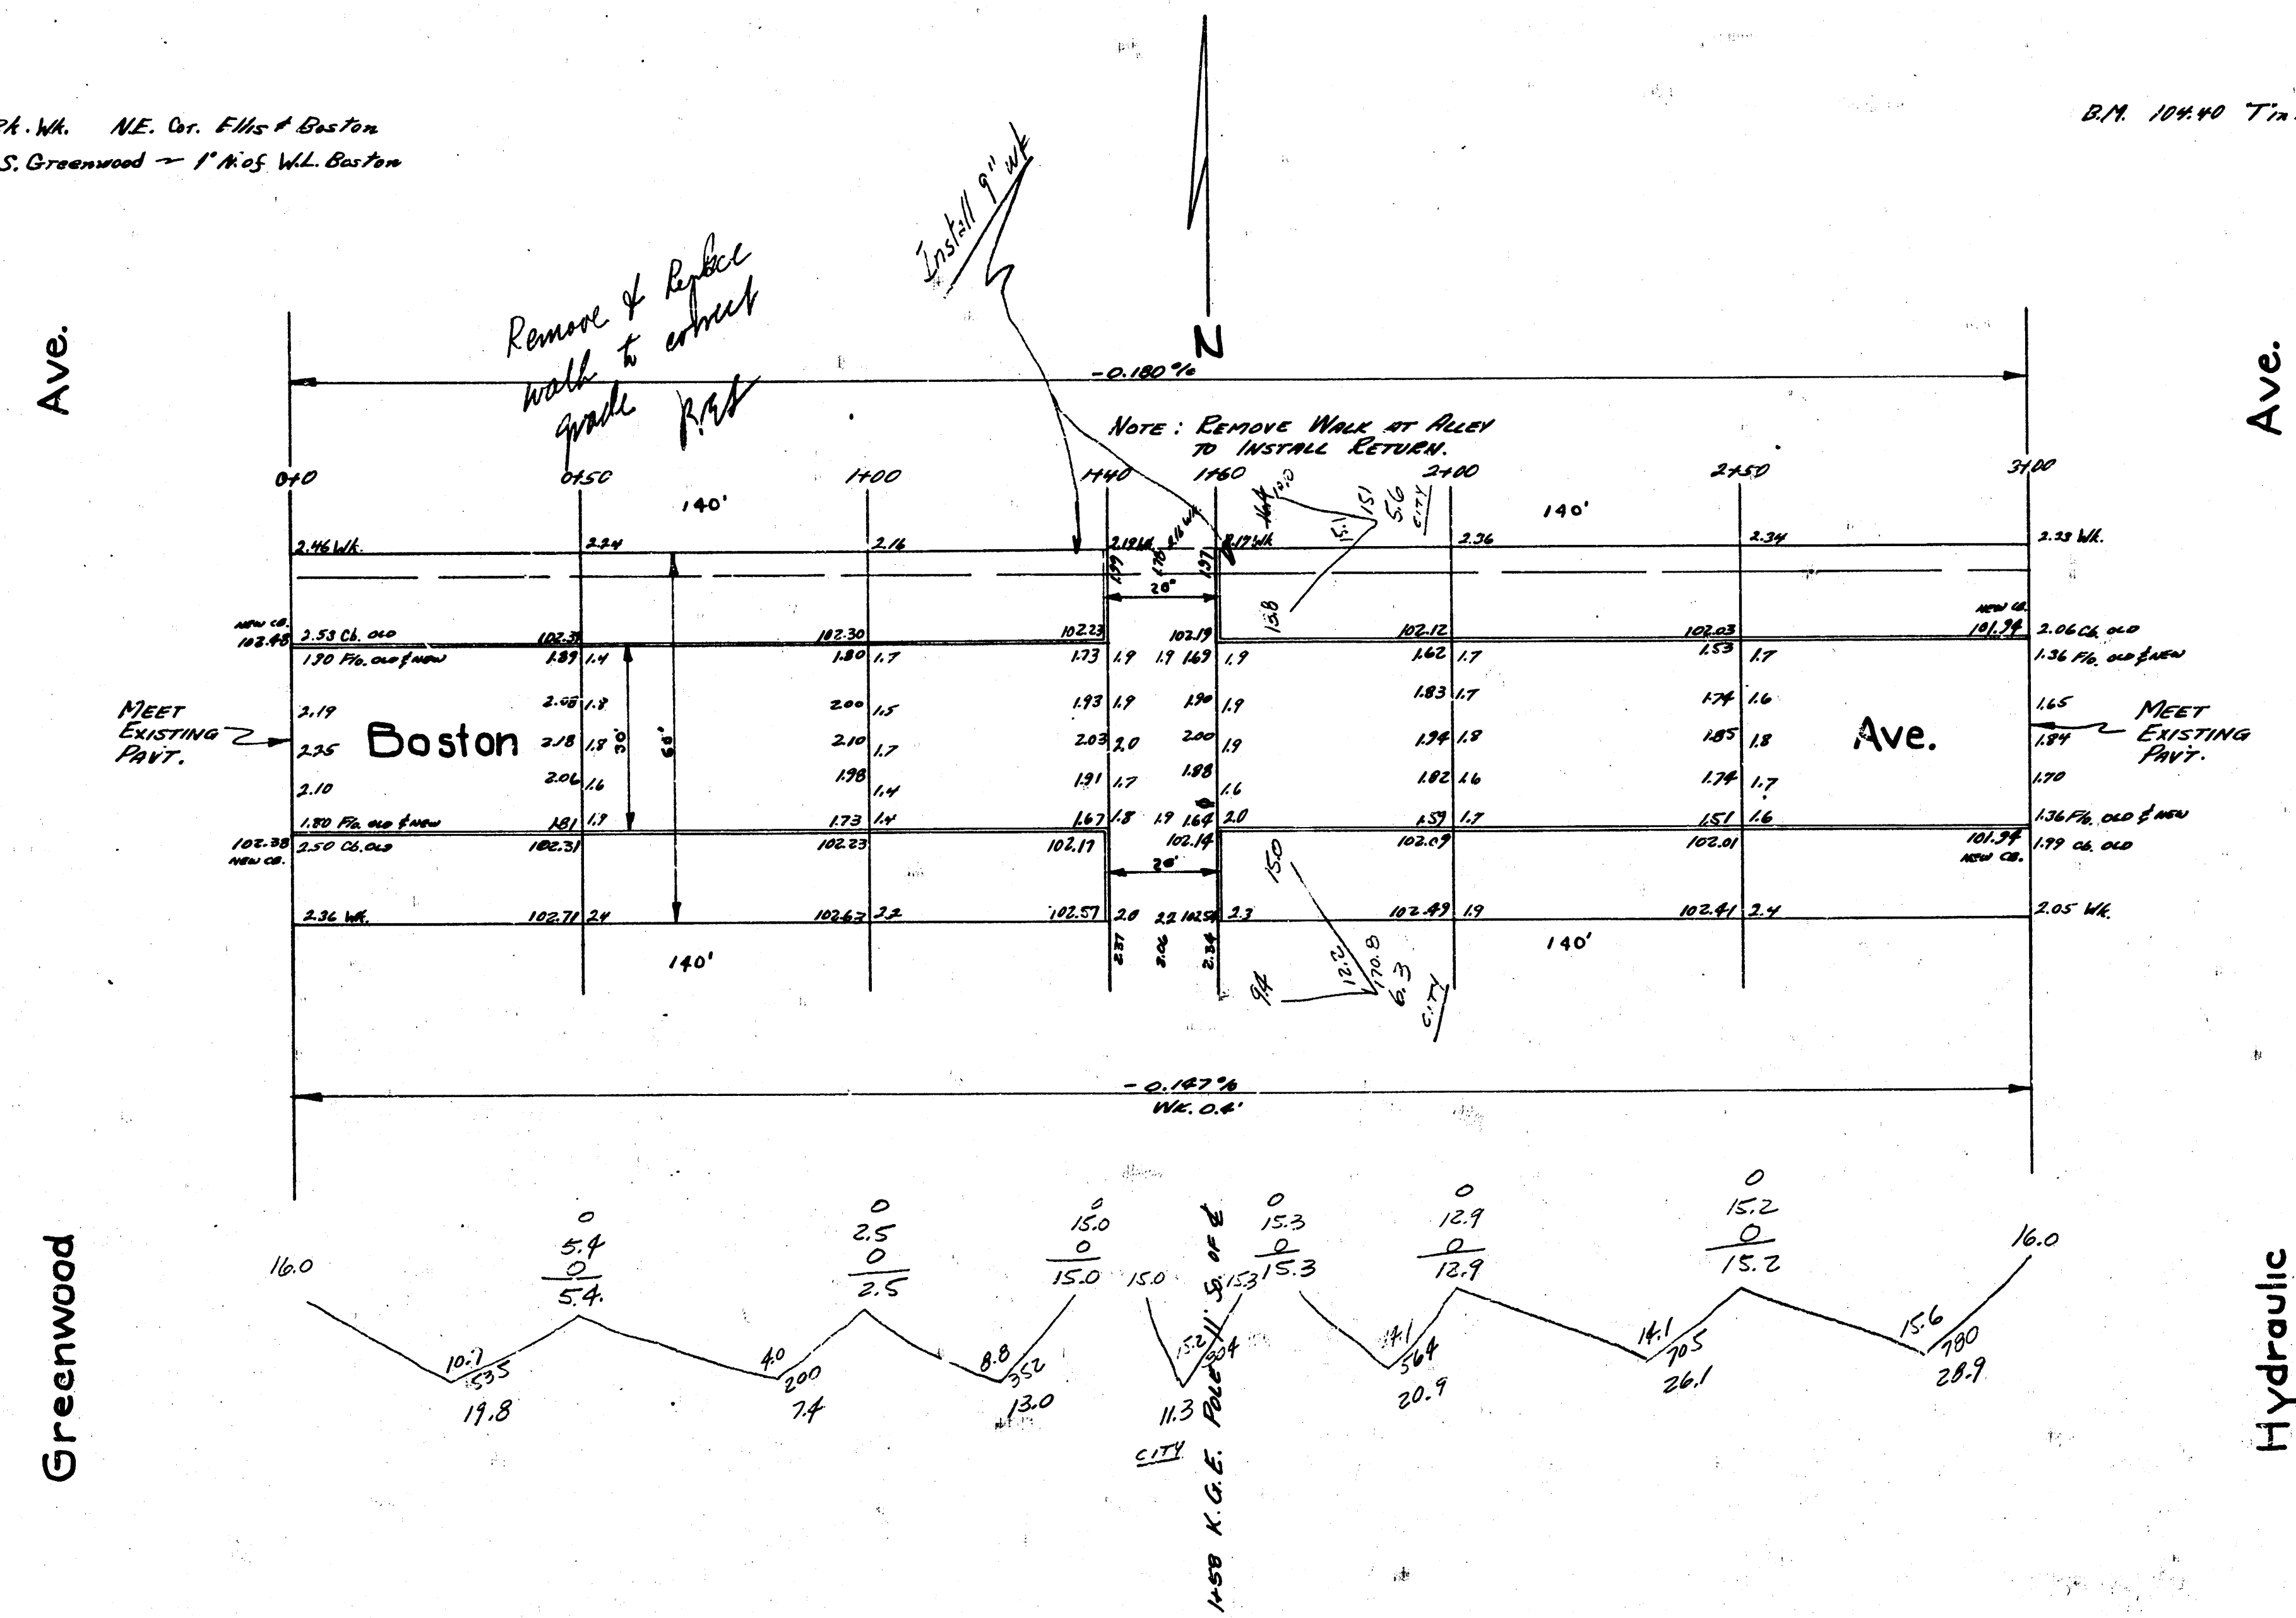

EXHAUSTION

PERCENT	CITY
19.8	5.2
7.4	4.3
13.0	11.3
20.7	23.2
24.1	110%
25.7	25.7
116.1	25.5 ch. 142
+10%	
127.7	ch 145

Boston Ave.
 E.L. Greenwood - N.L. Hydraulic
 30' Conc. & Curb
 City of Wichita, Kansas
 L.K. White - City Engineer
 March 1949 Proj. # C-19-35