B.M. Iron in thim. C. Palisade & S.S. Boston 105.57
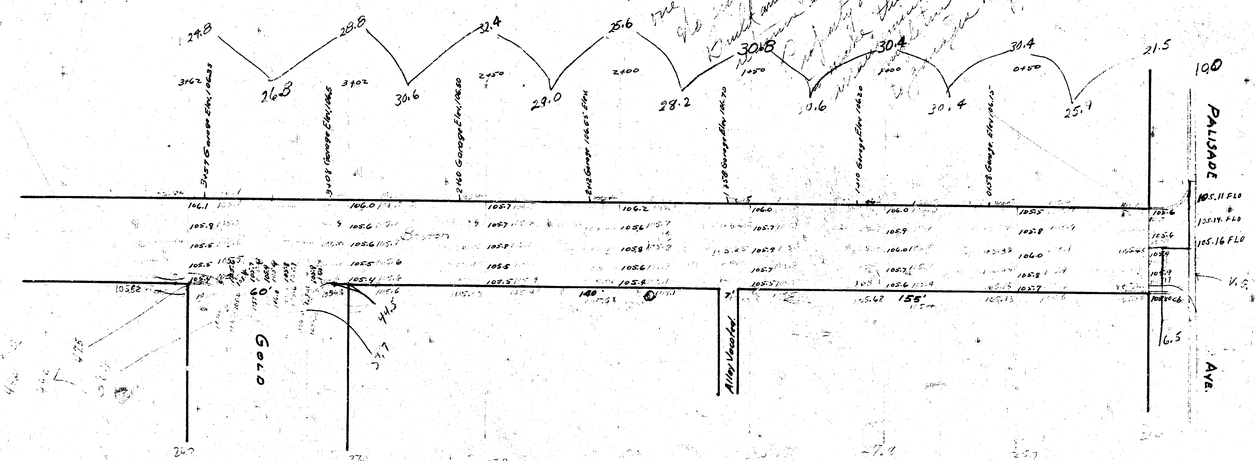
BOSTON ST. W.L. PALISADE to W.L. GOLD.