B.M. 94.39 S.W. Corner Co House Walk House S.E. Corner Gold & 38th St.
B.M. 95.63 S.E. Corner Bottom Step House 3523 Gold
B.M. 96.27 P.K. Spike N. Face Power Pole 10' West of E.L. Waco & 135' S. of S.L. Carlyle
B.M. 97.08 ½" ⌀ Spike in N. Face of Power Pole Sta 10+00 & 135' S. of S.L. Carlyle

Chaining From W. to E. on N. ℄.

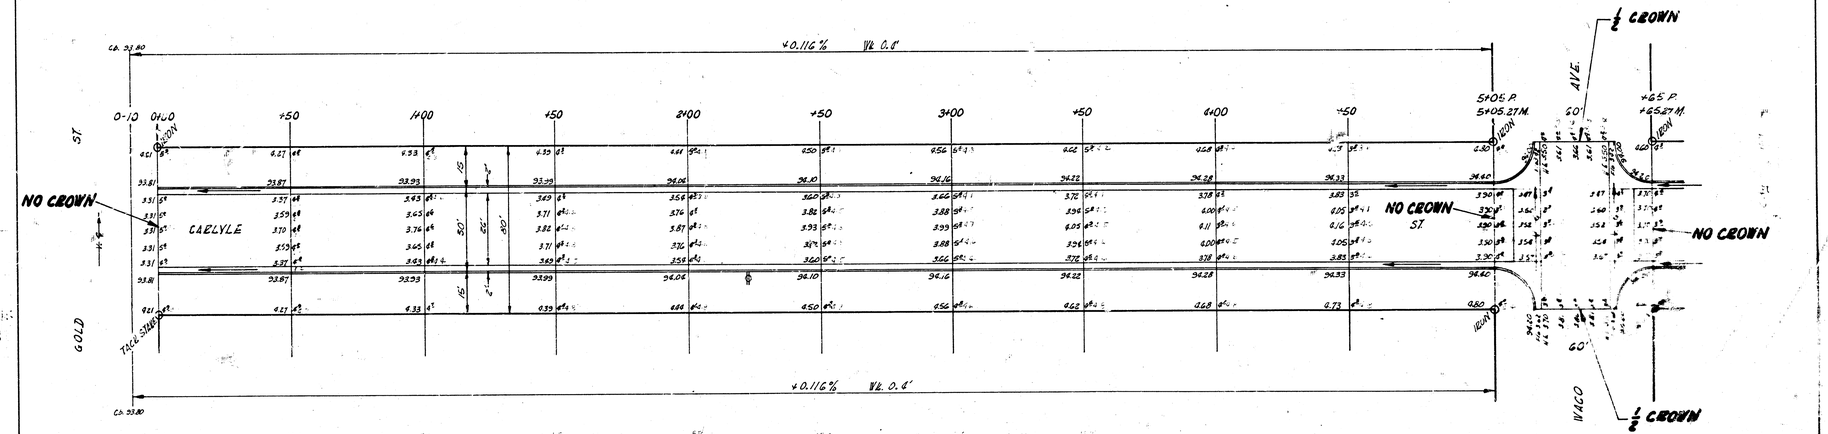

CARLYLE ST.
E.L. GOLD - W.L. WICHITA
26-2-30 A.C.
CITY OF WICHITA, KANS.
B.E. SMITH CITY ENGINEER
SEPT., 1956 PROJ. NO. C14-70

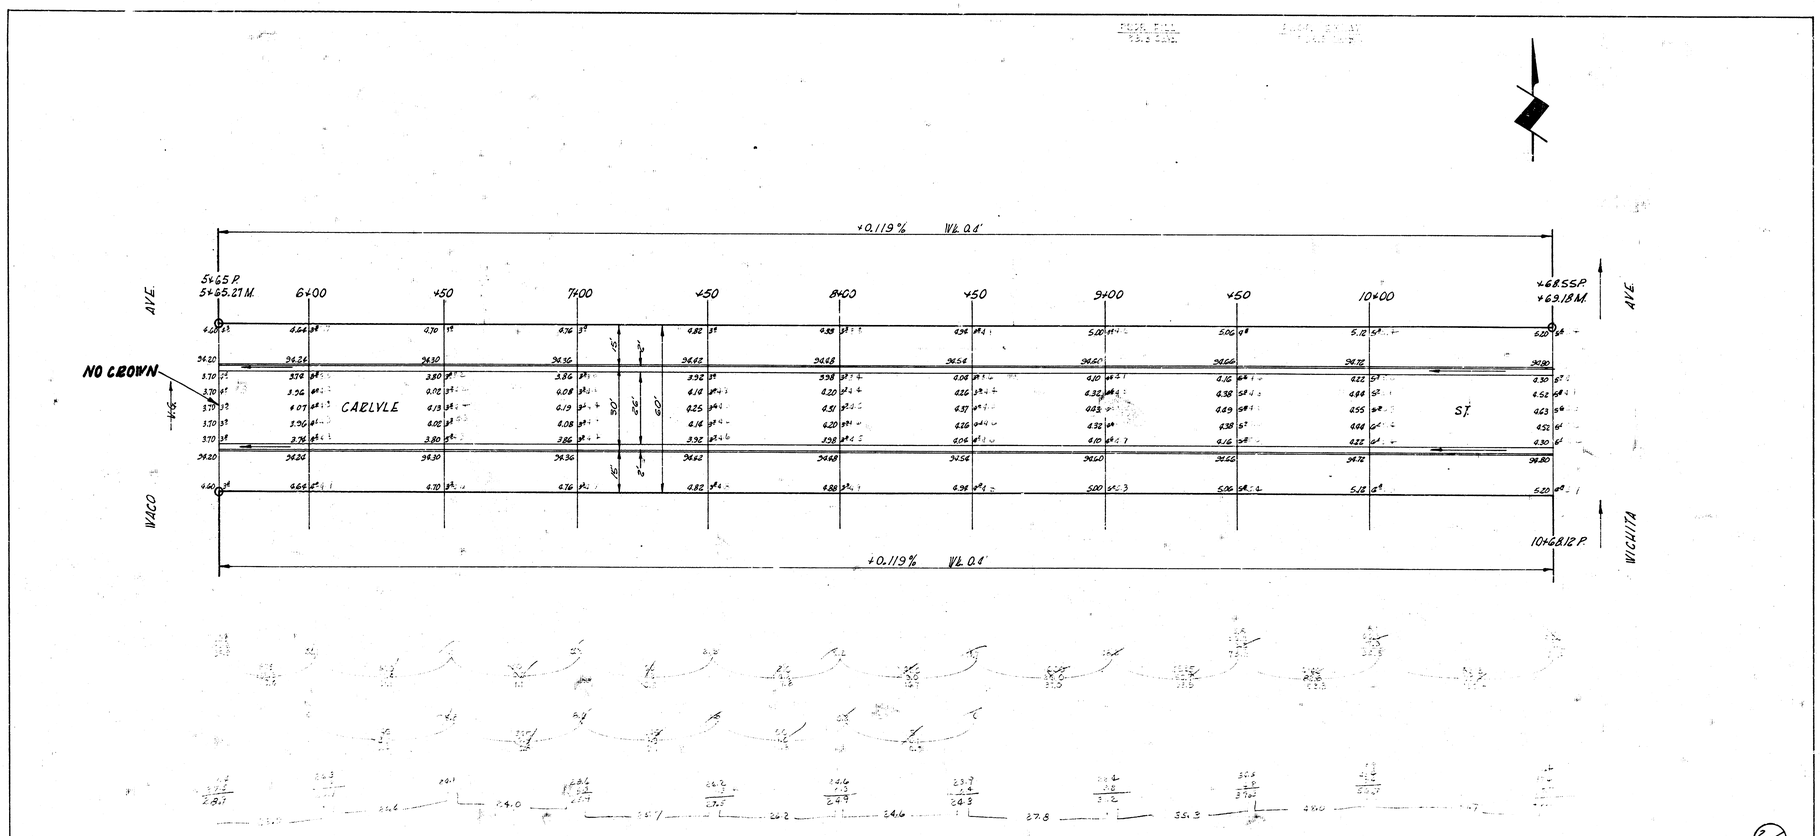

C/C

CARLYLE ST.
PROJ. NO. C14-70