


R.M. "X" IN W. HUBGUARD (2-CULVERT) W. S. WOODLAWN N.E. CASTLE DR. 151ST
S.M. STD. N.W. COR WOODLAWN & LINCOLN - 153RD

NOTE TO FIELD ENGINEER:
RESECTION THIS PROJECT
AT TIME OF SETTING CUT STAKES.

SCALE: 1"=20'

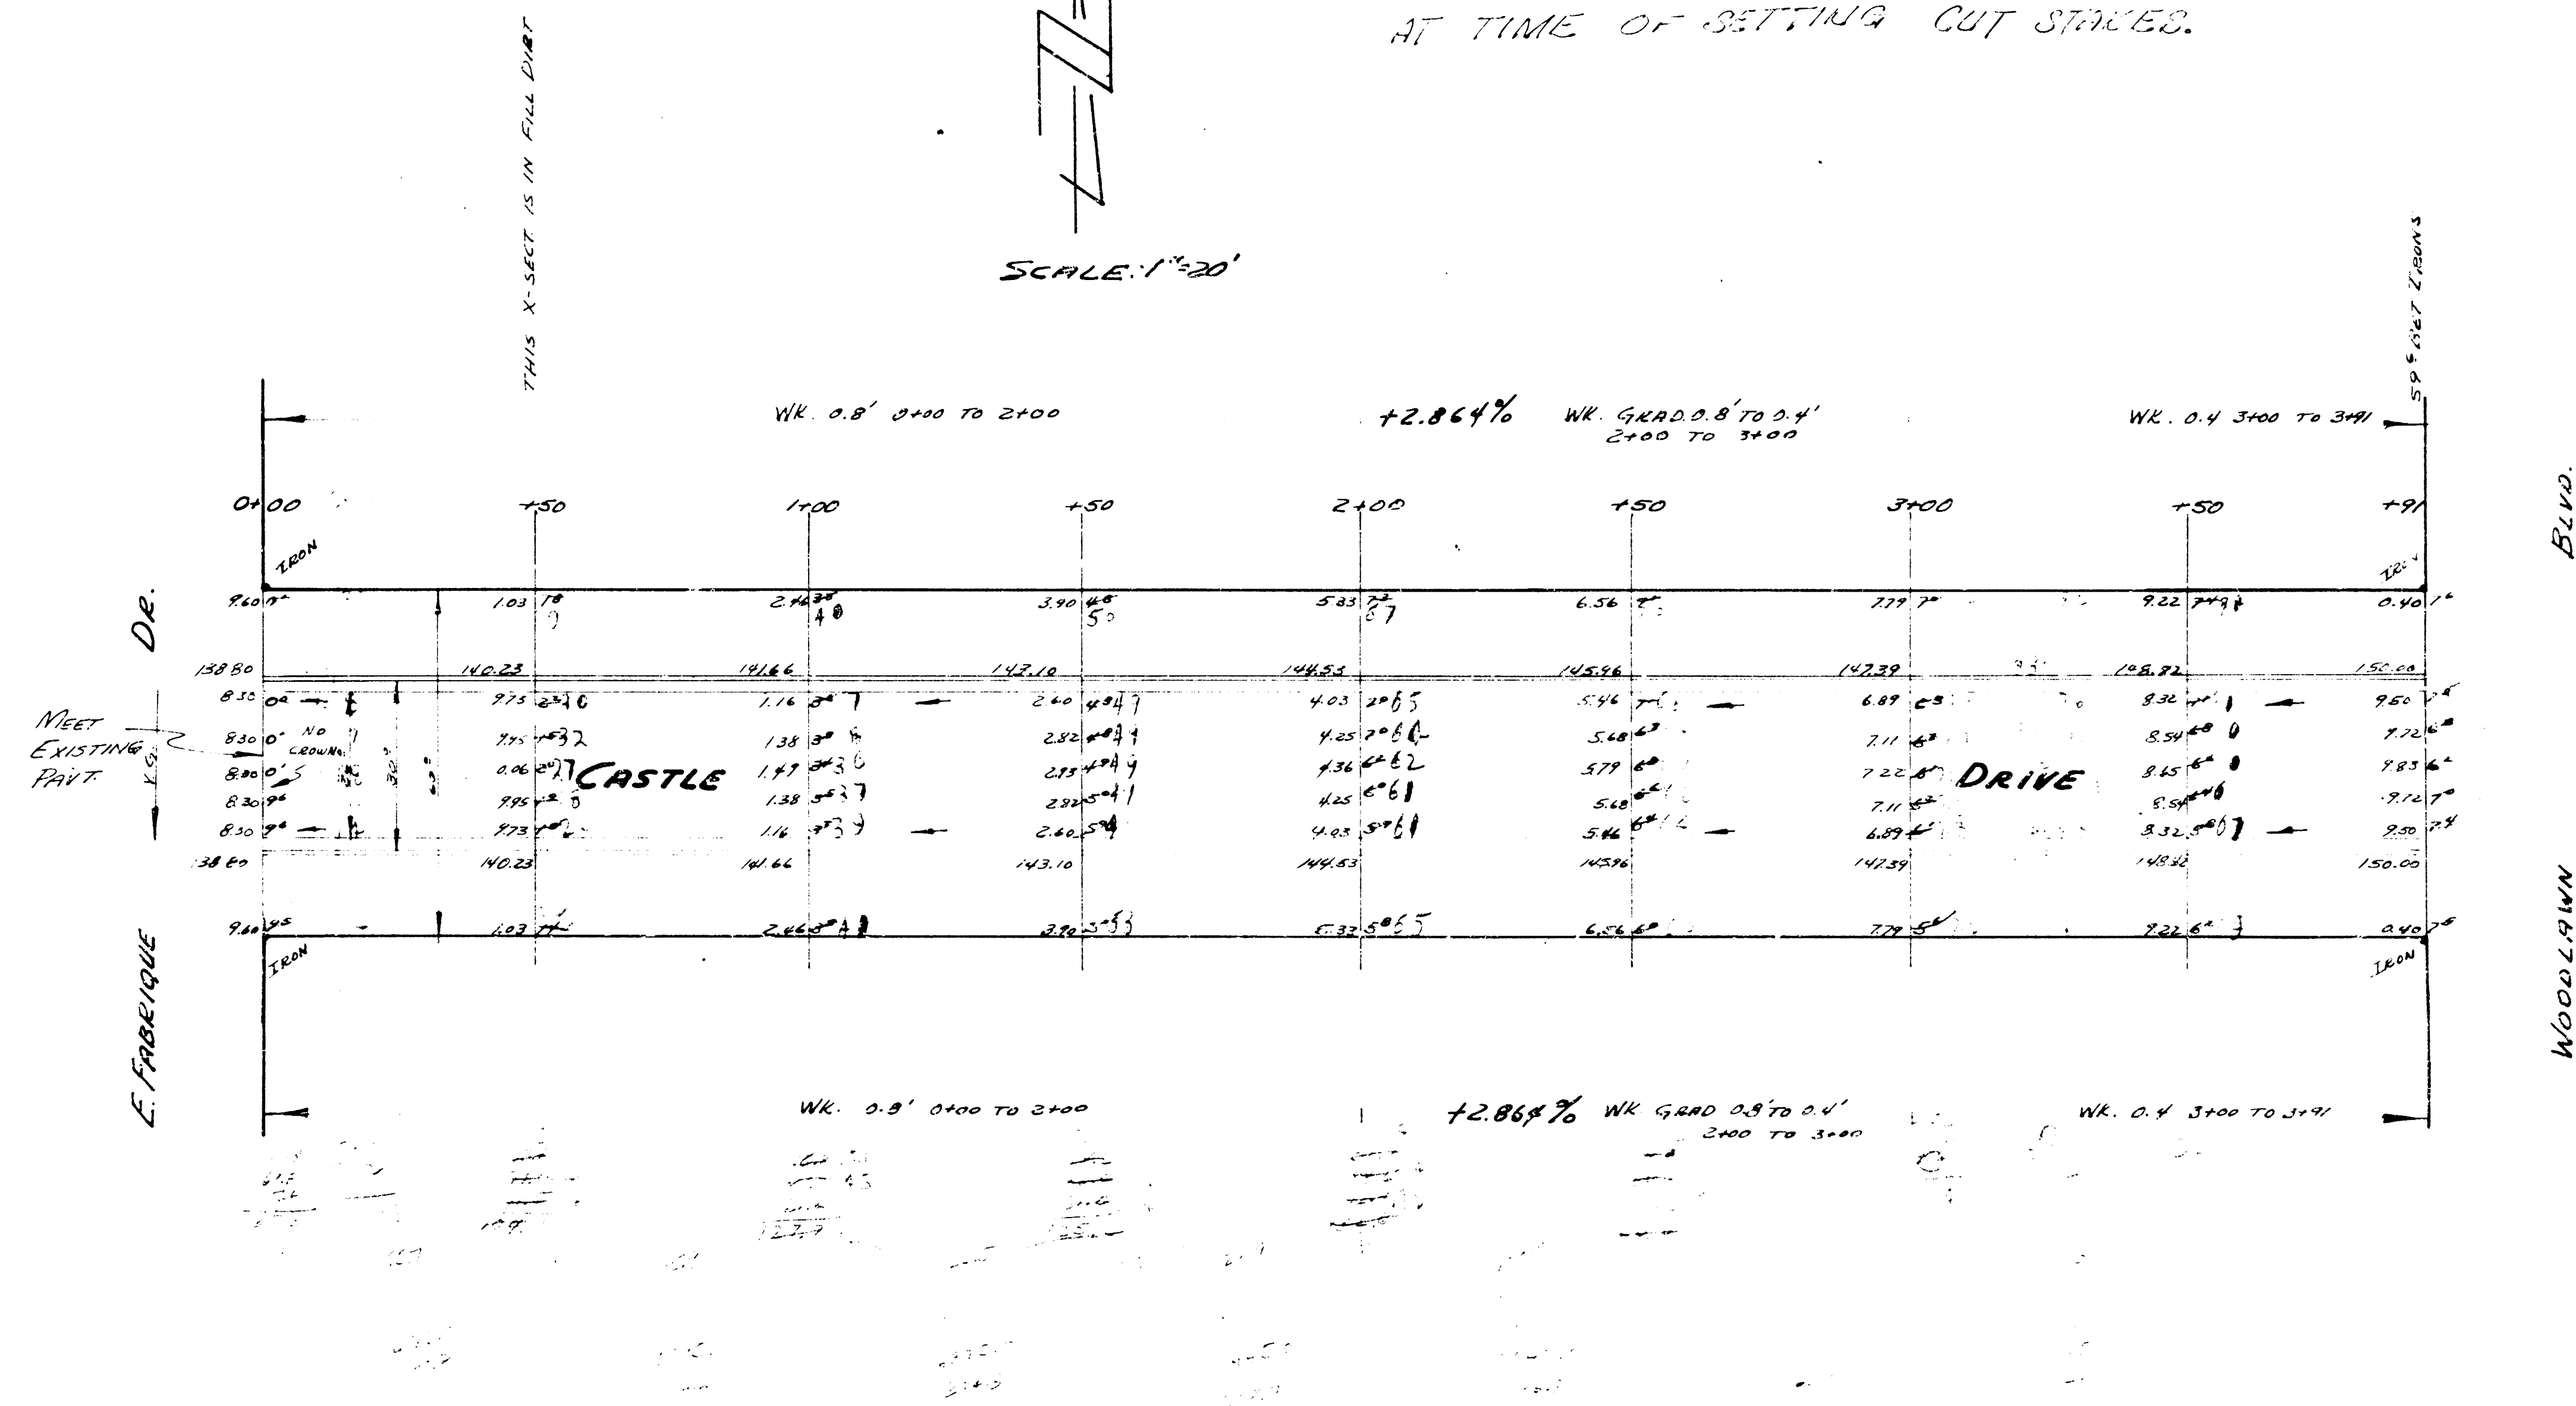

CASTLE DR.
EL E. FABRIQUE 10 WIL WOODLAWN
R6-2-30AC
CITY OF WICHITA, KANS.
LK WHITE CITY ENGINEER
JAN. 28, 1952 Proj. No. CH-324