



S-4

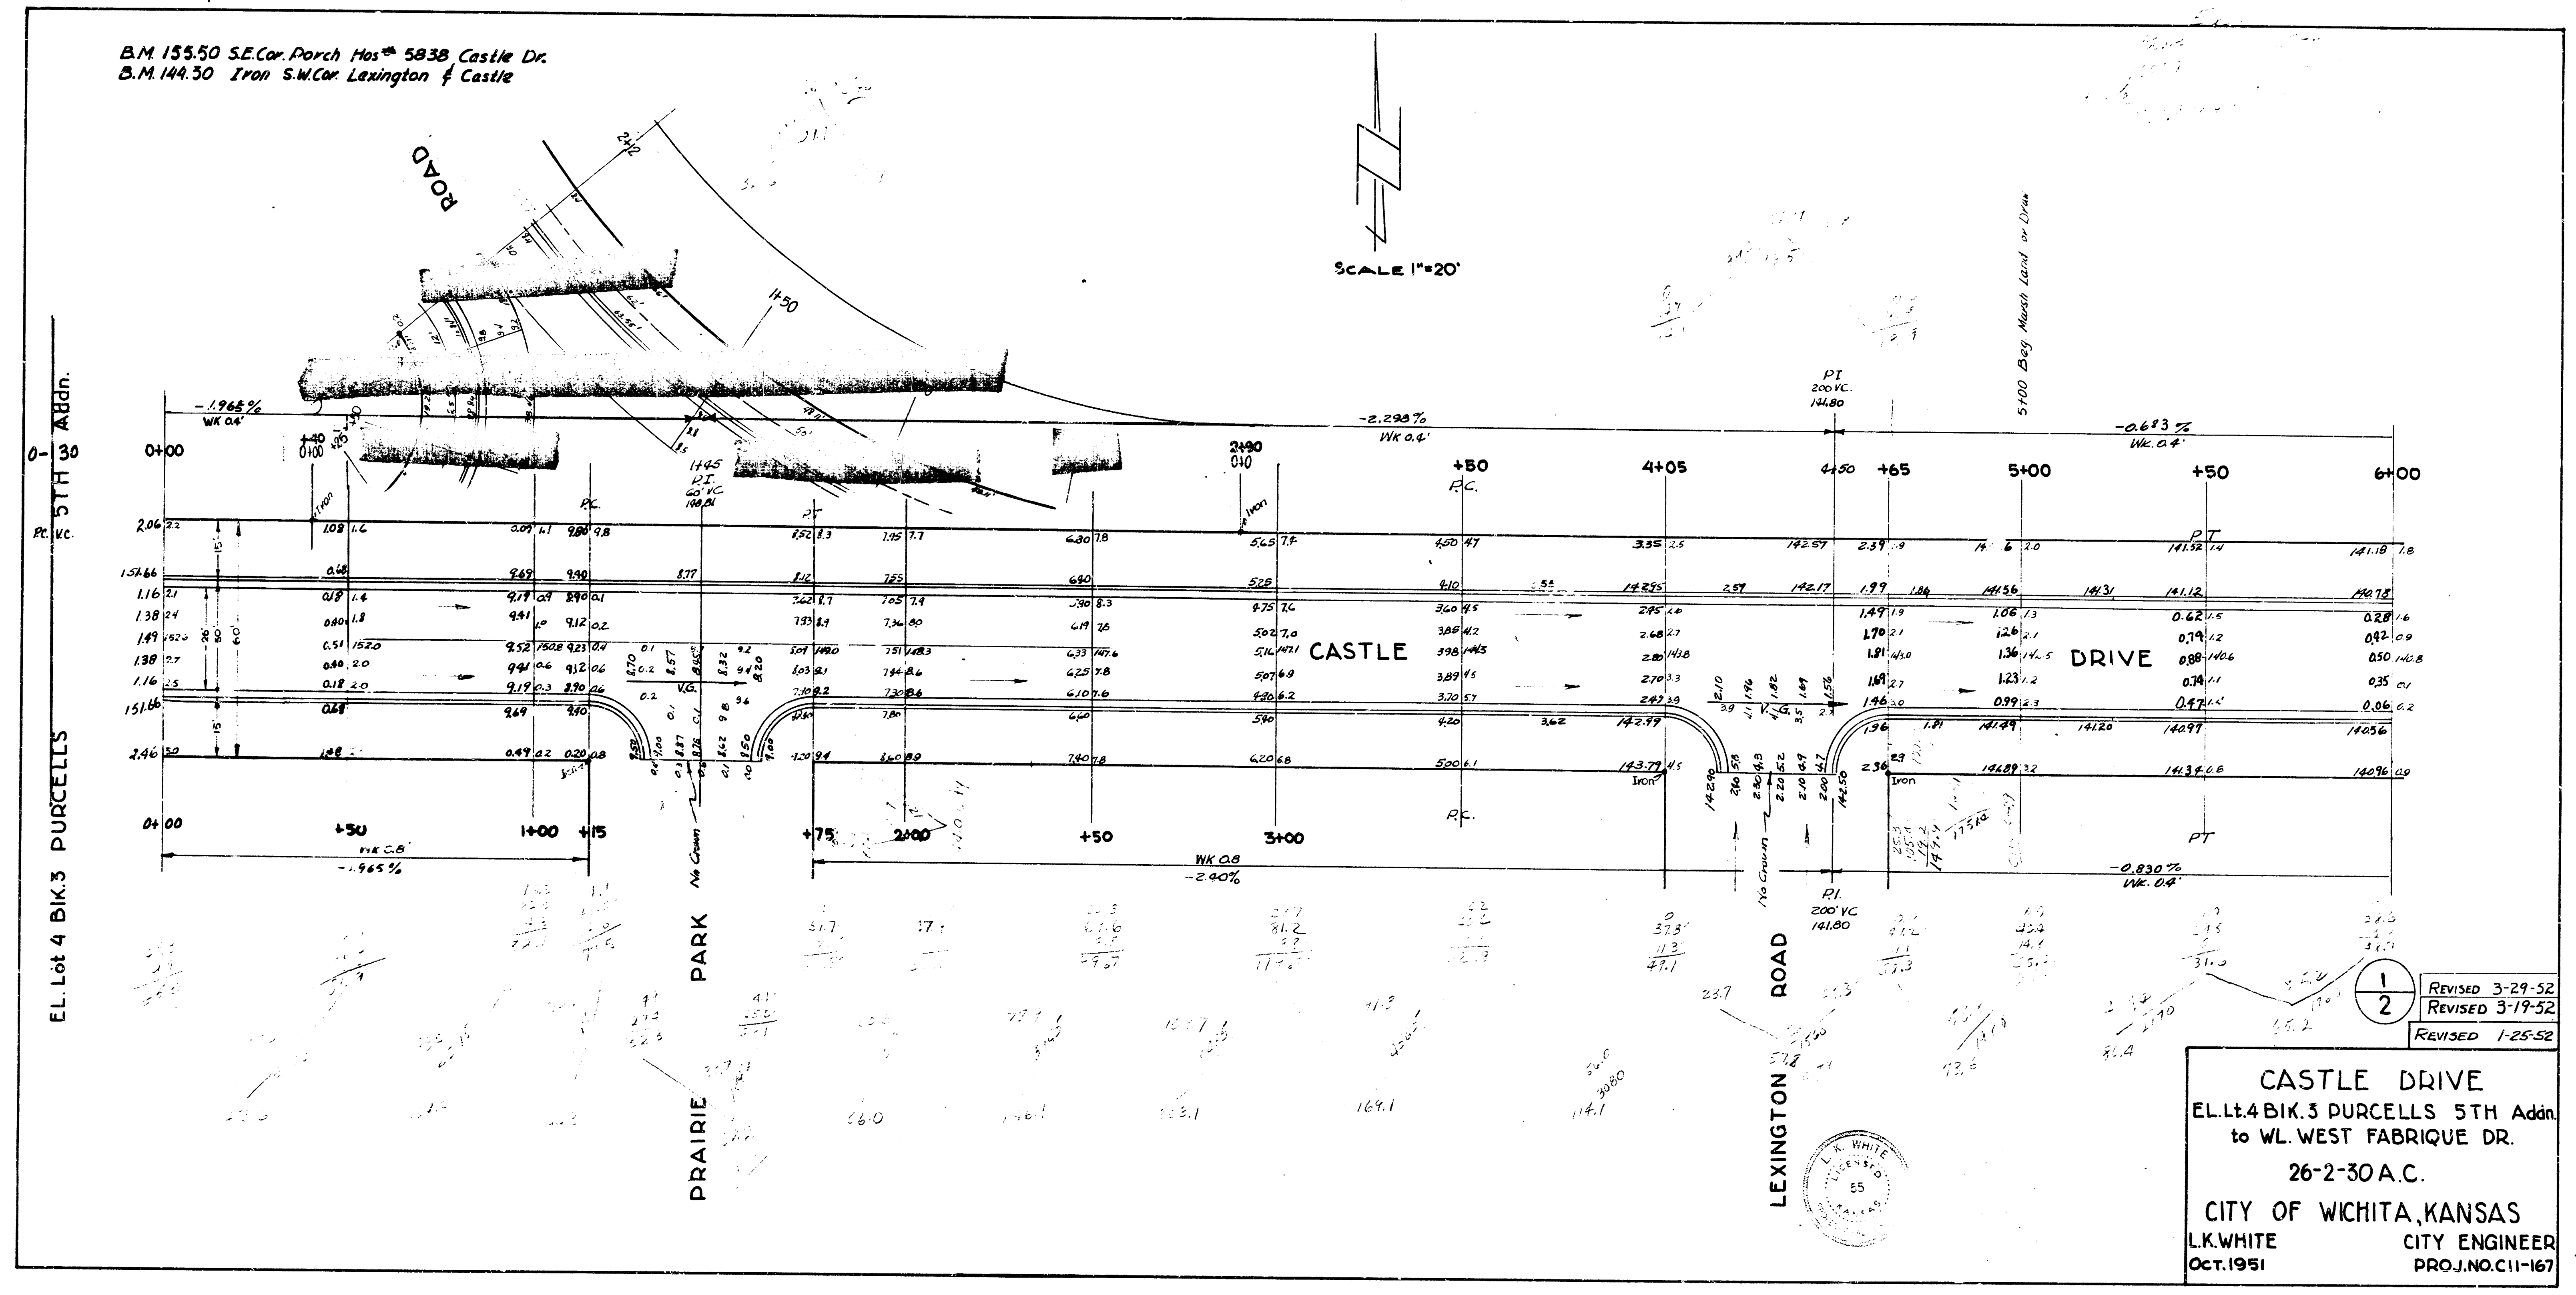

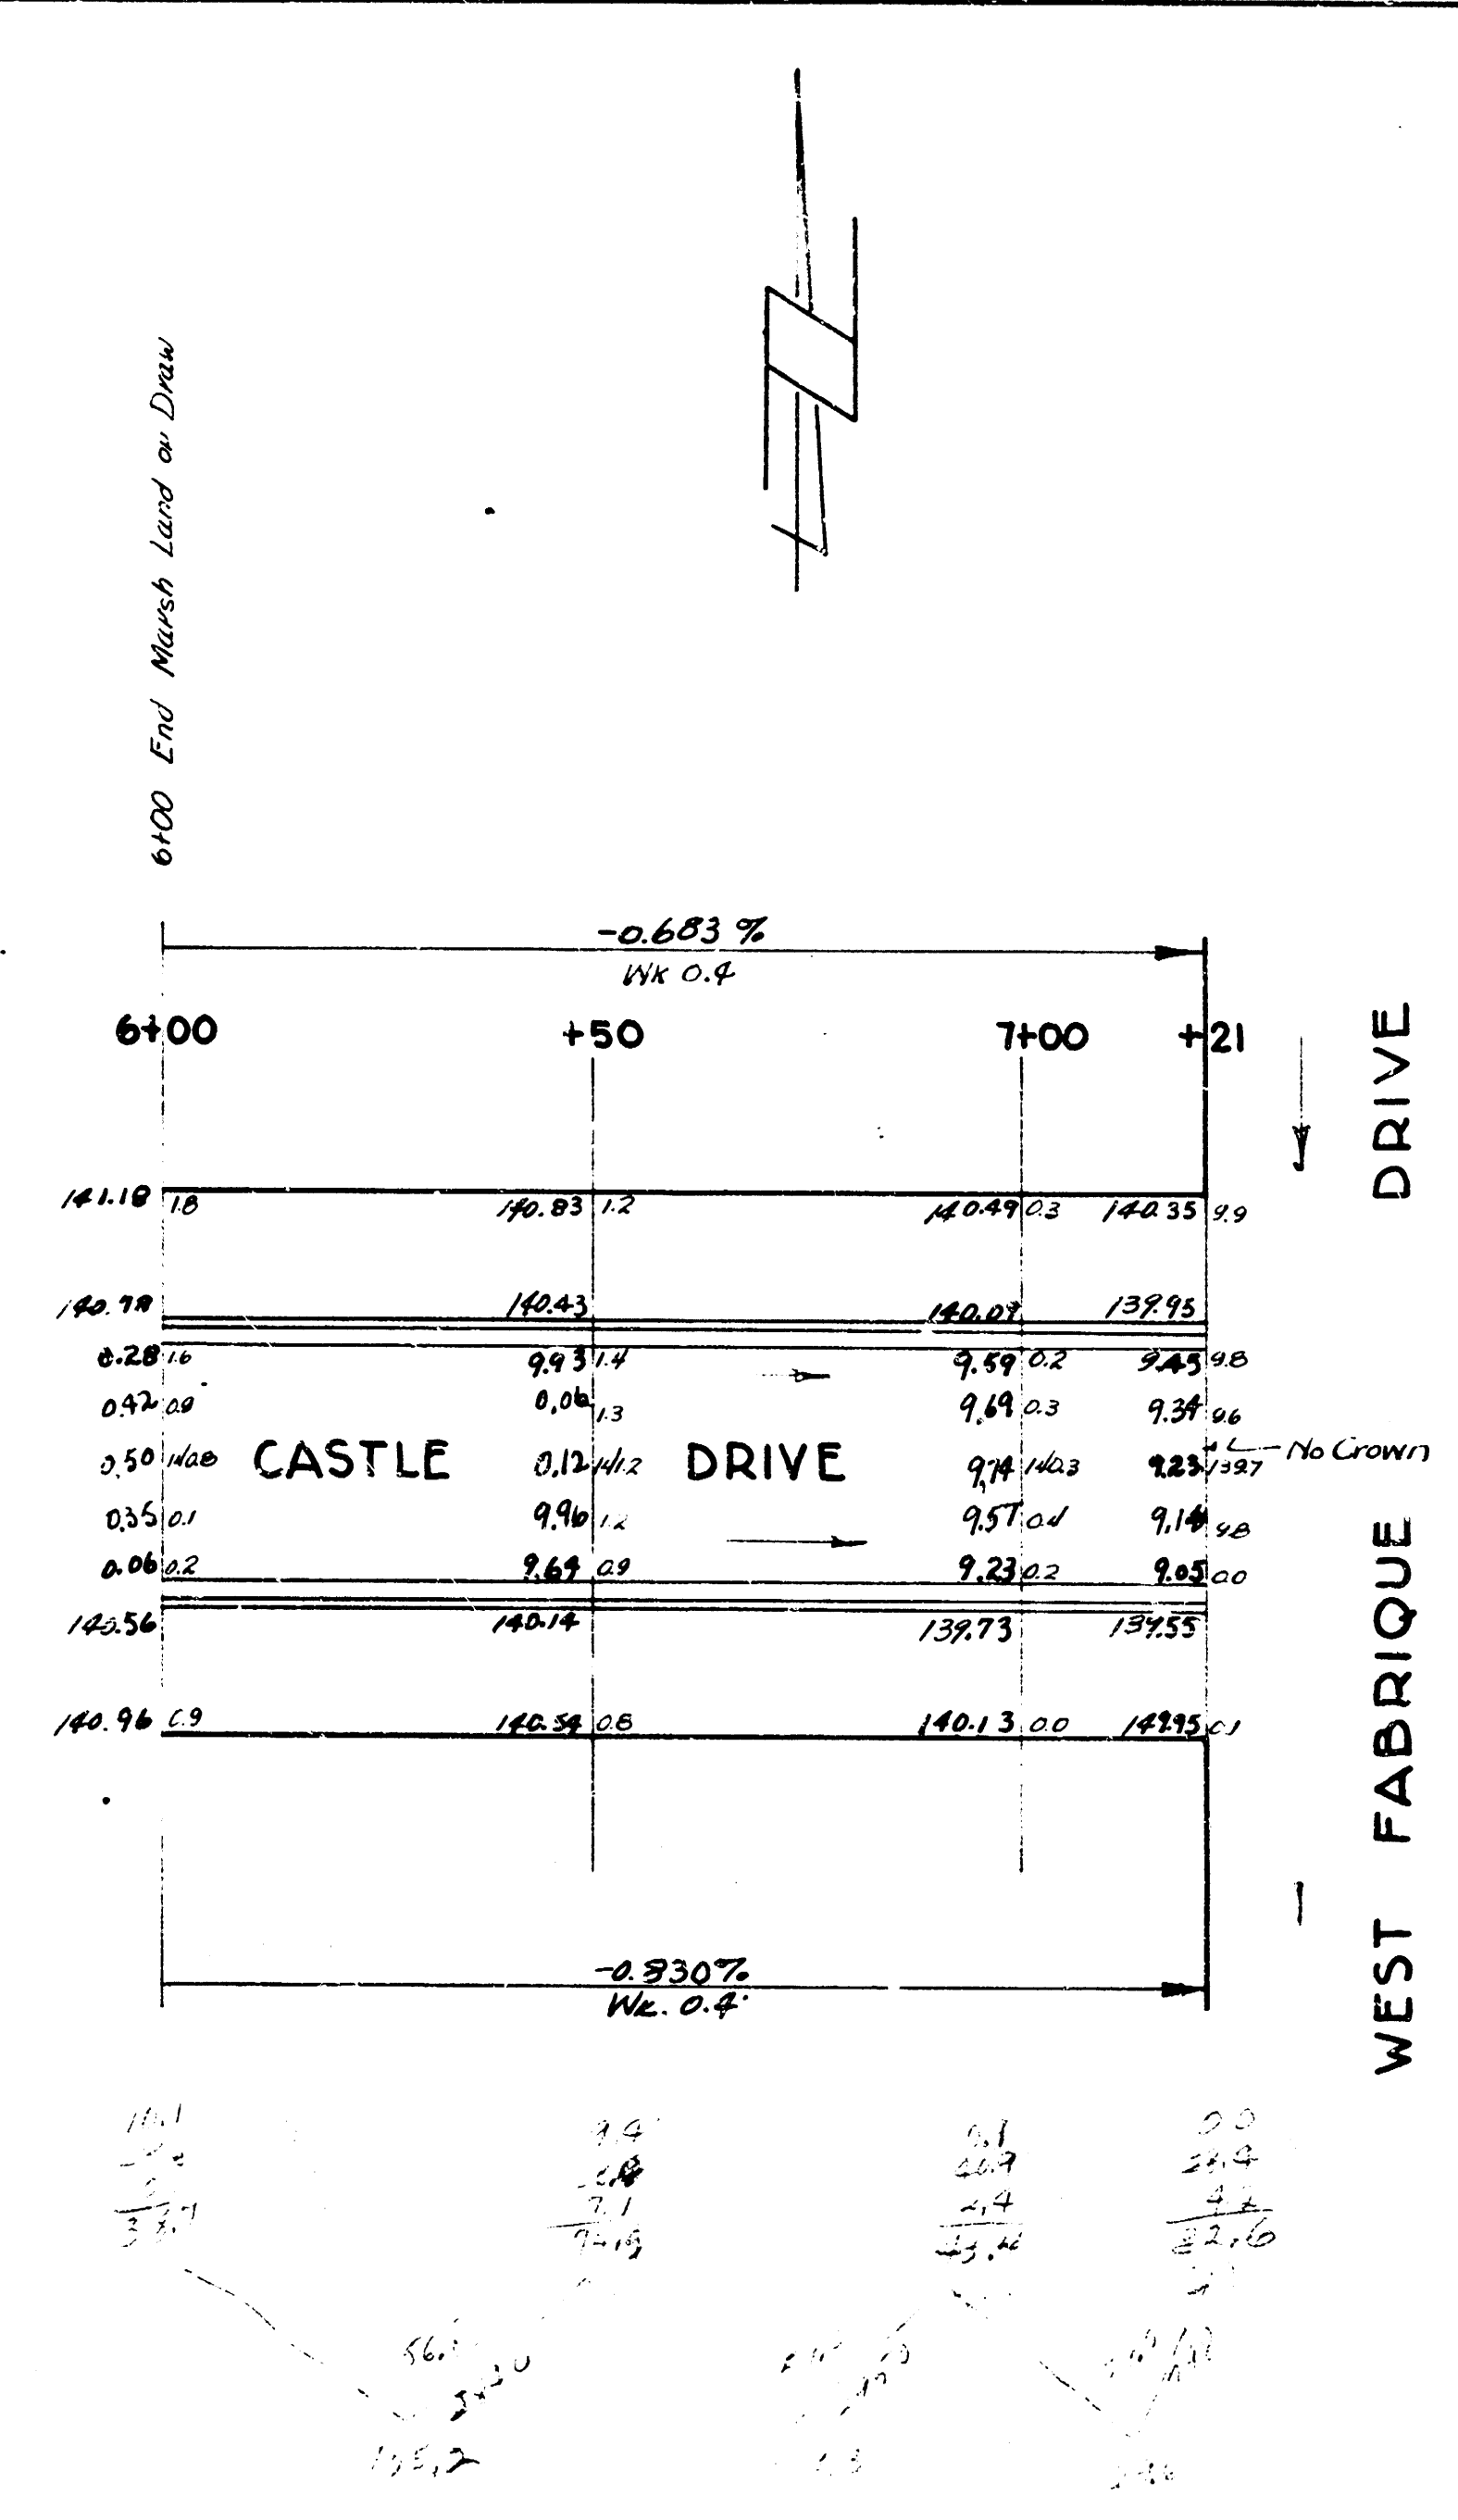

2
2

CASTLE DRIVE