

$$\begin{array}{r}
 P_{100} \\
 103.1 \\
 52.2 \\
 3.3 \\
 2.1 \\
 13.3 \\
 91.5 \\
 134.6 \\
 \hline
 398.0 \\
 +10\% \\
 \hline
 437.8 \text{ cu ft}
 \end{array}$$

City

49.1	
22.8	
18.9	
114.2	
21	
67.9	
22.2	
297.2	
+10%	
326.92	

189.06g 22.80g 49.10g


309.6 166 730

38.4 440 510

10.5 3.5 84.4 16.0

26.2 84.4 16.0

36.7 16.0

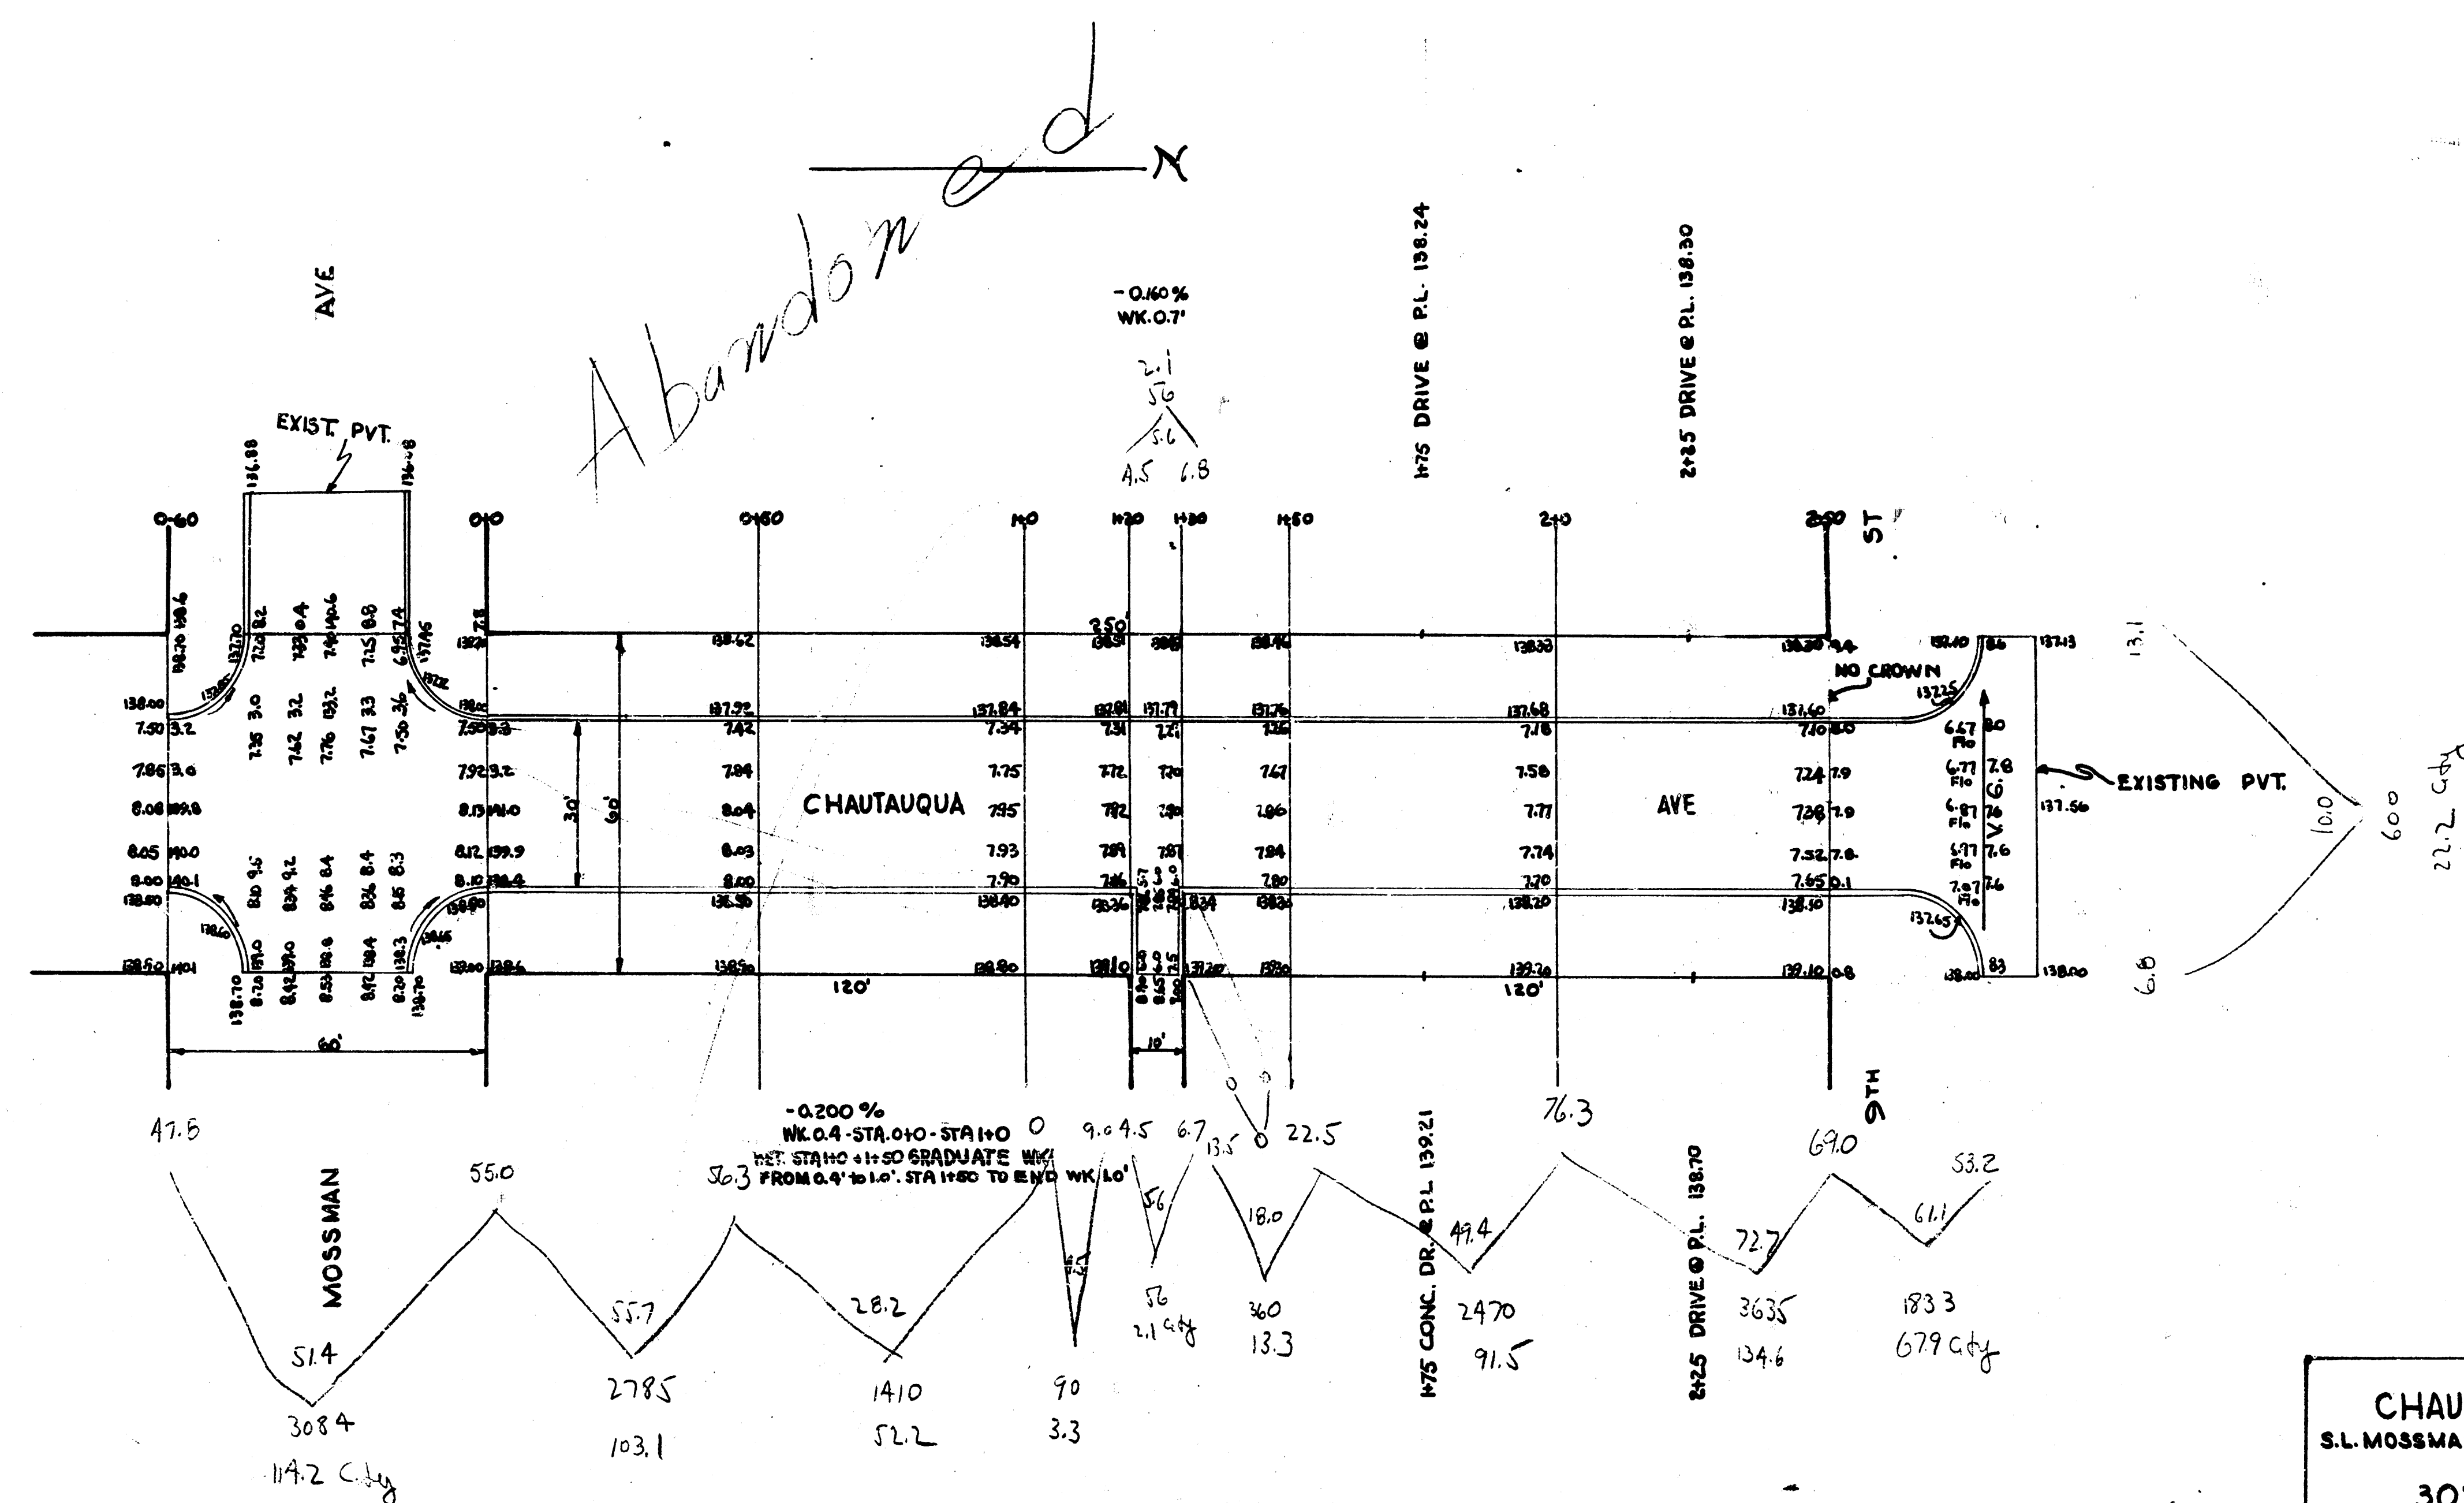

CHAUTAUQUA AVE
S.L. MOSSEMAN TO S.L. 9TH
30' CONC. & CB
CITY OF WICHITA, KANSAS
L.K. WHITE CITY ENGINEER
MARCH 1947

