


BK-CHM 65

BM. 154.50 "6" in Globe E. ch. Erie, SL. 21st
 BM. 146.45 "9" in 1942 E. ch. Chautauque, NL Shadybrook.
 BM. 151.72 NE. cor. conc. porch No. 2127 N. Chautauque.

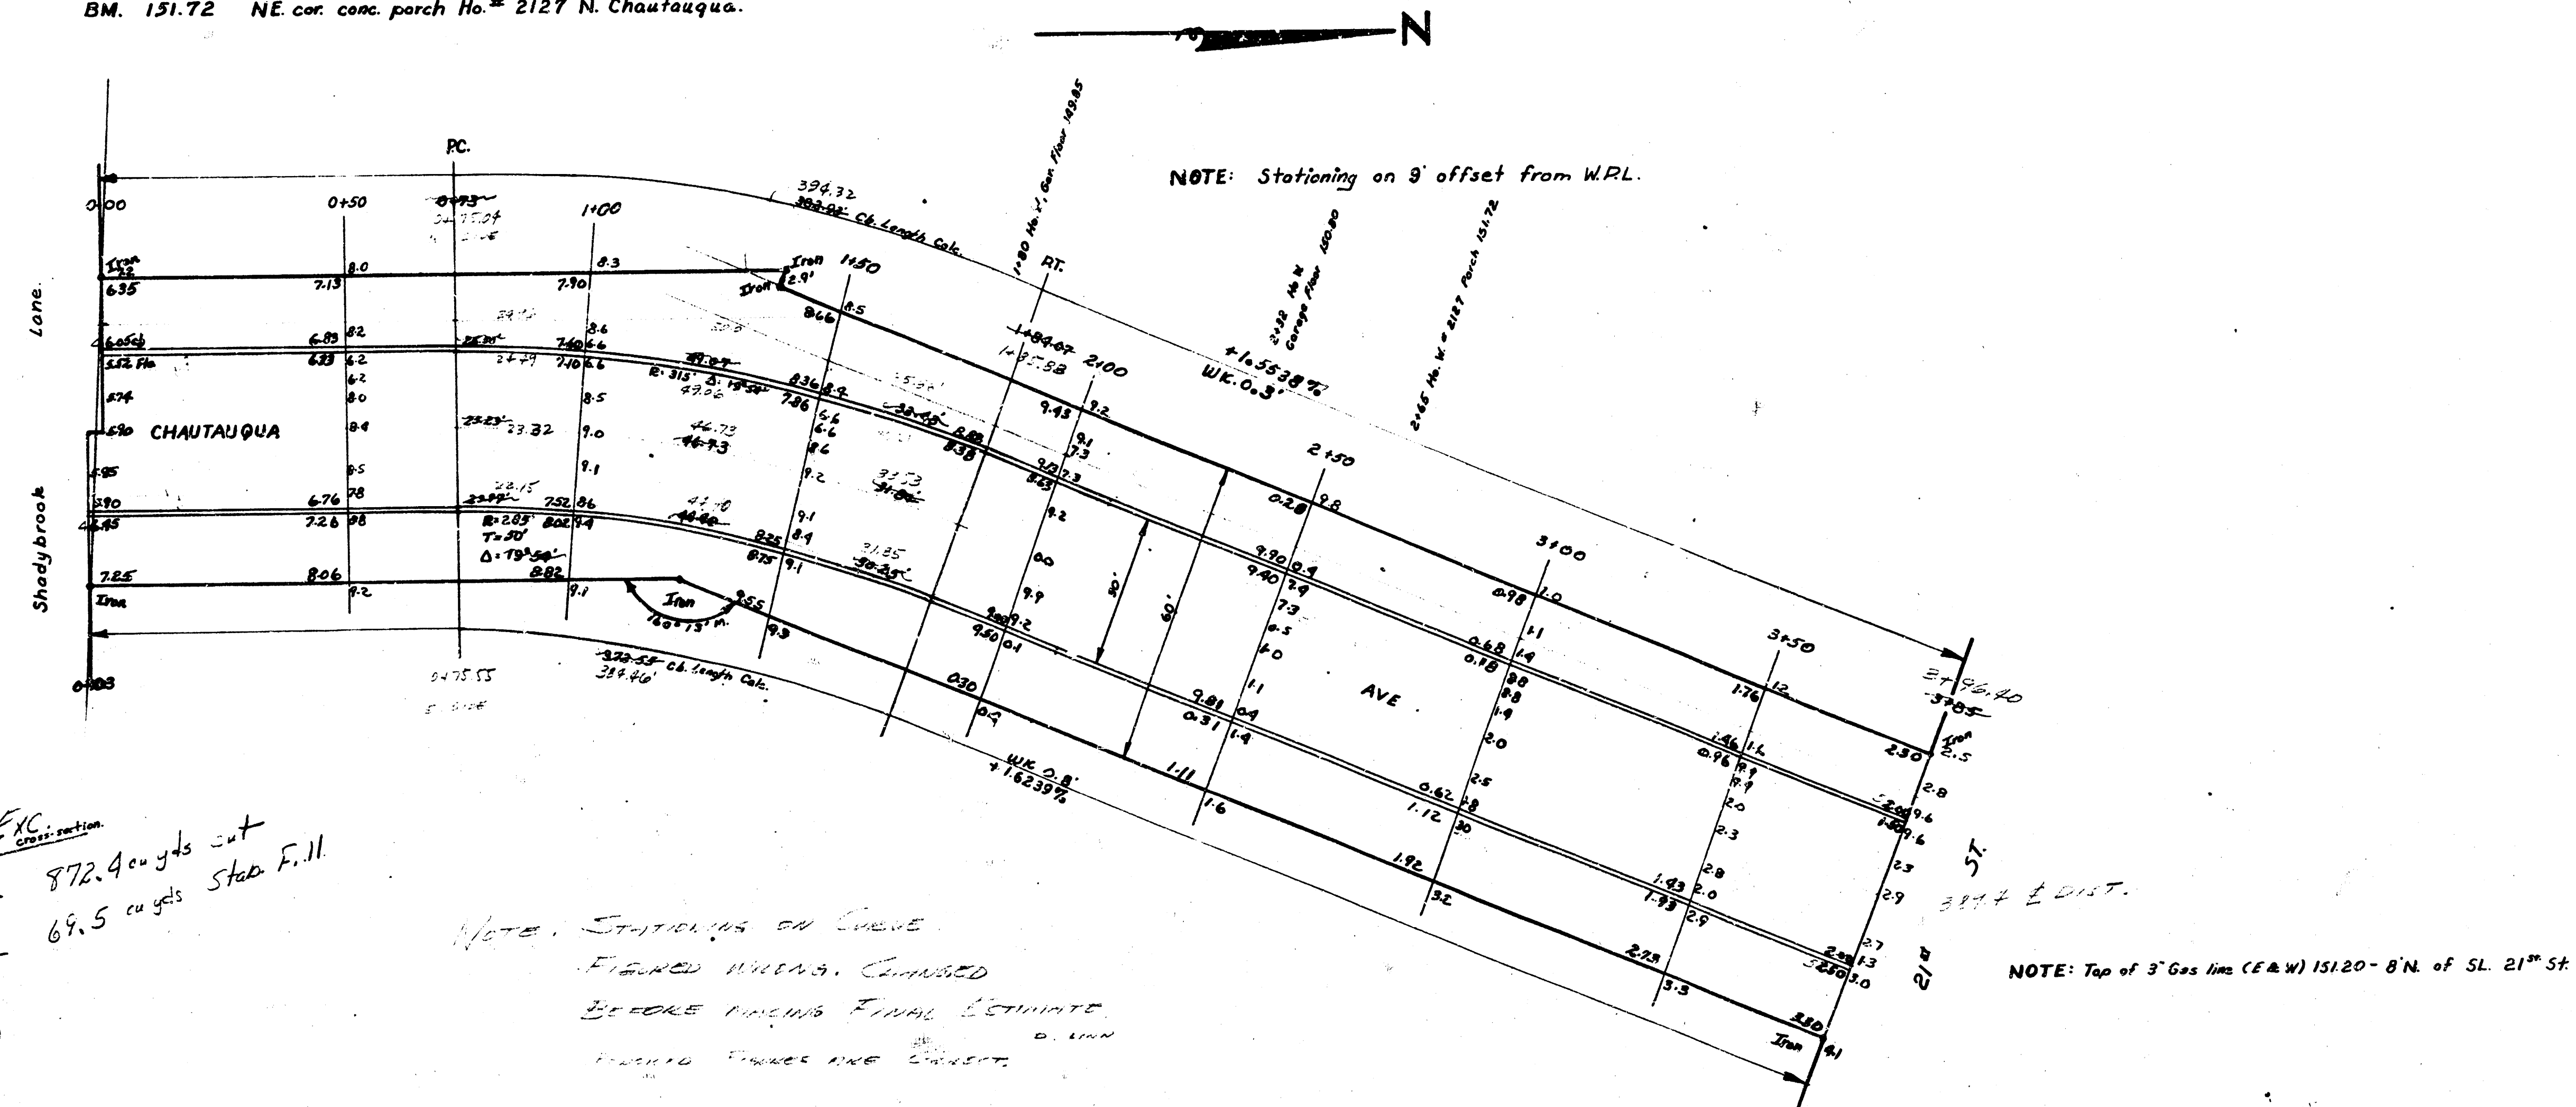

Total Exc. cut
 Property - 872.4 cu yds cut
 - 69.5 cu yds State Fill

City - 0

NOTE: STATIONING ON CURVE
 FIGURED MEAS. CHANGED
 BEFORE MAKING FINAL ESTIMATE
 PLACING PAVES ARE SHOWN

Chautauque Ave.
 NL Shadybrook Lane to SL. 21st St
 30' Conc. & Ch
 City of Wichita, Kansas
 L. K. White City Engineer
 October 1950 Proj No. C10-113