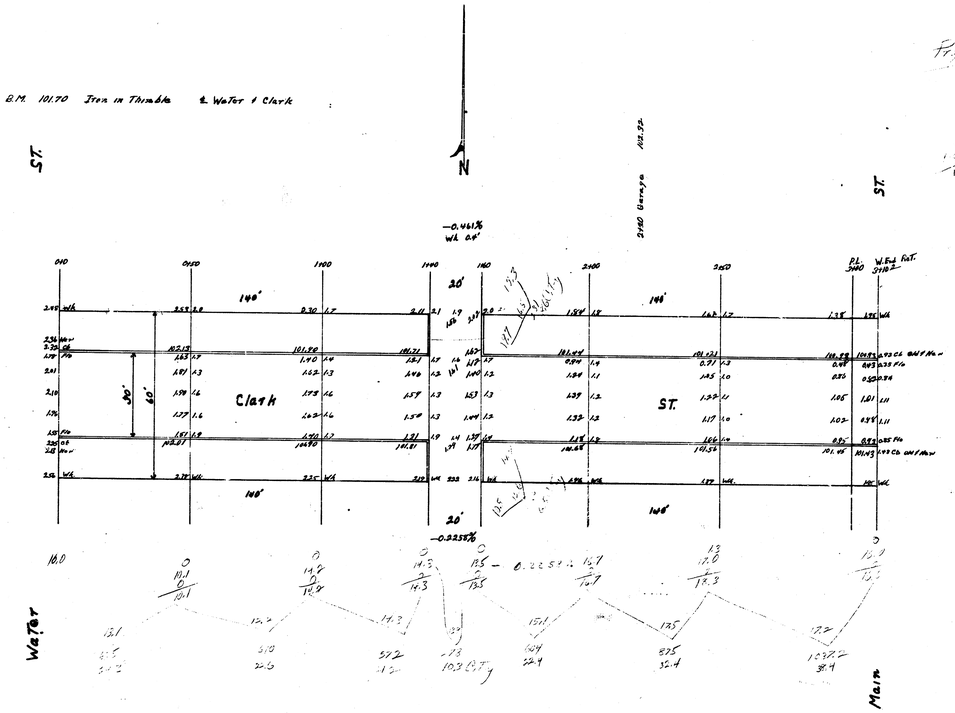


Clark ST.

E.L. Water — W.L. Main

30' Conc. — Ck.

City of Wichita, Kansas

L.H. White City Engineer

May 1948 Project C18-46

4 133 12