CORNELISON ST.

E.L. HYACINTH LANE TO E.L. LOT 3, BLK. 1, RIVER PARK ADDITION

TYPICAL SECTIONS of 30' ASPHALTIC CONCRETE PAVEMENT

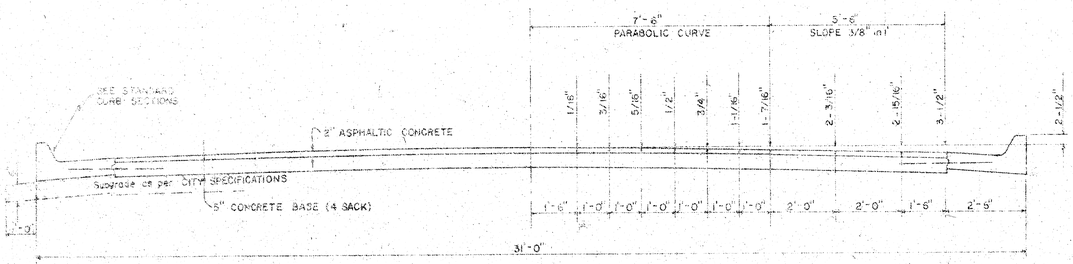

TYPICAL SECTION WITH STANDARD CROWN

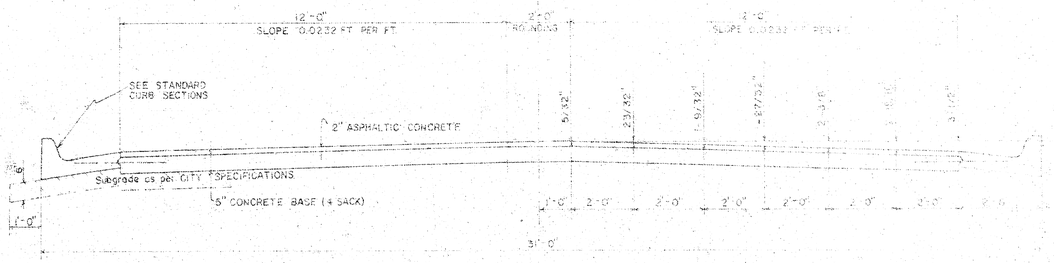

TYPICAL SECTION WITH ALTERNATE CROWN

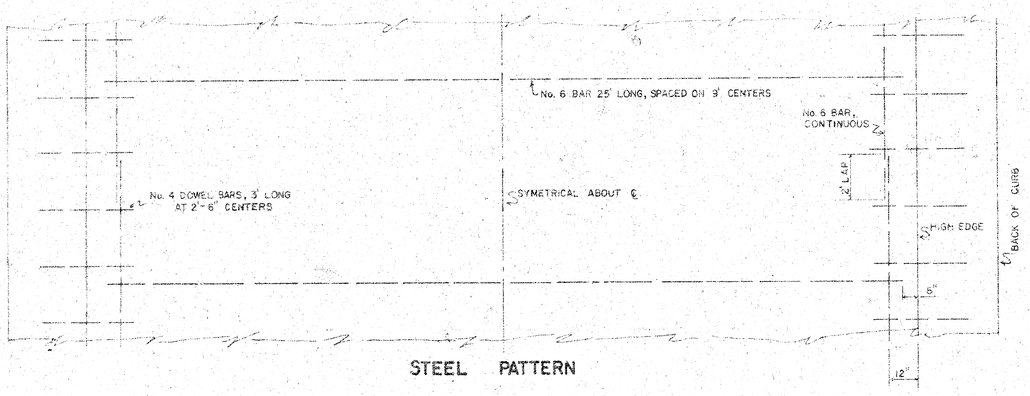

STEEL PATTERN

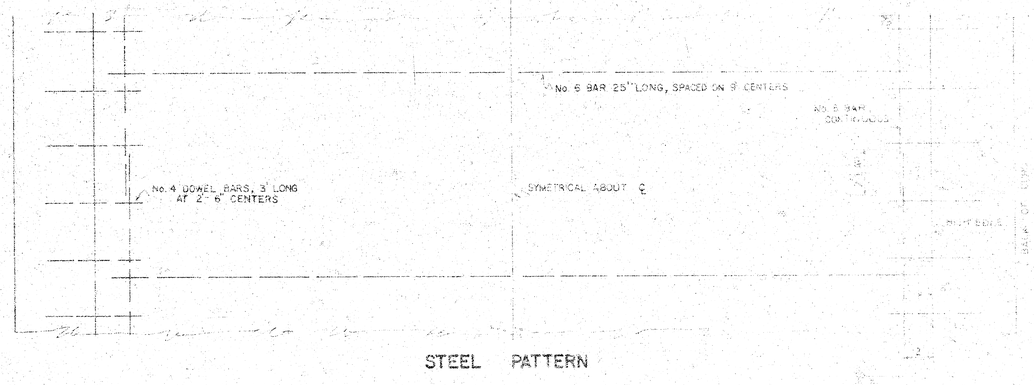

STEEL PATTERN

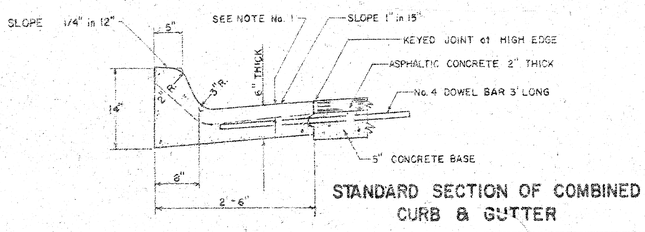

STANDARD SECTION OF COMBINED CURB & GUTTER

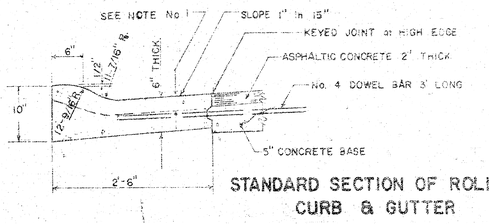

STANDARD SECTION OF ROLL-TYPE CURB & GUTTER

GENERAL NOTES

1. CONTRACTION JOINTS MAY BE CONSTRUCTED IN COMBINED CURB AND GUTTER BY SAWING WITH AN APPROVED CONCRETE SAW. THE SAW CUT SHALL EXTEND 2-1/2" BELOW THE SURFACE OF THE GUTTER AND CURB. SAWED CONTRACTION JOINTS SHALL HAVE A MAXIMUM SPACING OF 10' AND BE FILLED WITH A SPECIFIED JOINT FILLER, SUCH THAT THE JOINT IN THE GUTTER SECTION WILL BE COMPLETELY FILLED.

R. W. LINN LICENSED 3534 ENGINEER

CITY OF WICHITA, KANSAS
Department of Public Works - Engineering Division
R.W. Linn — City Engineer
Date July, 1976 — Project No. DAKS 564016

1/3

1/2

B-M

FILMED FROM THE BEST AVAILABLE COPY

B.M. 126.15' 'a' Cut Xap E.-Cb. Hyacinth @ S.L. Cornelison.
B.M. 128.73' S.W. Cor. conc. porch No. # 2602 Cornelison.

Baseline is ℄ Cornelison.

Survey Proj. Blk. Dr. dwg
Plan Master
Exc. "
Checked "

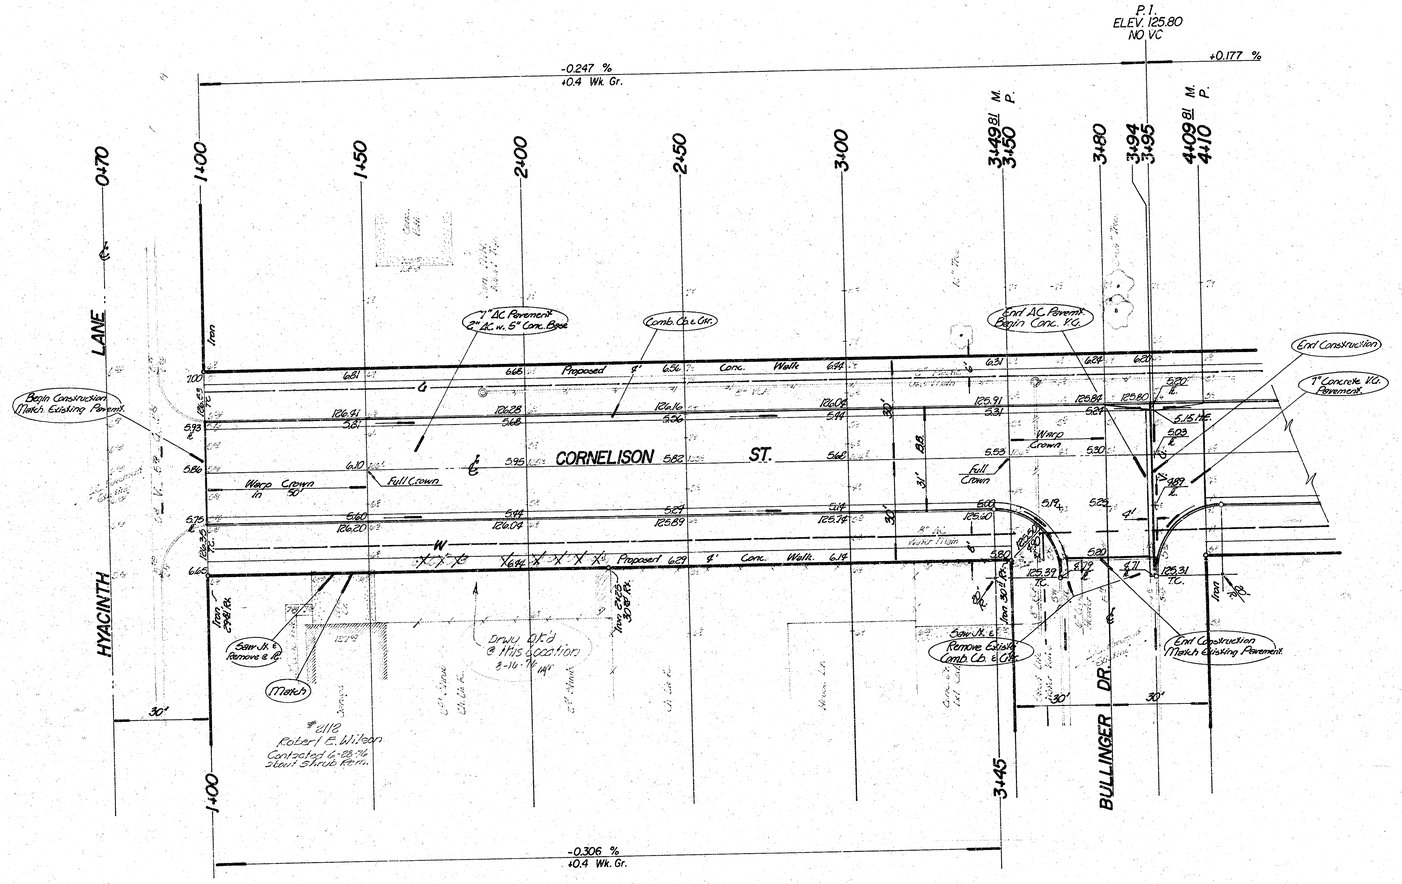

Scale: 1" = 20'

Note to Contractor:

Conc. header removal incidental to project, and to be decided by Engineer.
Take ties & replace all "irons" moved or destroyed.
All excess earthwork to be used on proj. DAKS 564017.
Construction to allow for 5-20' drives.

X·X·X = indicates Shrub Removal.
[ ] = indicates Removal.

Note: Change S.W. Cb. & Gtr. to Roll Cb. & Gtr. 8/16/76

Earthwork Quantities

Property		City	
Exc. = 1954 cy	Comp. Fill = 0.8 cy.	Exc. = 18.8 cy.	Comp. Fill = 23.6 cy.
x 10 % = 19.5 cy.	x 10 % = 0.1 cy.	x 10 % = 1.9 cy.	x 10 % = 2.4 cy.
Total = 214.9 cy.	Total = 0.9 cy.	Total = 20.7 cy.	Total = 26.0 cy.
Manipulation = 9973 sy.		Manipulation = 1346 sy.	

NOTE TO FIELD ENGINEER & CONTRACTOR
Grade parking and clear right-of-way for proposed sidewalk. Compact fill in sidewalk area. TO BE CONSTRUCTED BY "OTHERS".

SUB-GRADE
TYPE OF SUB-GRADE TREATMENT SHALL BE DETERMINED BY THE FIELD ENGINEER. SUB-GRADE TREATMENT MAY CONSIST OF LIME TREATMENT, CEMENT TREATMENT, SUB-GRADE MODIFICATION, OR ANY COMBINATION OF THESE.

CORNELISON ST.
E.L. Hyacinth Lane to E.L. Lot 3, Blk 1, River Park Addition.
31' B.B. - 2" Asph. Conc. Surf. w. 5" Conc. Base - Combined Curb & Gutter.
CITY of WICHITA, KANSAS
R. W. Linn — City Engineer
Project No. — DAKS 564016
Date: July, 1976
2/2

FILMED FROM THE BEST AVAILABLE COPY