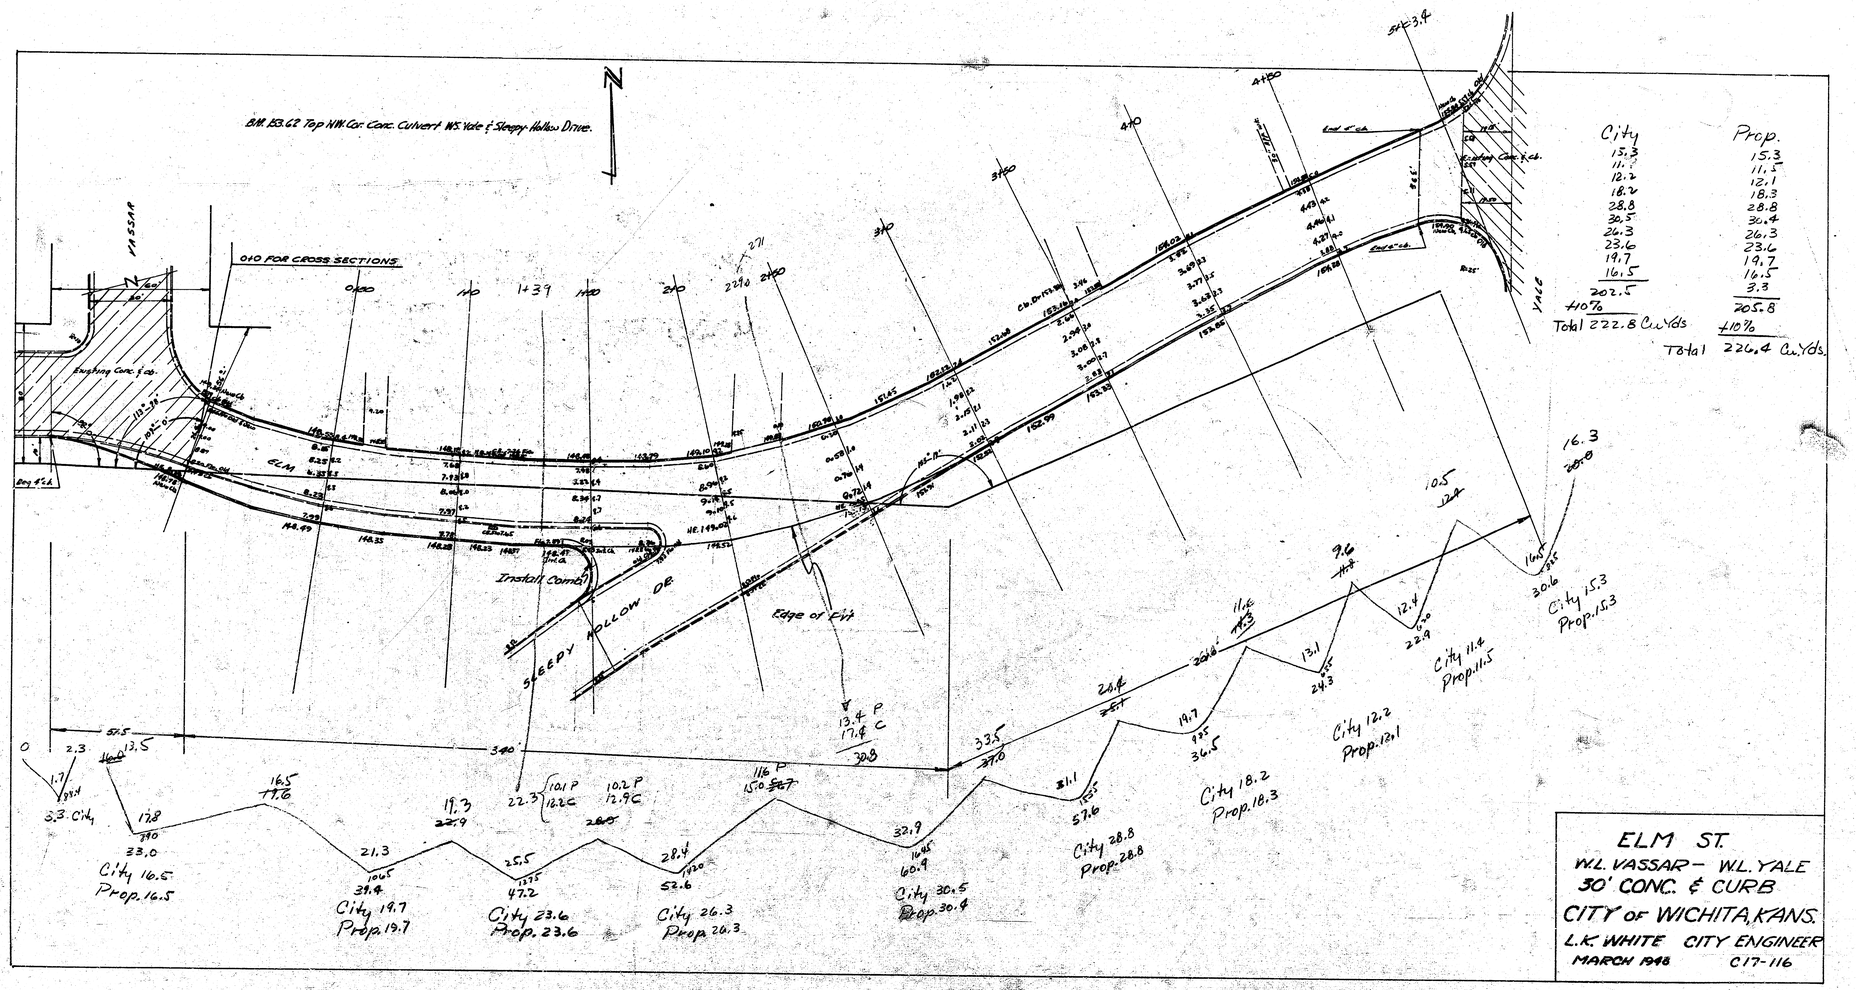
BM 1353.62 Top NW Cor. Conc. Culvert W.S. Yale & Sleepy Hollow Drive.
N
010 FOR CROSS SECTIONS
0+00
1+39
2+00
2+90
3+00
4+00
4+10
Existing Conc. Curb
ELM
Install Curb
SLEEPY HOLLOW DR
Edge of Fill
YALE
City
Prop.
15.3
11.5
12.2
18.2
28.8
30.5
26.3
23.6
19.7
16.5
202.5
410%
Total 222.8 Cu.Yds.
15.3
11.5
12.1
18.3
28.8
30.4
26.3
23.6
19.7
16.5
3.3
205.8
410%
Total 226.4 Cu.Yds.
City 16.5
Prop. 16.5
City 19.7
Prop. 19.7
City 23.6
Prop. 23.6
City 26.3
Prop. 26.3
City 30.5
Prop. 30.4
City 28.8
Prop. 28.8
City 18.2
Prop. 18.3
City 12.2
Prop. 12.1
City 11.4
Prop. 11.5
City 15.3
Prop. 15.3
ELM ST.
W.L. VASSAR – W.L. YALE
30' CONC. & CURB
CITY OF WICHITA, KANS.
L.K. WHITE CITY ENGINEER
MARCH 1948 C17-116

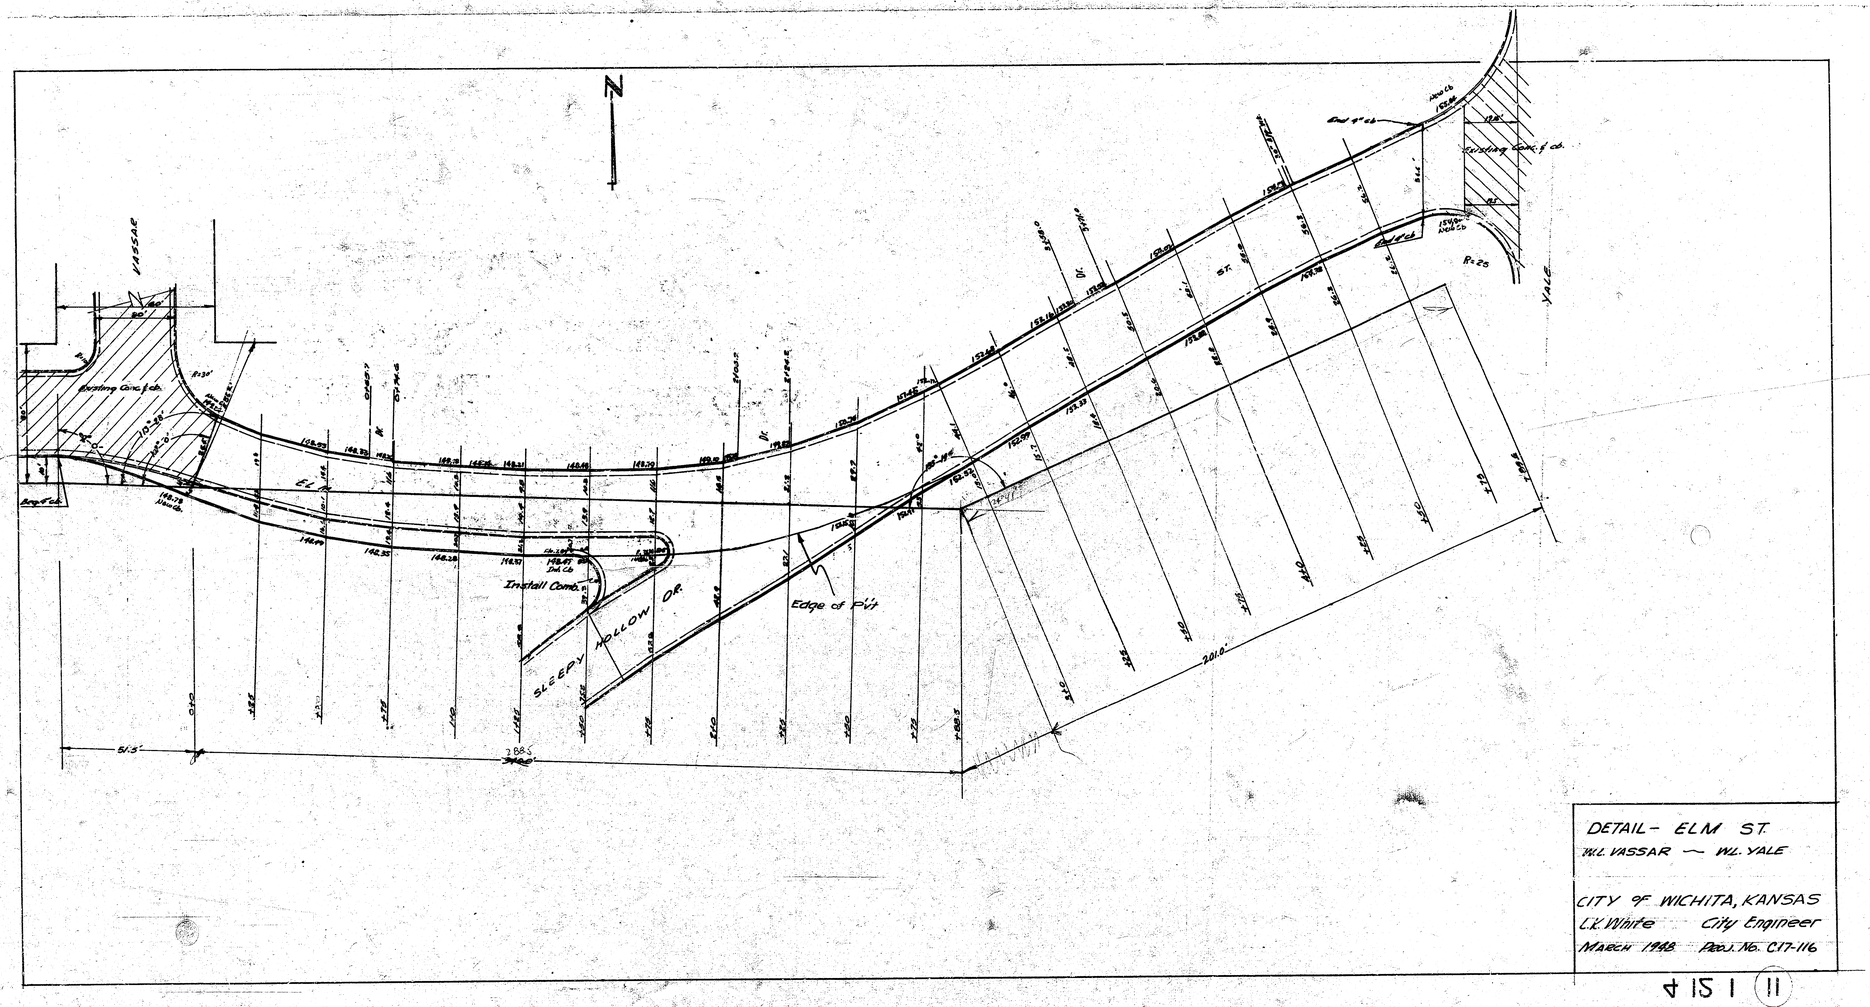

DETAIL - ELM ST.
W.L. VASSAR — W.L. YALE

CITY OF WICHITA, KANSAS
C.K. White City Engineer

SHEET 11