


Back 294

Note: Remove exist. cb. N. side Elm
Sta. 0-02 to Sta. 1440 and on W.S. Alley.

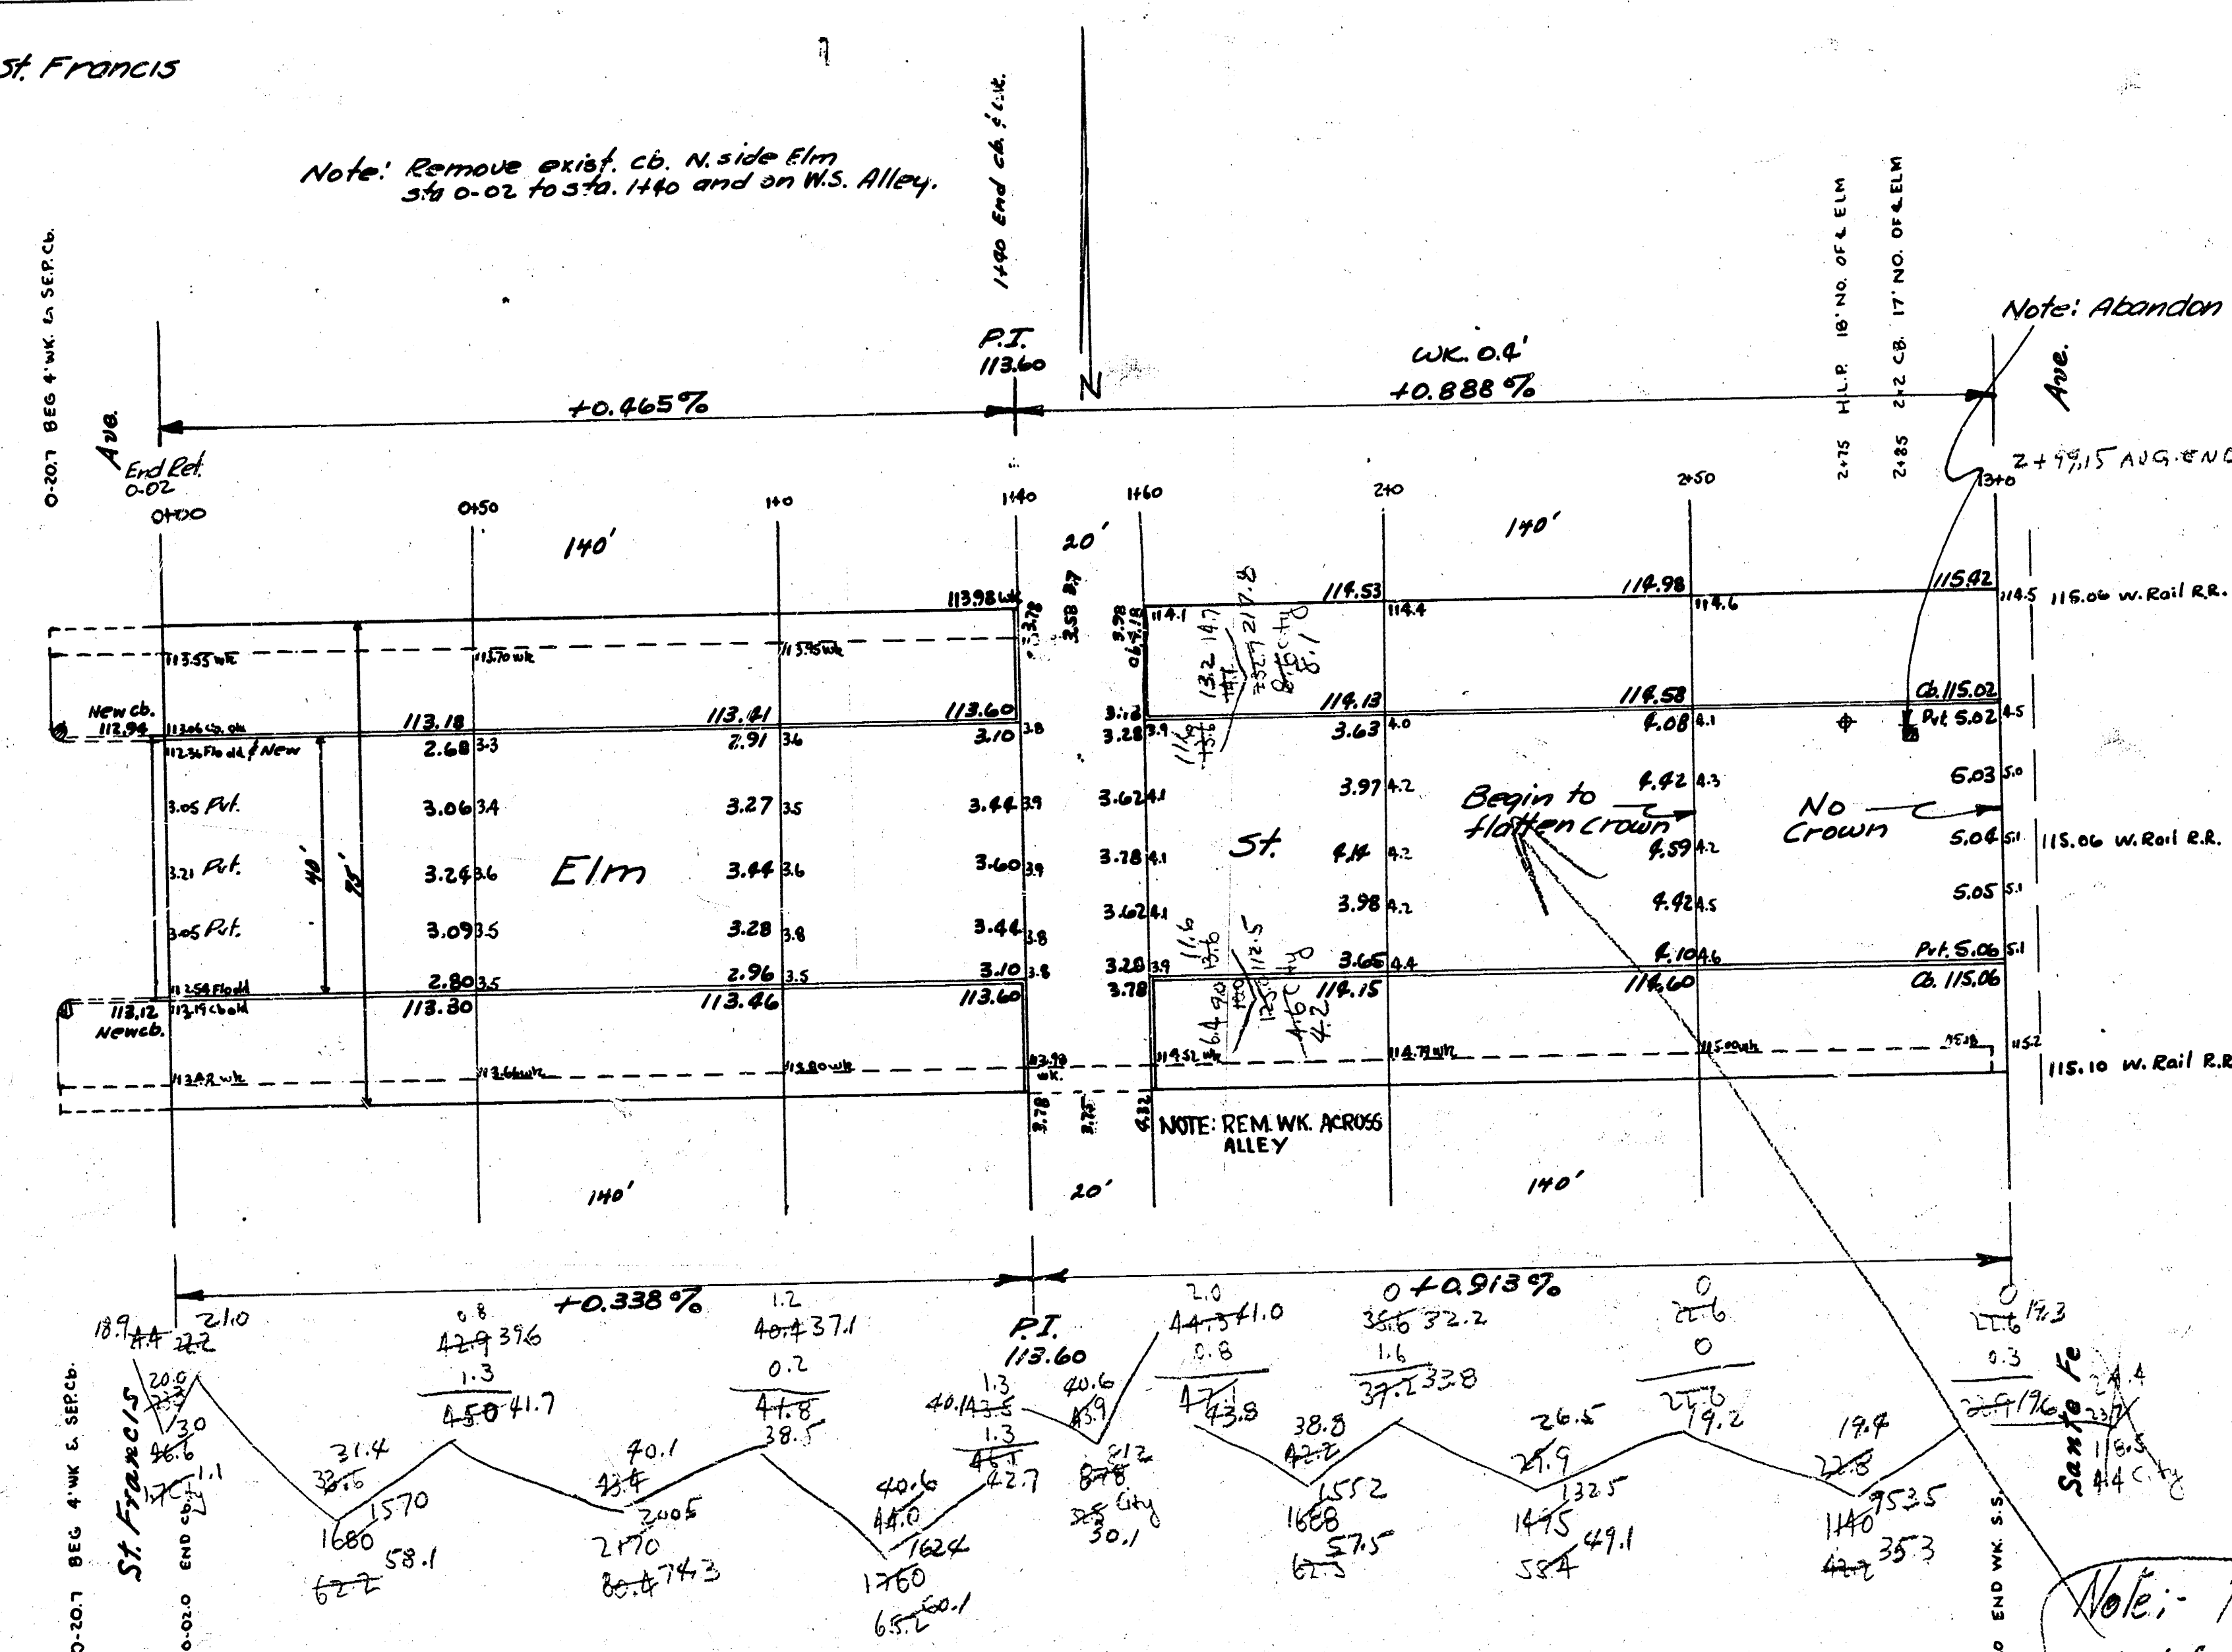

Note: Abandon exist. C.B.

Note: Begin raising pvt. at Sta. 2+50
and have pvt. flush with cb
at sta. 3+00

Exam Figure for 7" Core

<u>PROP.</u>	<u>CITY</u>
62.2	1.7
80.4	31.5
65.2	4.6
61.5	8.6
55.4	4.4
41.2	51.8
36.79	+10%
+10%	570 cups
1047 cups	-5.3 cups
-34.8 (cups)	570 cups
369.79 cups	

Note:- Place transverse reinforcing bars in usual pattern

Elm St.
EL. St. Francis — W.L. Santa Fe.
40' Conc. & Cb.
6" Conc.
City of Wichita, Kansas
L.H. White City Engineer
January 1949 Project C18-170