


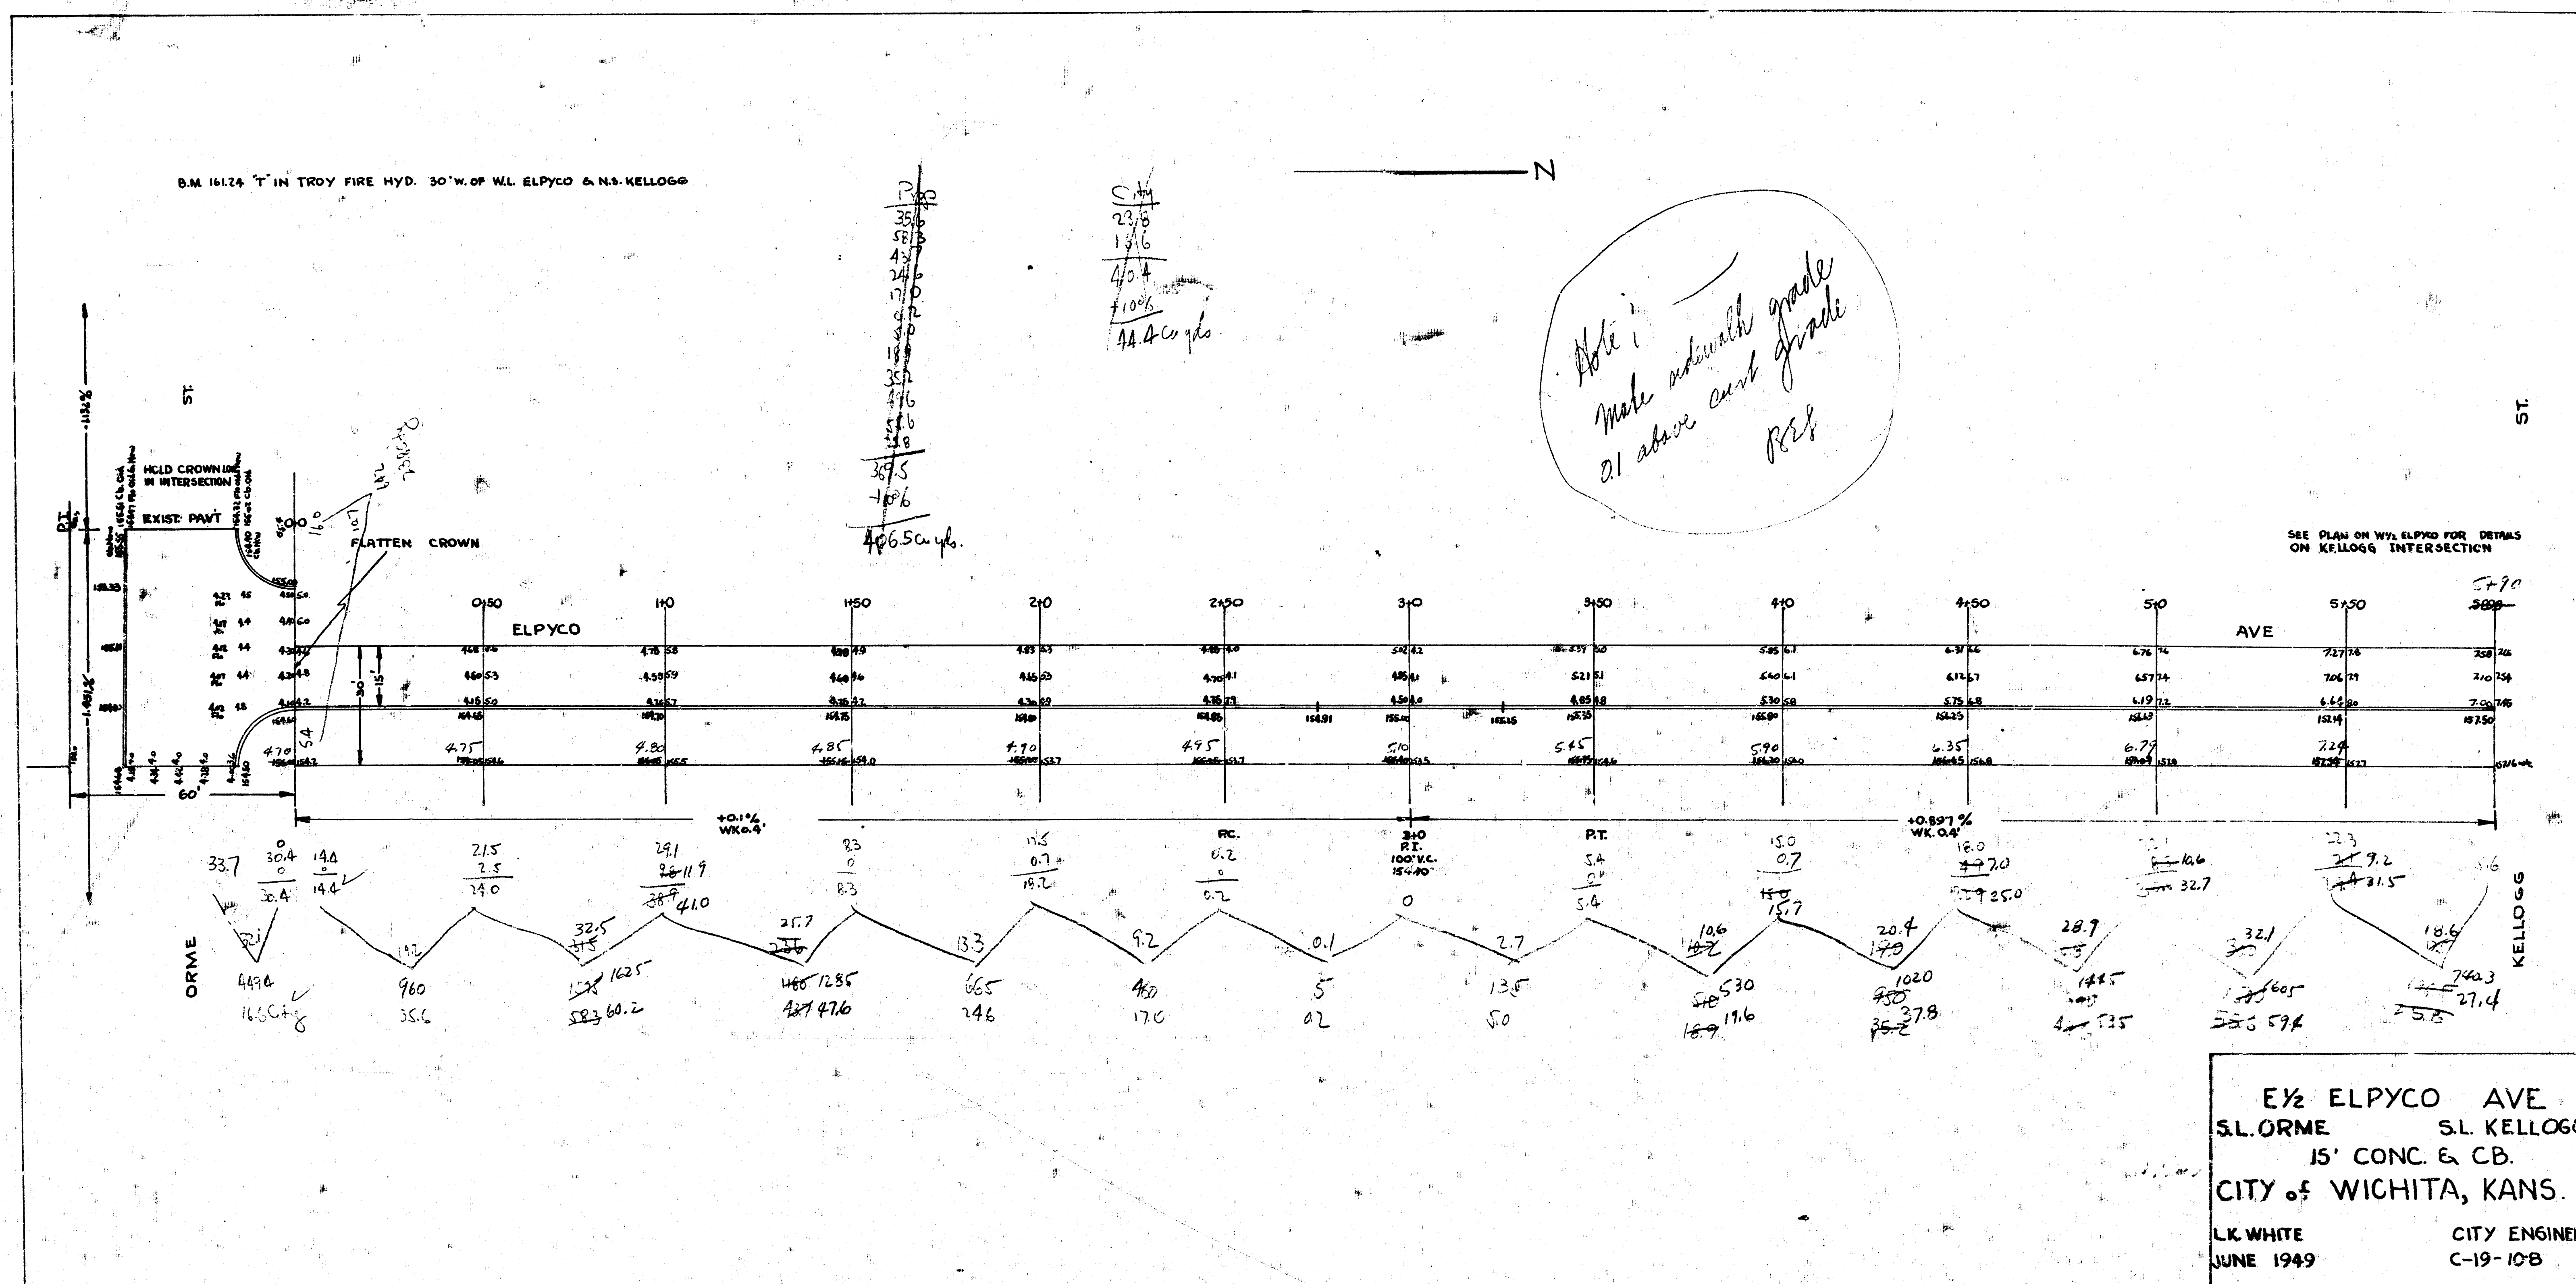

4 12 4 (15)

