

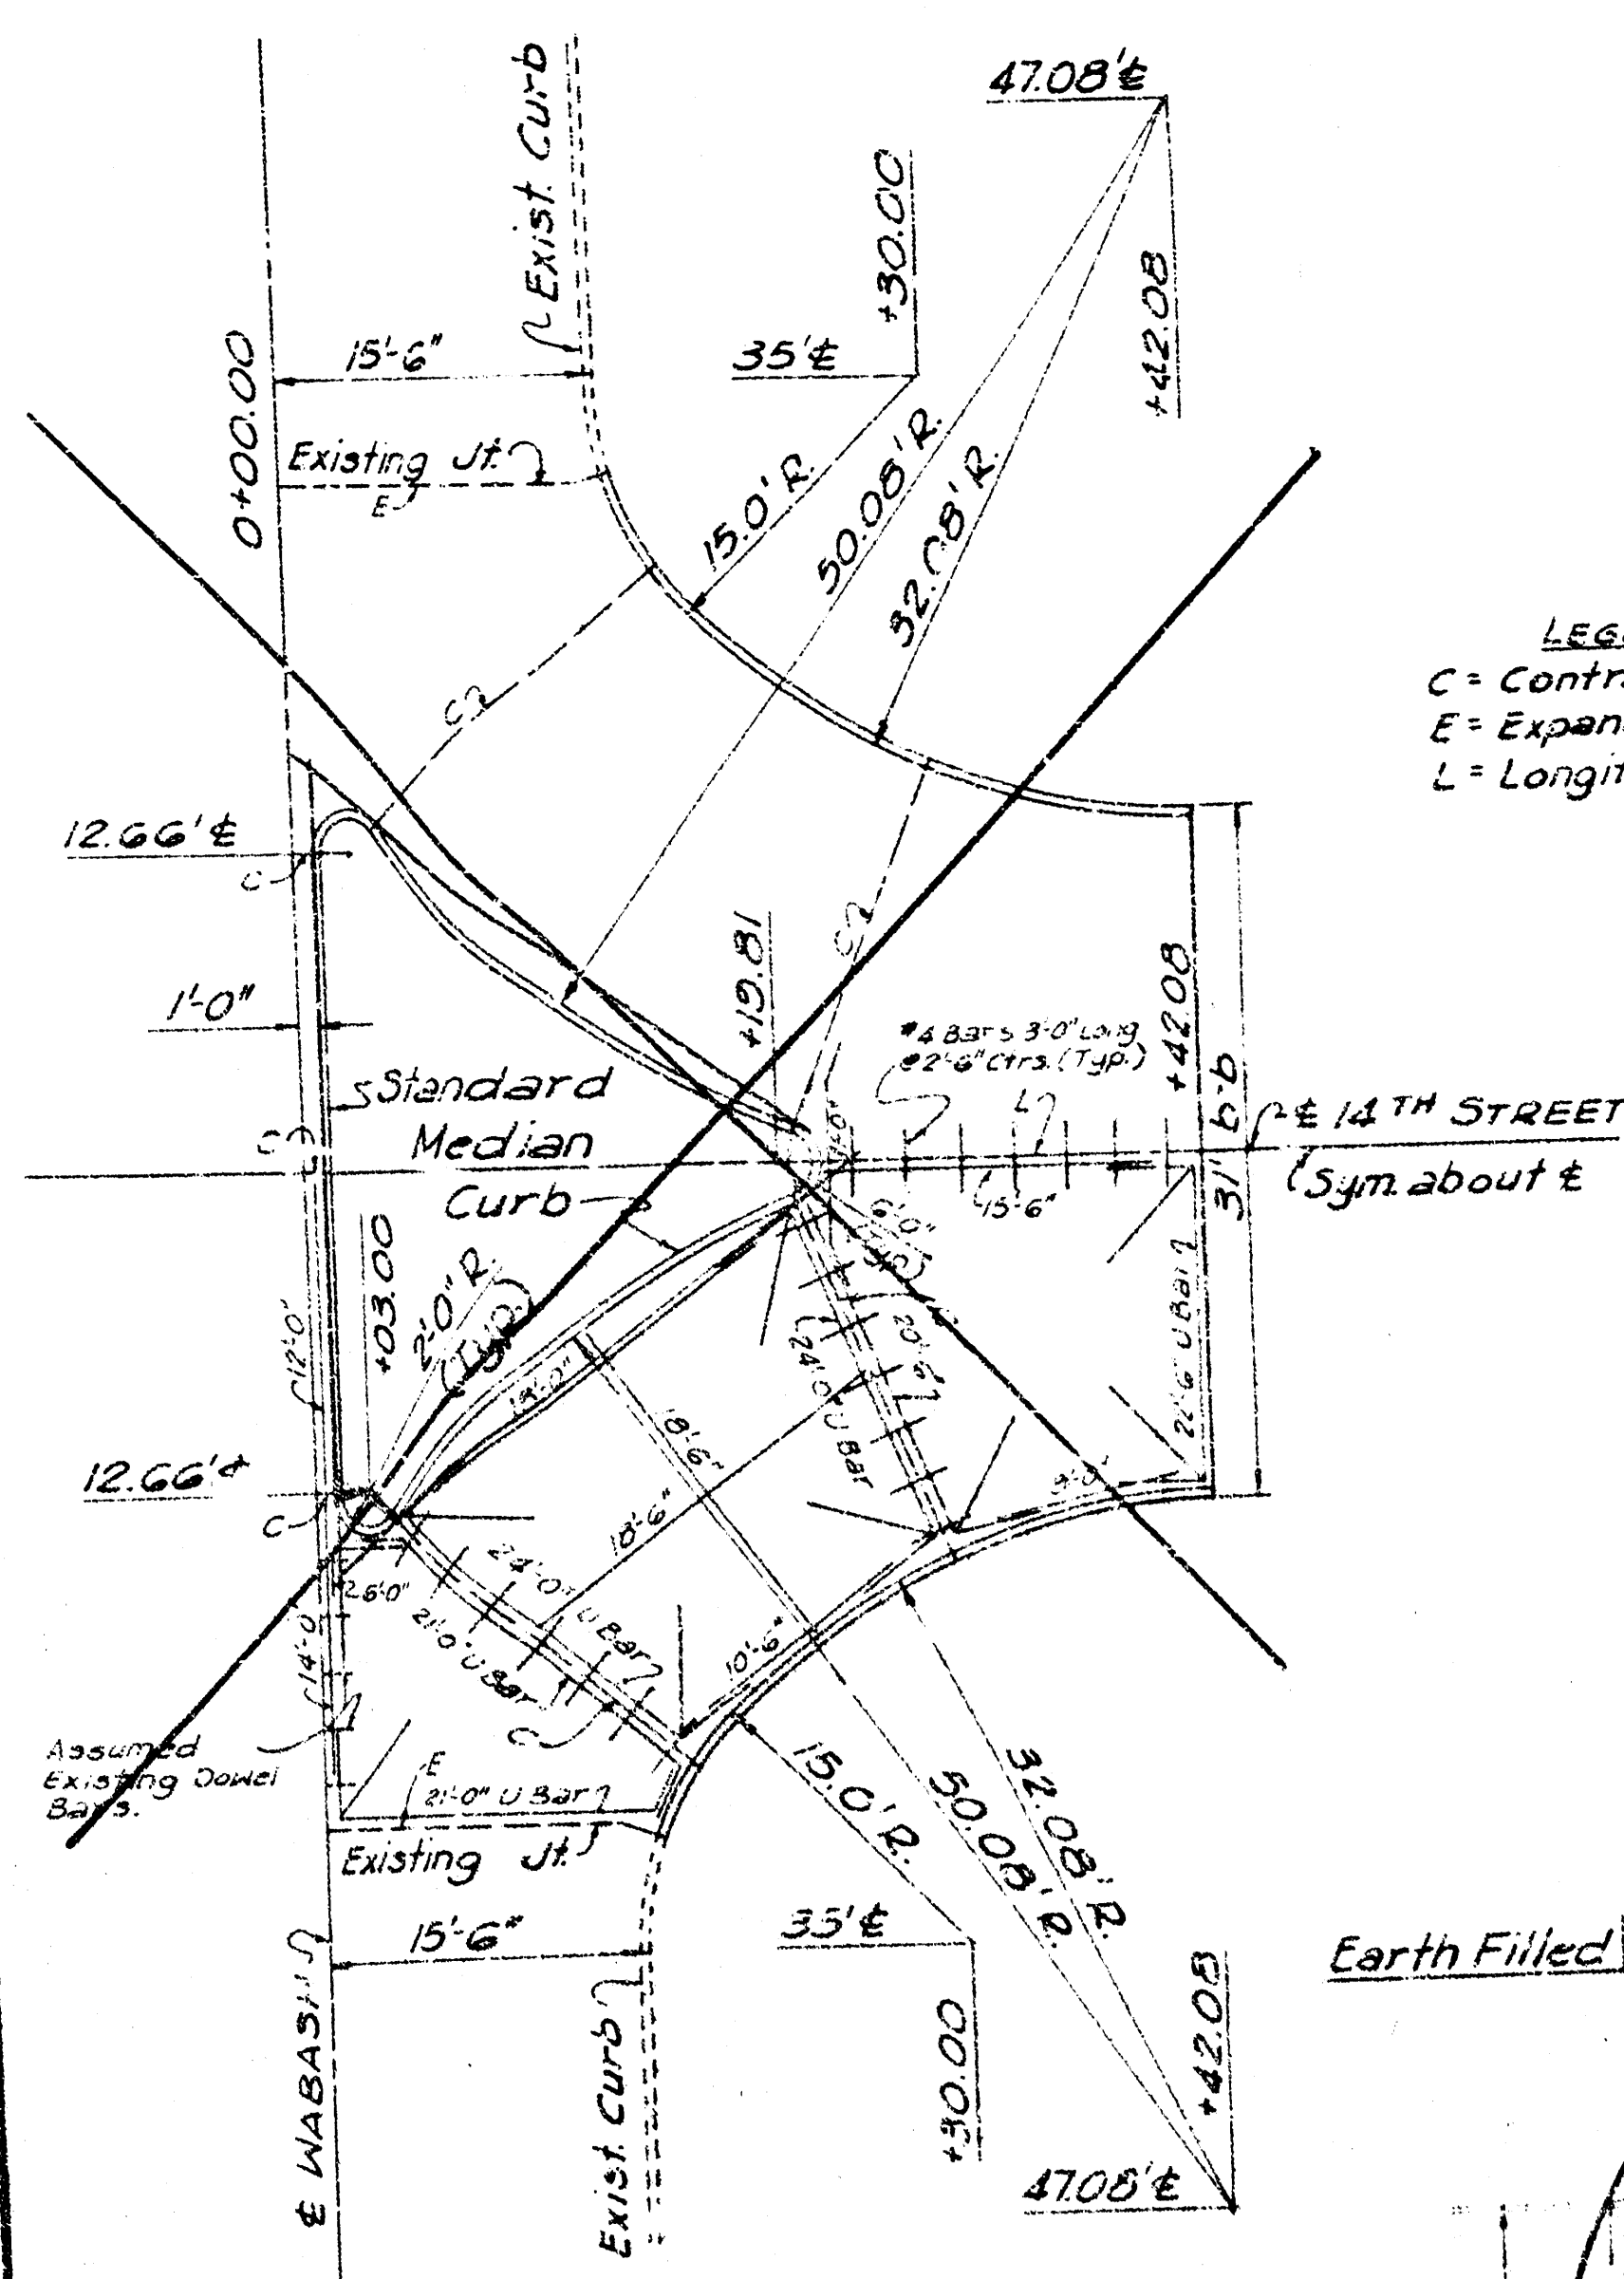
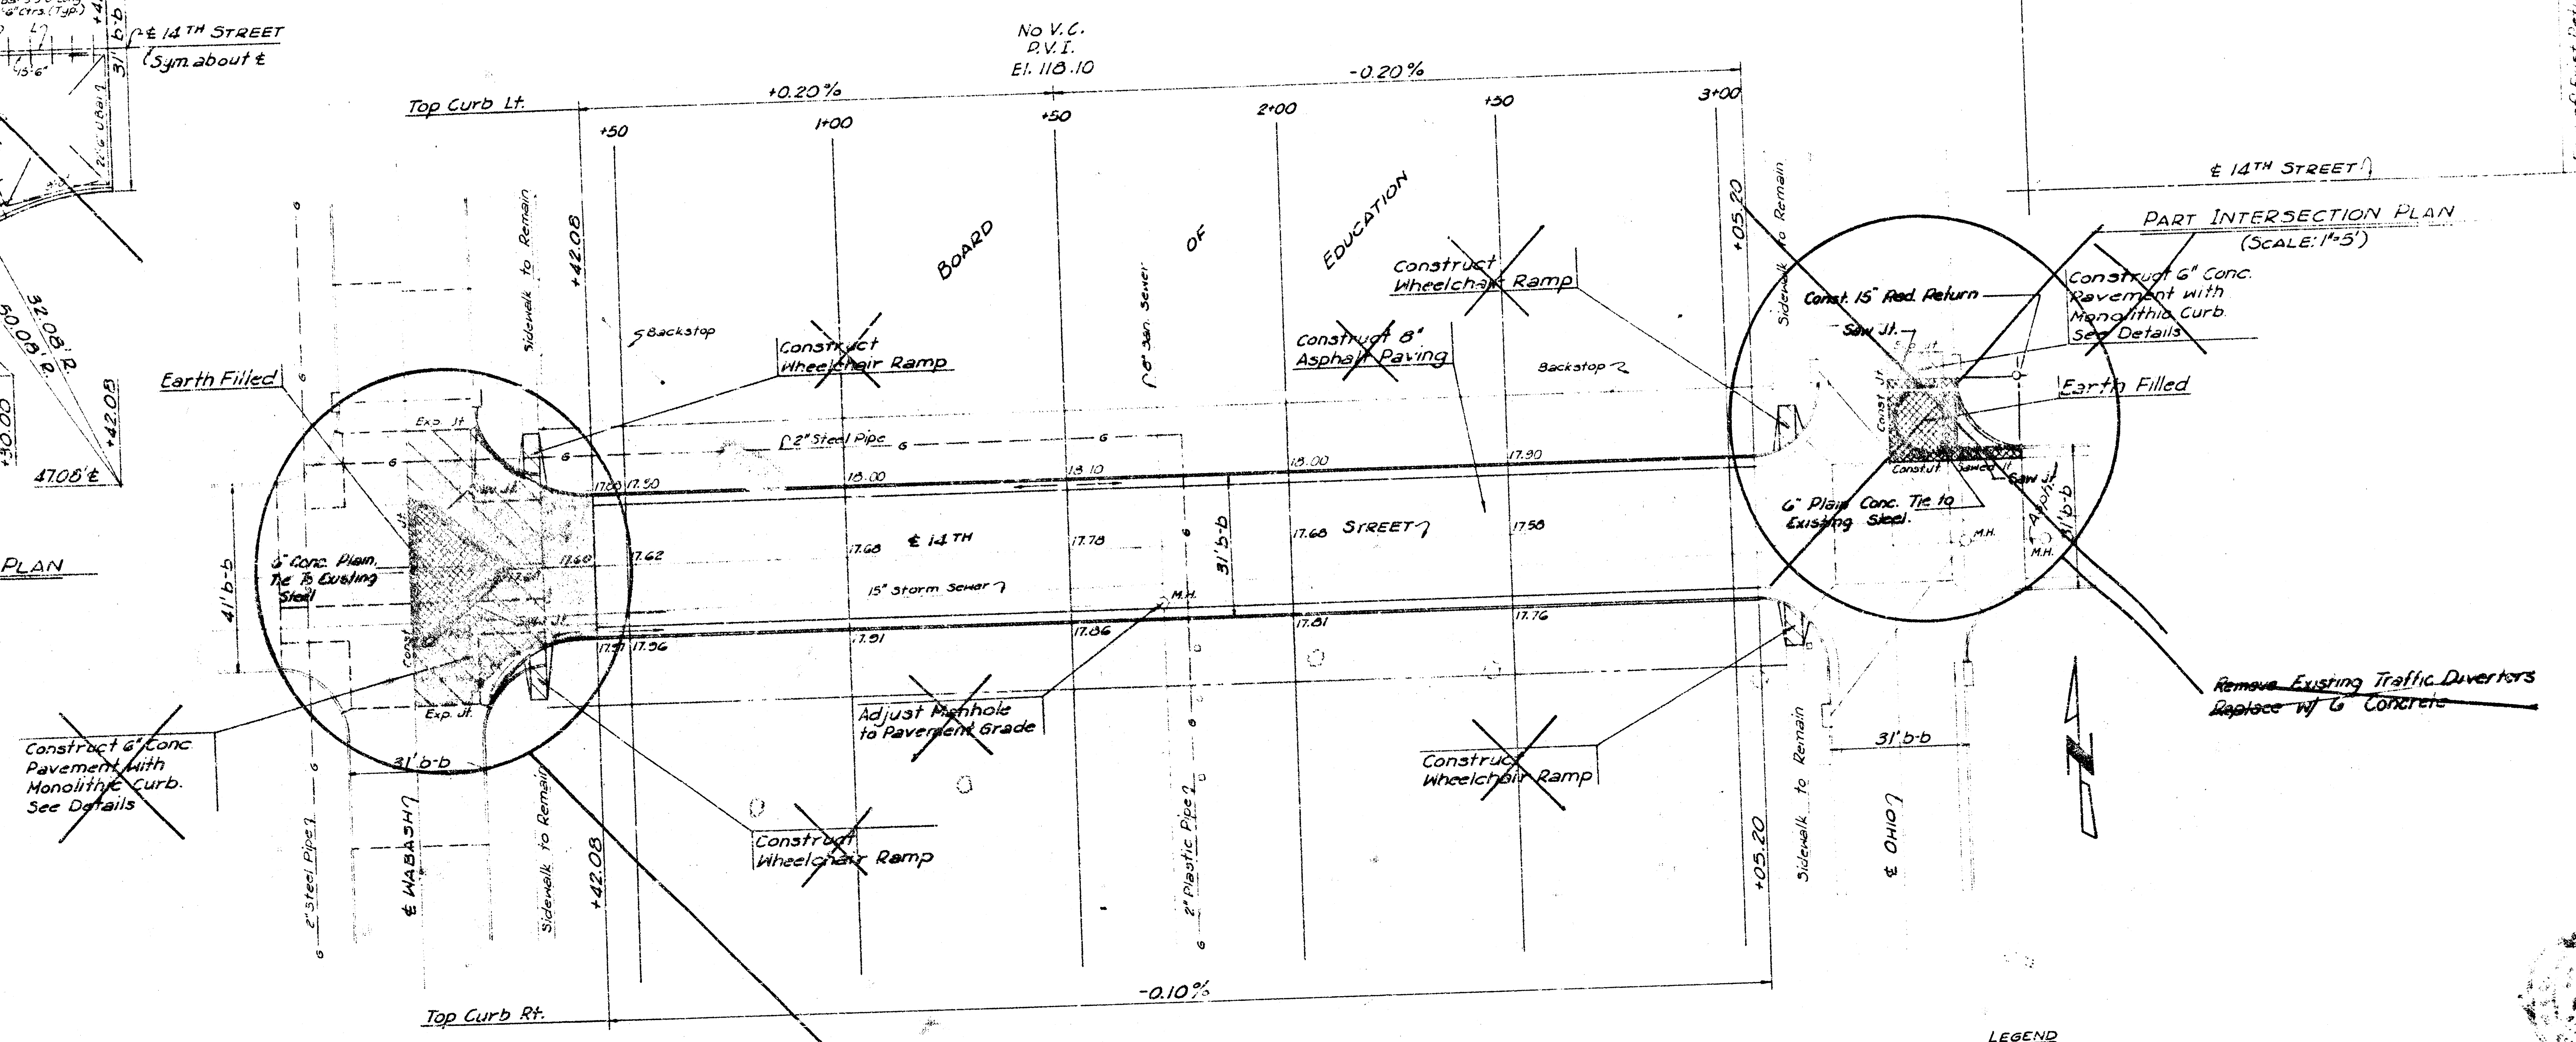


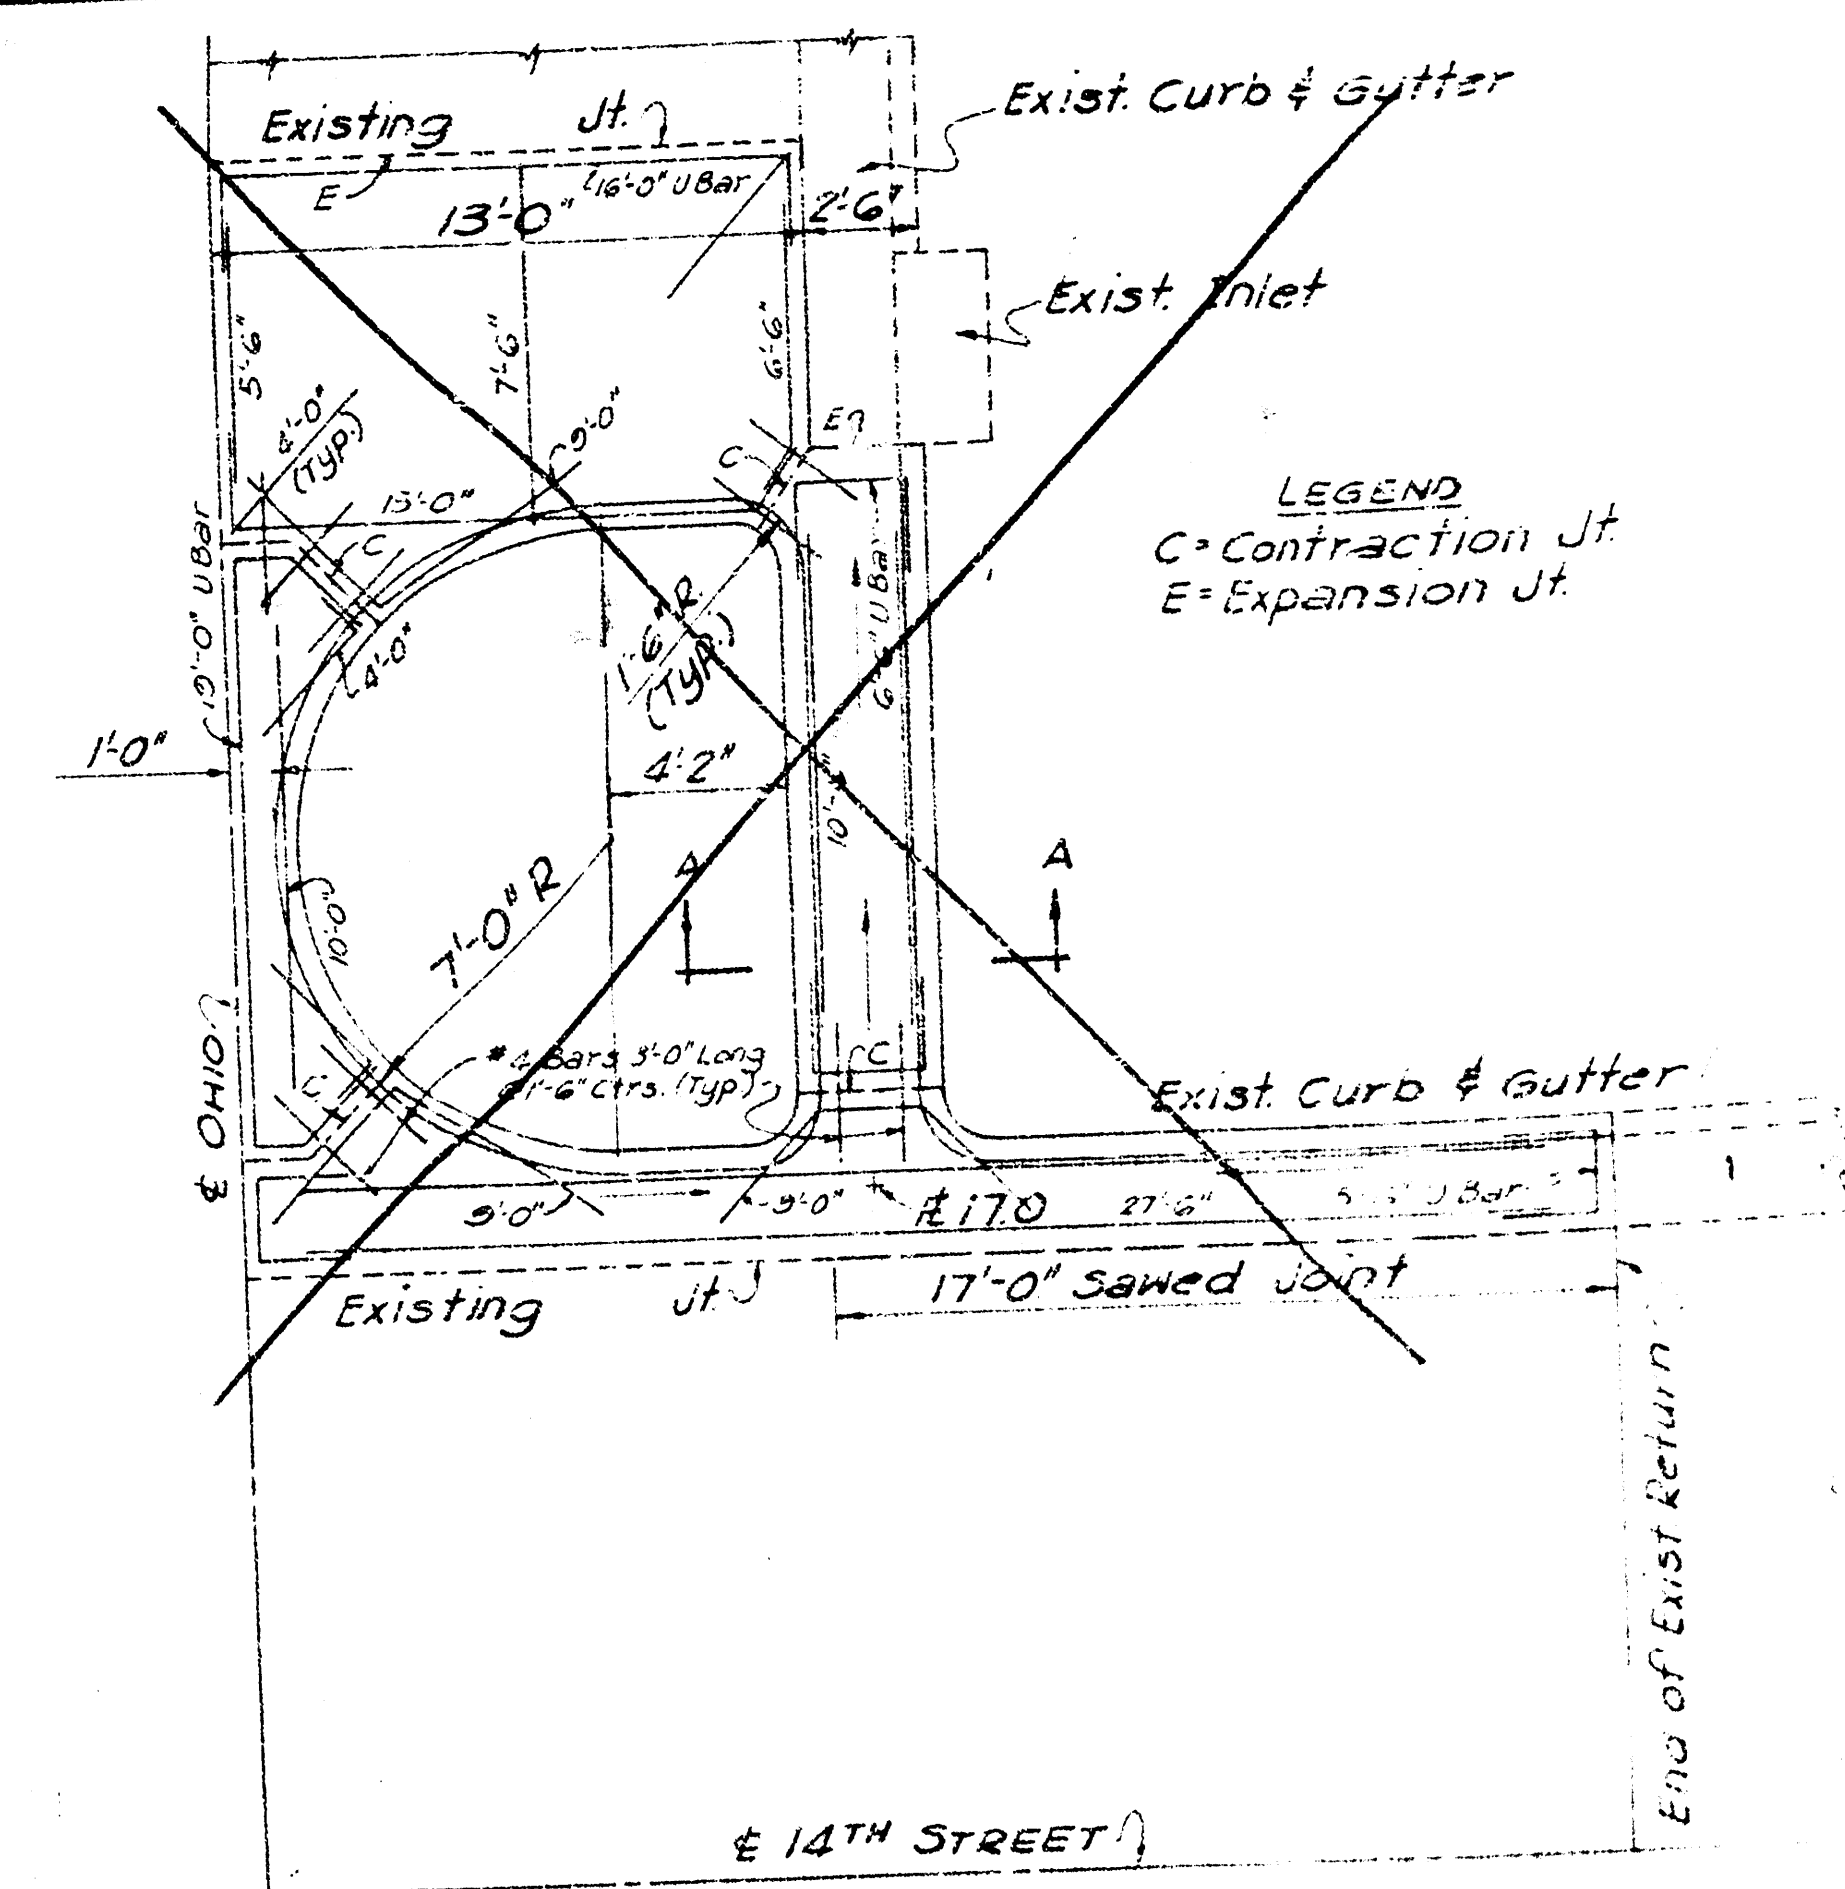




LEGEND
 C = Contraction Jt
 E = Expansion Jt
 L = Longitudinal Key Jt

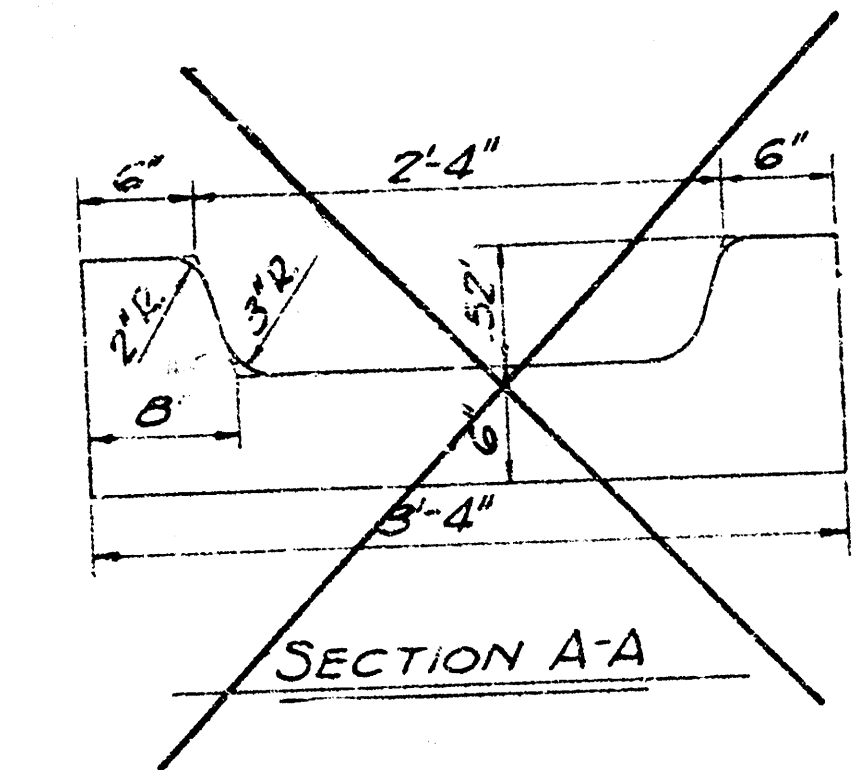

LEGEND
 Pavement Removal
 Sidewalk Removal

NOTE:
 Care shall be exercised to preserve any dowel bars in existing slabs at joints of new pavement to old.

City of Wichita		Dept. of Engineering	
Removal of Traffic Diverters at 14th and Wabash			
Proj. no		815-58-192-50116-430-102-000	
SCALE 1"=20'	DATE	DWG NO.	

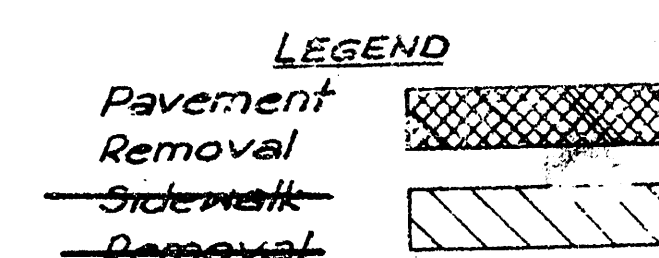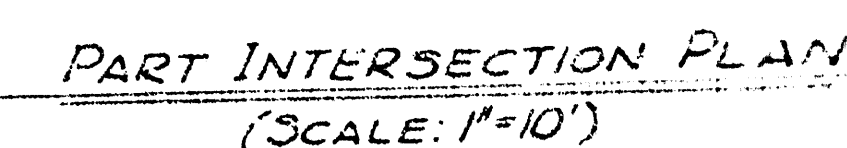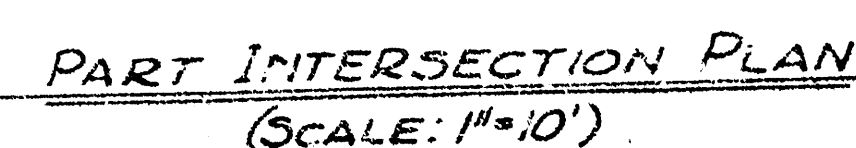

City of Wichita			Dept. of Engineering		
Proj. no.		815-58-192-50116-430-102-000			
SCALE	1"=20'	DATE			DWG. NO.

