

INTERSECTIONS
17 TH. STREET & PARK PLACE
21 ST. STREET & PARK PLACE

PROJECT NO. CII-7




TYPICAL SECTION
NO SCALE


TRANSVERSE & LONGITUDINAL
JOINT DETAIL
NO SCALE

NOTE -

WHERE CURBS IN THE SAME SECTION
ARE AT DIFFERENT ELEVATIONS USE
ELEVATION SHOWN ON PLAN FOR
CONSTRUCTION JOINT.

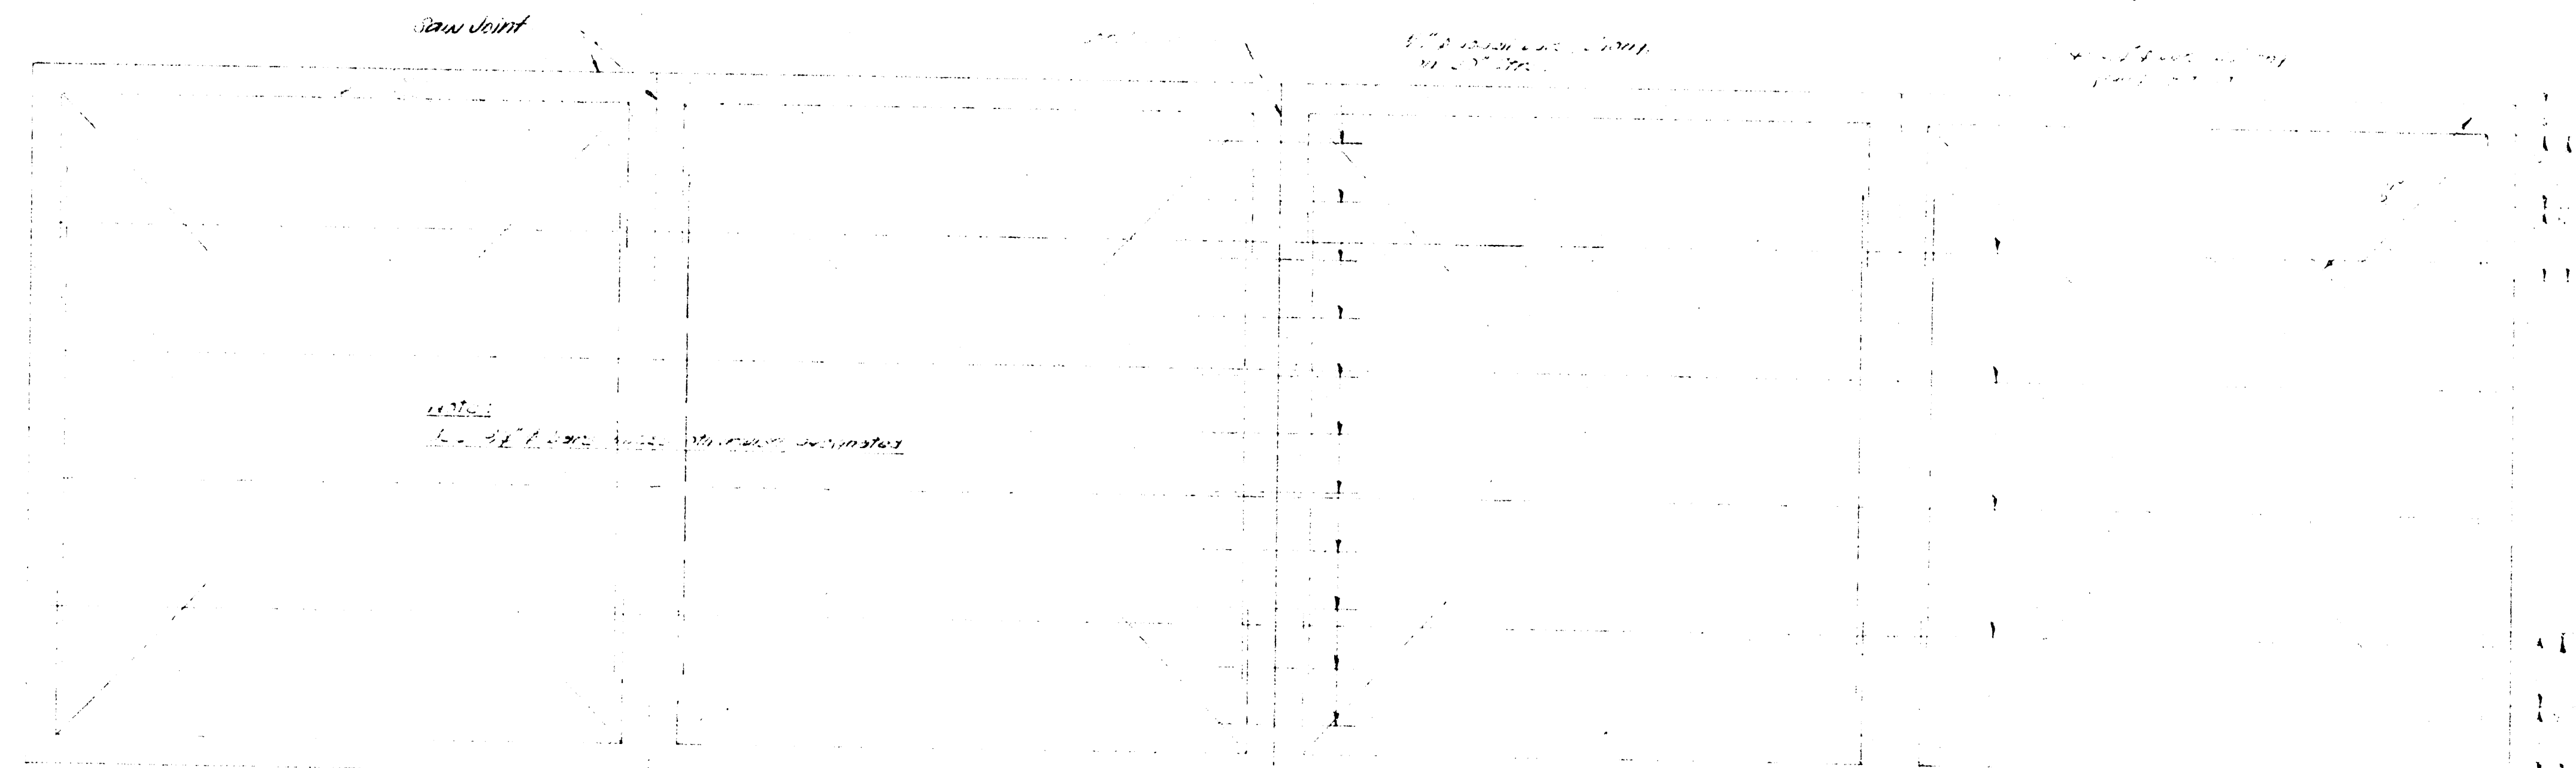

STEEL PATTERN
NO SCALE

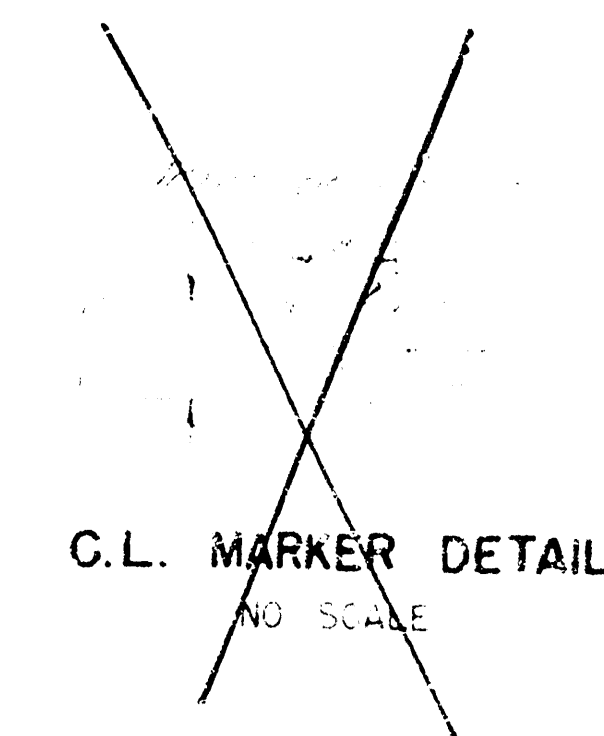

C.L. MARKER DETAIL
NO SCALE

2/8

