


B.M. 152.825 S.E. Cor. Por. House #2269 N. Volusia
B.M. 166.75 S.W. Cor. Porch House #2368 N. Erie

Chaining No. on E. E.

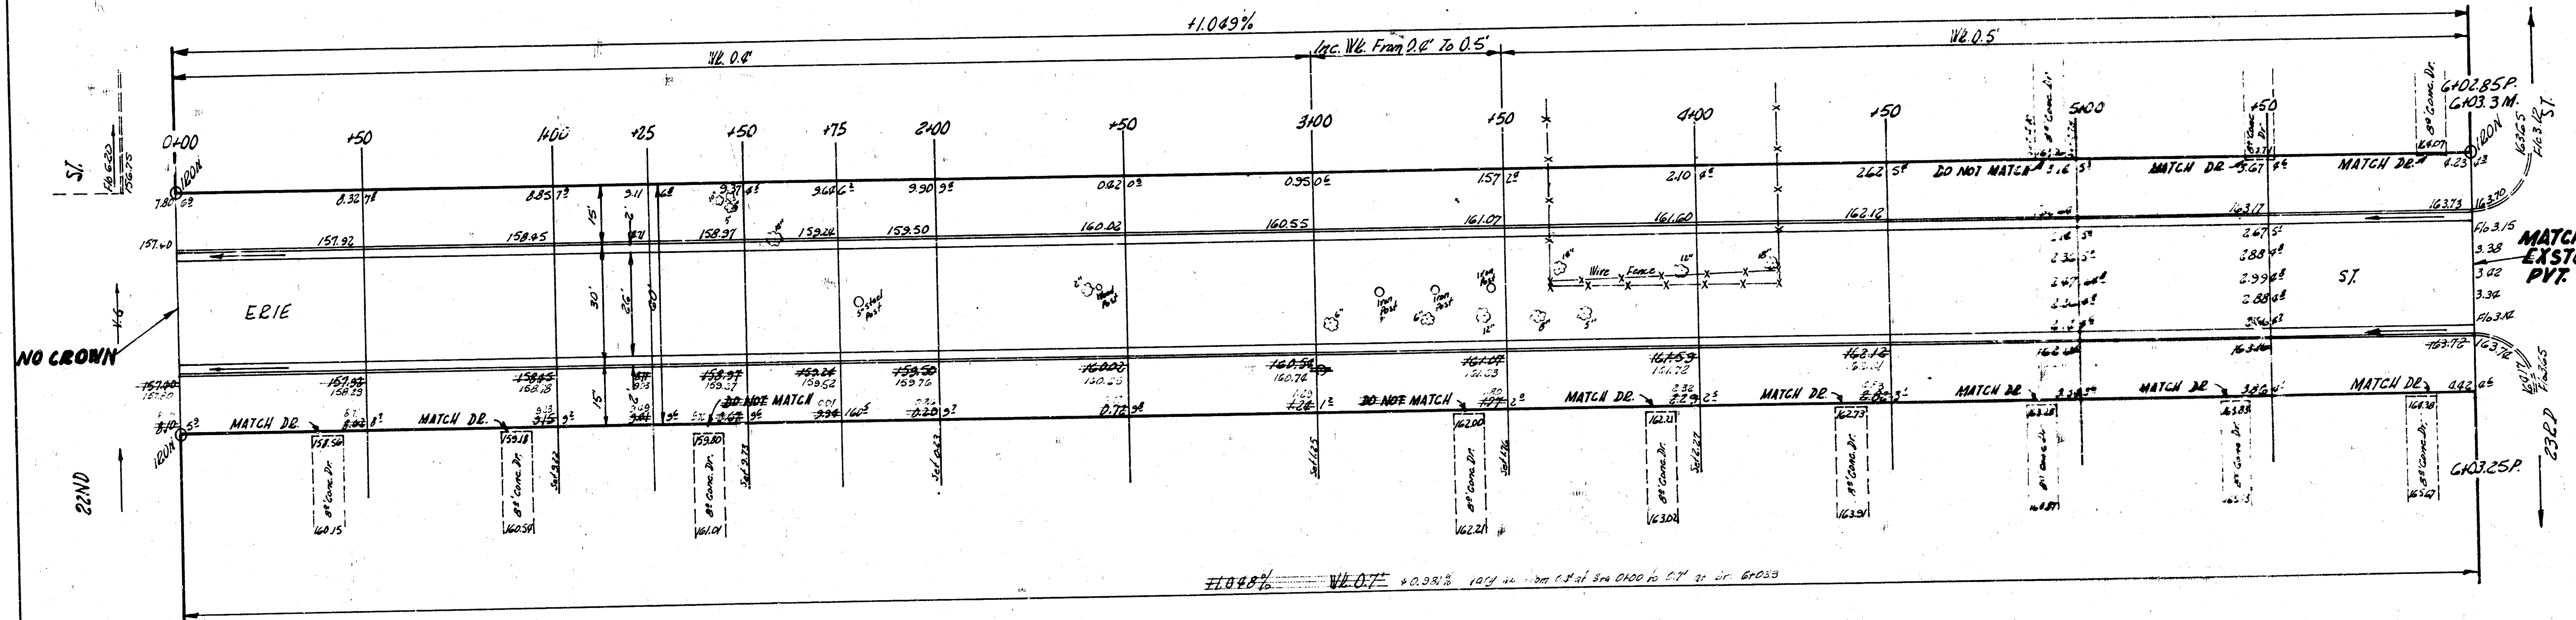

NOTE TO FIELD ENGINEER & CONTRACTOR
Re-cross section to determine amt. of loose
fill to be removed & replaced with sand
in draw at approx. Sta 2+00.

ERIE ST
NL 22ND - 31.23RD
26'-2'-30" AC.
CITY OF WICHITA, KANS.
B.E. SMITH CITY ENGINEER
FEB. 1955 PROJ. NO. C13-83

