

B.M. 126.79 N.E. Cor. Conc. Stop Ho. 1127 N. Estelle

B.M. 126.79 N.E. Cor. Conc. Stop Ho. 1127 N. Estelle
B.M. 131.06 "W" in Kee/Gr. Ctr. W.K. @ Eob. N.E. Cor. Estelle & 13th

Note:
Begin construction
Project No. C19-129

TIES TO IRON EOP ESTELLE & FAIRMOUNT PARK ADDRESS
1. 2136' W to "X" 0.4' W of Pnt. of W.K.
2. 3280' S.W. to "X" 0.4' W of Pnt. of W.K.

TIES TO IRON E ESTELLE & 11th
1. 46.05' N.E. to face of 12" Elm
2. 37.40' N.W. to "F" in F.C. Kensler Ctr. W.K. N.
3. 38.25' S.W. to "F" in F.C. Kensler Ctr. W.K. S.

Proposed

6.7
42.0
44.9
57.1
47.8
43.2
376.3
+107.0
371.3

Grand Total

Property

371.7
1003.3
1544.8
2740.0

ESTELLE AVE.

SL. FAIRMOUNT PARK ADD. to SL. 13th


30' conc. f. cb.

CITY of WICHITA, KANSAS


L.K. WHITE CITY ENGINEER

JULY 1949

PROJ. NO. C19-129

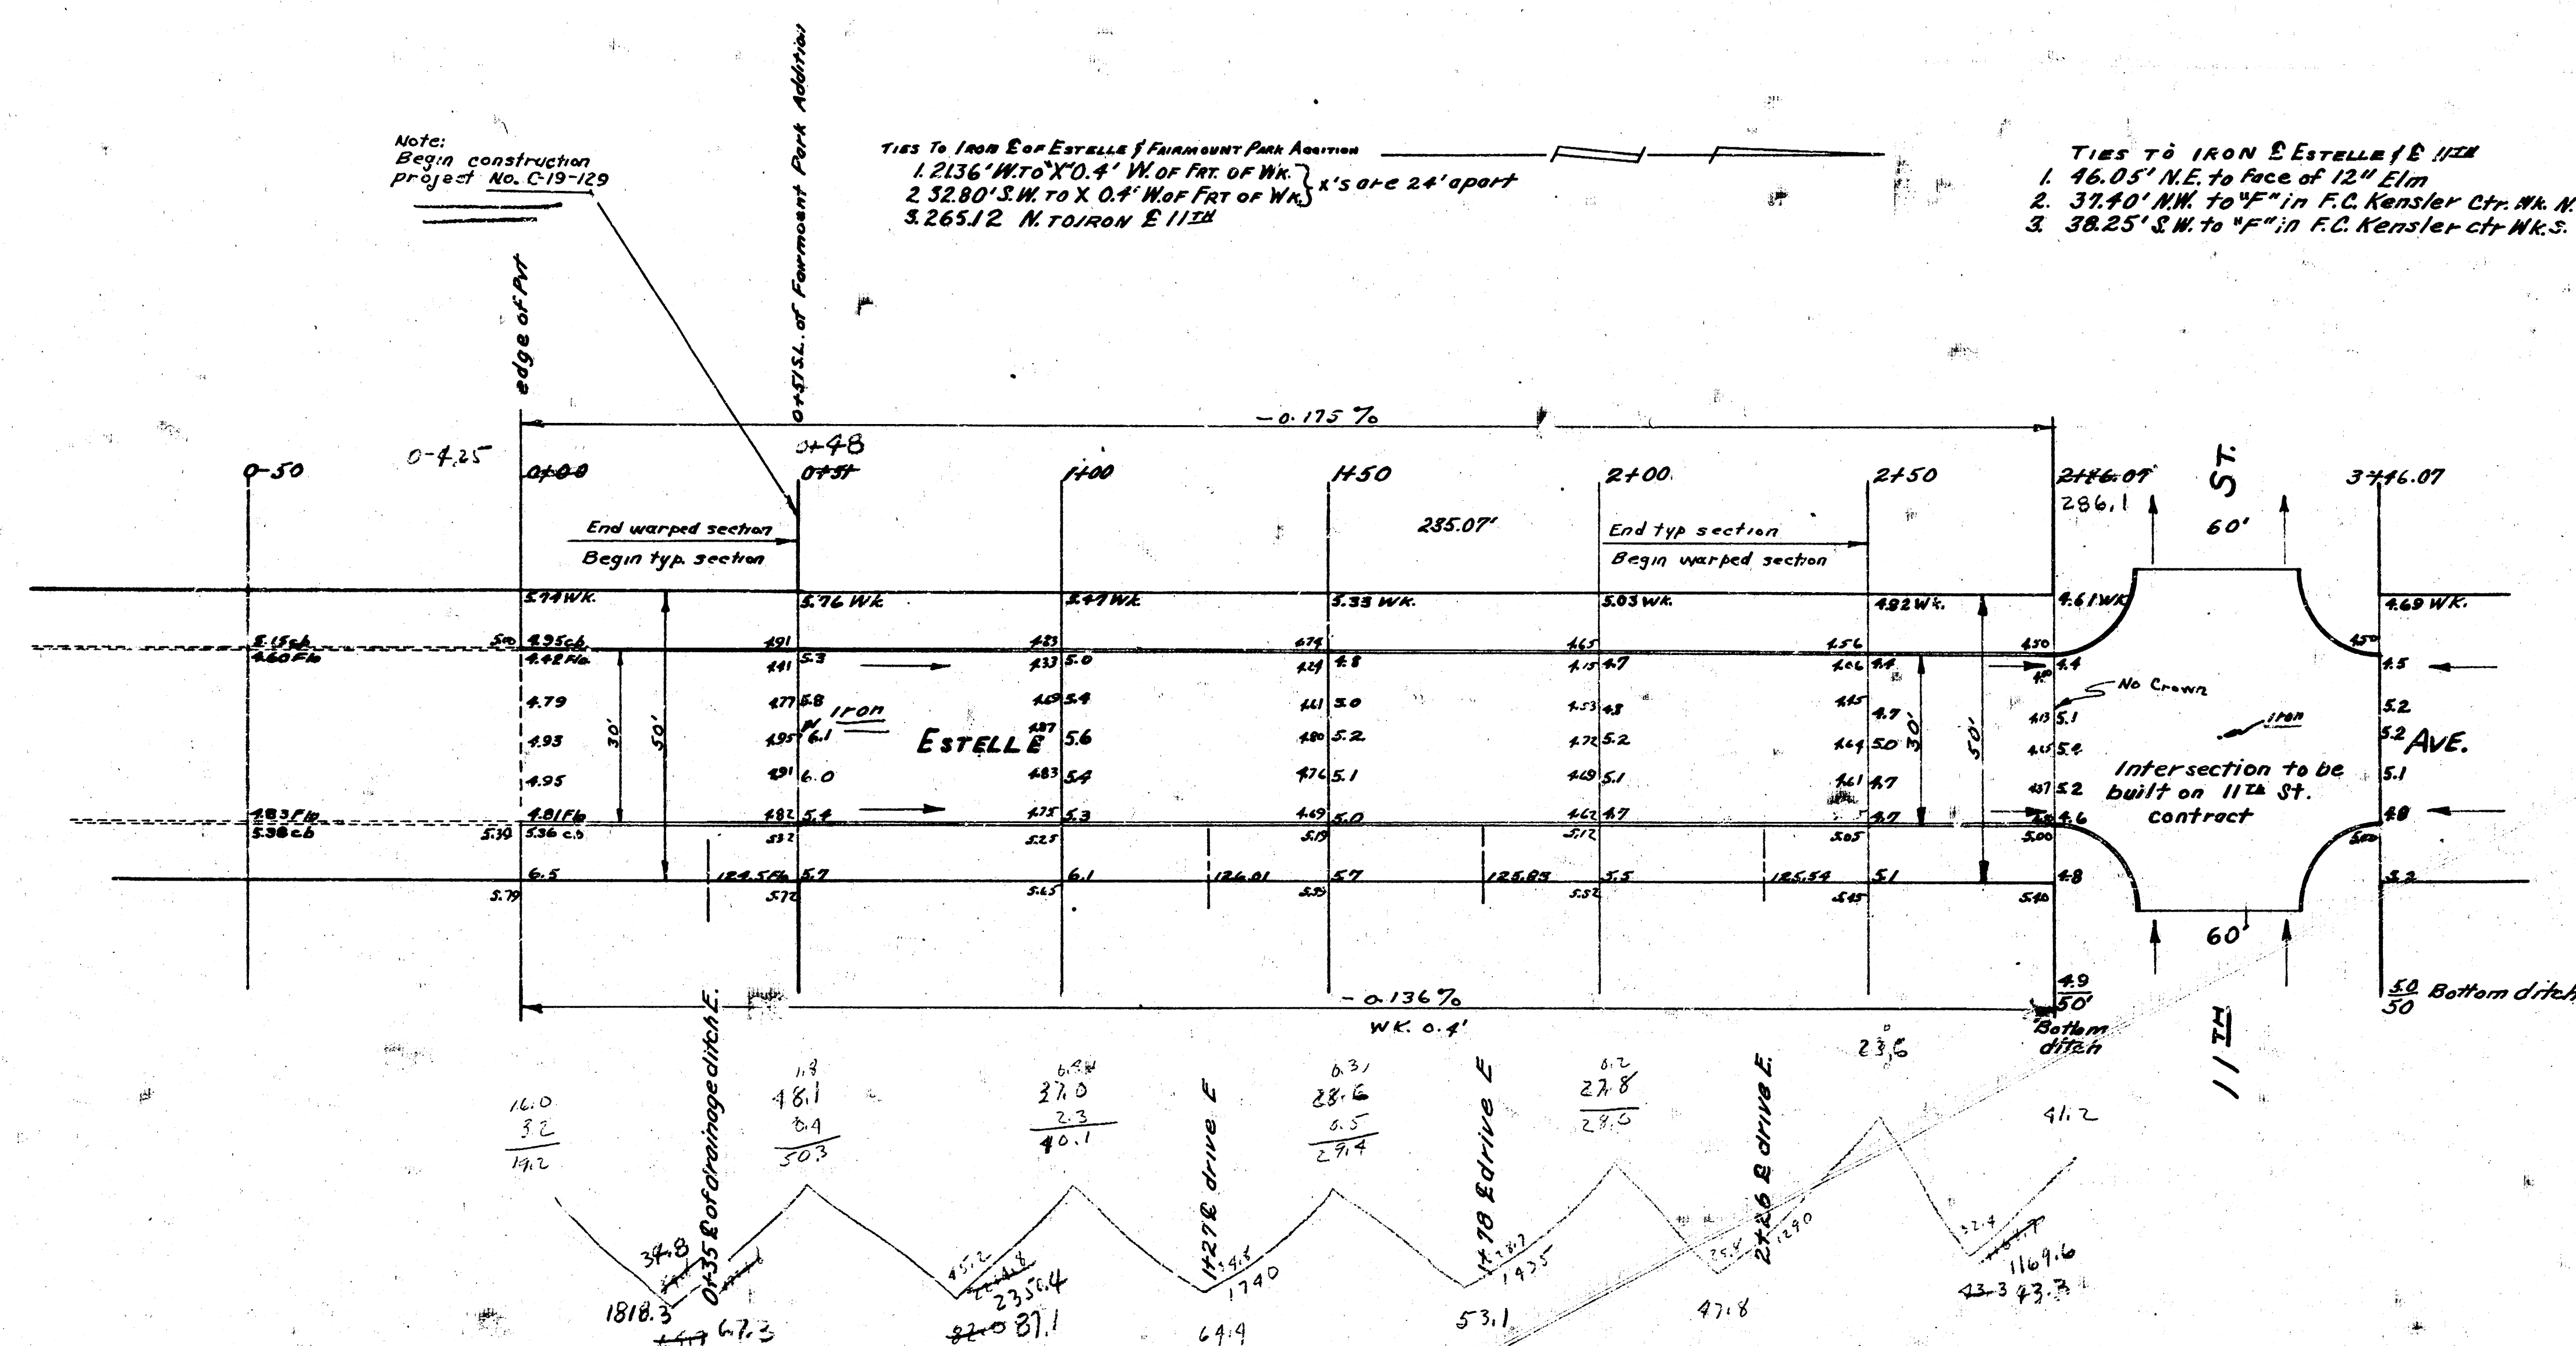

12-2-53

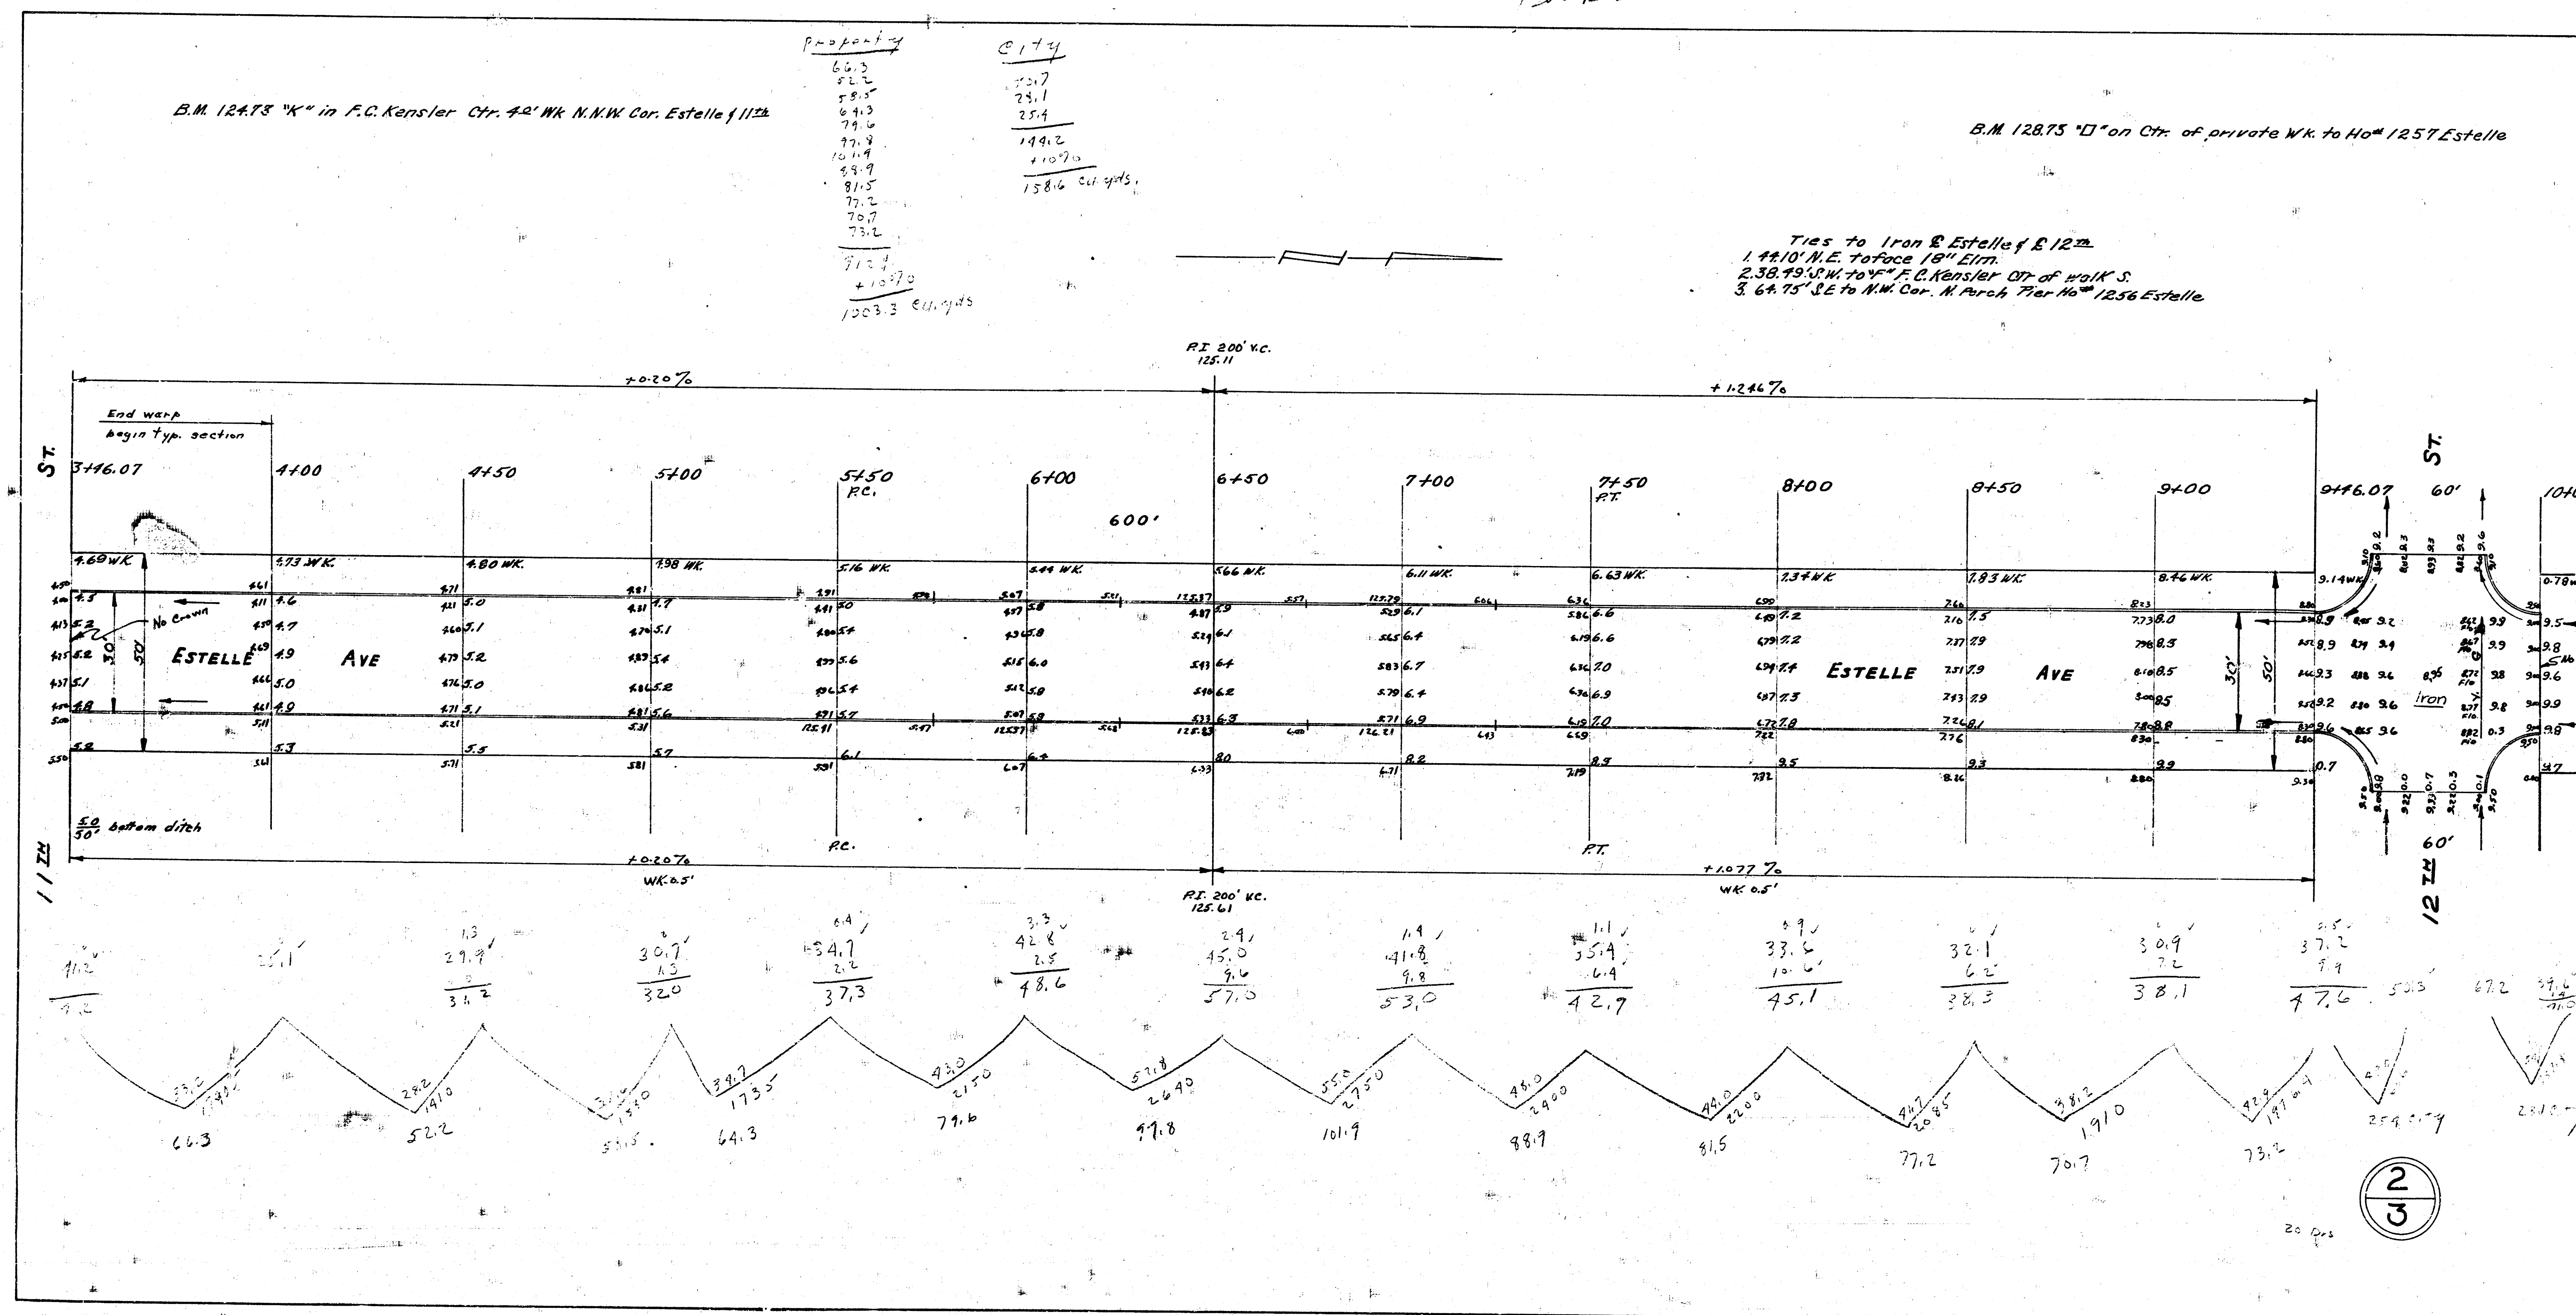


percentage

$$\begin{array}{r} 67.2 \\ 92.6 \\ 120.9 \\ 121.9 \\ 95.4 \\ 77.8 \\ 100.2 \\ 152.9 \\ 174.9 \\ 153.9 \\ 120.9 \\ \hline 77.3 \\ \hline 1024.4 \\ + 107.0 \\ \hline 1131.4 \end{array}$$

1131.4 @ 4. yds.

B.M. 131.06 "K" in Keeler Ctr. Wk @ E. cb. N.E. Cor. Estelle f 13th

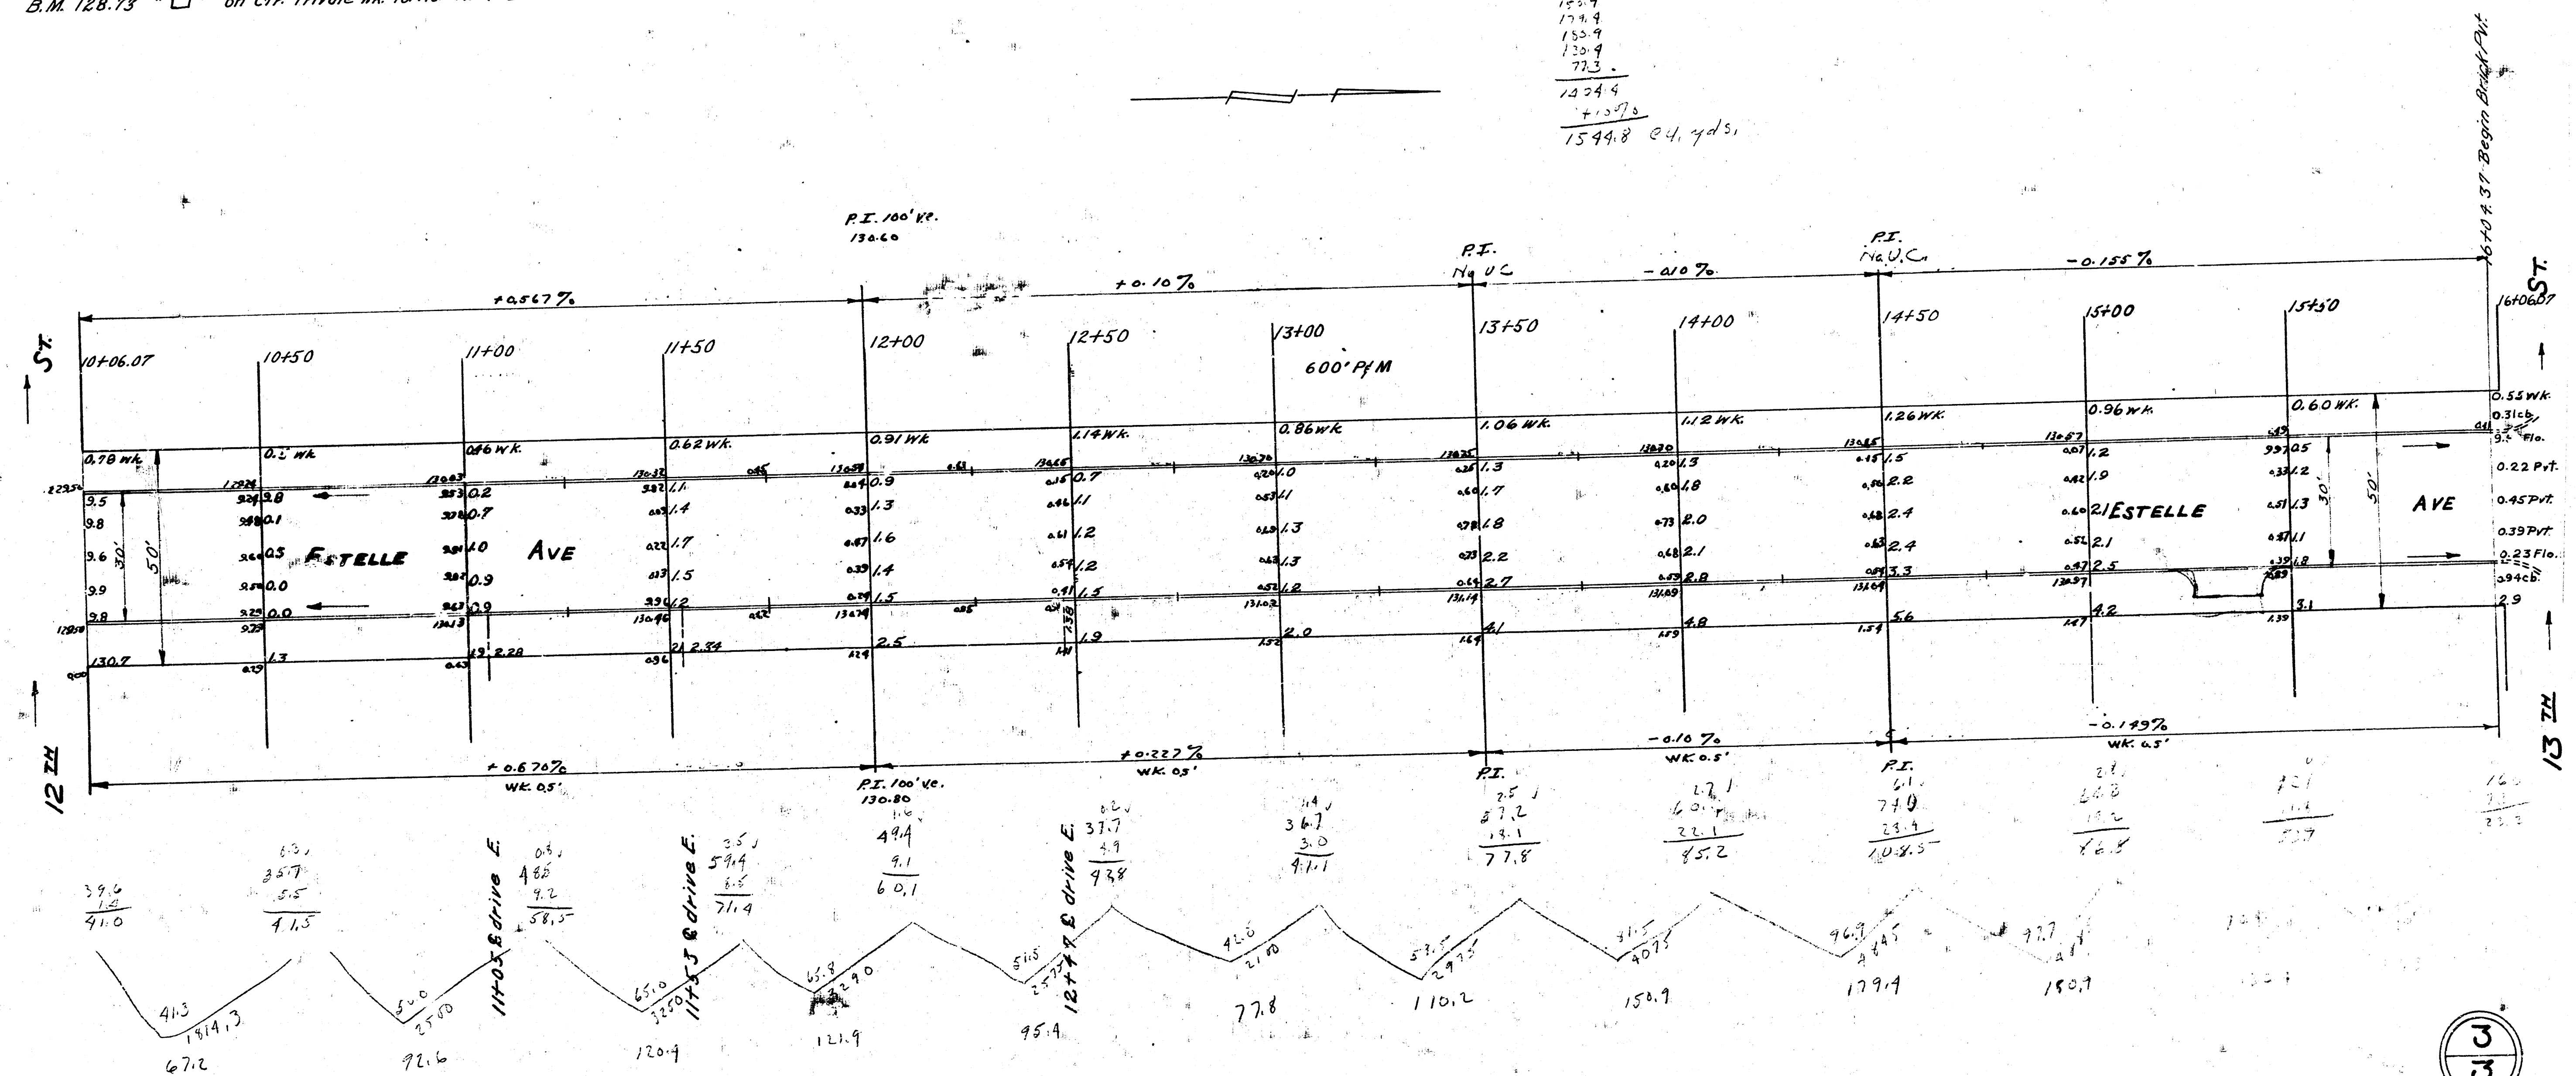

