CONCRETE ALLEY BETWEEN WASHINGTON & WABASH

FROM 200' S. OF S.L. OF CENTRAL TO S.L. CENTRAL

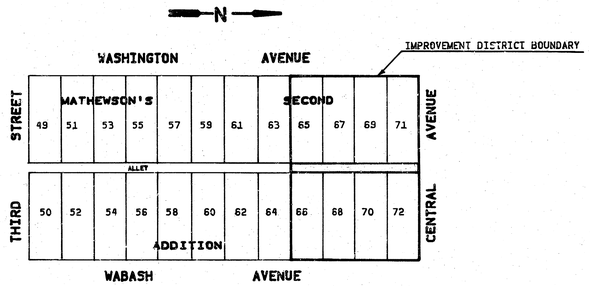

JAMES M. THOMPSON
LICENSED
6262
KANSAS
PROFESSIONAL ENGINEER

ALLEY BETWEEN WASHINGTON & WABASH
FROM 200' S. OF S.L. CENTRAL TO S.L. CENTRAL

POE & ASSOCIATES
CONSULTING ENGINEERS

PROJECT NO.
472-76-245-81340-000-000-001

CITY OF WICHITA
M.E. LINDEBAK-CITY ENGINEER

ENGINEER: J.M.T.	CHECKED BY:
DRAWN BY: W.P.F.	SCALE: 1"=20'
DATE: MAY, 1984	SHEET 1 OF 2

BM #1 CHISELED "□" ON CURB @ SE. COR. OF CENTRAL & WASHINGTON
INTERSECTION 42' RT. ℄ STA. 14+85 ELEV. 111.32
BM #9 SPIKE STEP S. FACE OF POWER POLE WEST SIDE OF ALLEY
NORTH SIDE CENTRAL ELEV. 112.62

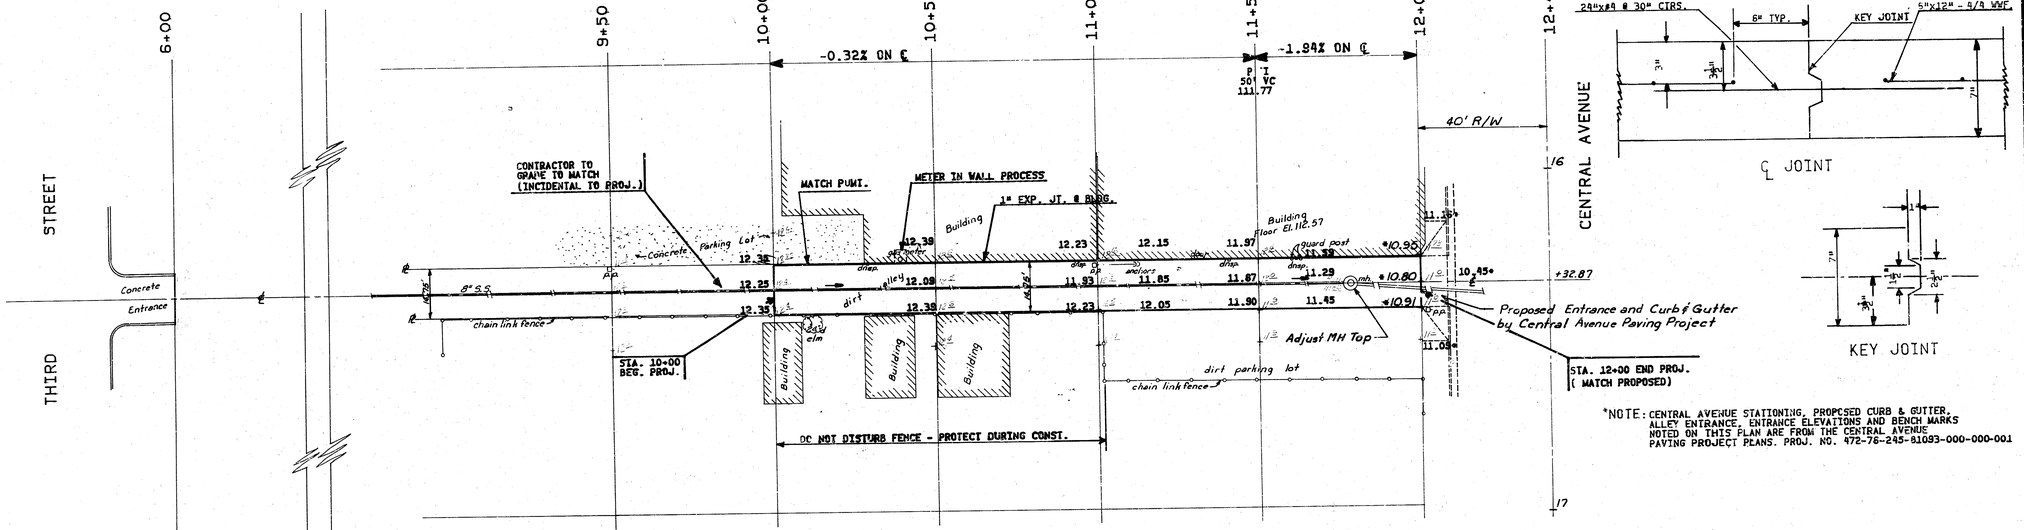
N
6+00
9+50
10+00
10+50
11+00
11+50
12+00
12+40
-0.32% ON ℄
-1.94% ON ℄
50' VC
111.77
40' R/W
STREET
THIRD
CENTRAL AVENUE
CONTRACTOR TO GRADE TO MATCH (INCIDENTAL TO PROJ.)
MATCH PVMT.
METER IN WALL PROCESS
1" EXP. JT. @ BLDG.
Building
Concrete
Parking Lot
Entrance
dirt
chain link fence
STA. 10+00 BEG. PROJ.
DO NOT DISTURB FENCE - PROTECT DURING CONST.
Building floor El. 112.57
guard post
Adjust MH Top
dirt parking lot
Proposed Entrance and Curb & Gutter by Central Avenue Paving Project
STA. 12+00 END PROJ. (MATCH PROPOSED)
12.38
12.25
12.09
12.35
12.23
12.15
11.97
11.93
11.85
11.67
12.29
12.05
11.90
11.45
11.39
10.95
10.80
10.45
10.91
11.05
+32.87
8" S.S.
dmp.
dmp. & pp
anchors
pp
pvmt.
