




Scale 1" = 10'

Excavation - 9.4 cu yds
Comp Fill - 33.5 cu yds

DERBY
SERVICE



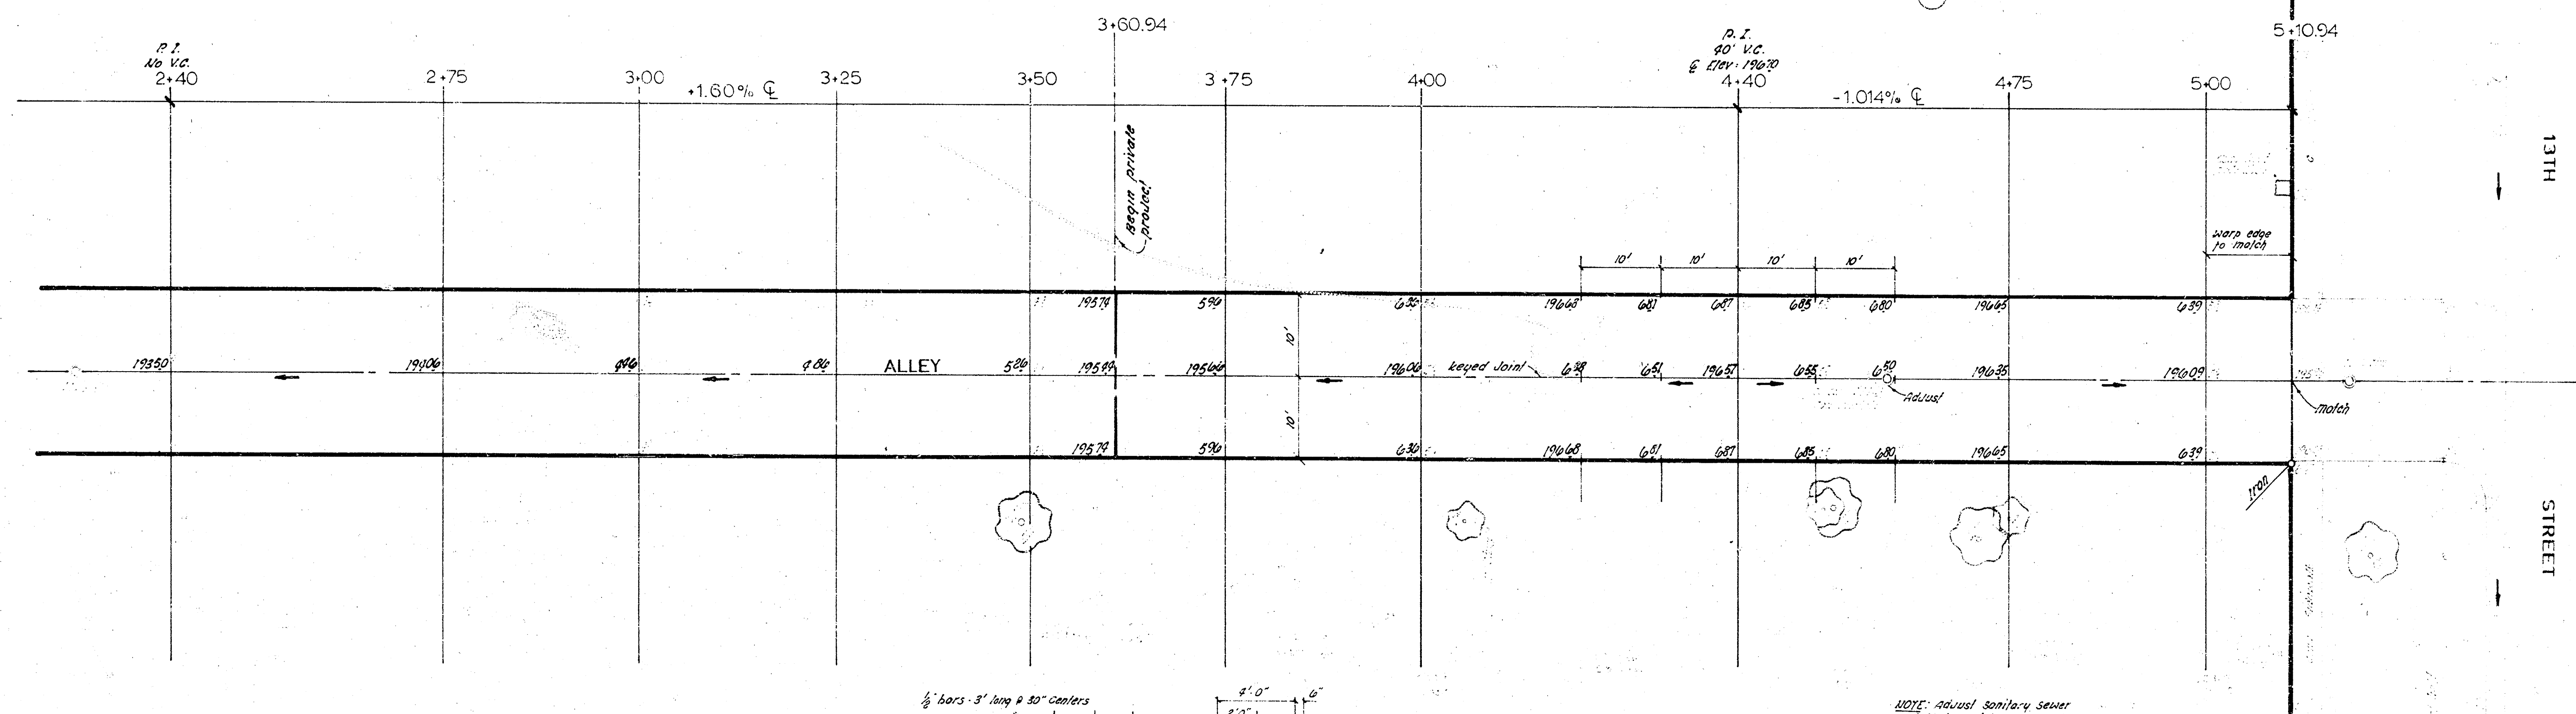

NOTE: Adjust Sanitary Sewer
manhole to match new construction.

ALLEY Bet Woodlawn and Stratford.
S.L. 13th St. to 150' South S.L. 13th St.
CITY OF WICHITA, KANSAS
20'-7" Concrete

B.E. SMITH City Engineer

Date March 1971 Private Project








DERBY
SERVICE



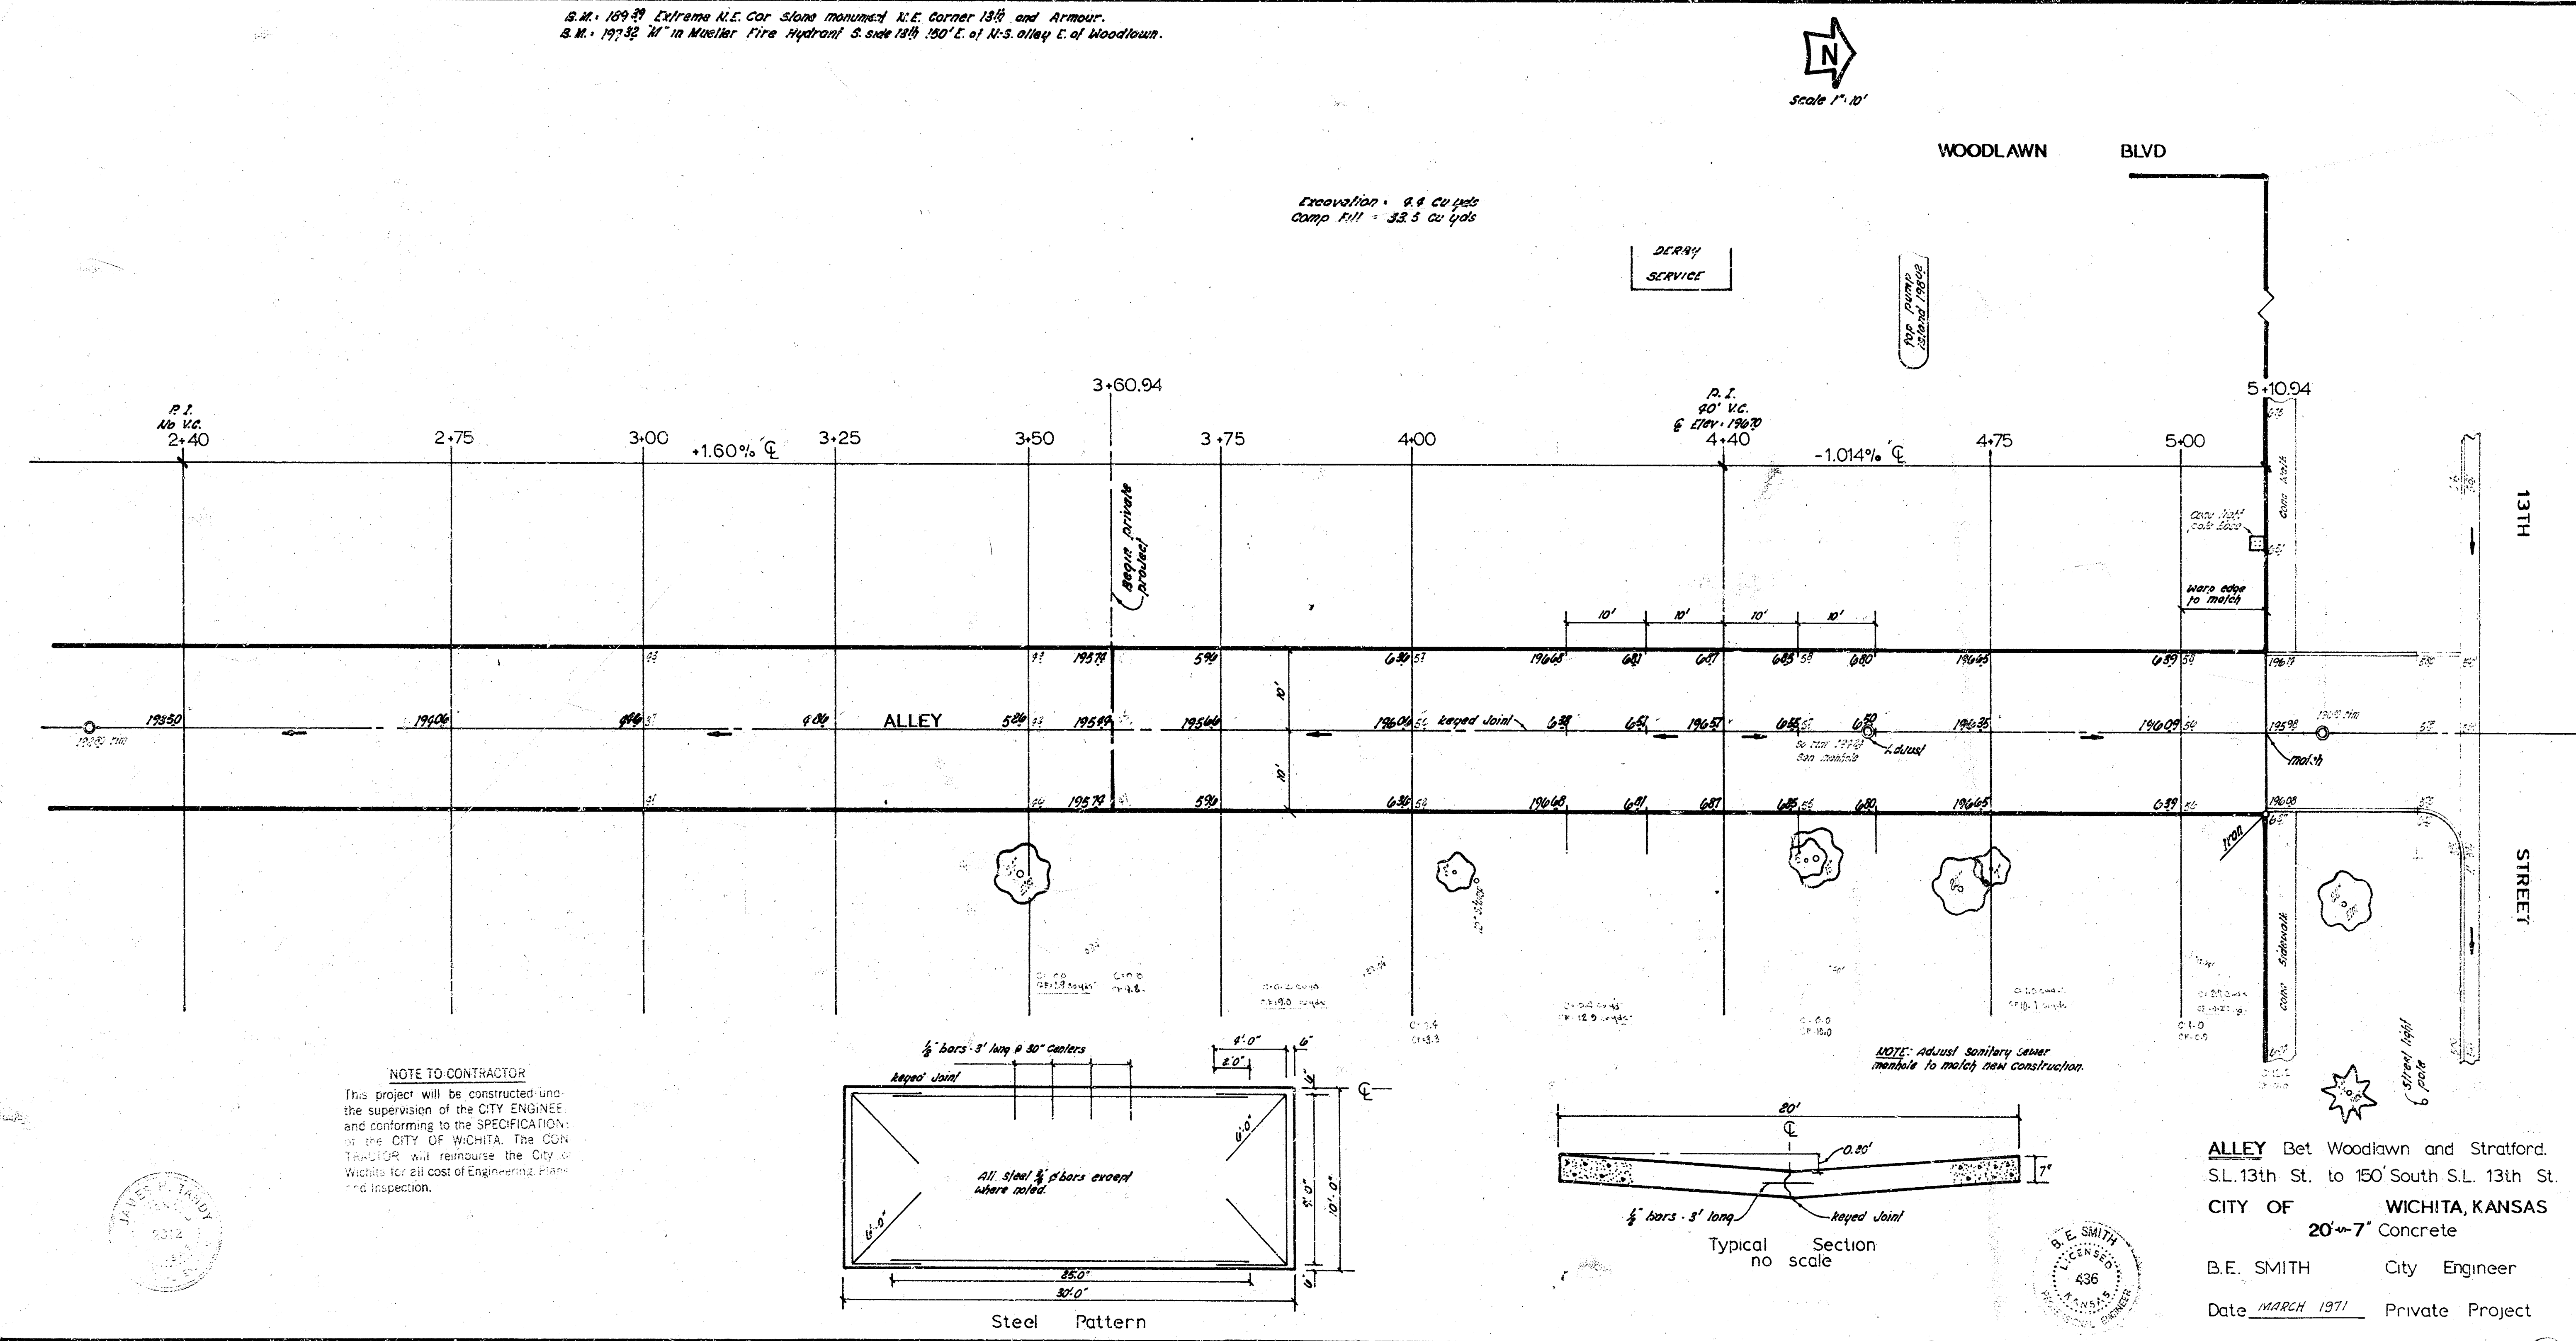

NOTE TO CONTRACTOR
This project will be constructed under the supervision of the CITY ENGINEER and conforming to the SPECIFICATION of the CITY OF WICHITA. The CONTRACTOR will reimburse the City of Wichita for all cost of Engineering, Plans and Inspection.

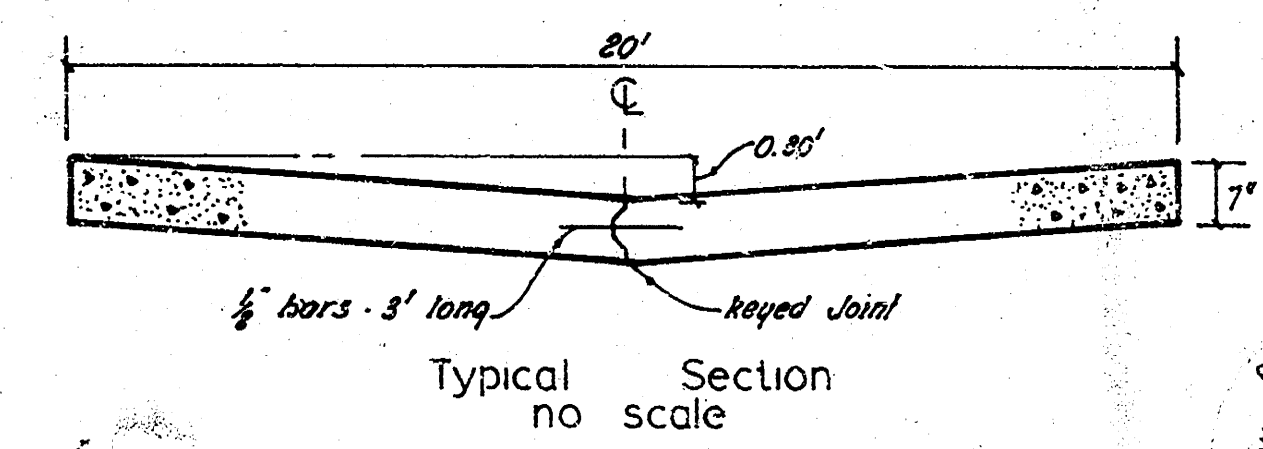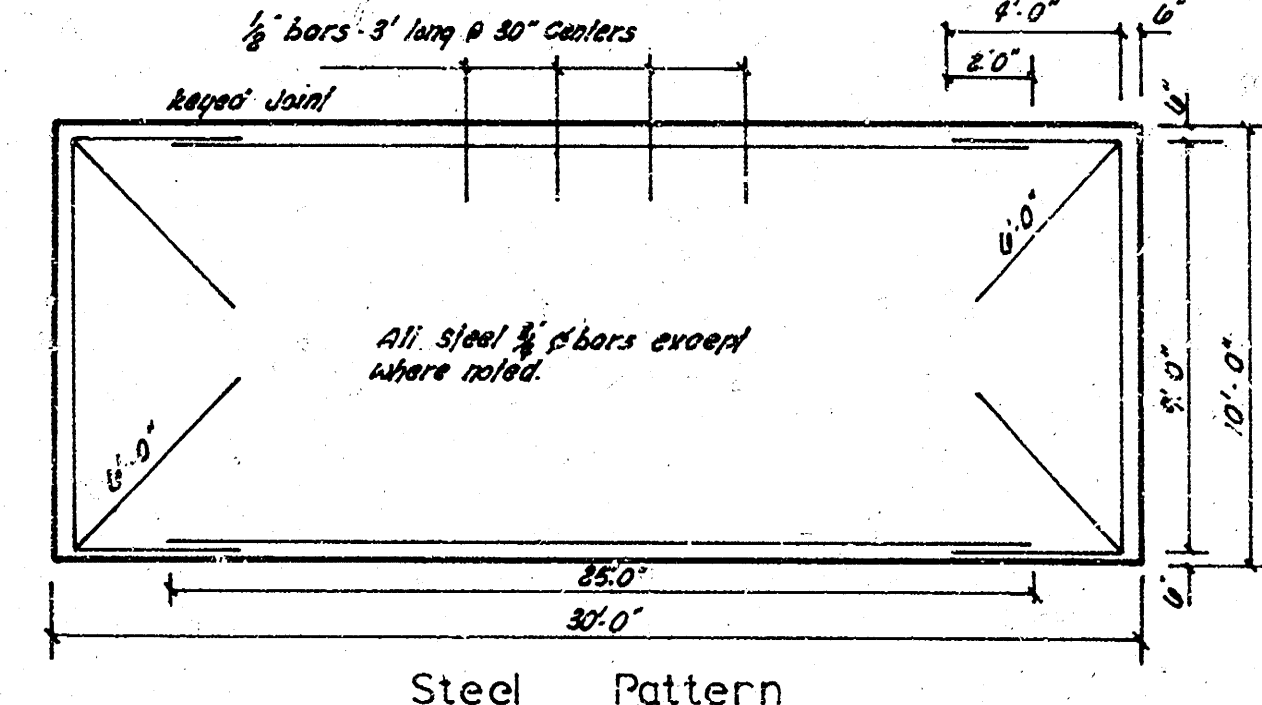

ALLEY Bet Woodlawn and Stratford.
S.L. 13th St. to 150' South S.L. 13th St.
CITY OF WICHITA, KANSAS
20'-7" Concrete
B.E. SMITH City Engineer
Date MARCH 1971 Private Project

