



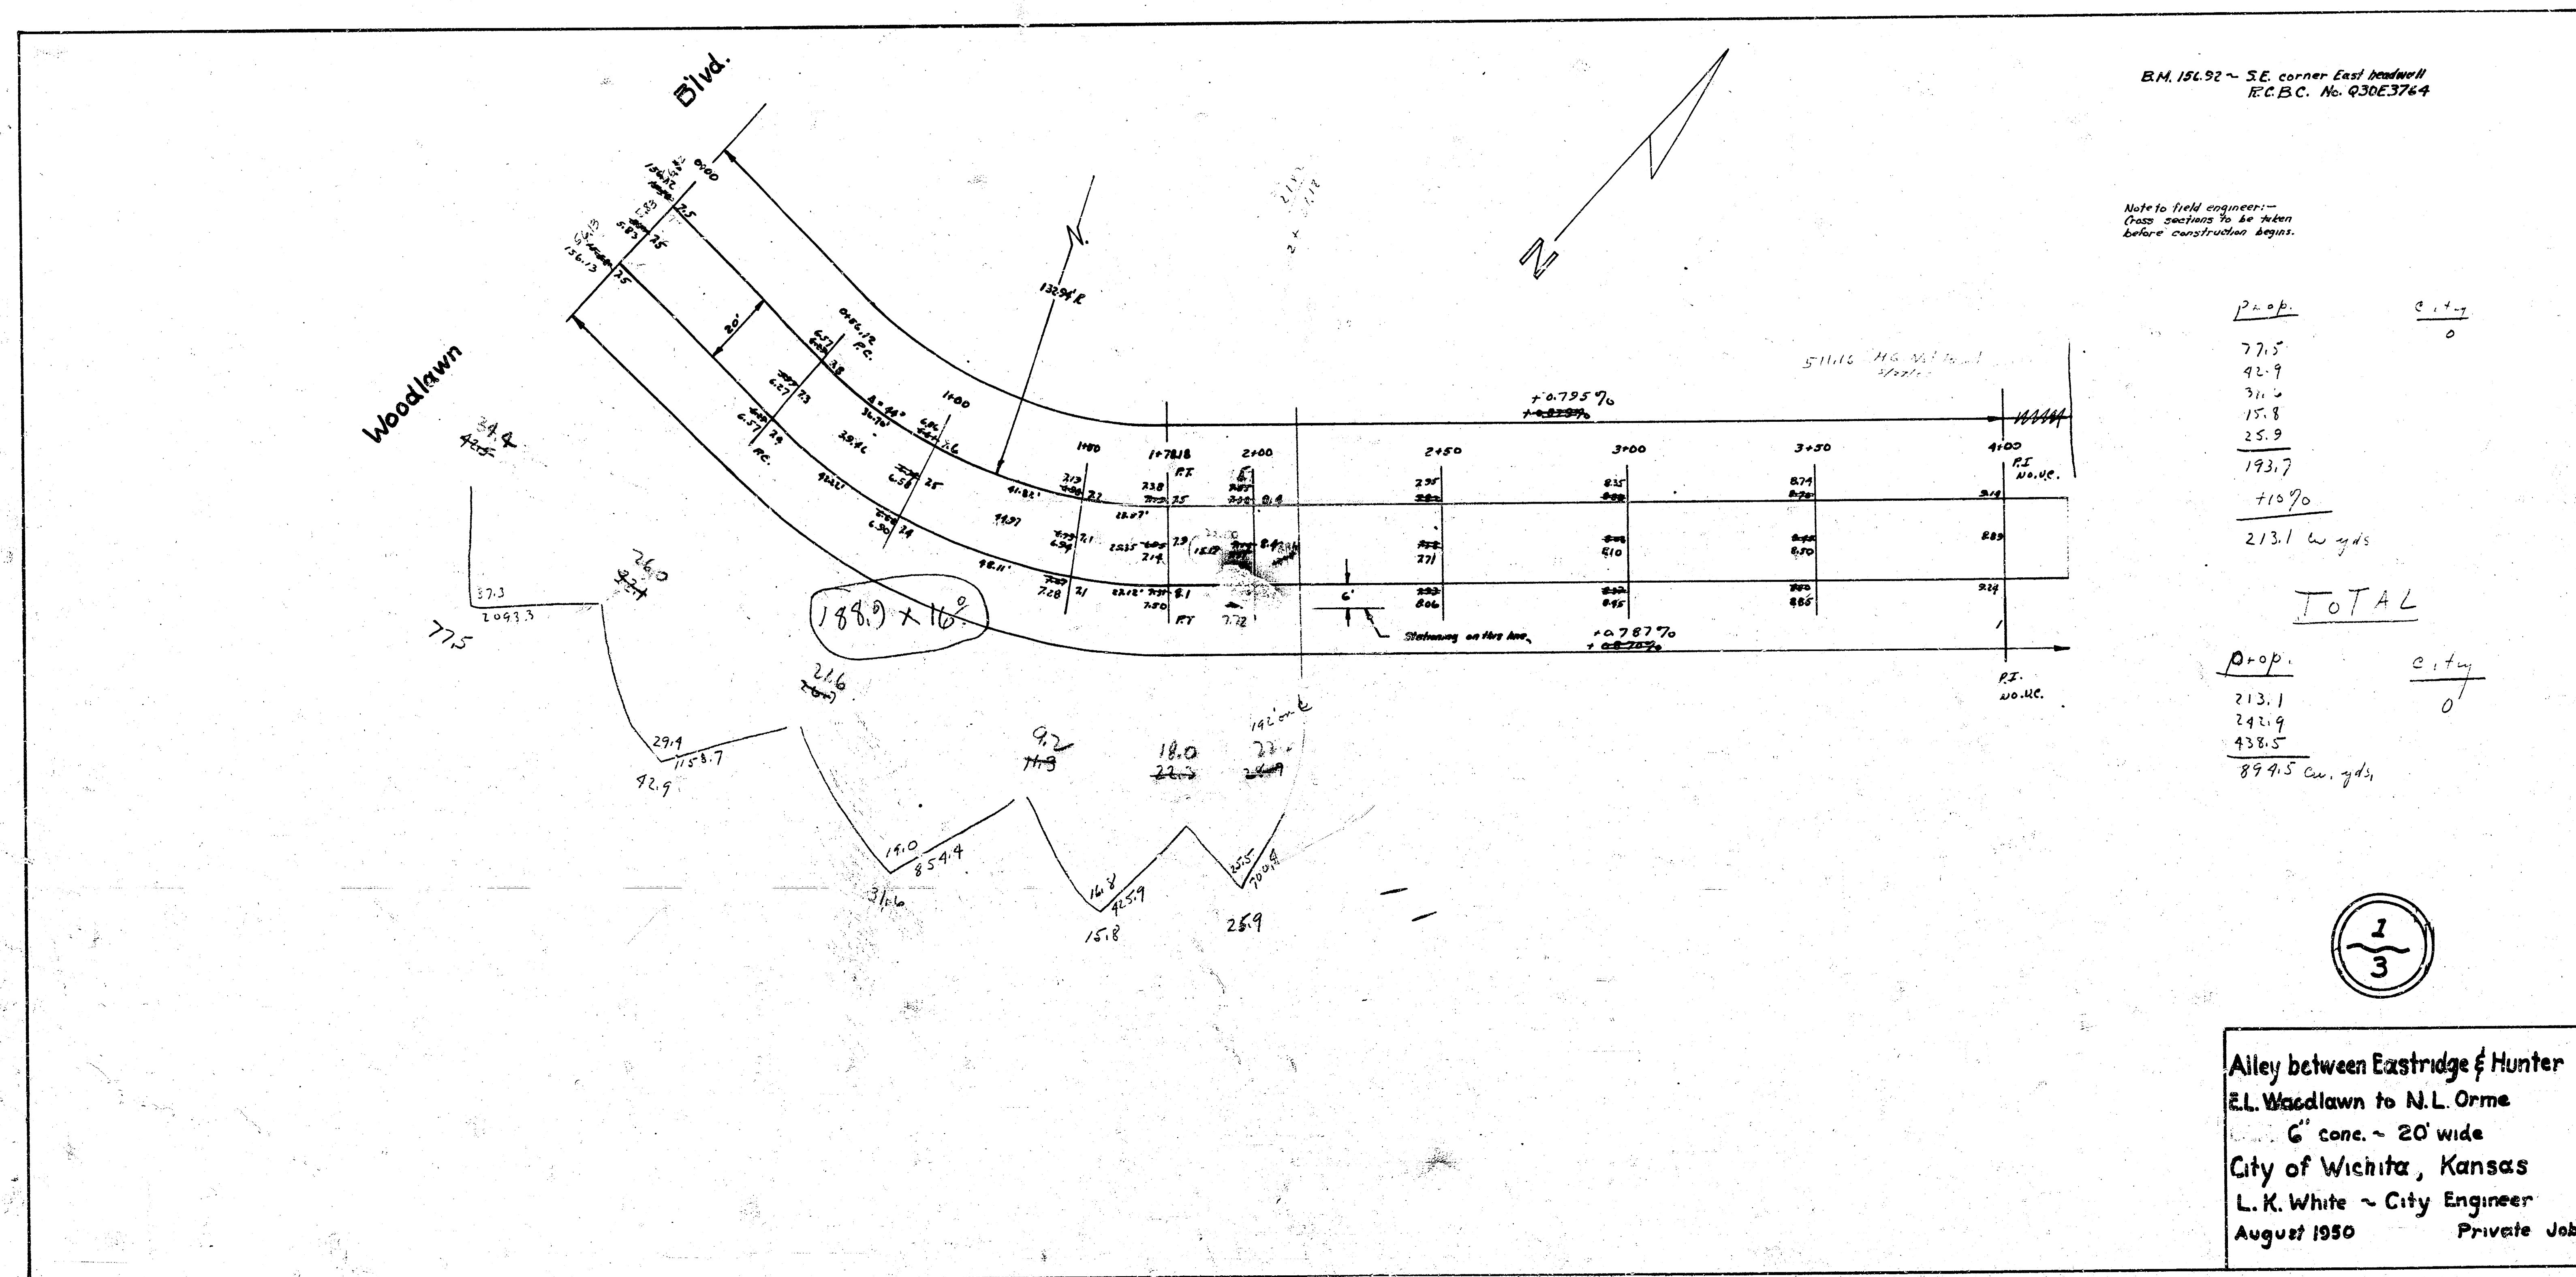

Note to field engineer:-
Cross sections to be taken before
construction begins.

B.M. 15632 ~ S.E. corner East headwall R.C.B.C. No. 63053764

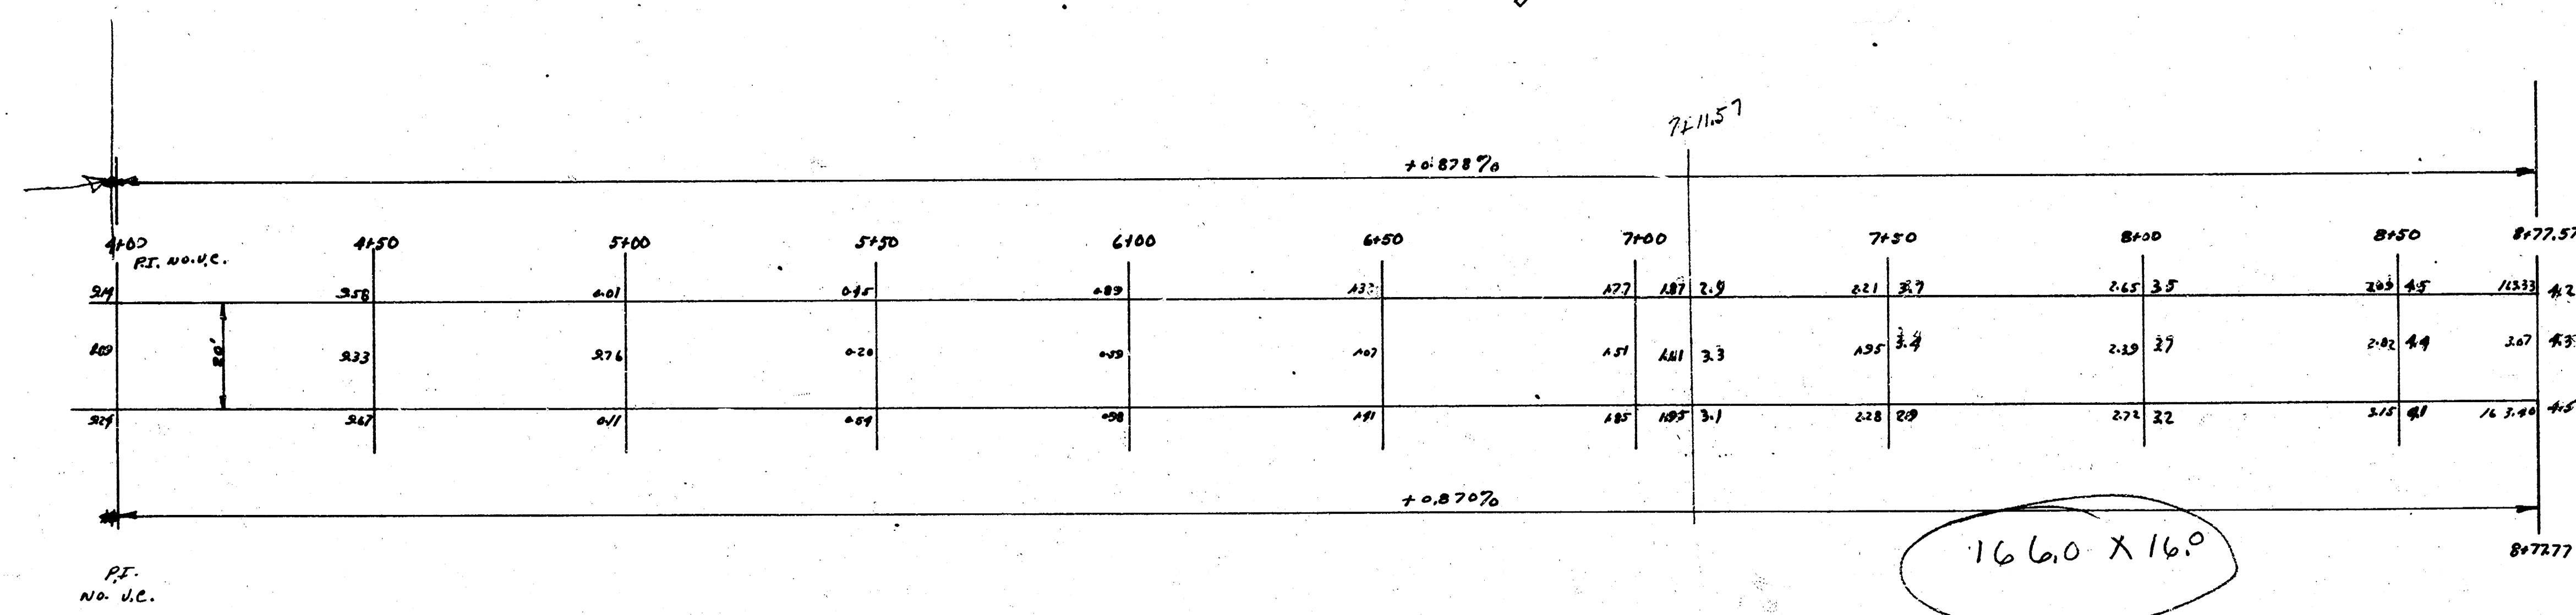

Drive

166.0 x 16.0

220.8
+10.70

Cottonwood

2
3

