


B.R. 1636 TOP RAILROAD IRON E.S. SANTA FE R/W & N.W. QUARTER.

GRAND TOTAL

PROPERTY	CITY
280 7	4 9
343 2	
623 9	4 9
7126 62 3	1070 4
686 2	5 3

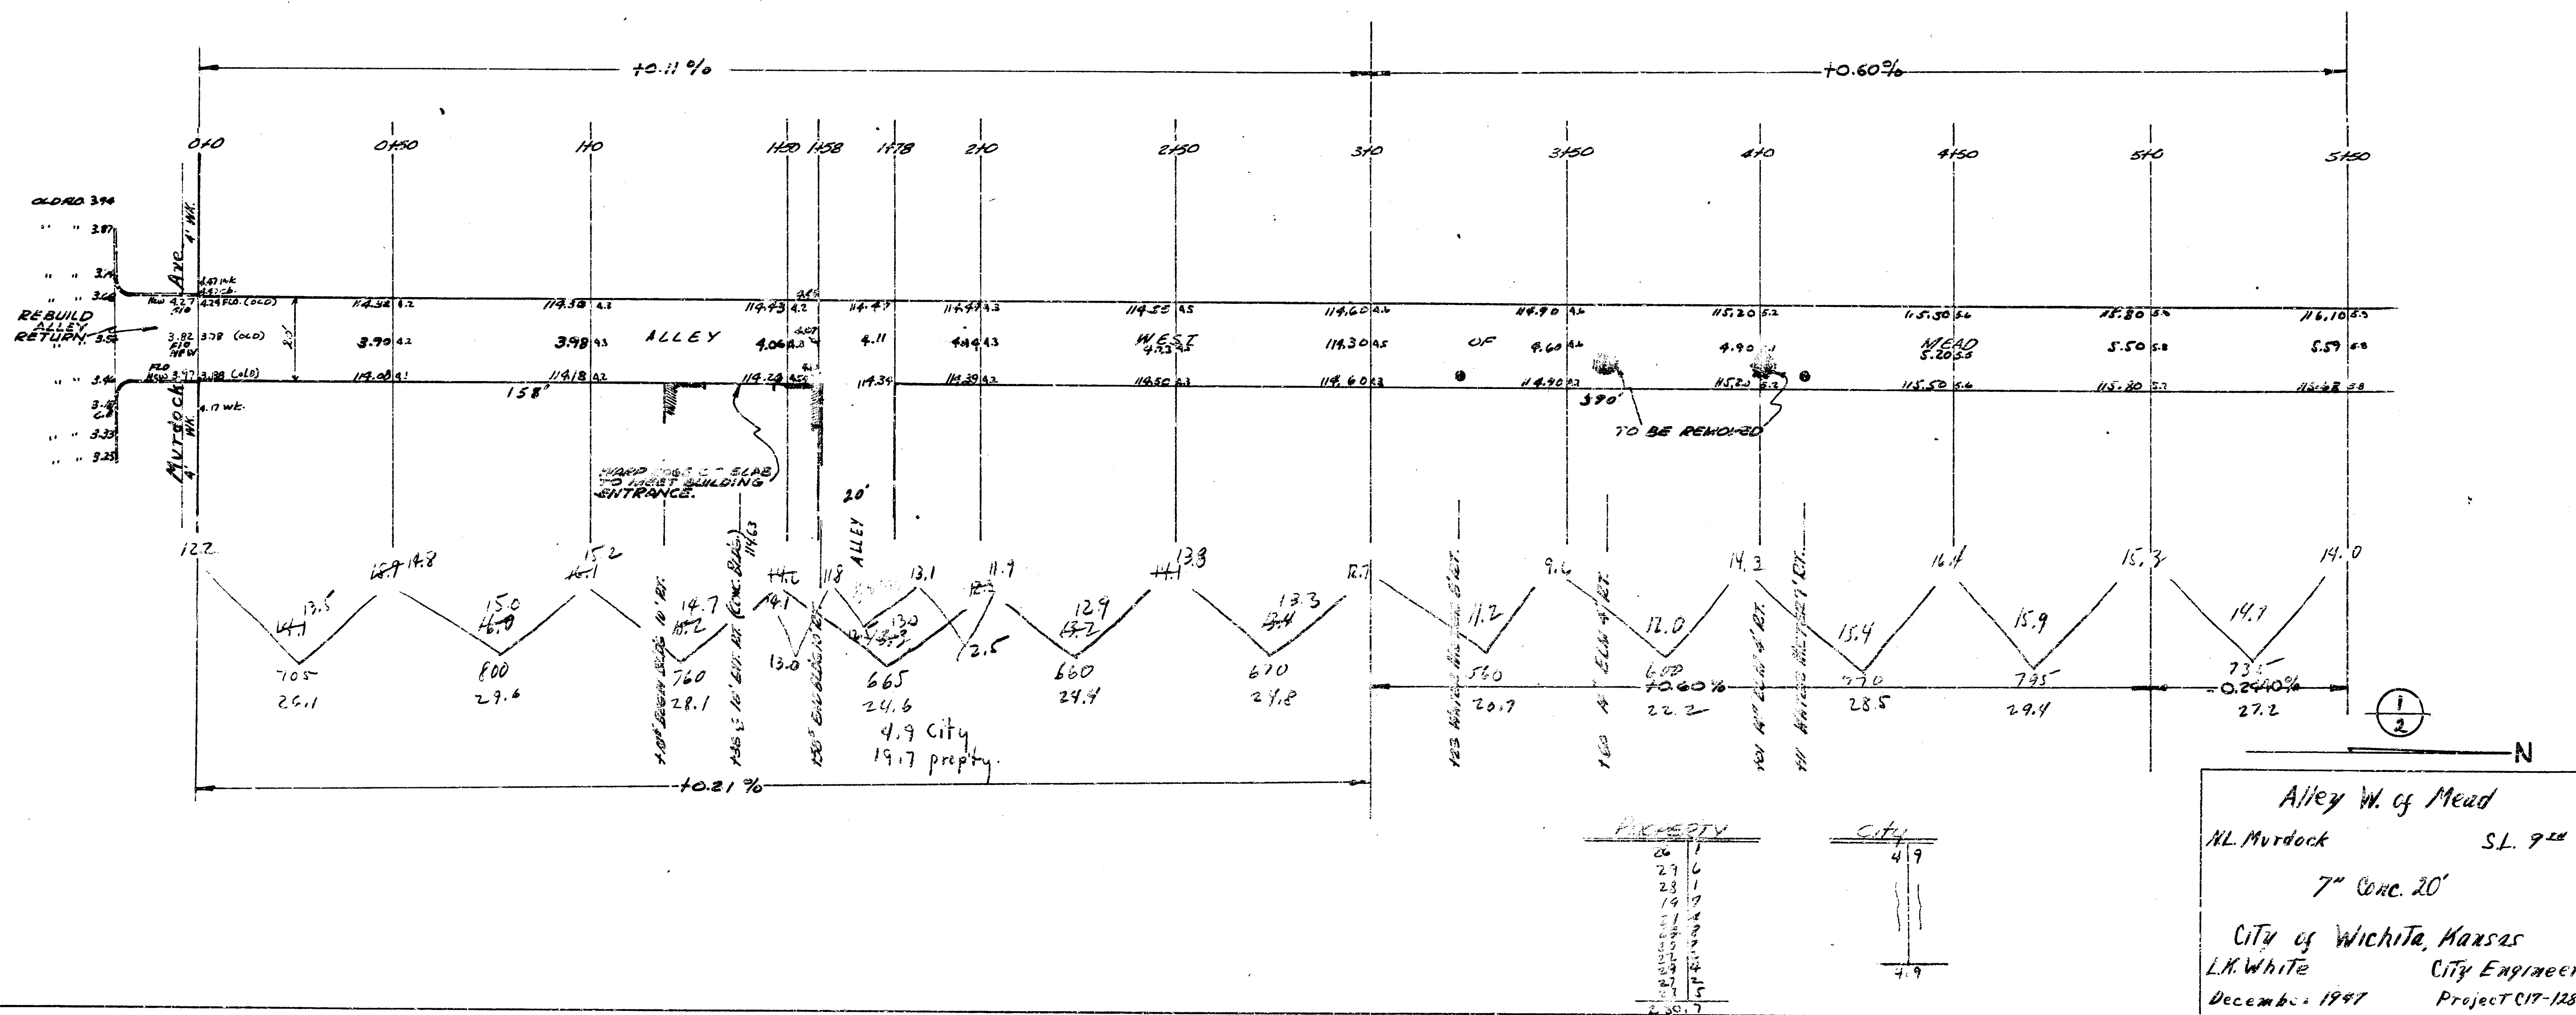

Alley W. of Mead
 H.L. Murdock S.L. 9th
 7th Cor. 20'
 City of Wichita, Kansas
 L.H. White City Engineer
 December 1947 Project C17-128

