
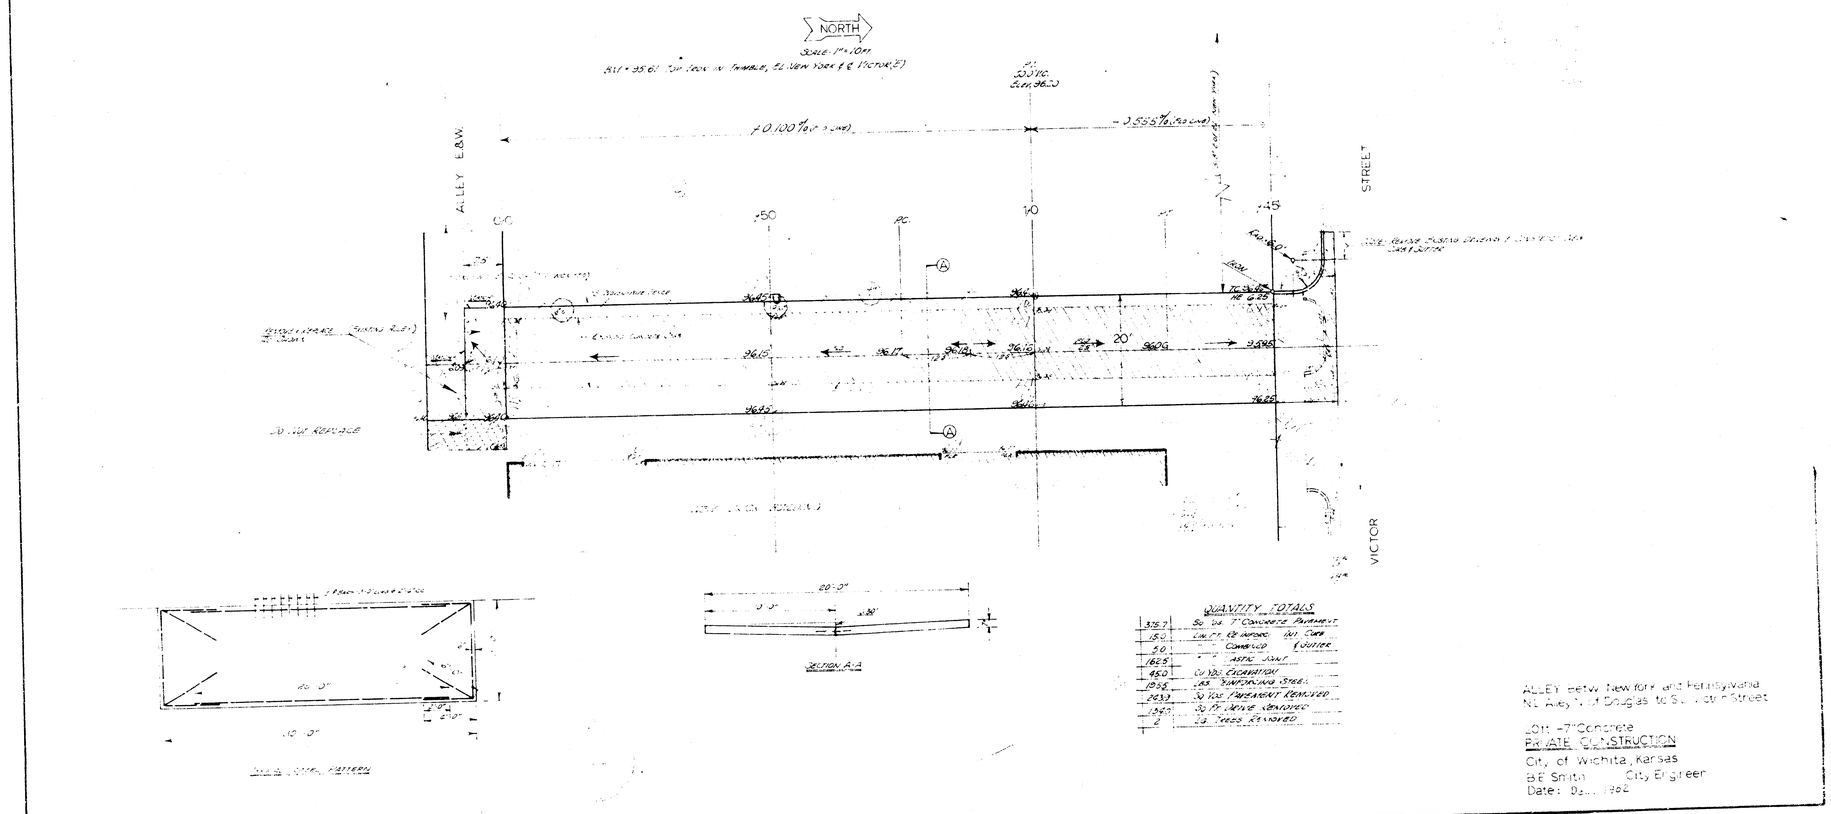


ALLEY betw. New York and Pennsylvania
NL Alley N. of Douglas to S. ... of Street

.01: -7" Concrete
PRIVATE CONSTRUCTION
City of Wichita, Kansas
BE Smith City Engineer
Date: D... 1902

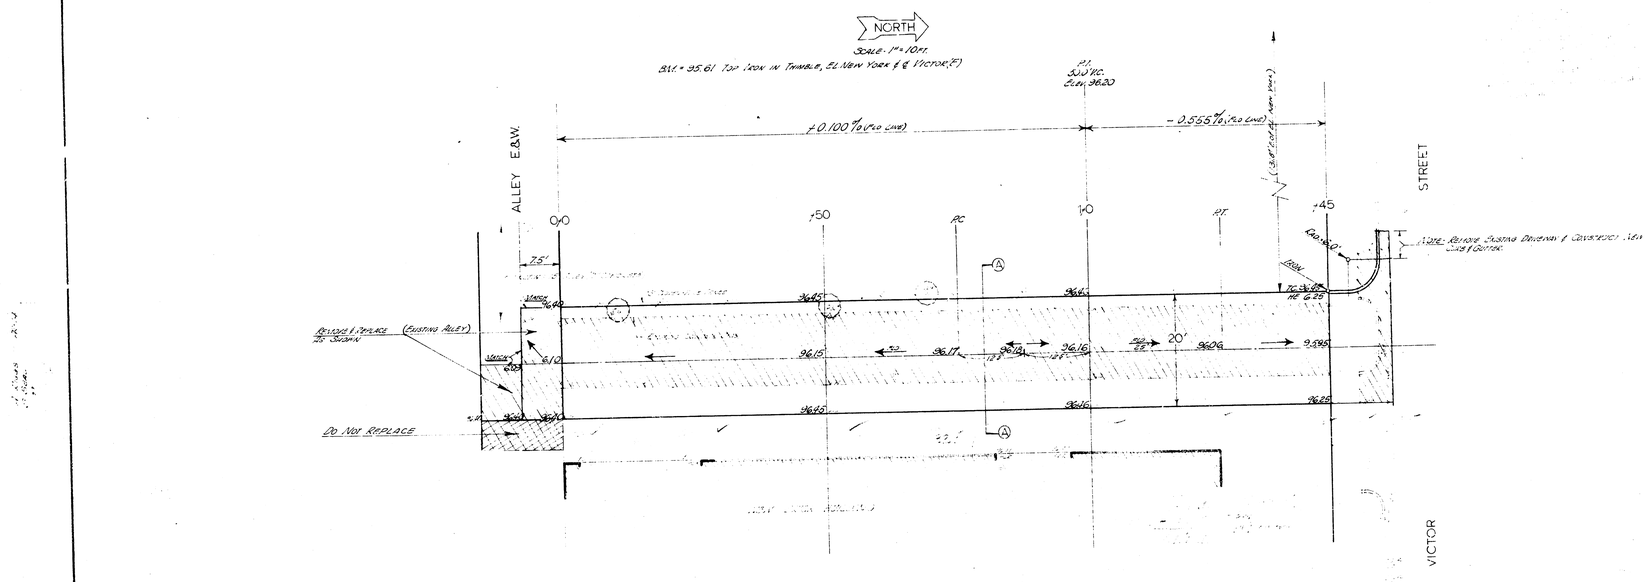

	QUANTITY TOTALS	FINAL QUANTITIES
370.7	Sq Yds. 7" Concrete Pavement	388.4
15.0	Lin Ft. Reinforced 6" Curb	13.4
5.0	" " Combined Curb & Gutter	7.9
162.5	" " Mastic Joint	152.5
4.50	Cu Yds. Concrete	6.1.7
1.55	Lbs. Reinforcing Steel	1615
24.39	Sq Yds. Pavement Removed	24.2.7
1.340	Sq Ft. Drive Removed	150.3
2	Ea Trees Removed	none

ALLEY Betw New York and Pennsylvania
N.L. Alley N. of Douglas to S.L. Victor Street

20ft. -7"Concrete
PRIVATE CONSTRUCTION
City of Wichita, Kansas
B.E. Smith City Engineer
Date: Dec. 1948