



B.M. 114.67 W.L. Water & Douglas - Top NW Cor. E. Part Safety Island
 B.M. 112.42 W. Rm. M.H. in Alley S.S. 1st Between Main & Market



NOTE: Exst. pvt. in alley is 3" brick,
 asphalt filler, on 5" Conc. base in 15' of
 width. Other 5' is Conc. pvt.

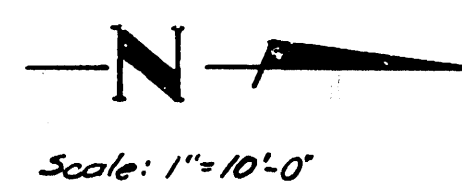

Scale: 1"=10'-0"

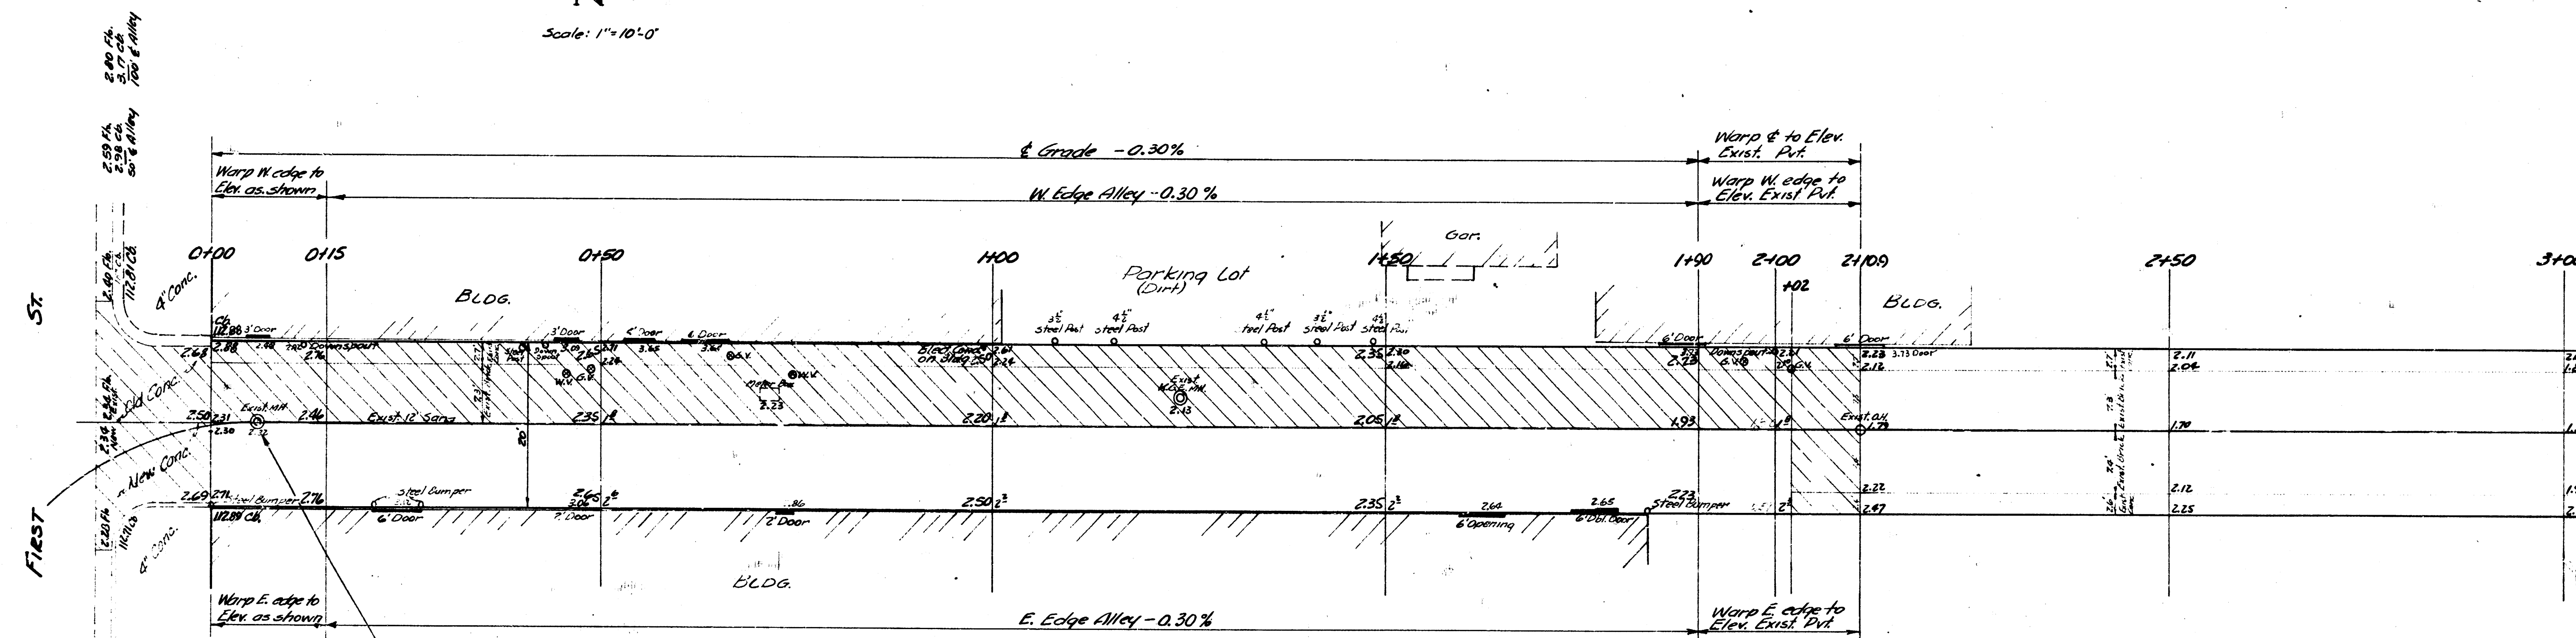

NOTE: Manhole to be rebuilt
 by City Sewer Maintenance

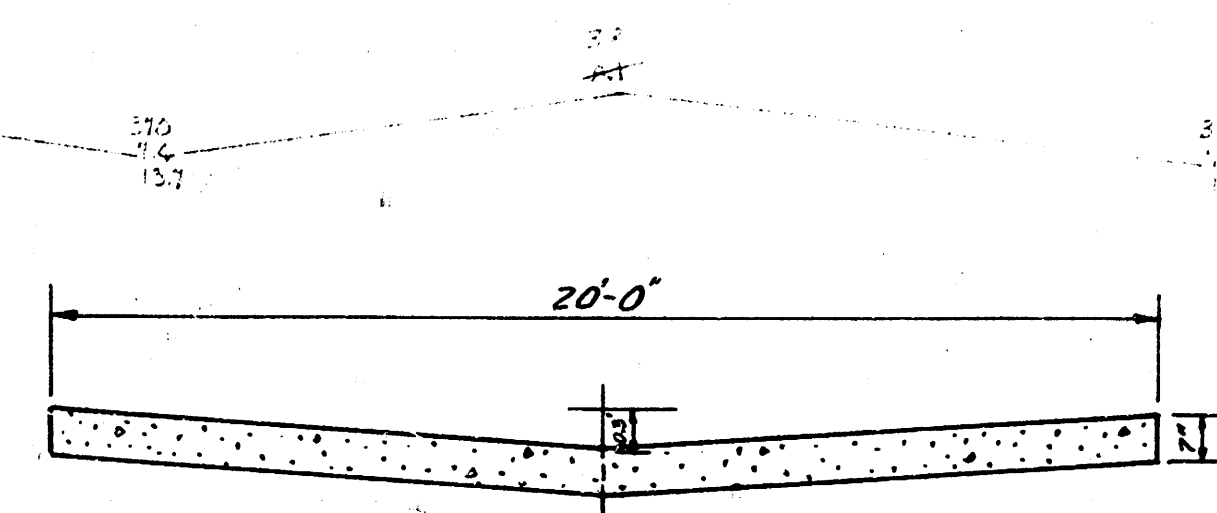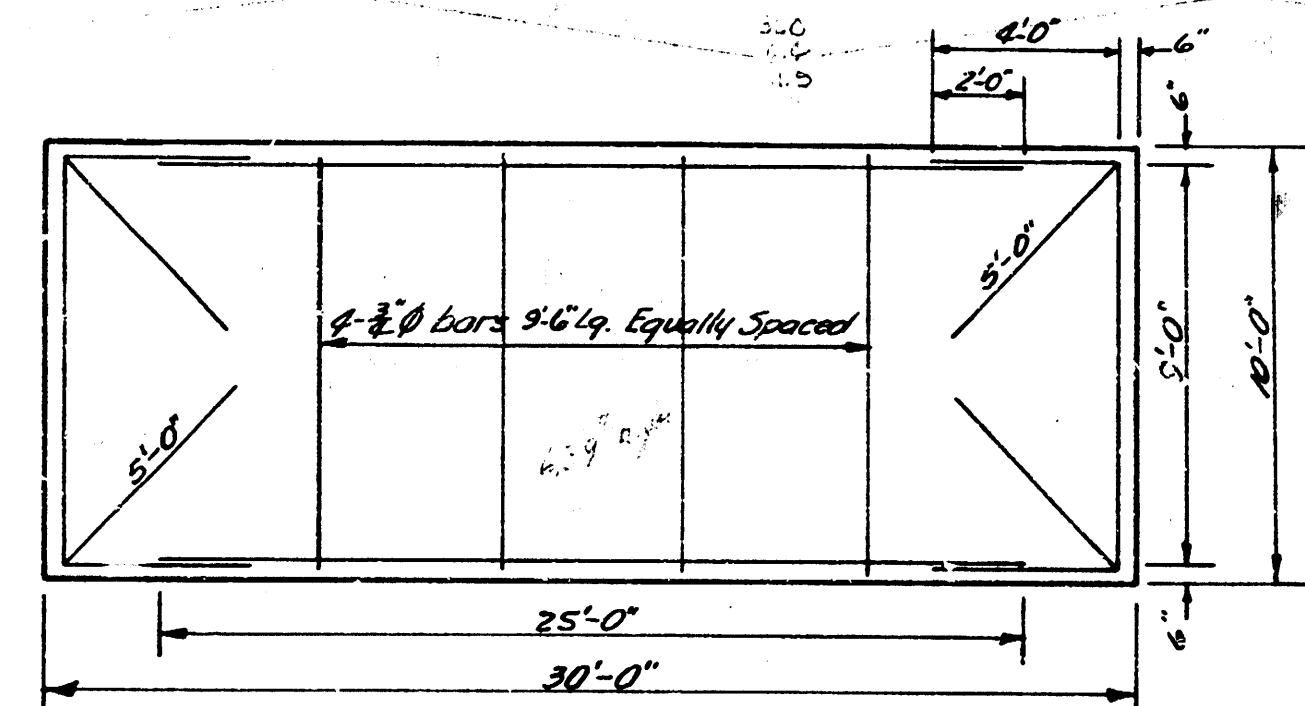




ALLEY BTWN MARKET & MAIN
 N.L. 1ST-NL LOT 63, MARKET ST RESURVEY OF GREIF-
 ENSTEIN'S ORIGINAL TOWN IN THE CITY OF WICHITA, KAN.
 20' CONC. - 7" THICK
 CITY OF WICHITA, KANSAS
 B.E. SMITH CITY ENGINEER
 APRIL 1956 PROJ. C16-55