


B.M.-15336- A. in Ridge and W. Ch. S.W. Co. Devel. Co. of Kansas

Prop.
53.1
75.7
70.6
70.0
169.4
377.2
+1070 37.4
411.6

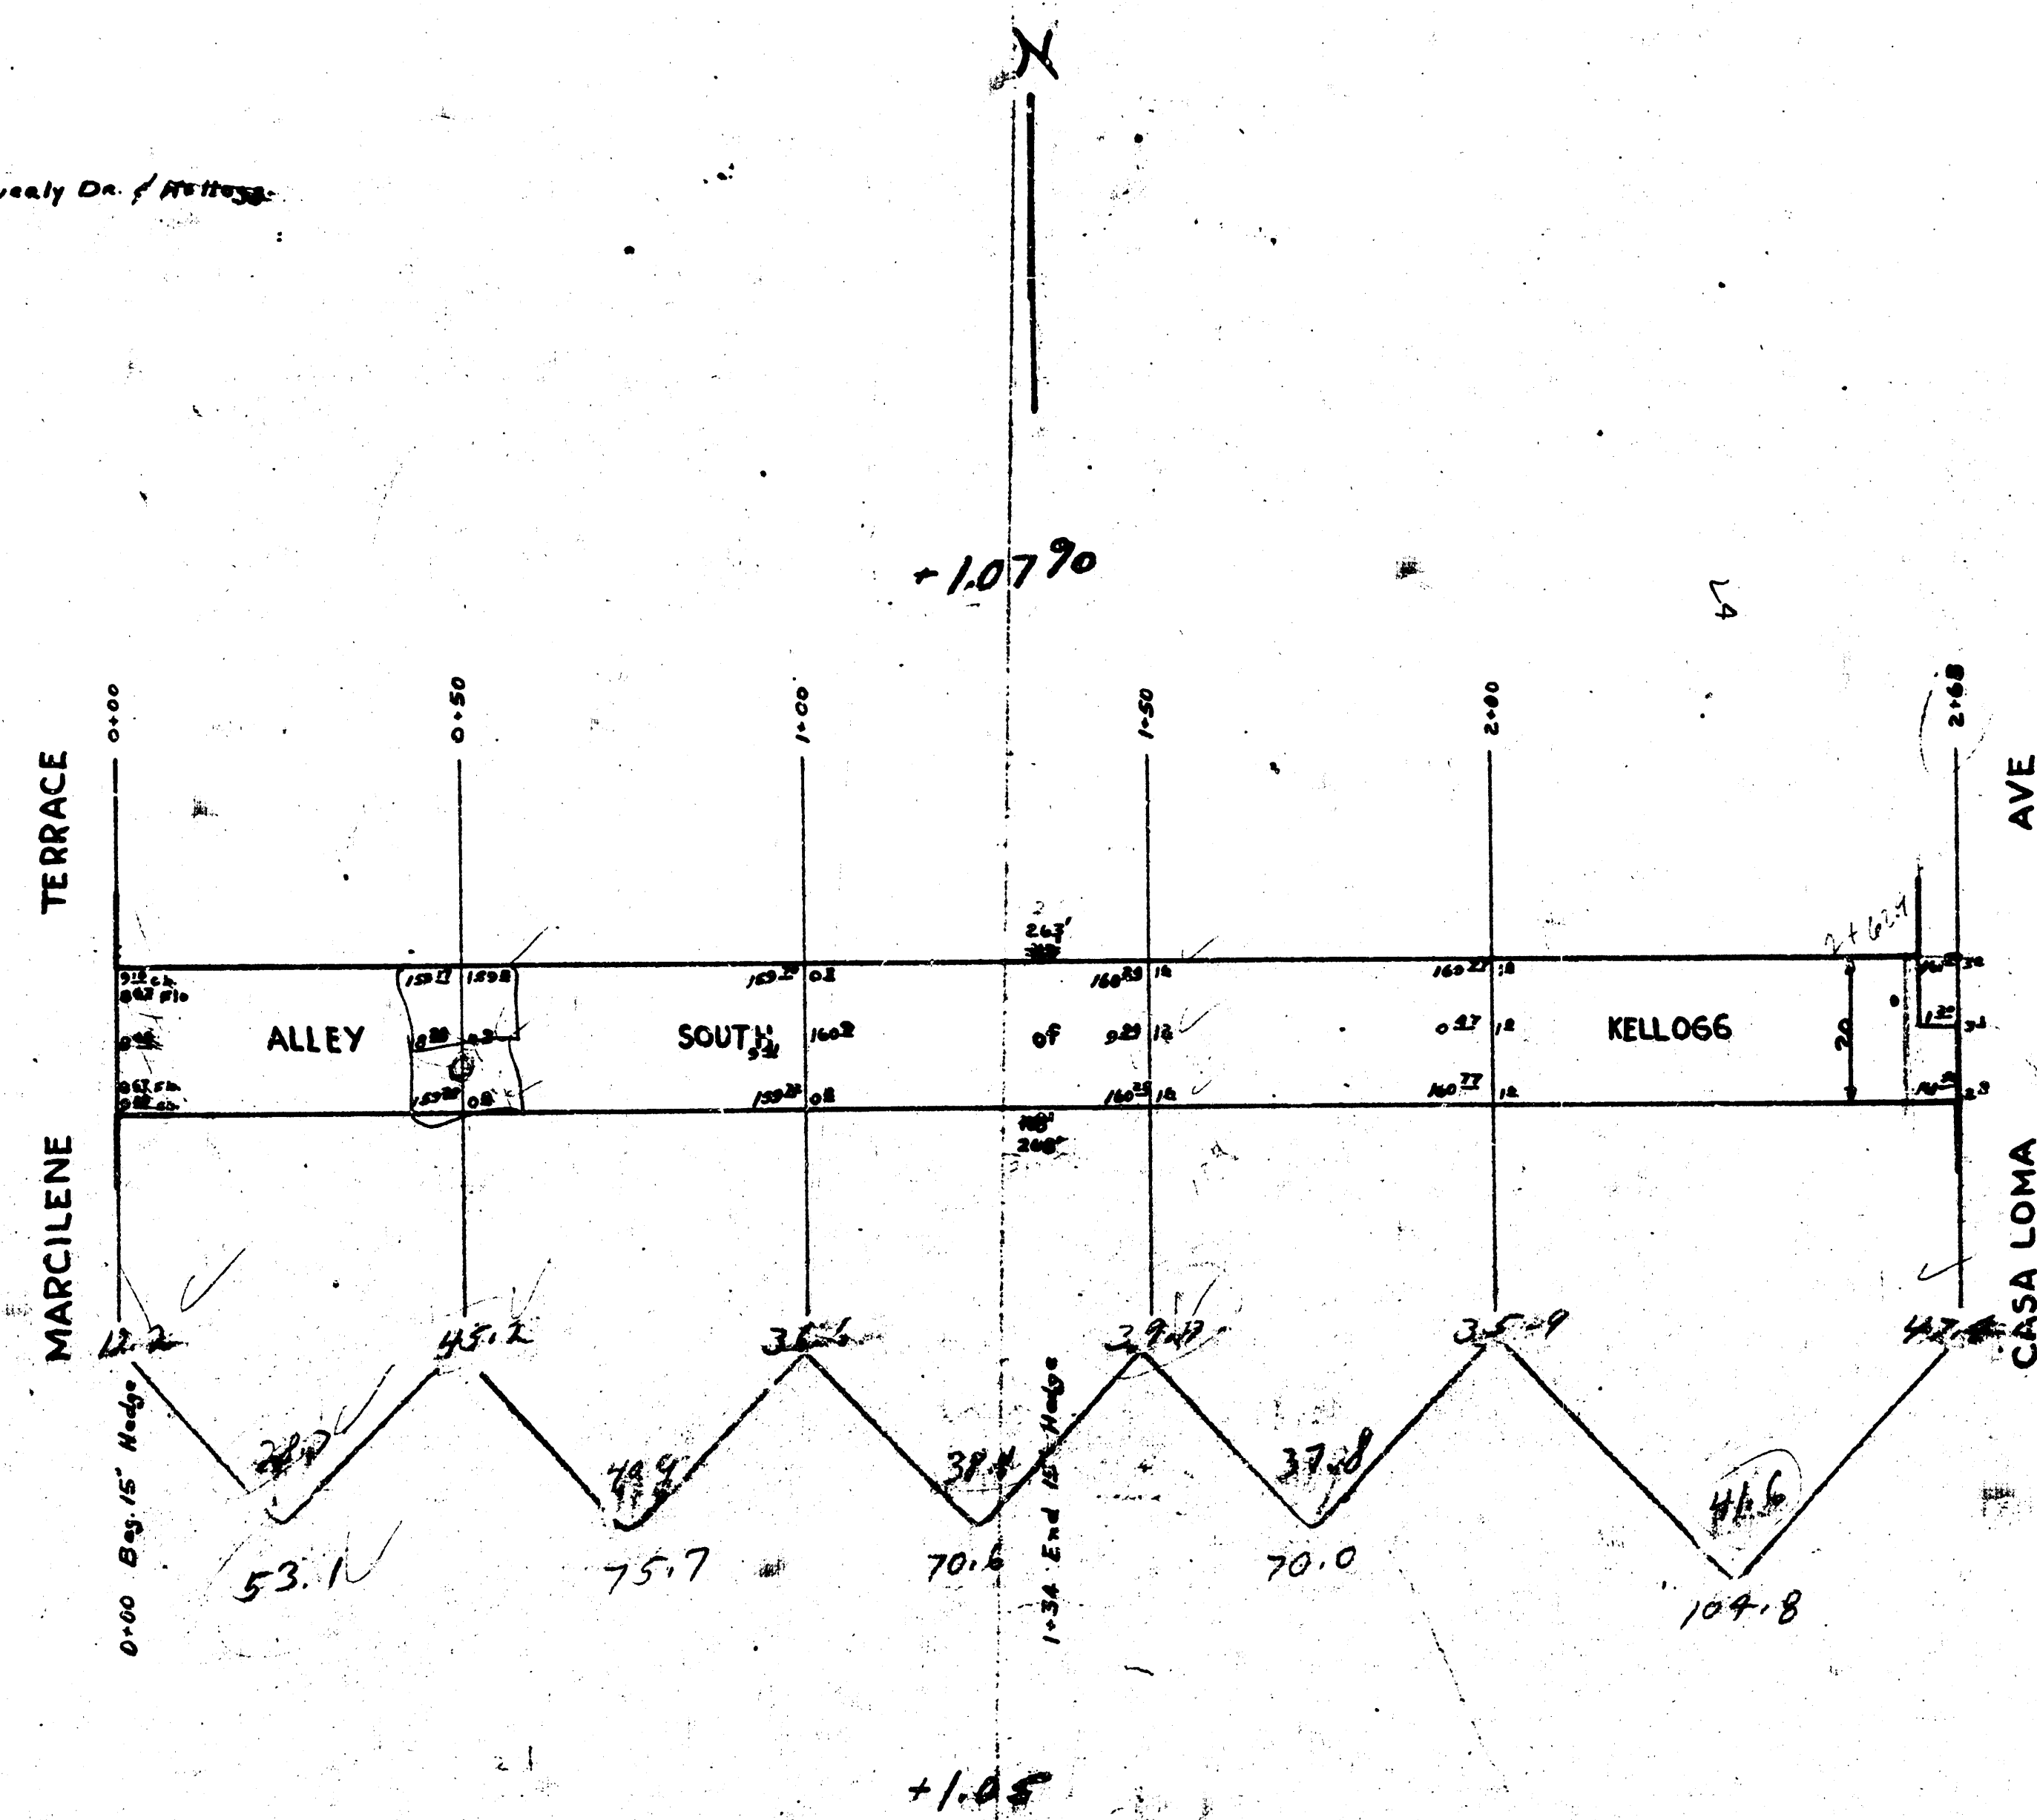

ALLEY S. of KELLOGG ST	WL CASA LOMA
EL MARCILENE	
20' CONCRETE, 7" THICK	
CITY of WICHITA, KANSAS	
LK WHITE	CITY ENGINEER
APRIL 1947	