



B.M. 10785 Iron in thimble W.S. Ellis & English W.  
 B.M. 10843 1" in. Latimer C. W.E. E. 153. Alley West of Ellis & S.S. English  
 B.M. 10864 N. Elm N.W.M. Alley intersection, 2' E of E. Alley S.  
 B.M. 10980 Top of cap 2" pipe, 15' E. 10' S of S.E. Cor. Alley Intersection.

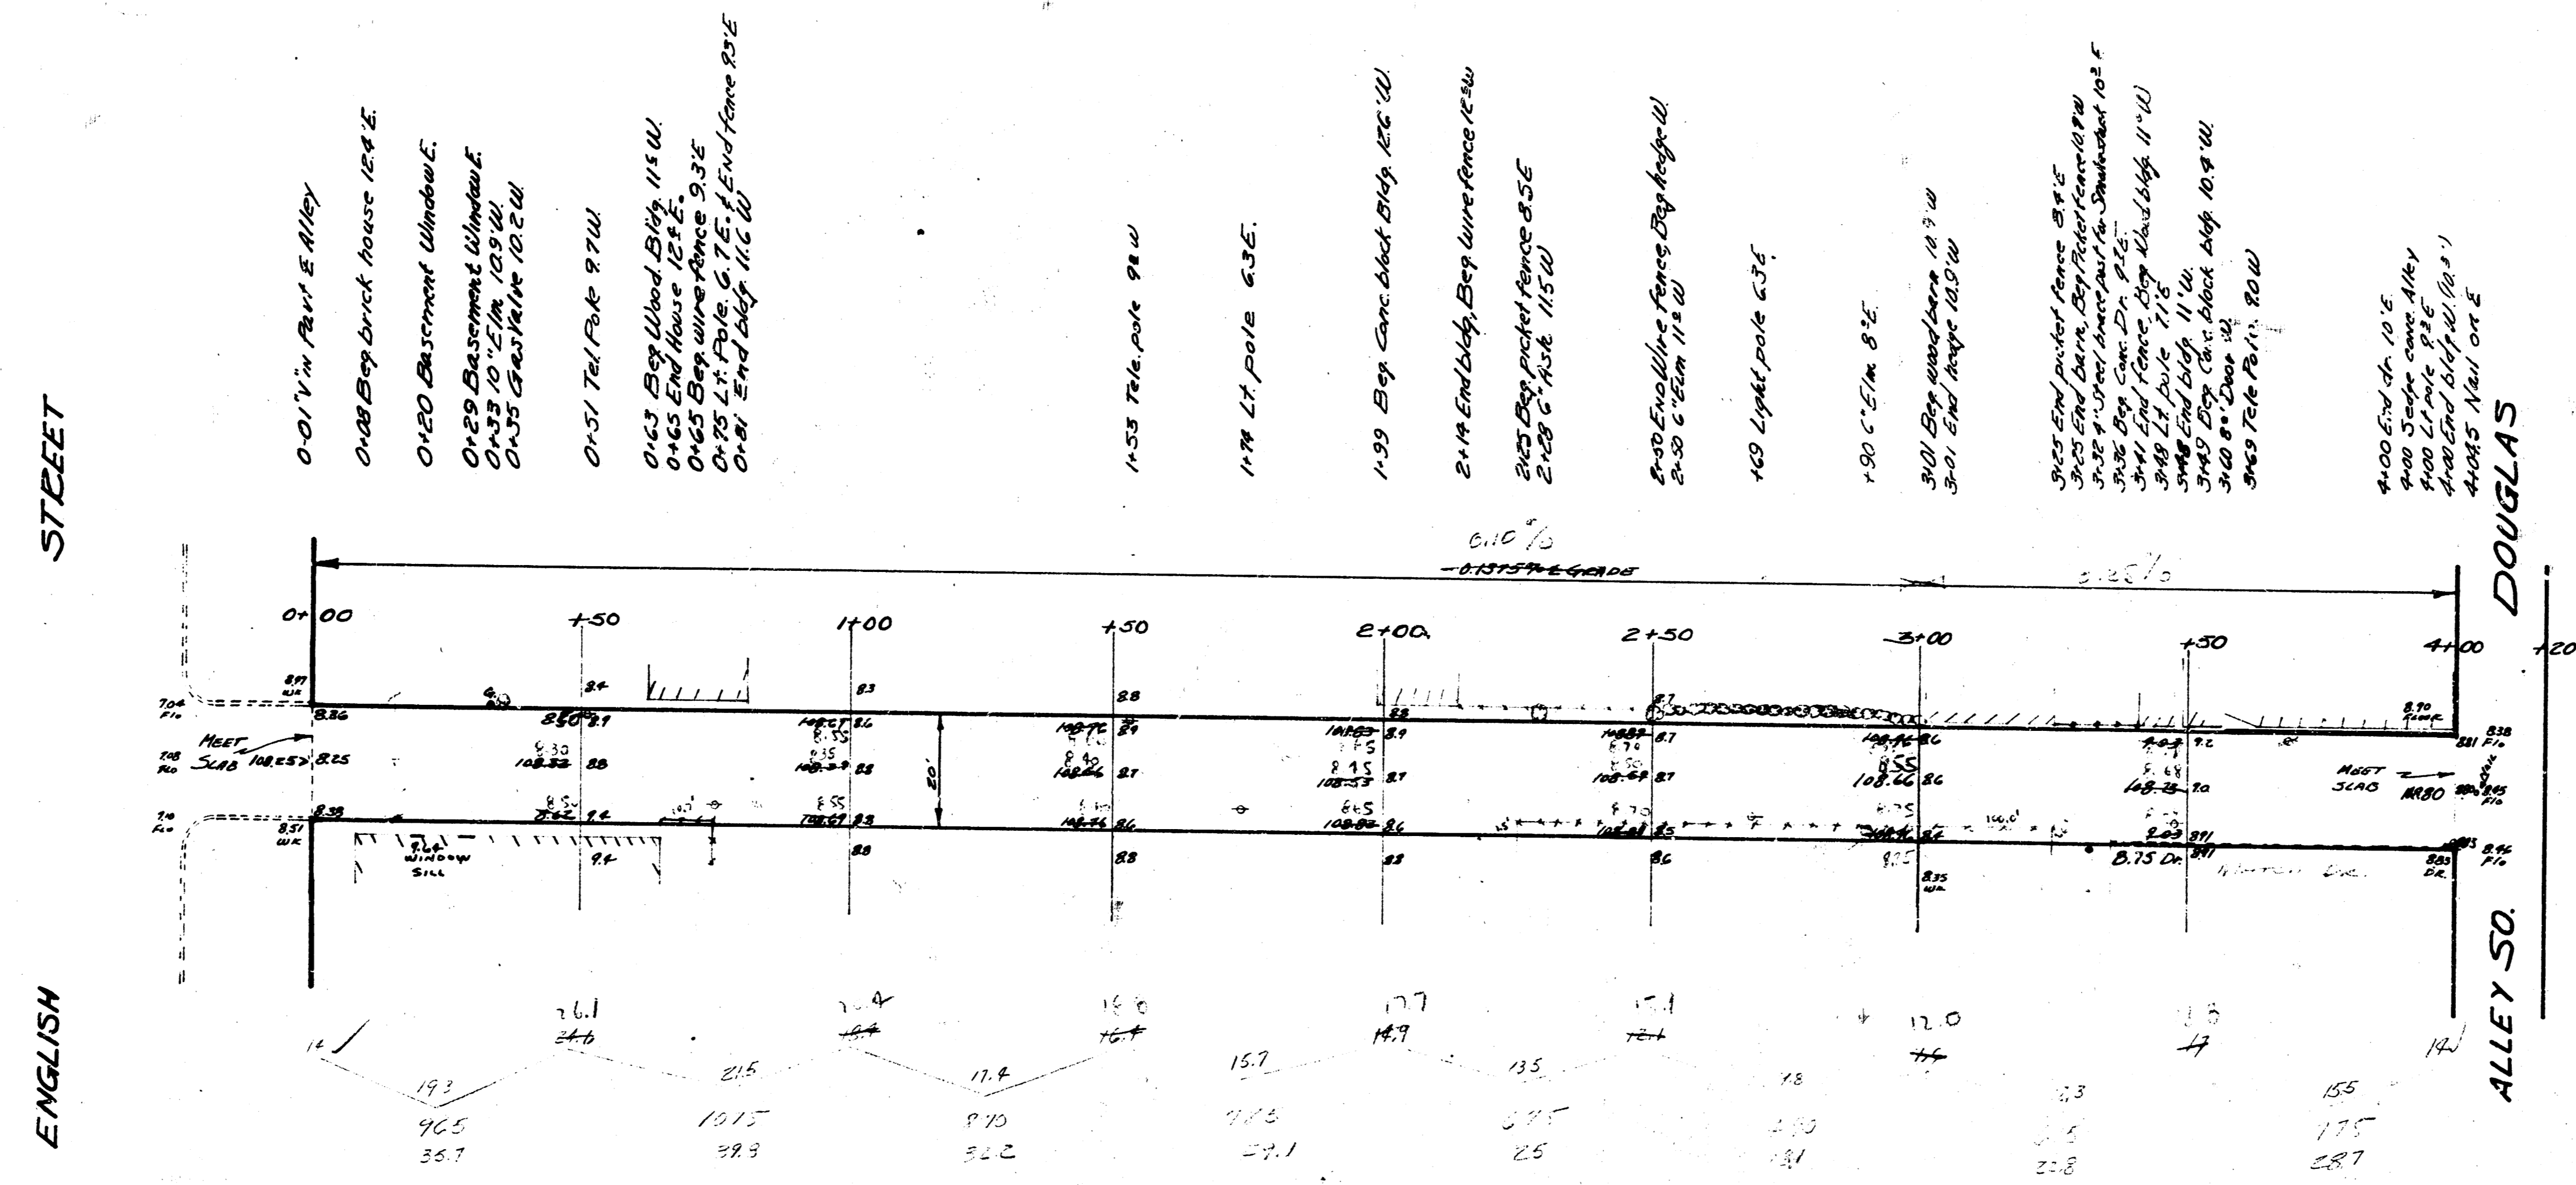

Check with  
 [Signature]

*Refuge of  
 curb of alley  
 s. p. 2' 6\"/>*

1"=20'

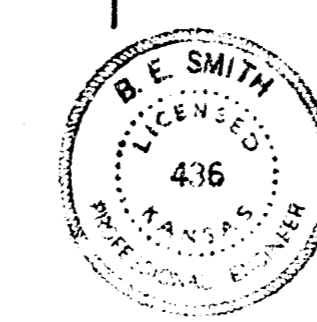

ALLEY BET ELLIS & LULLU  
 N.L. ENGLISH TO S.L. ALLEY SO. OF DOUGLAS  
 8" CONC. 20"  
 CITY OF WICHITA, KANSAS  
 B.E. SMITH CITY ENGINEER  
 JAN. 26, 1953 PROJ. NO. C12-235