DETAIL

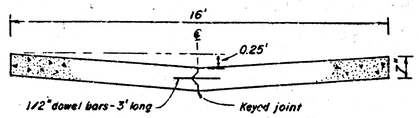

TYPICAL SECTION

Not To Scale

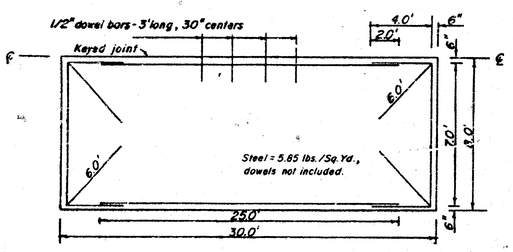

STEEL PATTERN

NOTE - All reinforcing steel to be #6 bars, except dowel bars.

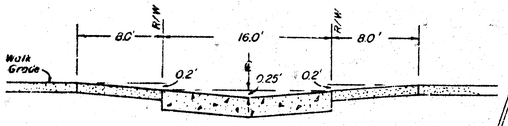

ALLEY APPROACH

Section At Property Line (Not To Scale)

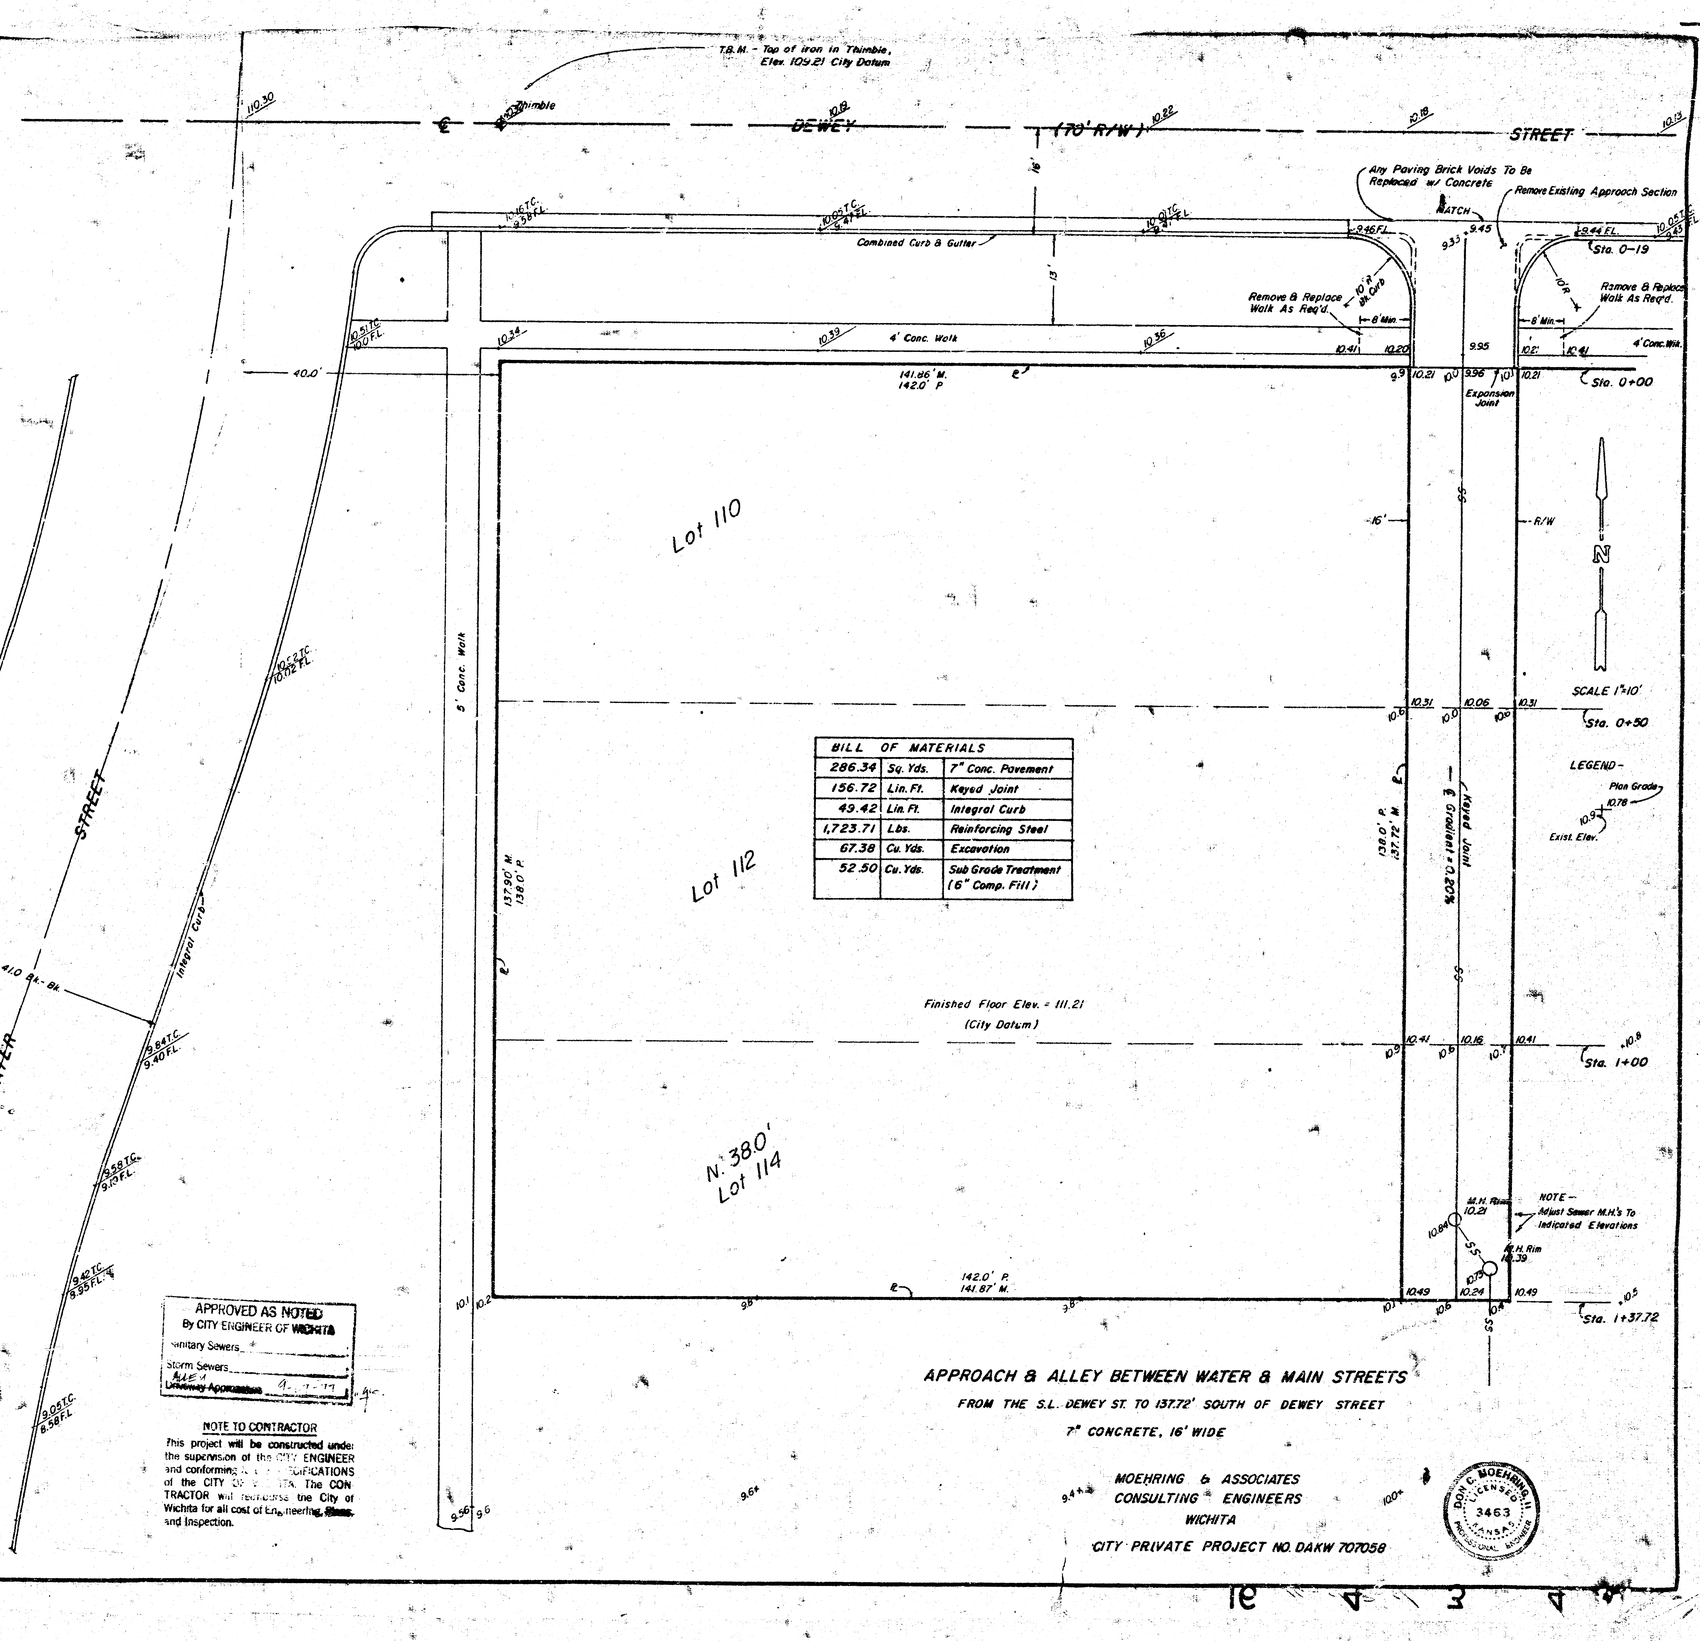

BILL OF MATERIALS		
286.34	Sq. Yds.	7" Conc. Pavement
156.72	Lin. Ft.	Keyed Joint
49.42	Lin. Ft.	Integral Curb
1,723.71	Lbs.	Reinforcing Steel
67.38	Cu. Yds.	Excavation
52.50	Cu. Yds.	Sub Grade Treatment (6" Comp. Fill)

Finished Floor Elev. = 111.21
(City Datum)

APPROVED AS NOTED
By CITY ENGINEER OF WICHITA
Sanitary Sewers
Storm Sewers
Alley
Driveway Approaches
4-17-57

NOTE TO CONTRACTOR

This project will be constructed under the supervision of the CITY ENGINEER and conforming to the SPECIFICATIONS of the CITY OF WICHITA. The CONTRACTOR will reimburse the City of Wichita for all cost of Engineering, Plans, and Inspection.

APPROACH & ALLEY BETWEEN WATER & MAIN STREETS

FROM THE S.L. DEWEY ST. TO 137.72' SOUTH OF DEWEY STREET

7" CONCRETE, 16' WIDE

MOEHRING & ASSOCIATES
CONSULTING ENGINEERS
WICHITA

CITY PRIVATE PROJECT NO. DAKW 707058

DON C. MOEHRING II LICENSED 3463 KANSAS PROFESSIONAL ENGINEER